
No gas lines


B. M. 145.38 "+" top W. End Handrail R. C. B. C. on Harry 238' E. of Rock Rd.

B. M. 145.79 "M" in Mueller Fire Hydrant N.W. cor. Rock Rd. & Harry.

B. M. 149.87 SE cor. bolt in conc. Step at S.E. cor. Bldg. 7820 E. Harry.

Survey by D.L.K. Bk. D.L.K. 123
Plan by J. R. W.
Checked by D.N.R.

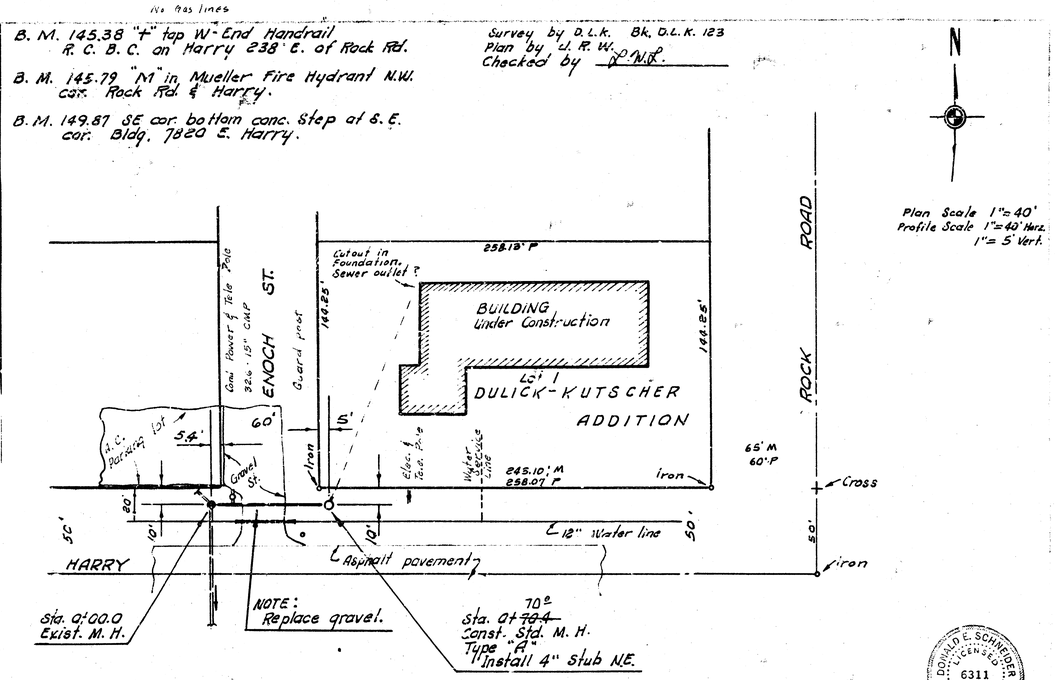

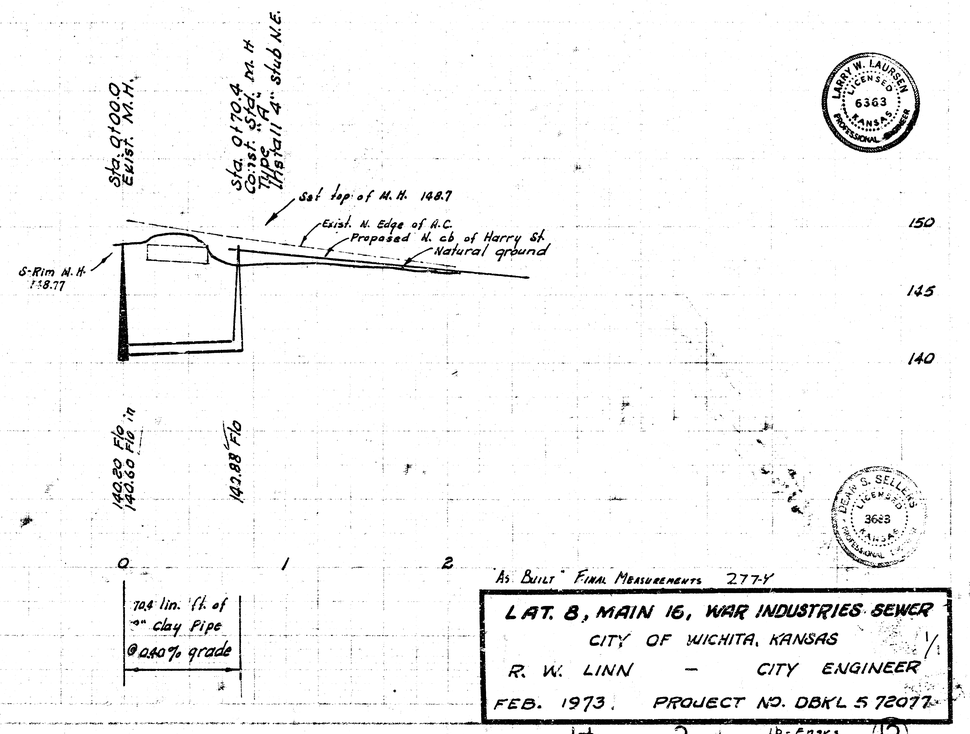

"As Built" Final Measurements 2-7-74

LAT. 8, MAIN 16, WAR INDUSTRIES SEWER

CITY OF WICHITA, KANSAS

R. W. LINN — CITY ENGINEER

FEB. 1973. PROJECT NO. DBKL 5 72077

1/1

14 2 12 1-Engrs 1-Water

DONALD E. SCHNEIDER LICENSED 6311 KANSAS PROFESSIONAL ENGINEER

LARRY W. LAURSEN LICENSED 6363 KANSAS PROFESSIONAL ENGINEER

DEAN S. SELLERS LICENSED 3628 KANSAS PROFESSIONAL ENGINEER

FILMED FROM THE BEST