
B.M. 86.90 "+" cut in S.W. cor. conc. Pd. Auto Parts Store.

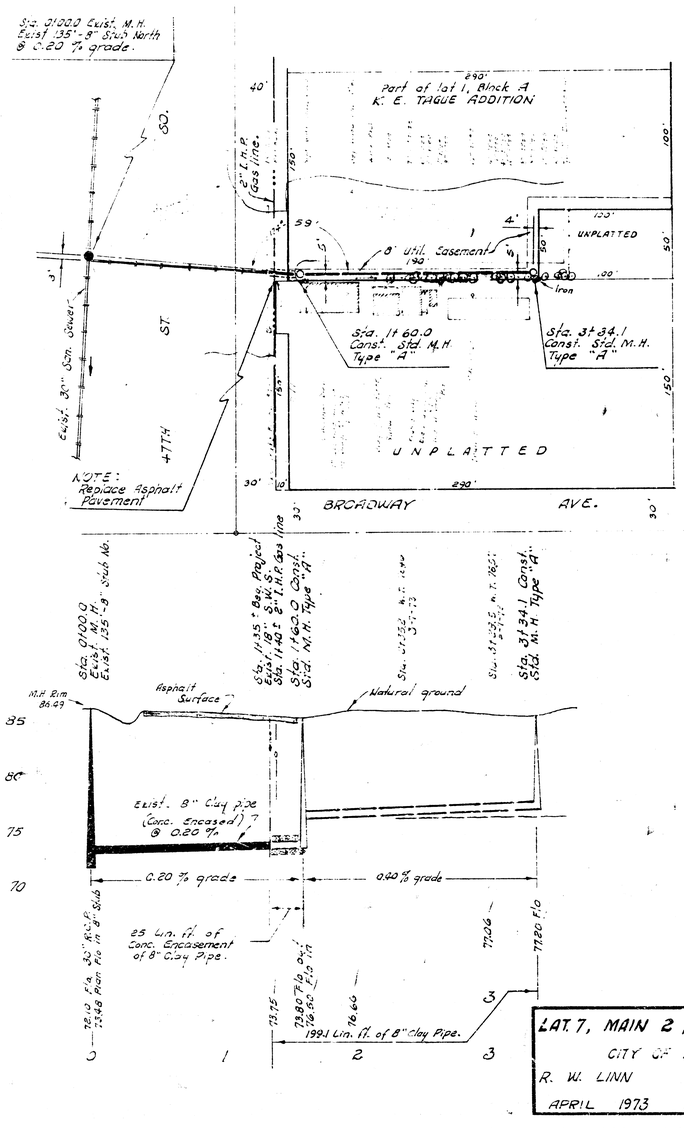

NOTE TO FIELD ENGINEER AND CONTRACTOR

All sand backfill for this project shall be included in the price bid per linear foot of clay pipe, and shall include the cost of sand, placing, jetting and vibrating and all necessary costs and labor to complete the backfill.

Plan Scale 1"= 40'
Profile Scale 1"= 40' Horz.
1"= 5' Vert.

LAT. 7, MAIN 2, S.W. INTERCEPTOR SEWER

CITY OF WICHITA, KANSAS

R. W. LINN — CITY ENGINEER


APRIL 1973 PROJECT NO. DBKL 572081

B.M. 145.38 "+" top W-End Handrail R.C.B.C. on Harry 238' E. of Rock Rd.


B.M. 1:5.79 "M" in Mueller Fire Hydrant N.W. cor. Rock Rd. & Harry.

B.M. 149.87 SE cor. bottom conc. Step at S.E. cor. Bldg. 7820 E. Harry.

Survey by D.L.K. Bk. D.L.K. 128
Plan by J.R.W.
Checked by

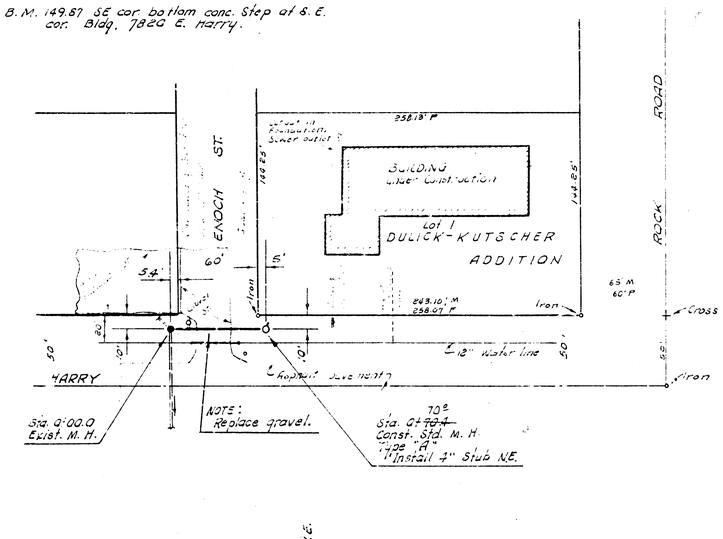

Plan Scale 1"= 40'
Profile Scale 1"= 40' Horz.
1"= 5' Vert.

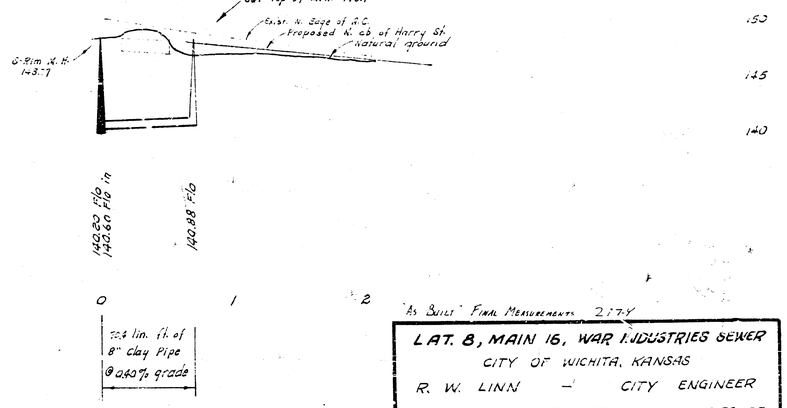

"As Built" Final Measurements 2-7-74

LAT. 8, MAIN 16, WAR INDUSTRIES SEWER

CITY OF WICHITA, KANSAS

R. W. LINN — CITY ENGINEER

FEB. 1973. PROJECT NO. DBKL 572077