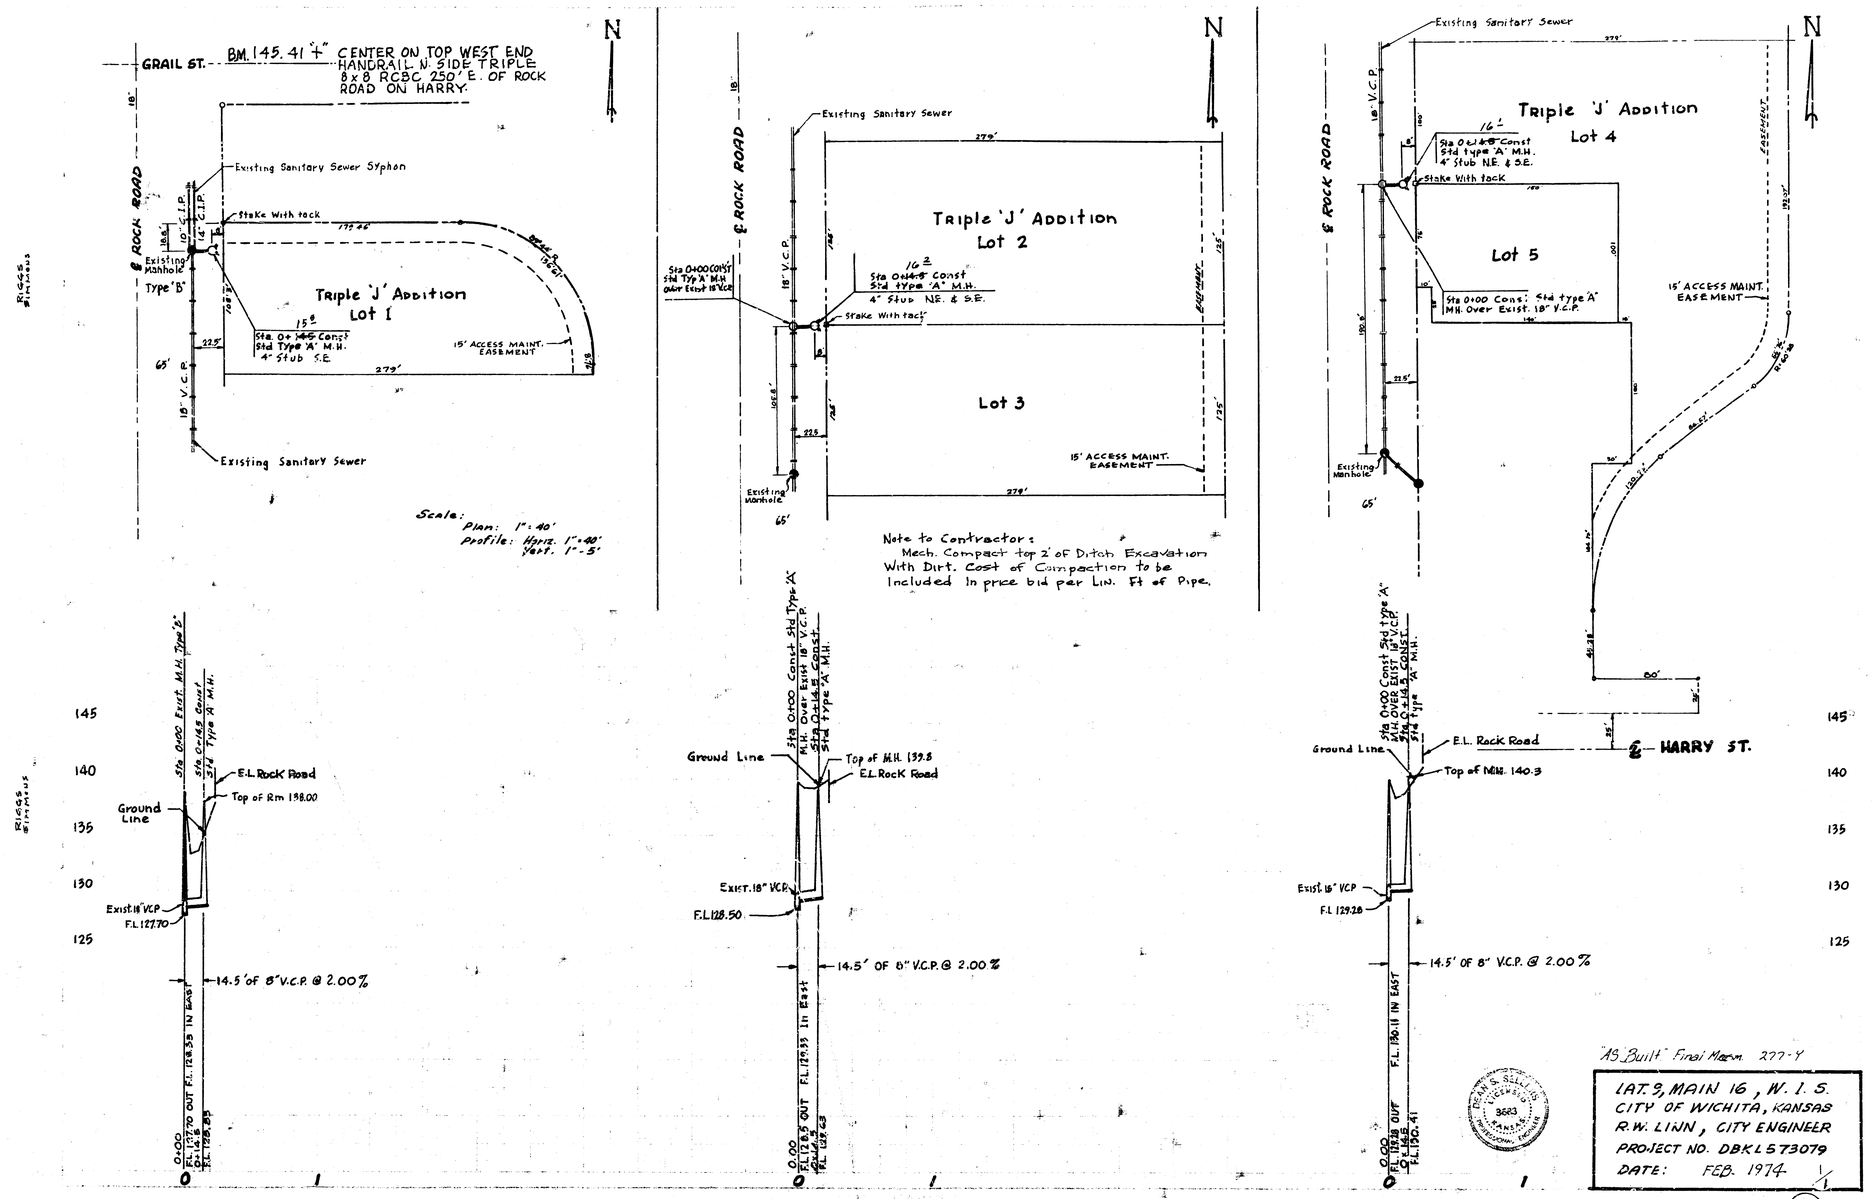

"As Built" Final Mapm. 277-Y

LAT. 3, MAIN 16, W. I. S.
CITY OF WICHITA, KANSAS
R.W. LINN, CITY ENGINEER
PROJECT NO. DBKL573079
DATE: FEB. 1974

FILMED FROM THE BEST AVAILABLE COPY....