
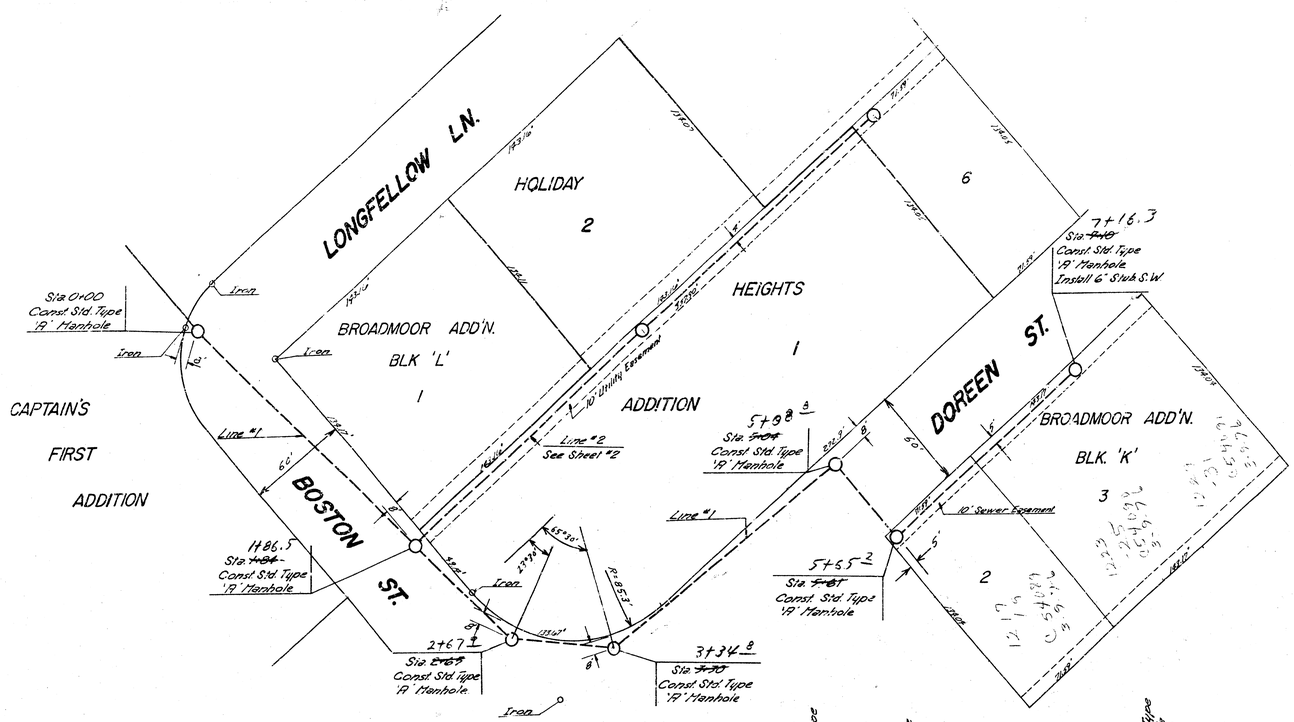


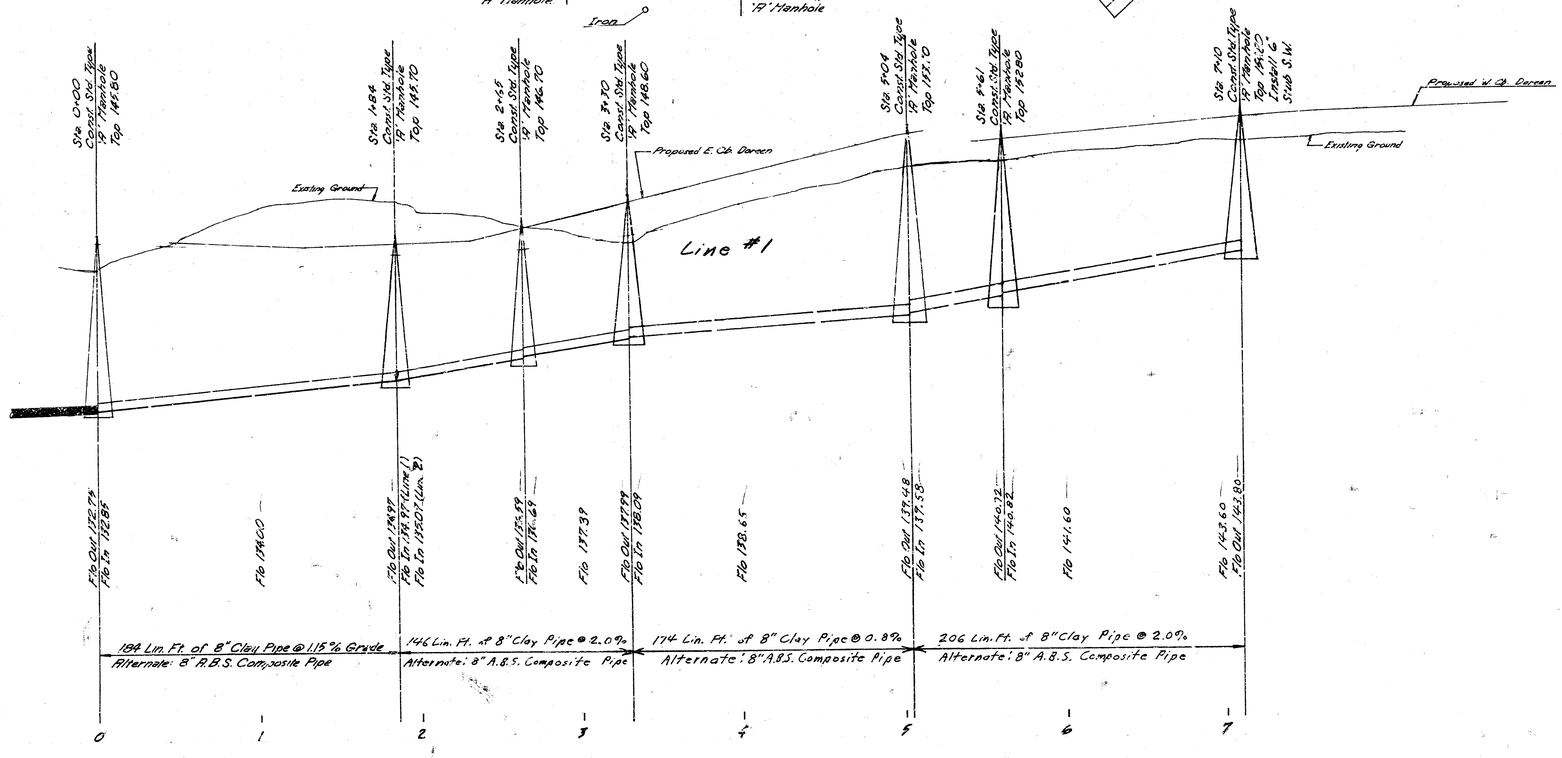


B.M. 1145.4' Chiseled "X" in Ctr. of top W. End Handrail N.S. Triple 8x8 R.C.B. 250' East of Rock Rd. on Harry.


SCALES:
PLAN: 1"=40'
PROFILE:
Hori. 1"=40'
Vert. 1"=5'

As Built 3-17-76

LAT. 11, MAIN 16, W.I.S.
CITY of WICHITA, KANSAS
R.W. LINN, – CITY ENGINEER
Project No. DBKL575051
DATE – Mar. 1976

Y
12

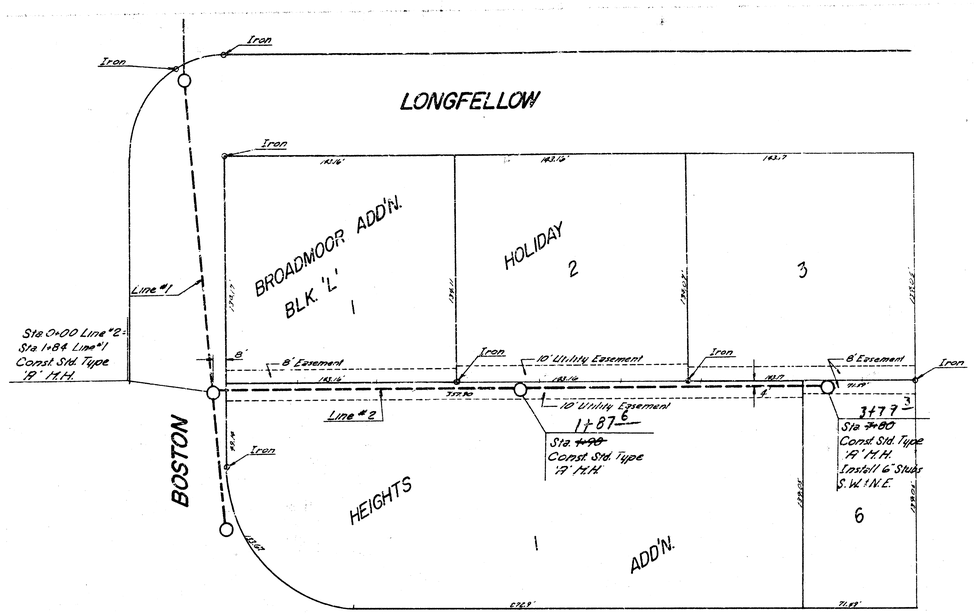

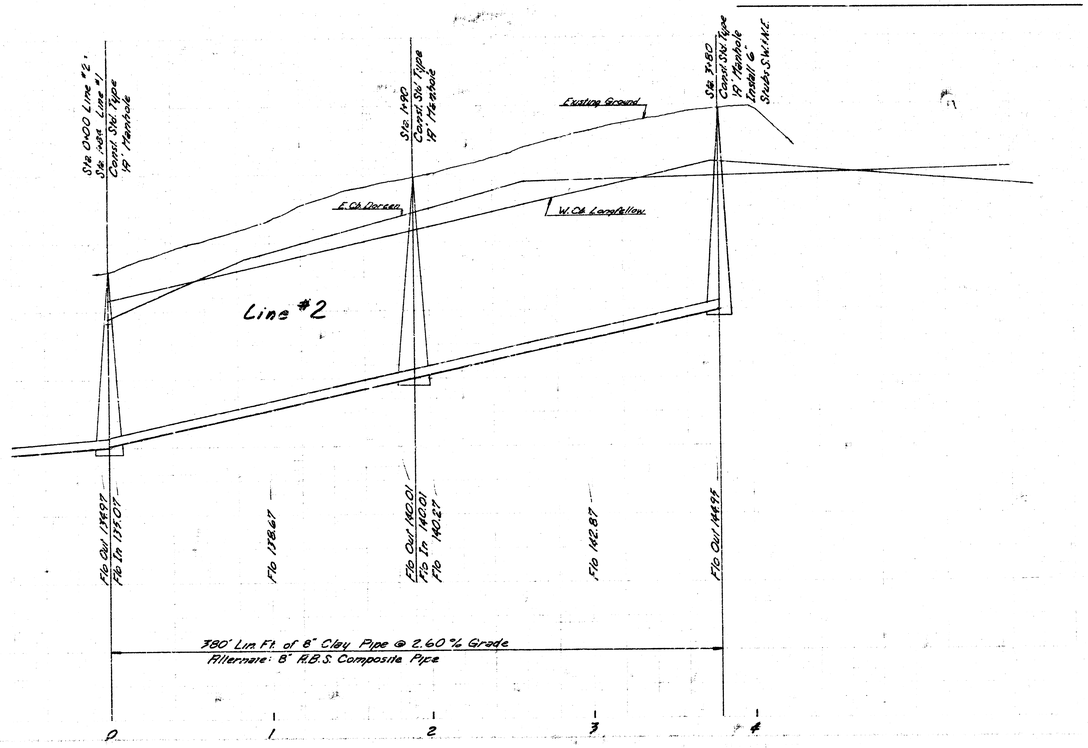

B.M. 145.41 Chiseled "x" Ctr. of top W. End Handrail N.S. Triple 8x8 R.C.B. 250' East of Rock Rd. on Harry

N

SCALE
Plan 1"=40'
Profile
Hort 1"=40'
Vert 1"=5'

LMT 11, MAIN 16, W.I.S
DBKL575051

2/2

14 8 4 50