
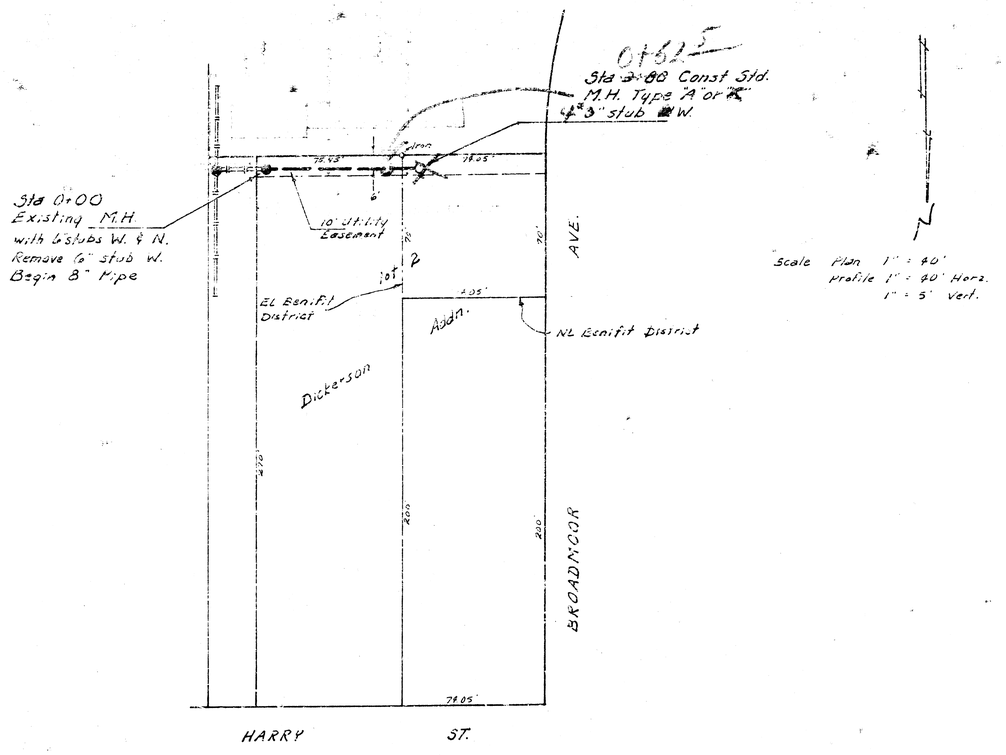


Sta 3+80 Const Std.
M.H. Type "A or C"
4"3" stub W.

Scale Plan 1" = 40'
Profile 1" = 40' Horz.
1" = 5' Vert.

B.M. 156.55 N.W. Corner of conc. walk & N. face of building on S.E. corner of Harry & Broadmoor.

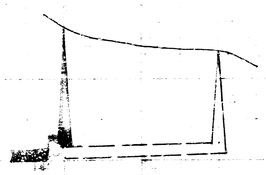

80 Lin. Ft. 8" [redacted] @ 0.90% Grade

Alternate A.B.S. Composite Pipe

As built 5-9-70

LAT 14, MAIN 16, WAR INDUSTRIES

CITY OF WICHITA, KANSAS

R. W. LINN — CITY ENGINEER

March 1970 PROJECT NO. DBKL577078

DONALD E. SPENCER 6311 REGISTERED PROFESSIONAL ENGINEER