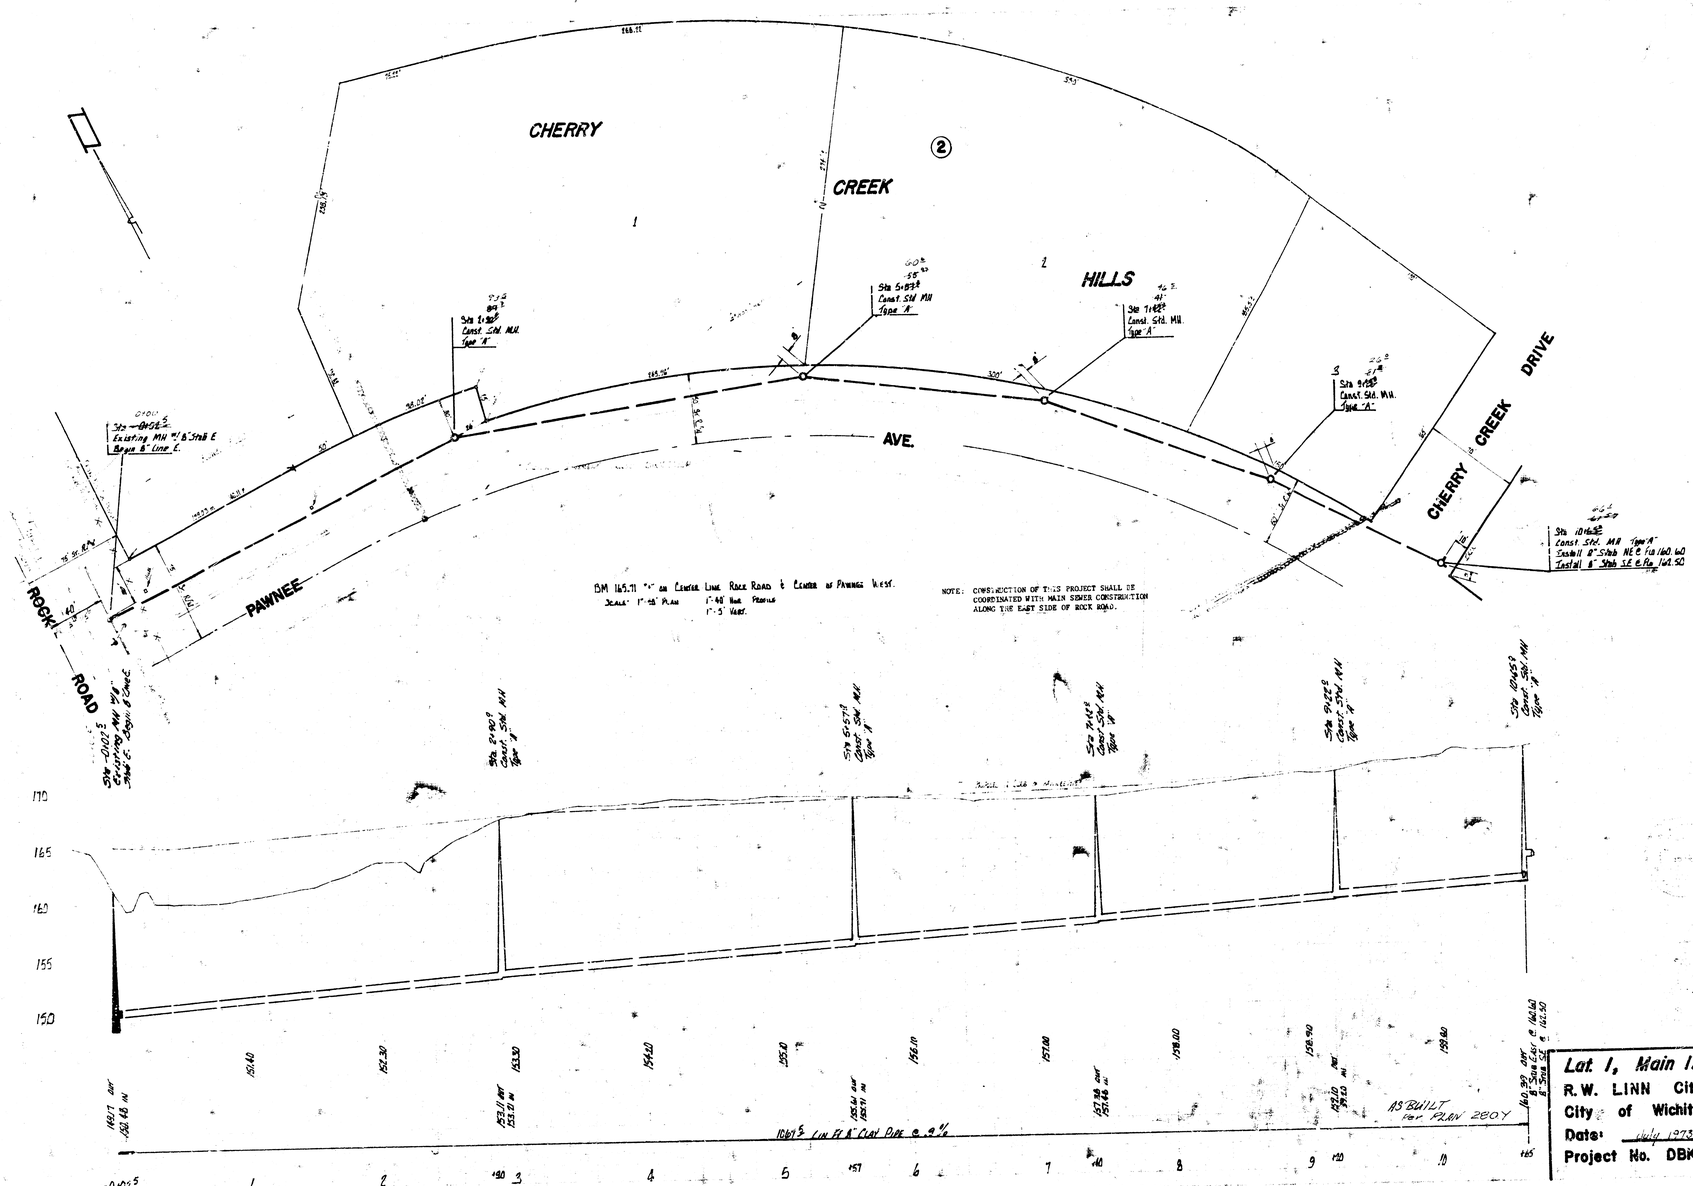
CHERRY
CREEK
HILLS
DRIVE
CHERRY CREEK
AVE.
PAWNEE
ROCK ROAD
BM 165.71 "+" on Center Line Rock Road & Center of Pawnee West.
Scale: 1"=40' Plan 1"=40' Horz. Profile 1"=5' Vert.
NOTE: CONSTRUCTION OF THIS PROJECT SHALL BE COORDINATED WITH MAIN SEWER CONSTRUCTION ALONG THE EAST SIDE OF ROCK ROAD.
Sta 0+00.5 Existing MH w/ 8" Stub E Begin 8" Line E.
Sta 1+32.5 Const. Std. MH Type "A"
Sta 5+87.5 Const. Std. MH Type "A"
Sta 7+82.5 Const. Std. MH. Type "A"
Sta 9+25.5 Const. Std. MH. Type "A"
Sta 10+62.5 Const. Std. MH Type "A" Install 8" Stub NE & Fla/160.40 Install 8" Stub SE & Fla/121.50
Sta -0+00.5 Existing MH w/ 8" Stub E. Begin 8" Line E.
Sta 2+90.5 Const. Std. MH Type "A"
Sta 5+57.5 Const. Std. MH Type "A"
Sta 7+45.5 Const. Std. MH Type "A"
Sta 9+22.5 Const. Std. MH Type "A"
Sta 10+62.5 Const. Std. MH Type "A"
170
165
160
155
150
156.40
152.30
153.30
154.40
155.0
156.10
157.10
158.10
158.90
159.60
160.99 INV. 8" Stub East @ 160.40 8" Stub West @ 160.50
160.17 INV. 158.48 IN
153.11 INV. 153.01 IN
155.40 INV. 155.11 IN
157.74 INV. 157.64 IN
152.0 INV. 151.0 IN
1061.5 Lin Ft 8" Clay Pipe @ 0.9%
AS BUILT For PLAN 280Y
-0+00.5
1
2
3
4
5
6
7
8
9
10
Lot 1, Main 17, W.I.S.
R.W. LINN City Engineer
City of Wichita, Kansas
Date: July 1973
Project No. DBKL573012