

BM 165.71 'X' on Center Line of Rock Rd & Center of Pawnee West

SCALE:
Plan 1"=40' Profile 1"=40' Hor.
1"=5' Vert.

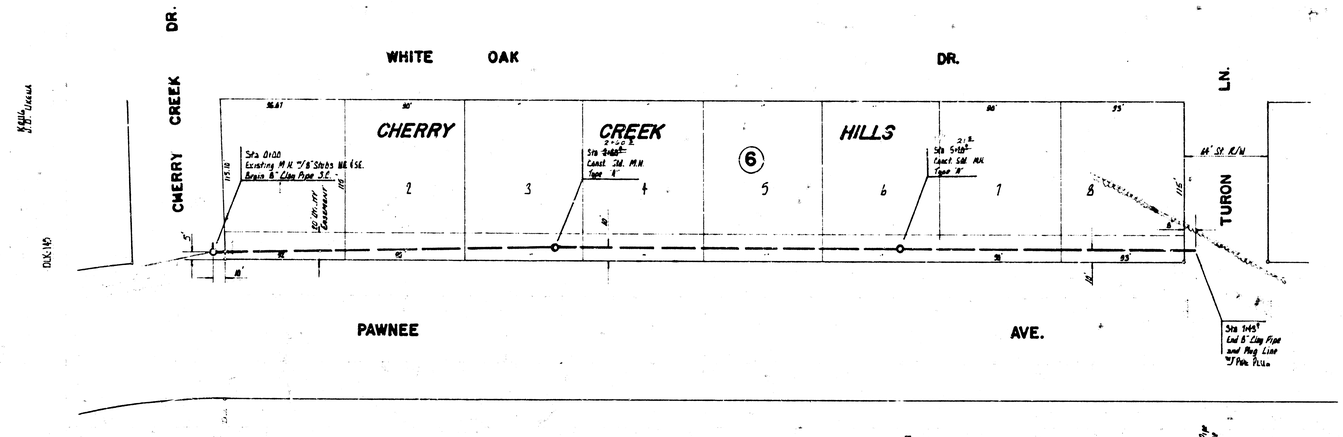

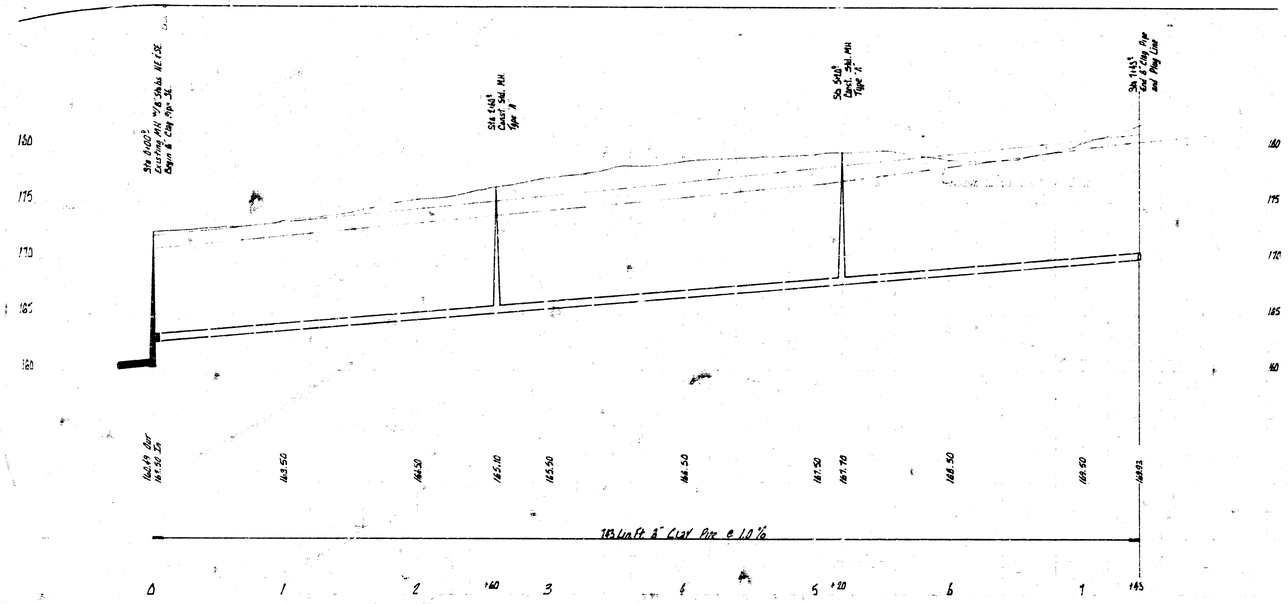

NOTE: CONSTRUCTION OF THIS PROJECT SHALL BE COORDINATED WITH MAIN SEWER CONSTRUCTION ALONG THE EAST SIDE OF ROCK ROAD.

"As Built" Final Mass 260 ft

Lat. 2, Main 17, W.I.S.
R. W. LINN City Engineer
City of Wichita, Kansas
Date: July 1973
Project No. DBKL 573013

14 2 5 12