

B.M. - 1986 R.R. Spike E. Side 2" pole 30' N. of intersection of ℄ OAK KNOLL & Broq Co. Driveway.

CAUTION
UNDERGROUND UTILITIES
Please check with K.G.&.F. or Subdivision Bull Telephone Co. for location

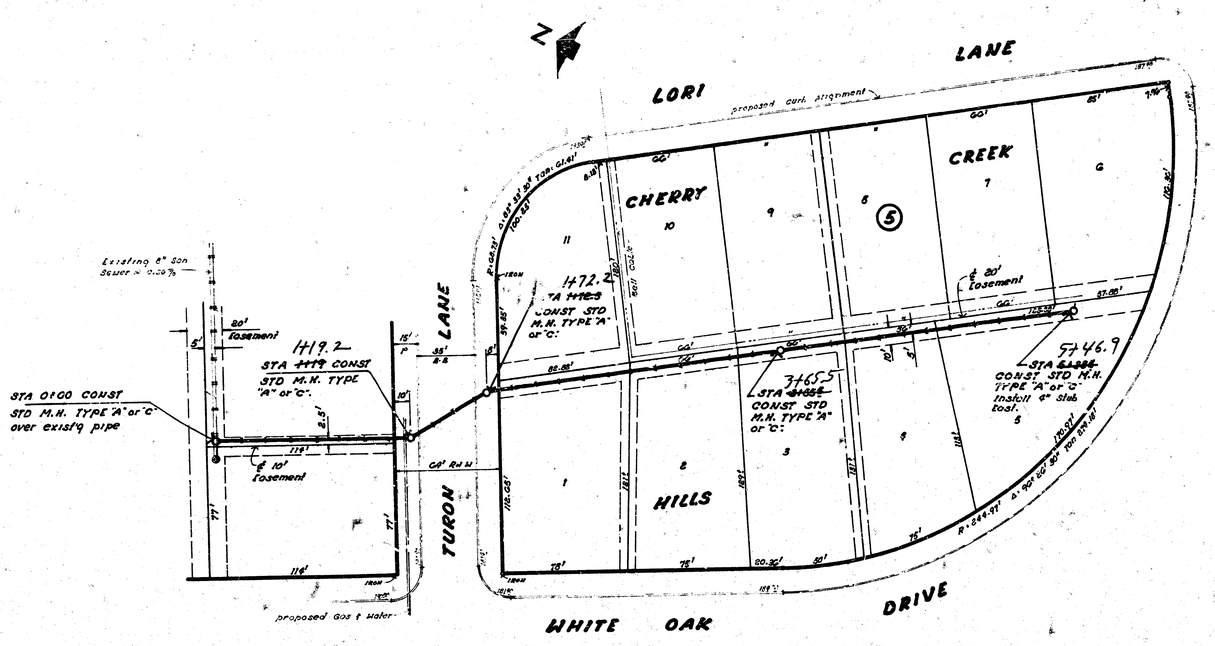

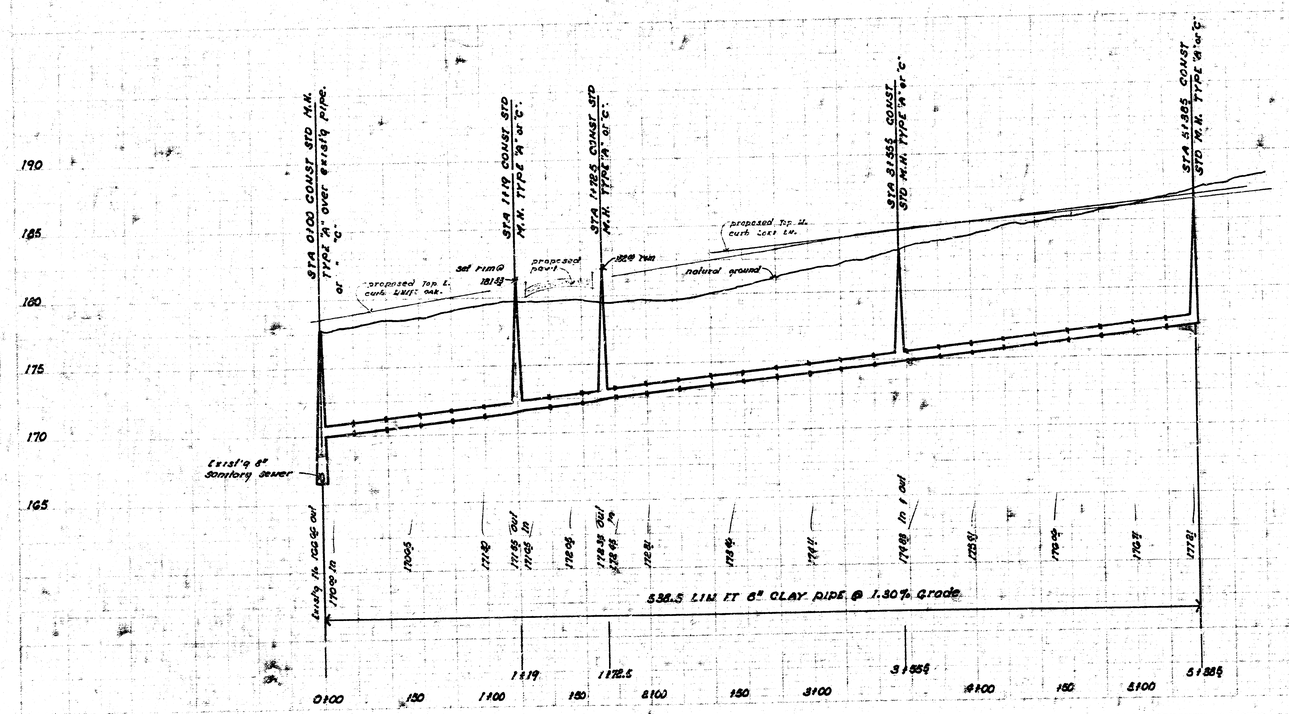

plan scale 1" = 40'
profile 1" = 40' Horz
" = 5' Vert

DONALD E. SCHNEIDER LICENSED 6311 KANSAS PROFESSIONAL ENGINEER

As Built 7-29-75

LAT. C, MAIN 17, W.L.S.
CITY OF WICHITA, KANSAS
R. W. LINN CITY ENGINEER
DATE PROJ. NO. DBKL 573017

1/1

14 2 3 2