





B. M. 198.26 R.R. Spk. E.S. P.P. 30 North of
Intersection of Oak Knoll & Bray Co. Driveway.
B. M. 178.06 on east rim M.H. @ S.E. cor lot 8
Blk. 8 Cherry Creek Hills Addn.

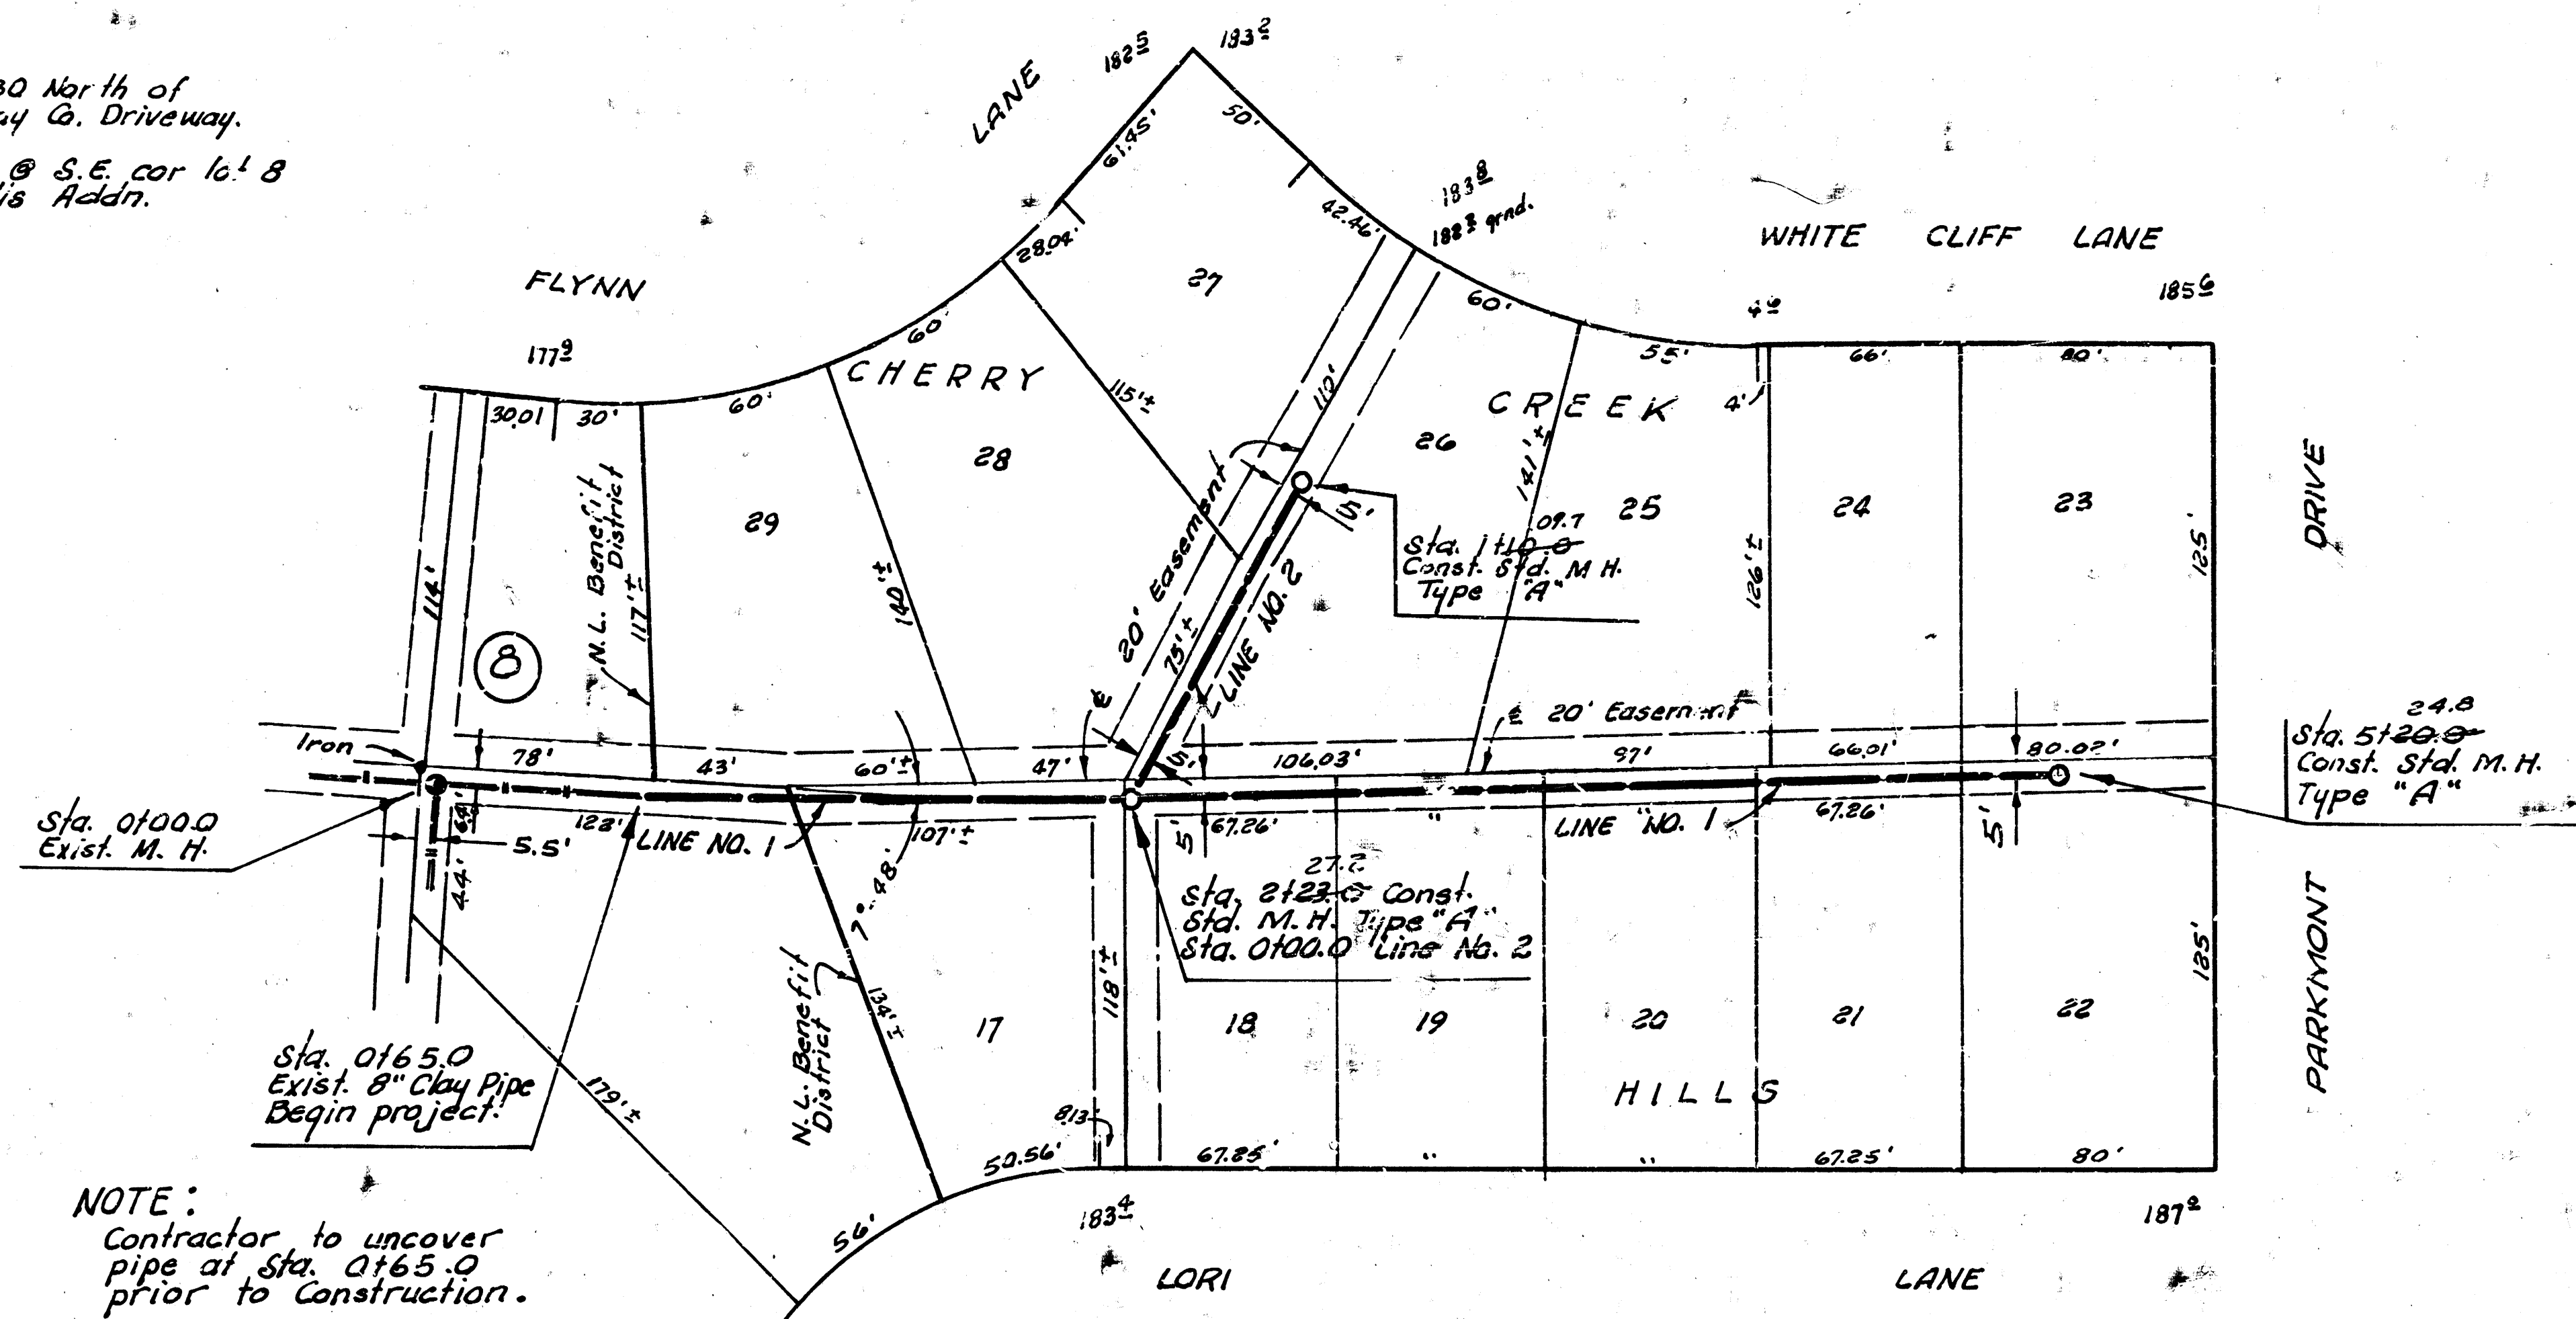

NOTE:
Contractor to uncover
pipe at Sta. 0+65.0
prior to construction.

Plan Scale 1" = 40'
Profile Scale 1" = 40' Horiz.
1" = 5' Vert.

185
180
175
170
165
160

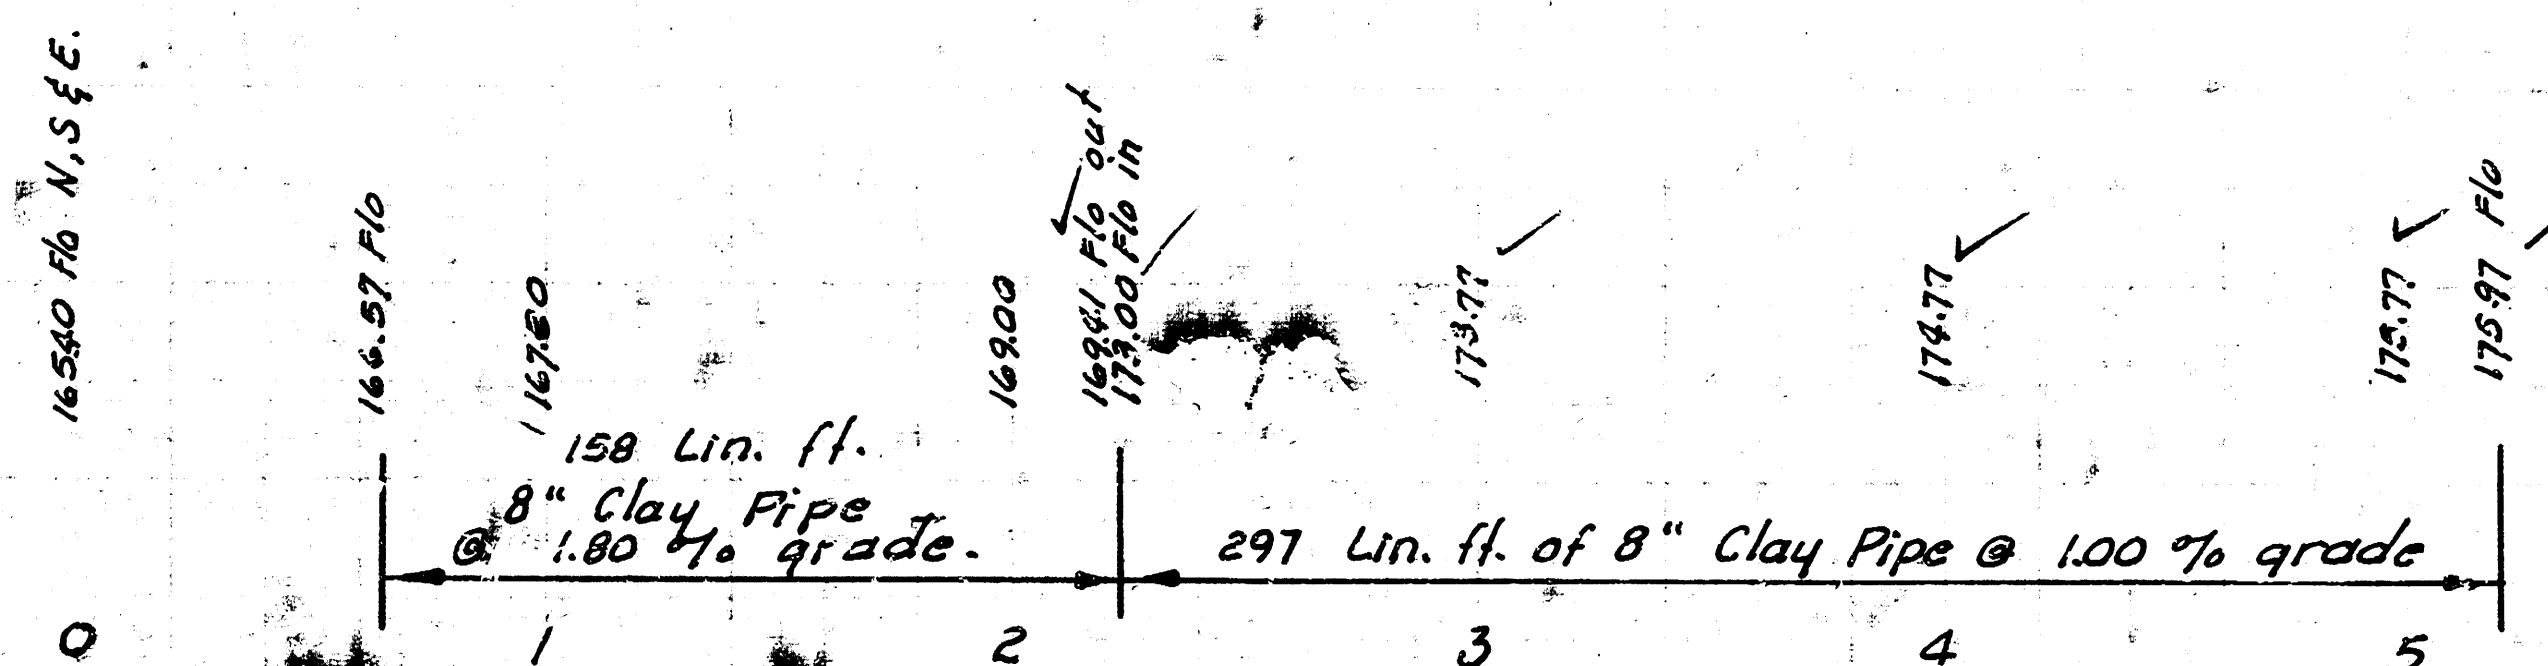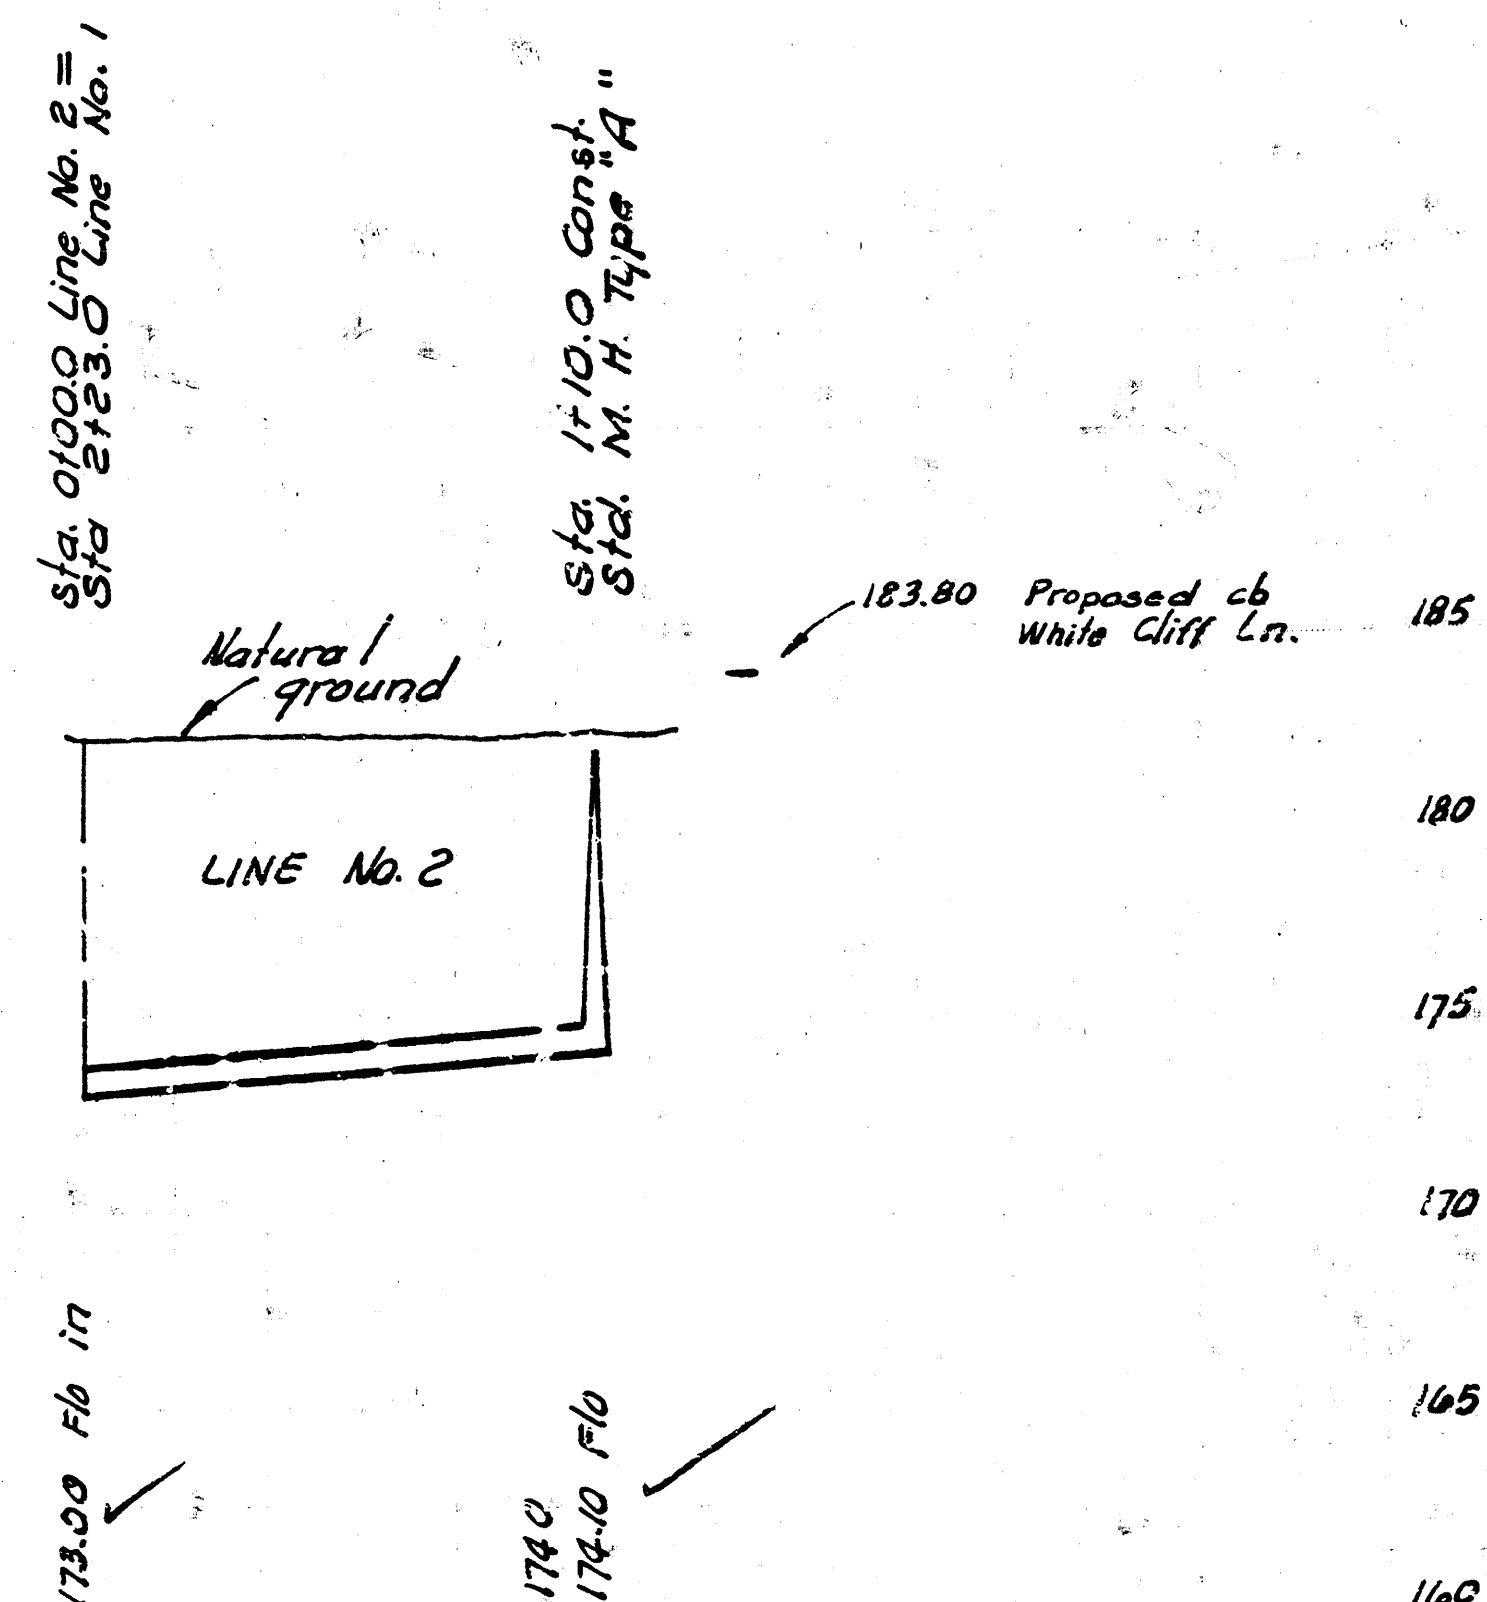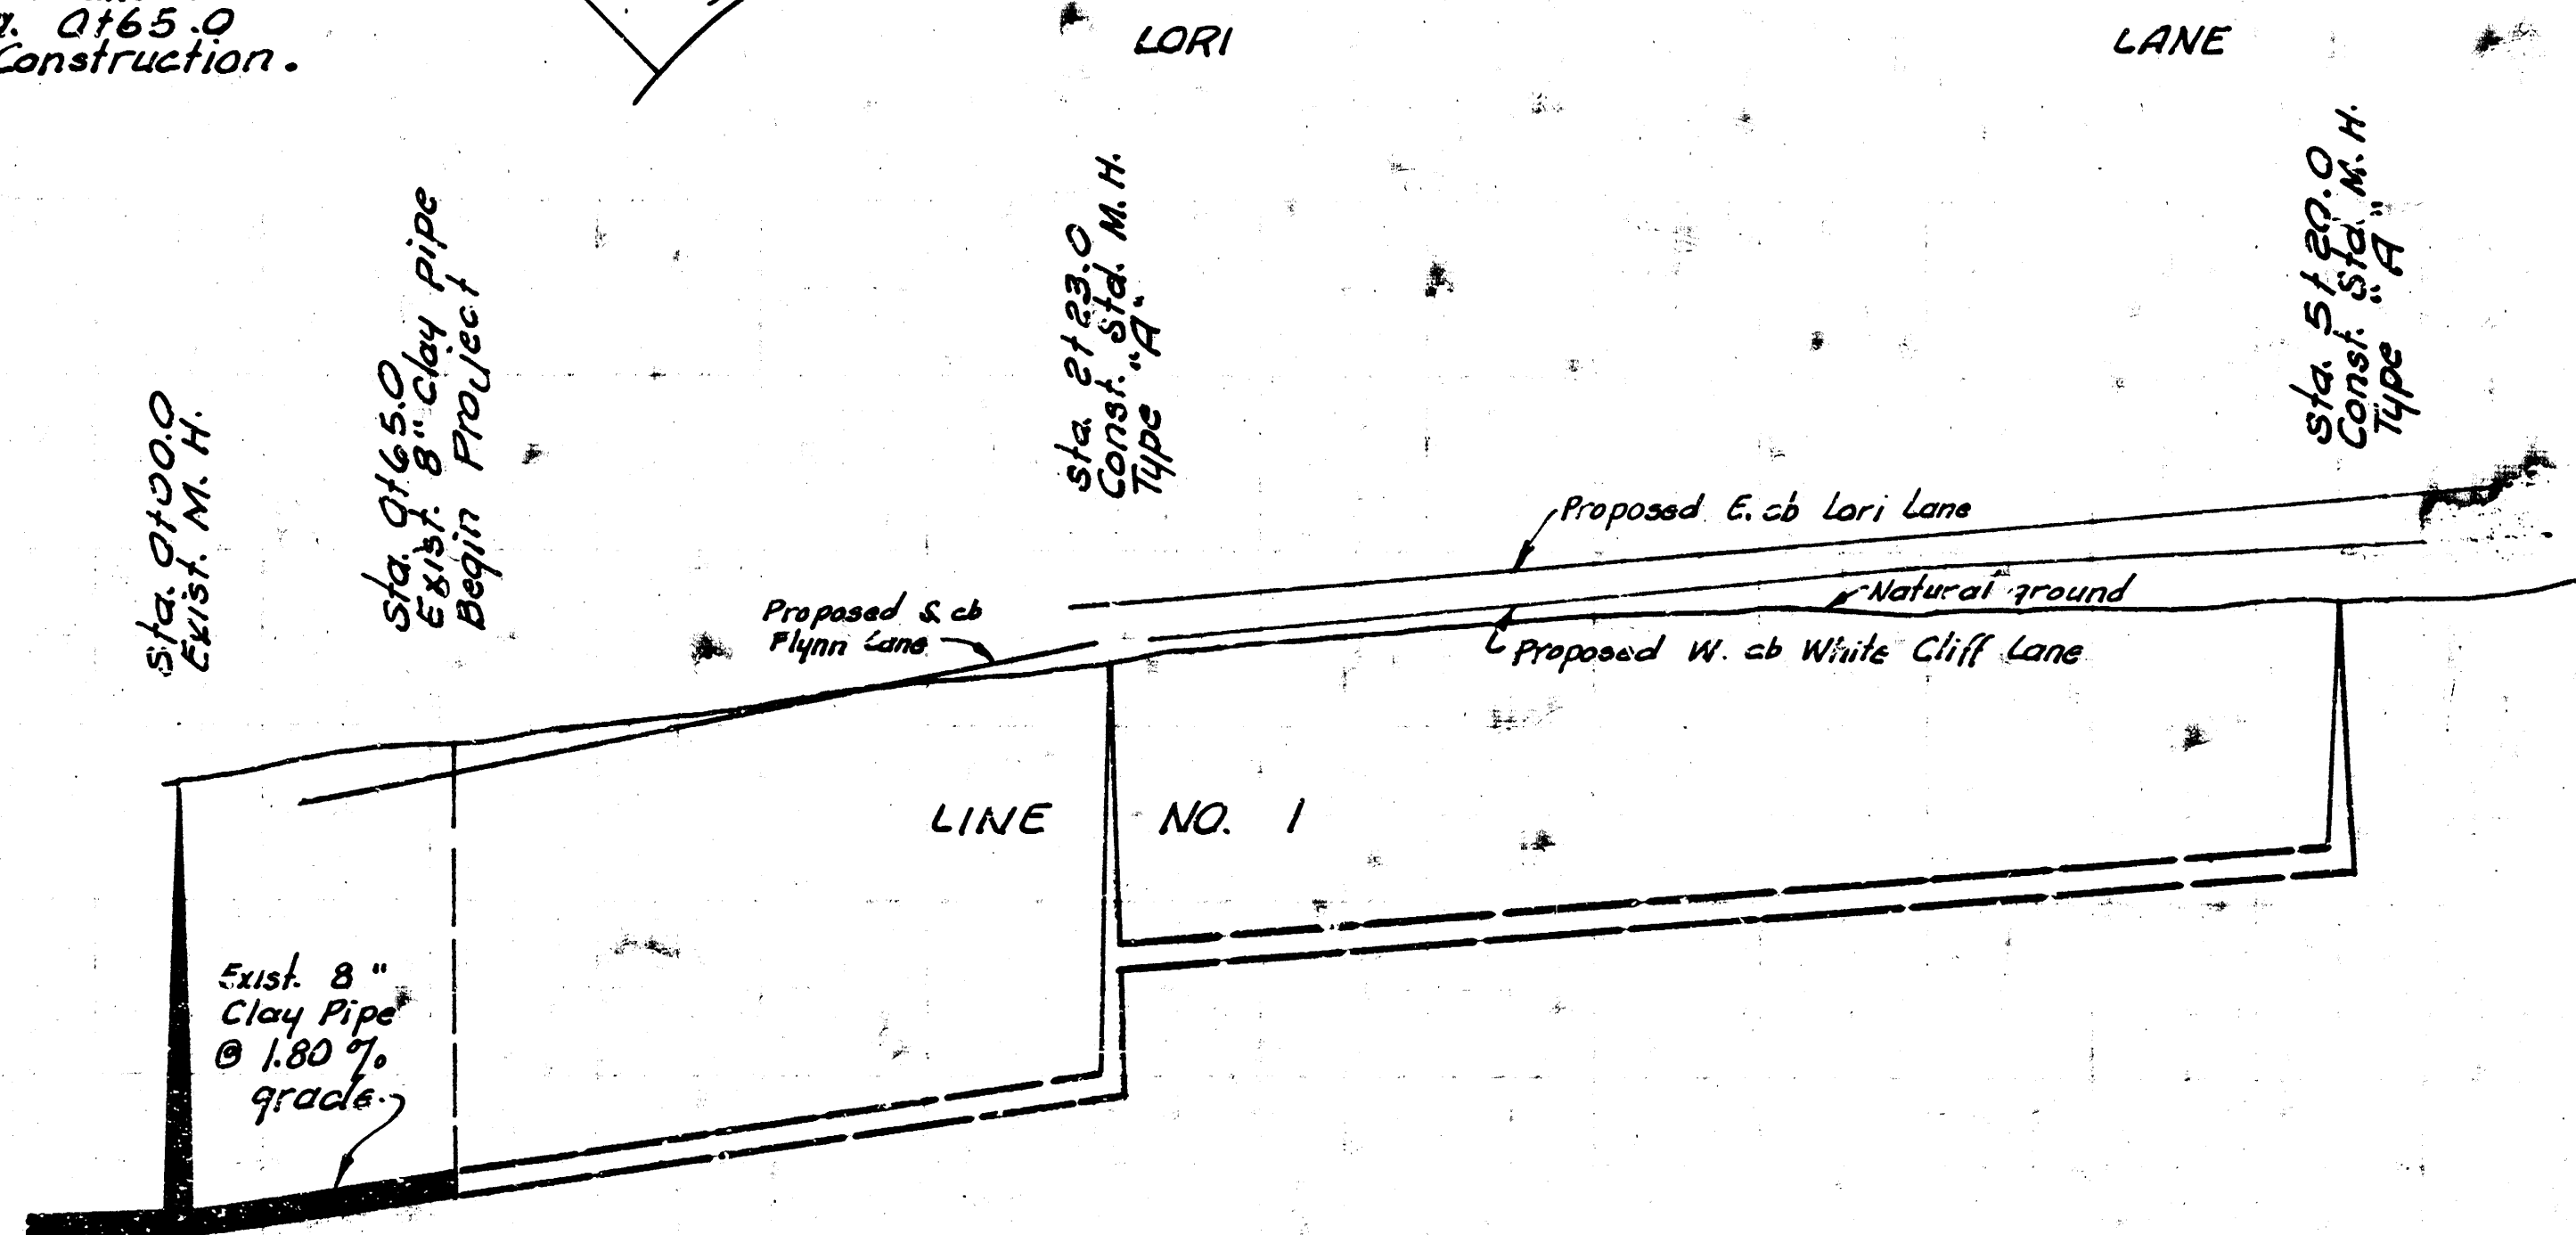

LAT. 7, MAIN 17, W. I. S.
CITY OF WICHITA, KANSAS
R. W. LINN - CITY ENGINEER
MAY 1974 PROJECT NO. DBKL573018