



B. M. 178.06 on E. Rim Manhole @ S.E. cor. lot @ Block 8, Cherry Creek Hills.  
 B. M. 172.42 on N. Rim Manhole 109.2 east E.L. Lori Lane & 8' North of Cherry Creek Drive.

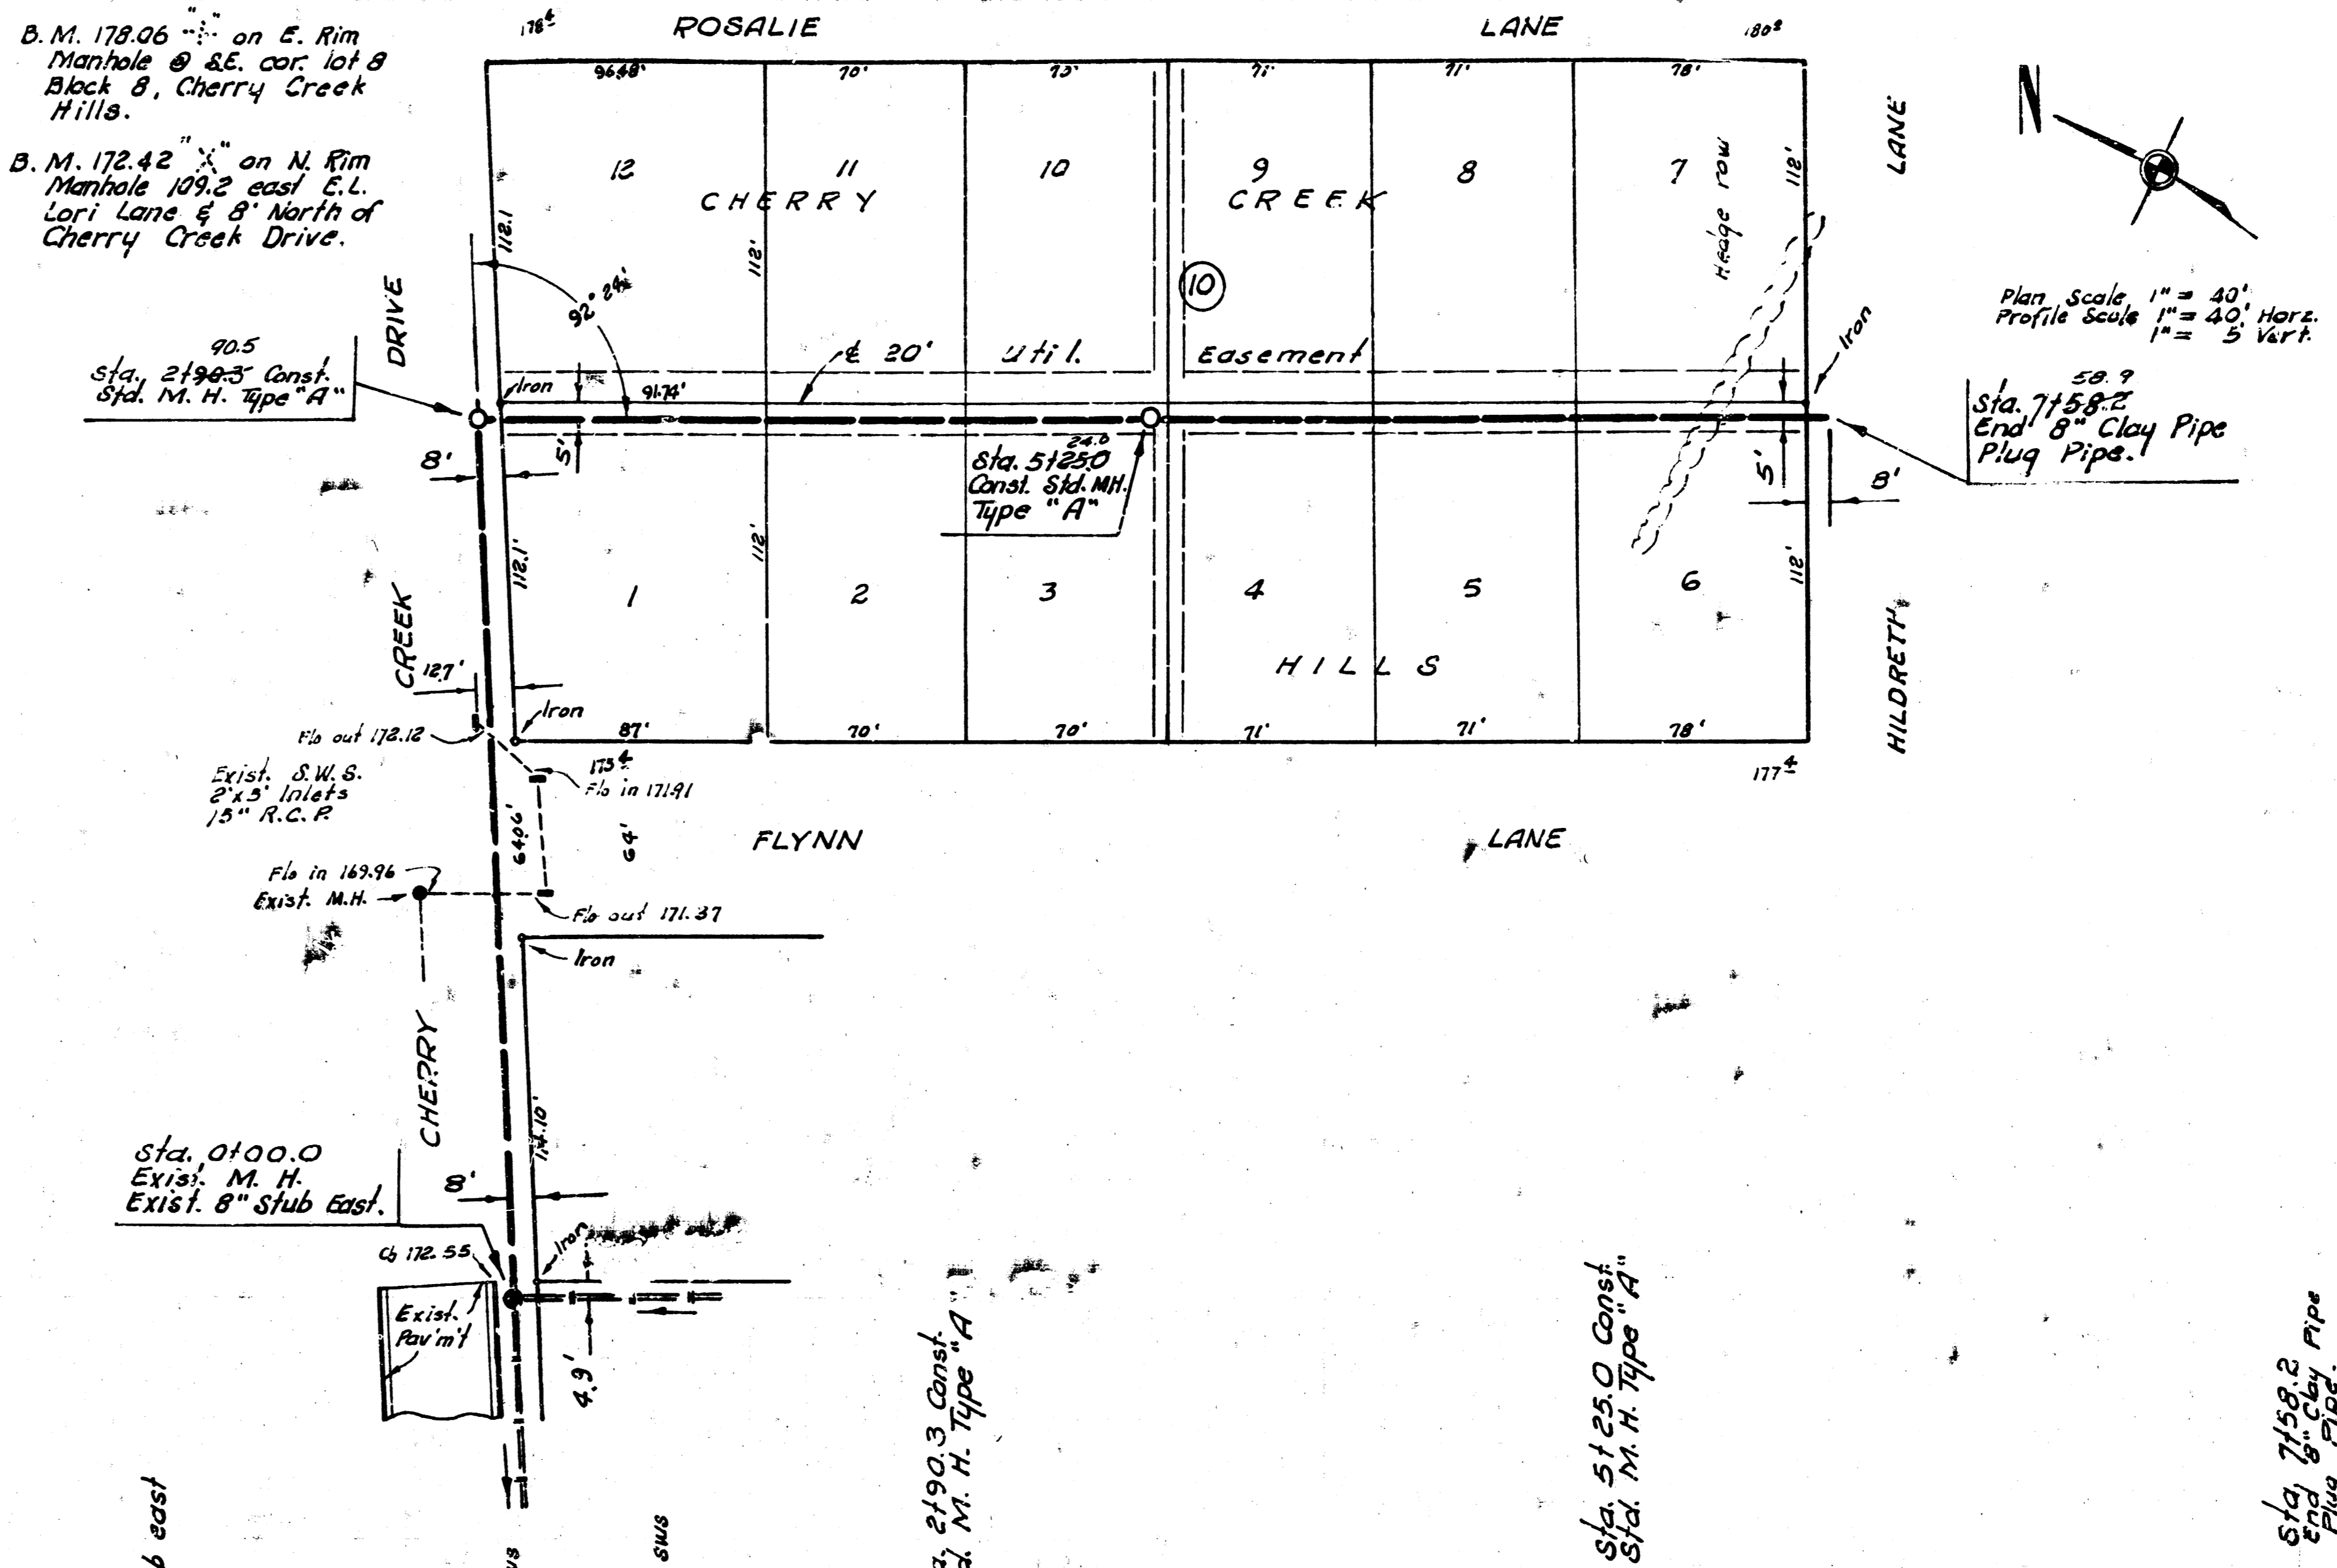

Plan Scale 1" = 40'  
 Profile Scale 1" = 5' Vert.

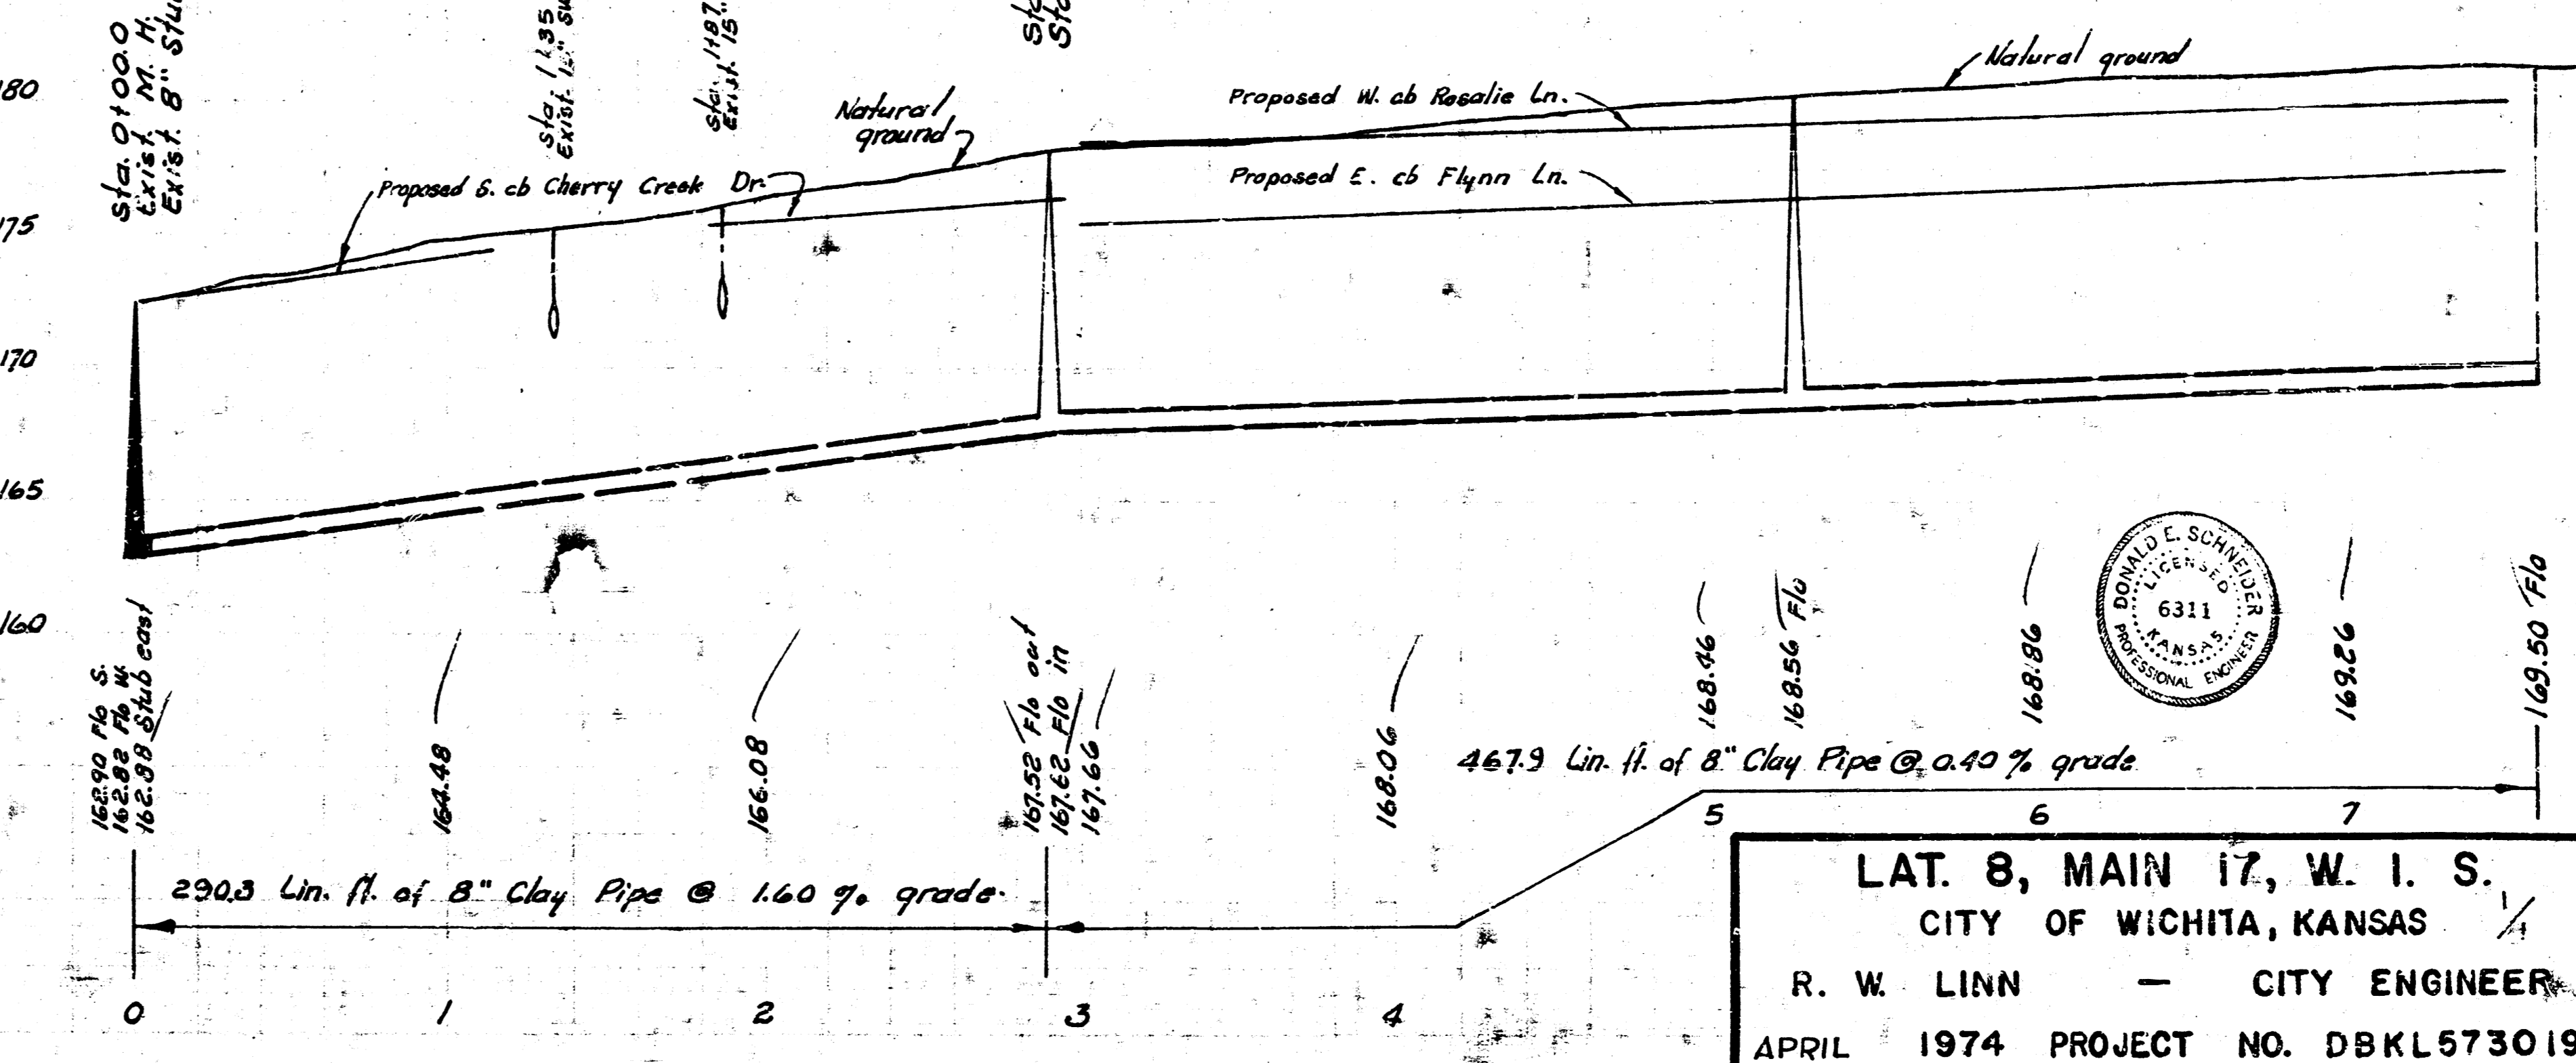

LAT. 8, MAIN 17, W. I. S.  
 CITY OF WICHITA, KANSAS  
 R. W. LINN - CITY ENGINEER  
 APRIL 1974 PROJECT NO. DBKL573019

FILMED FROM THE ORIGINAL