LAT. 10, MAIN 17, WAR INDUSTRIES SEWER


CITY OF WICHITA, KANSAS

R. W. LINN - CITY ENGINEER

SEPT. 1973, PROJECT NO. DBKM 573043

N

1" = 100'

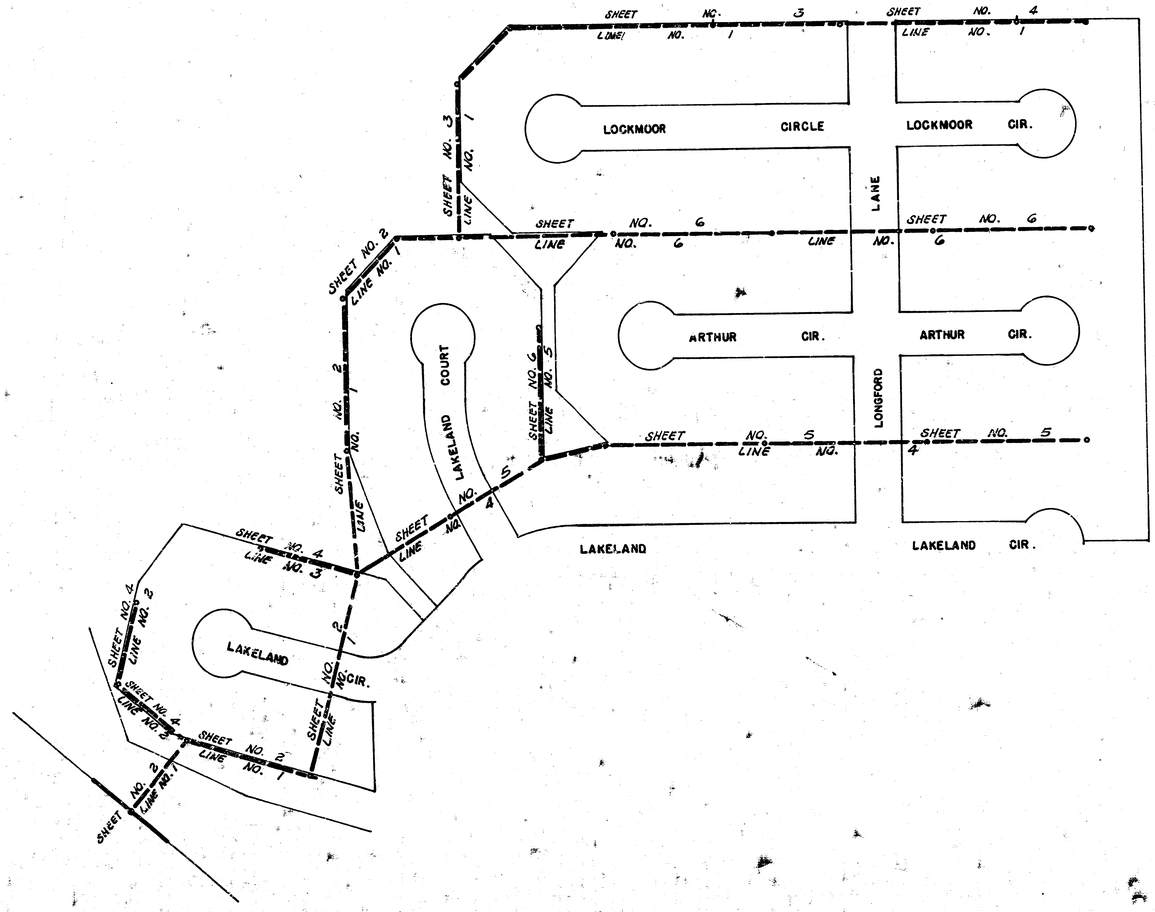

"As Built" final Mees. 279-4

1/6

1/6

LAT. 10, MAIN 17, WAR INDUSTRIES SEWER
PROJECT NO. DBKL 573043


B. M. #1 City Std. 42' W. & 48' So. of ¼ Sec. cor. ⅛ mi. E. of Rock Rd. & E Harry Elev. 824

B. M. #2 "+" on NW cor. N. Handrail R.C.B.C. on Harry 238' E. of E Rock Rd. Elev. 845.41

B. M. #3 "a" cut NW. cor. N. Headwall 85' W. of W.L. Longford Lane So. on Harry St. Elev. 859.08


B. M. #4 Top steel T-fnc. Post 38' N. of N.L. Longford Lane & E.L. Cedar Lakes Addn. Elev. 864.53

B. M. #5 "a" cut NW. cor. N. wing wall on Dam app. 130' S. of Lakeland Cir. Elev. 853.495

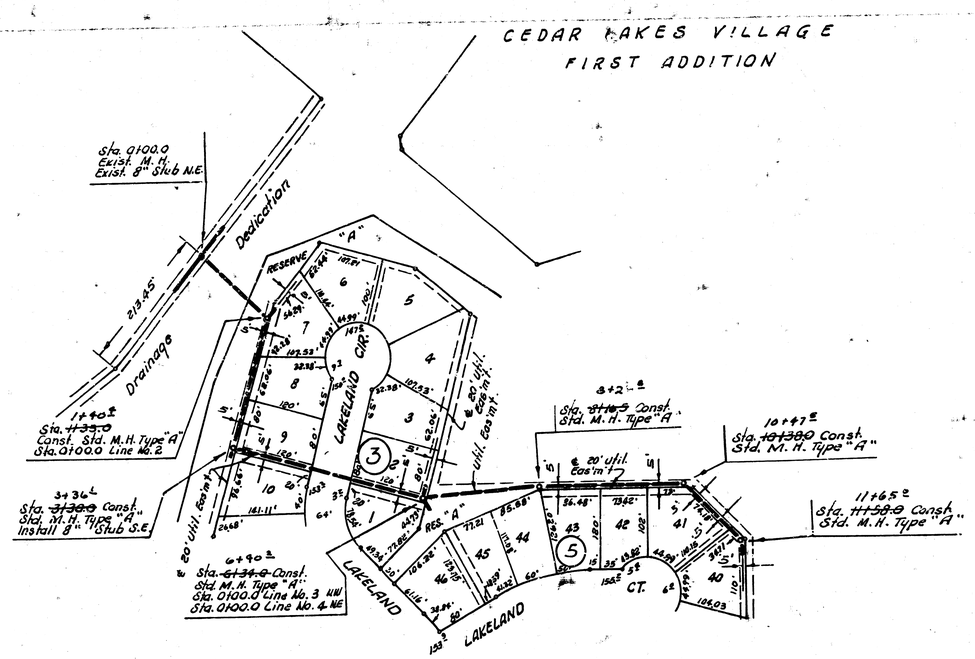

Plan Scale 1" = 100'
Profile Scale 1" = 40' Horz.
1" = 5' Vert.


• Irons set

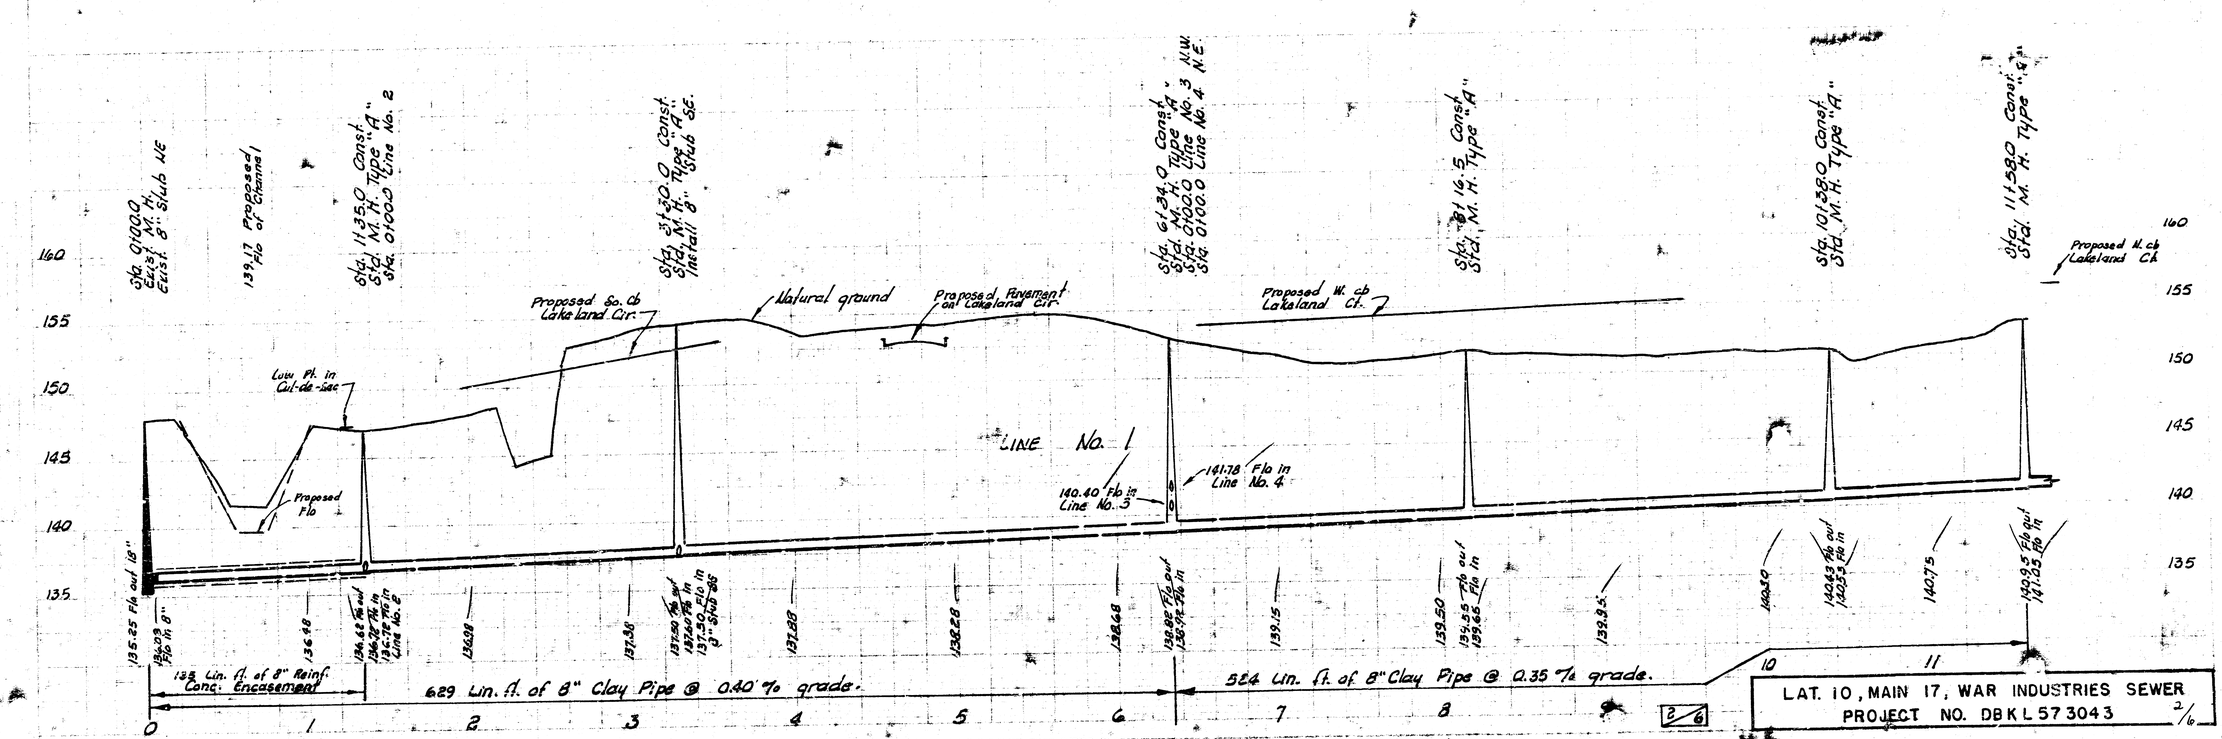


LAT. 10, MAIN 17, WAR INDUSTRIES SEWER
PROJECT NO. DBKL 573043

2/6

CEDAR LAKES - VILLAGE
FIRST ADDITION

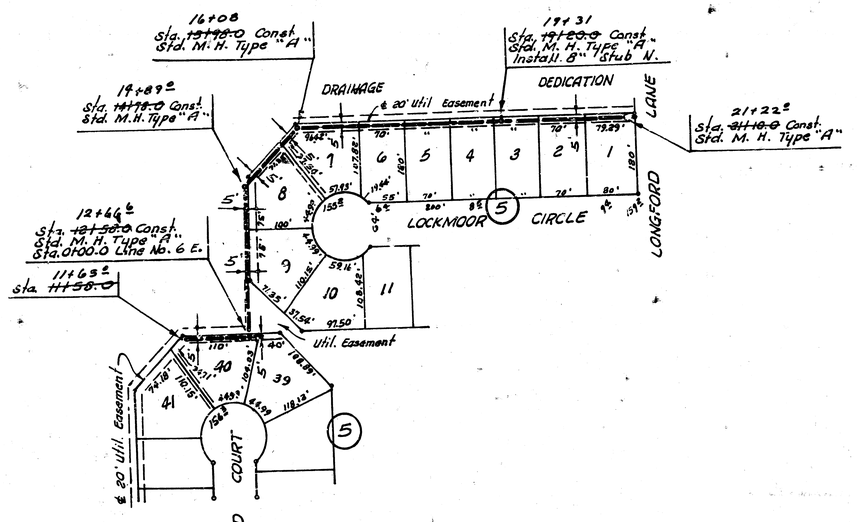


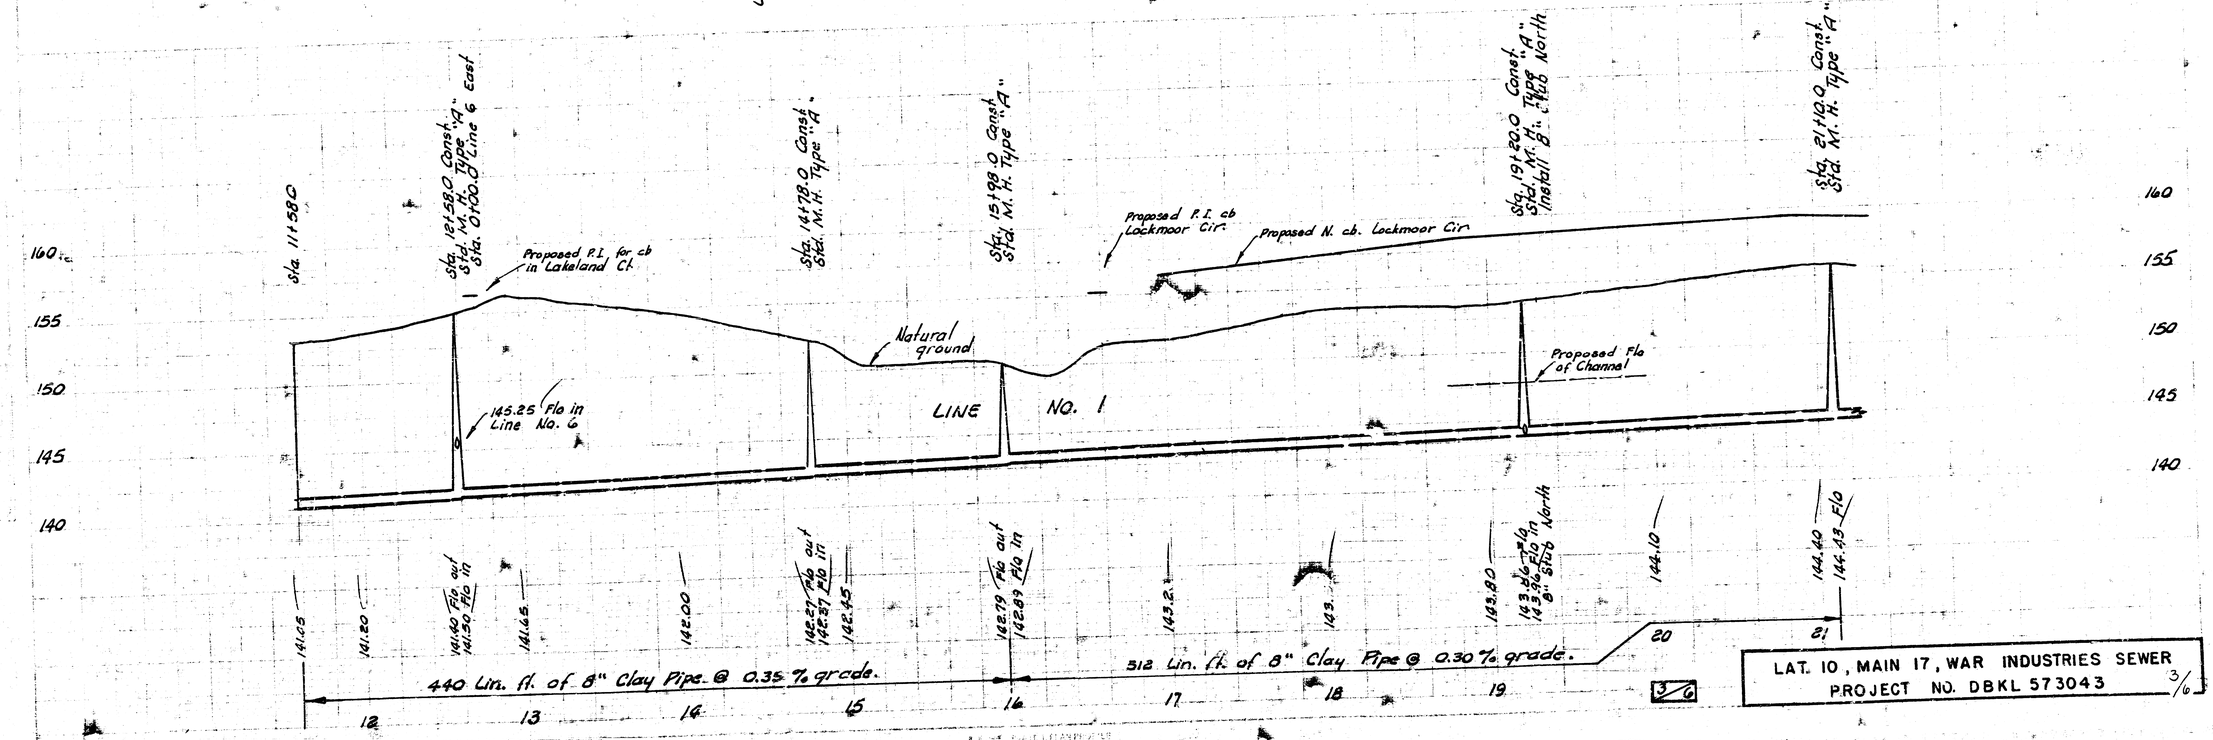


Pg. 12


LAT. 10, MAIN 17, WAR INDUSTRIES SEWER
PROJECT NO. DBKL 573043


CEDAR LAKE VILLAGE
FIRST ADDITION

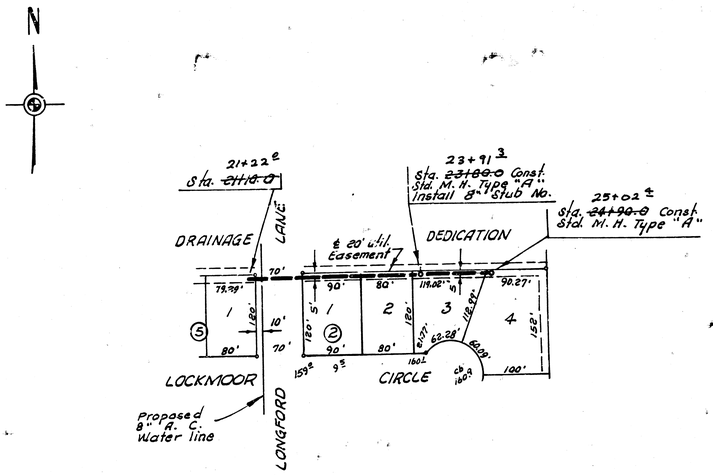

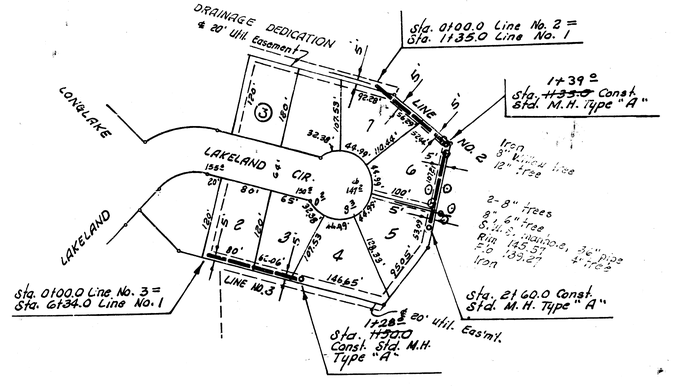


Pg. 11, 12

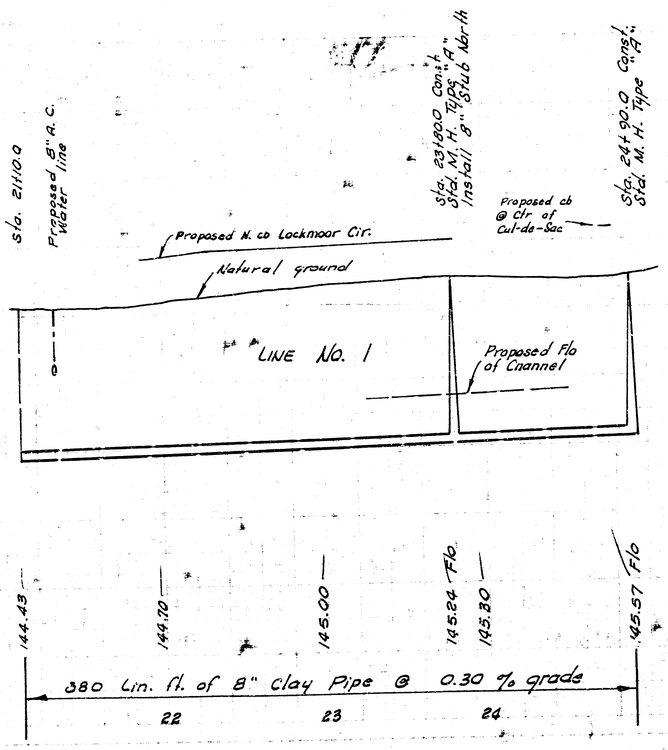

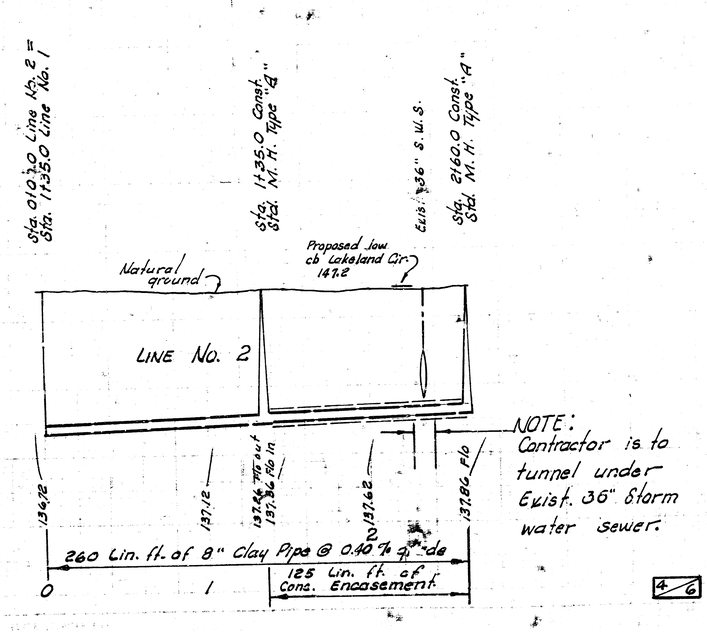


Pg. 5, 6

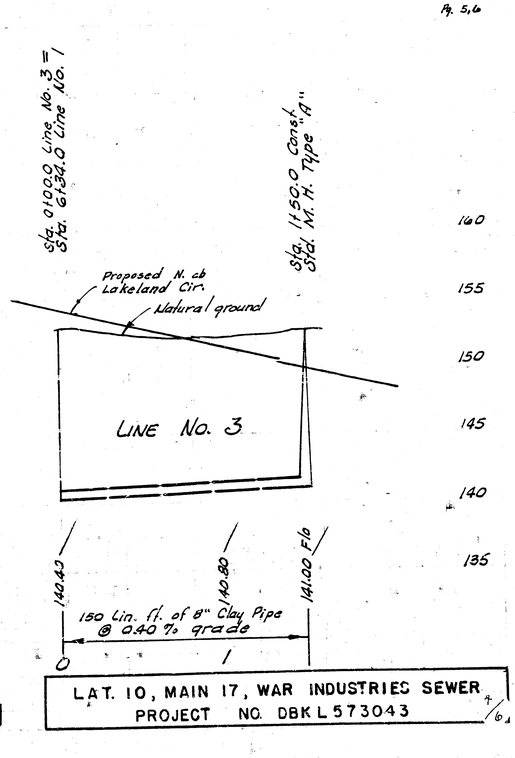


LAT. 10, MAIN 17, WAR INDUSTRIES SEWER
PROJECT NO. DBK L 573043

5/6

CEDAR LAKES VILLAGE
FIRST ADDITION

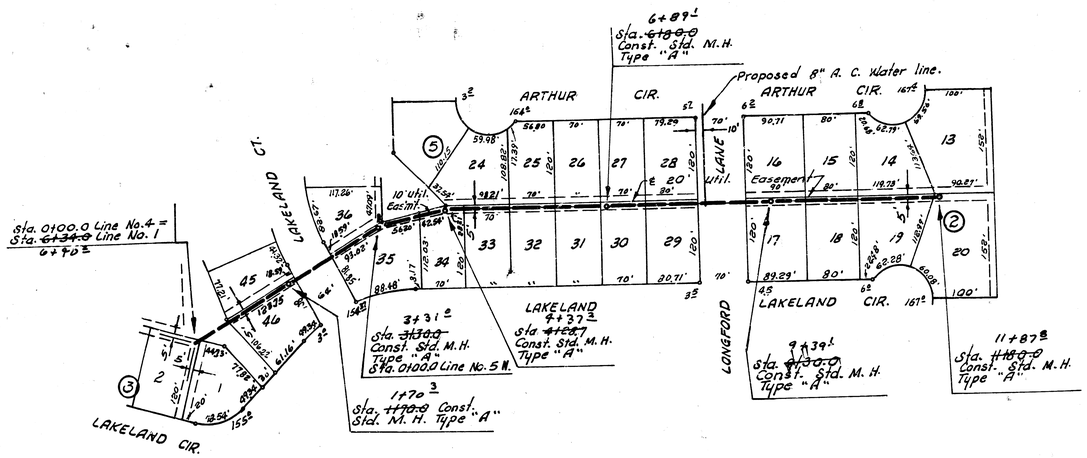

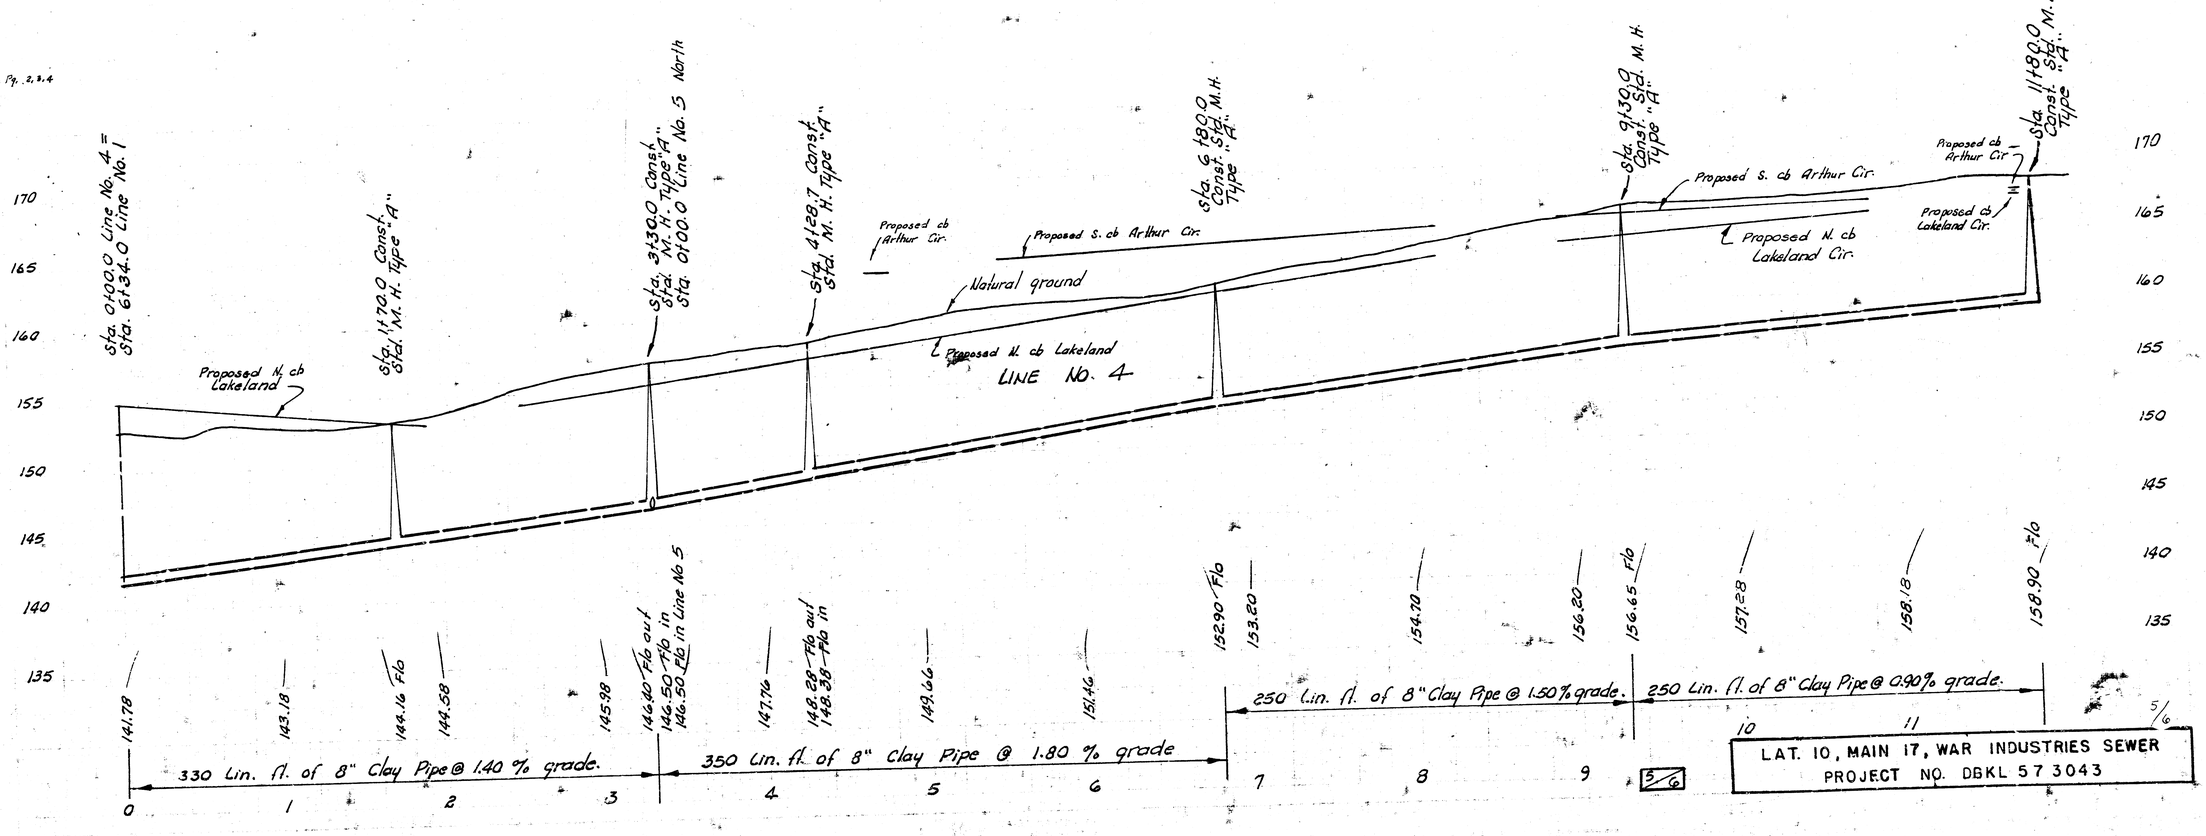

CEDAR LAKES VILLAGE
FIRST ADDITION

