





B. M. 153.50 "a" cut NW cor. N-Wing wall on top of dam app. 130' S. of Lakeland Circle.
 B. M. 164.53 Top steel T. Pnc. P 38' N. of N.L. Longford Lane & E.L. Cedar Lakes Adorn.


Plan Scale 1" = 40' Horiz.
 Profile Scale 1" = 5' Vert.

NOTE:
 Tie Conc. Cradle to manholes with 4 - 3" # 4 Steel bars.
 Bid price of Lin. ft. of conc. Cradle is to include the steel.
 Conc. Cradle may be deleted with the approval of the field Engineer.

NOTE:
 The bid price of Lump Sum Clearing Right-of-Way to include all cost of removing trees, hedges, stumps and any other items in the way of the construction of the sewer.

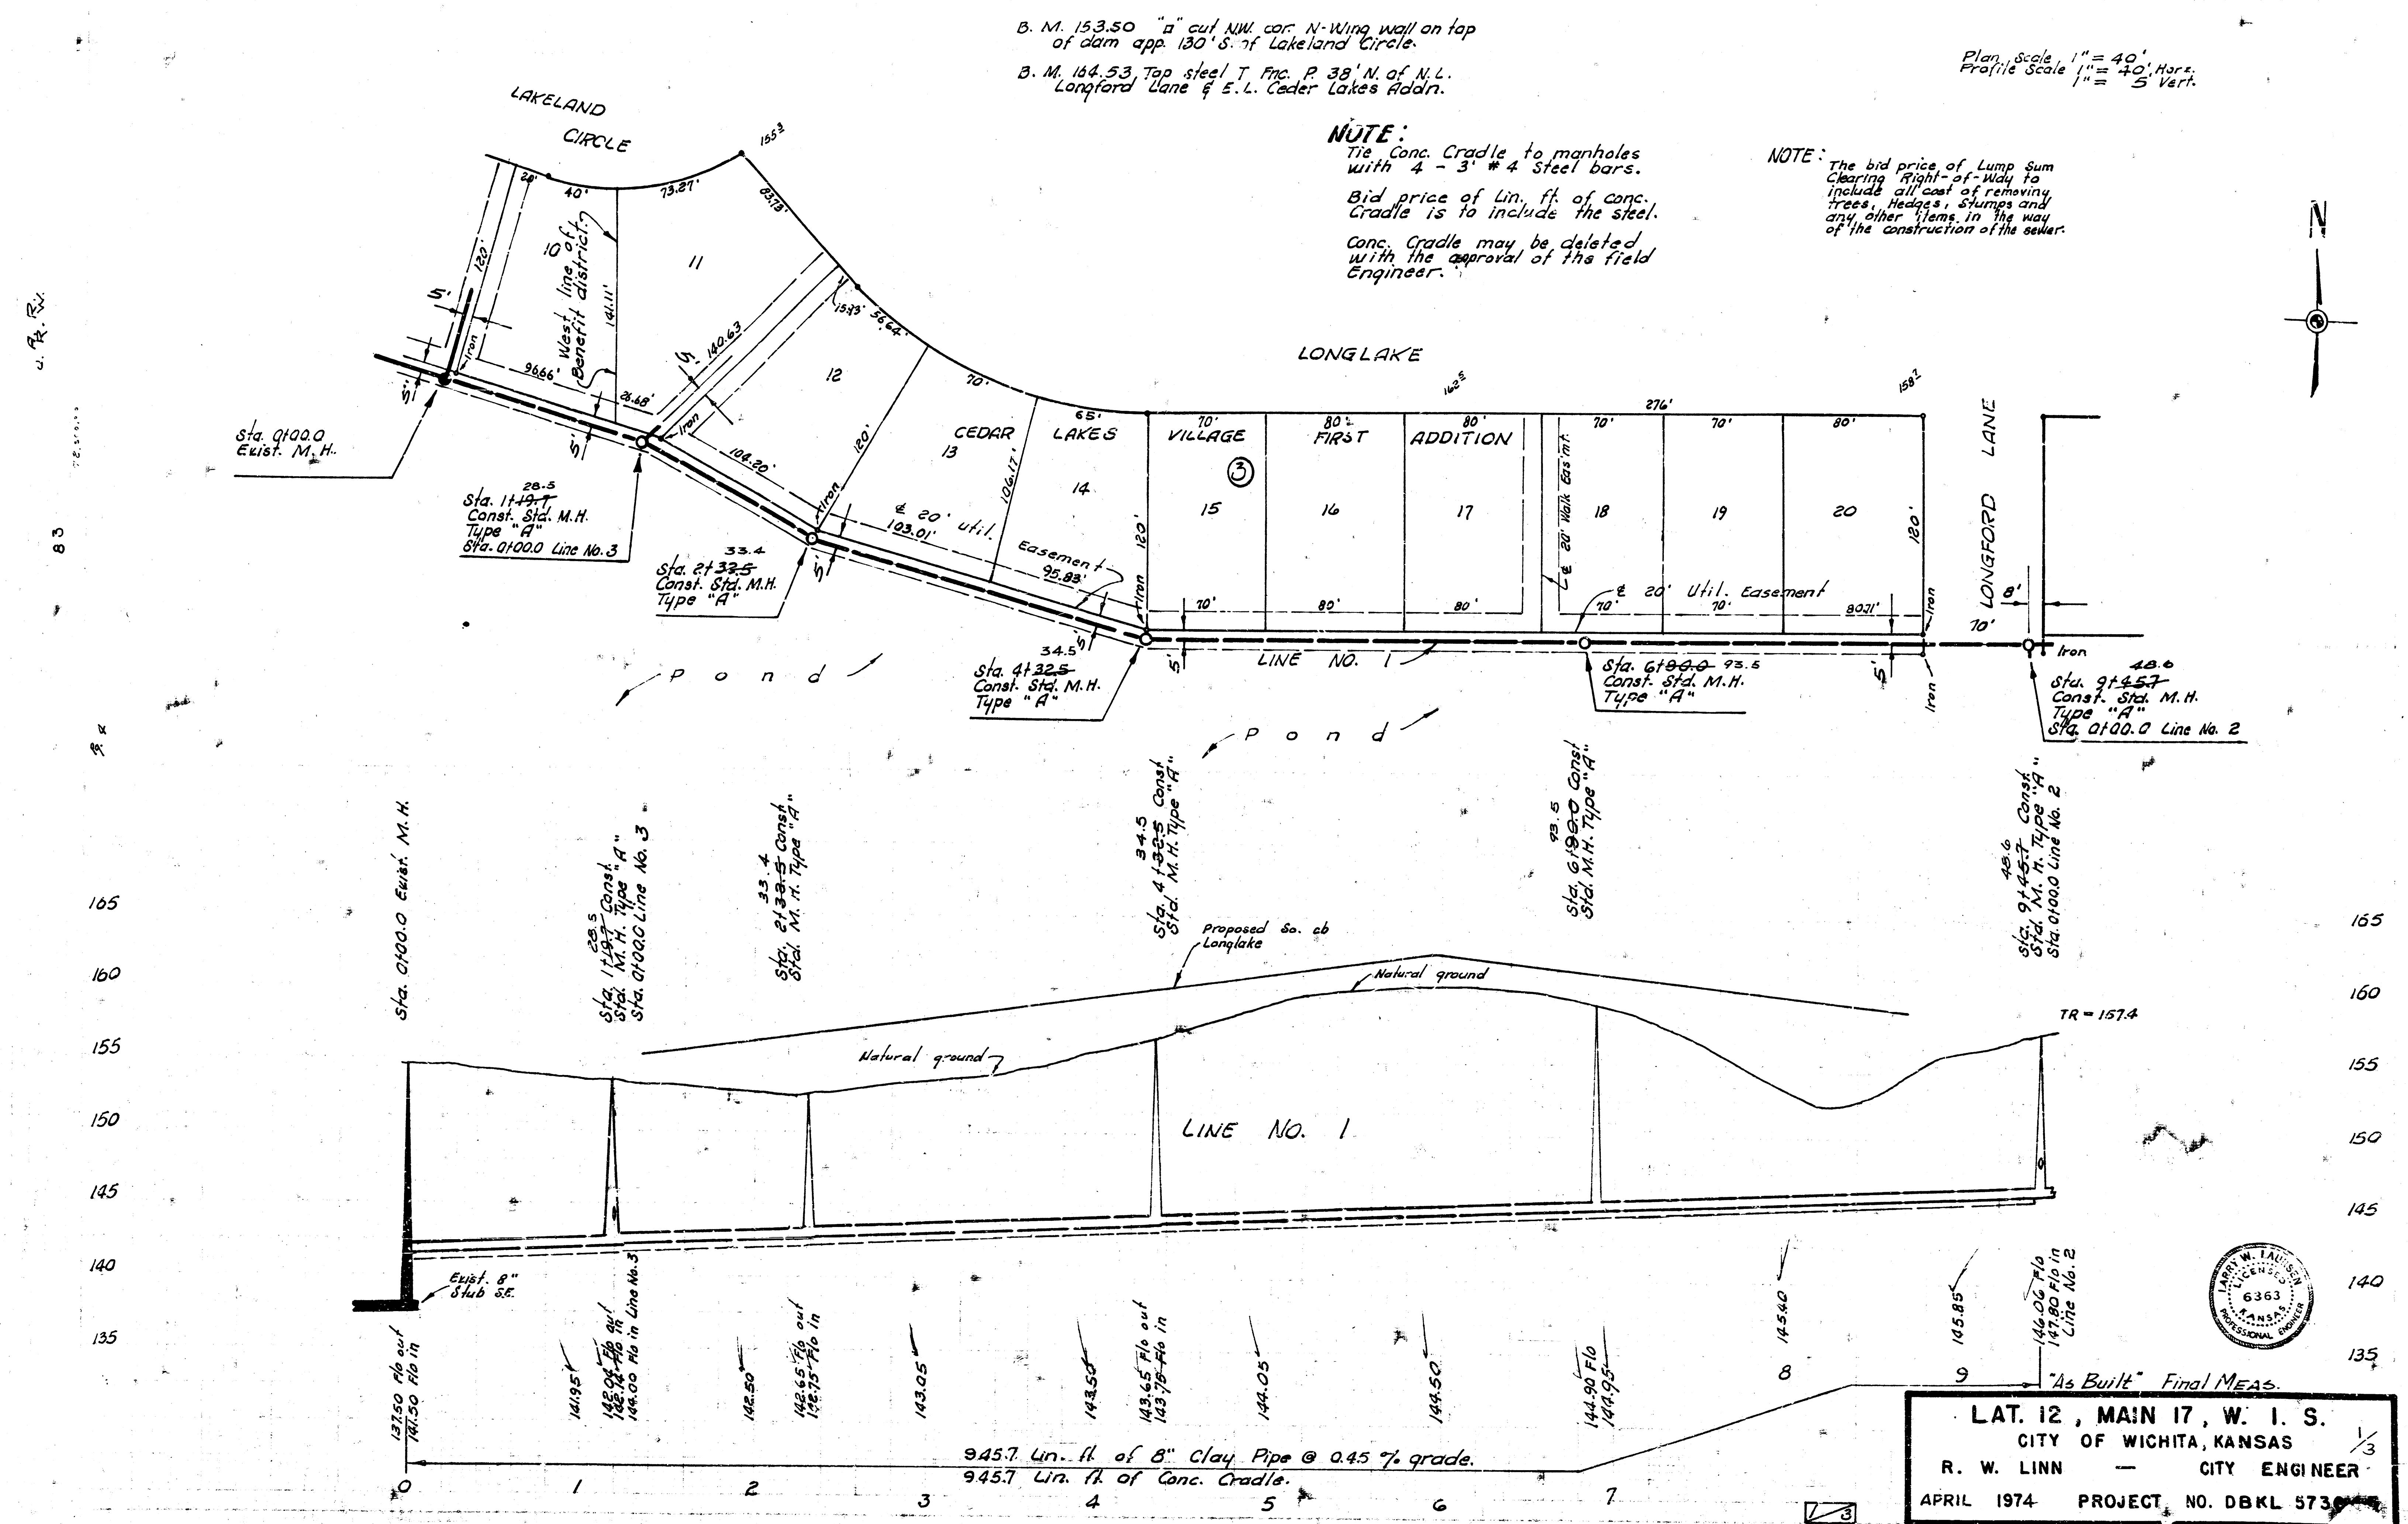

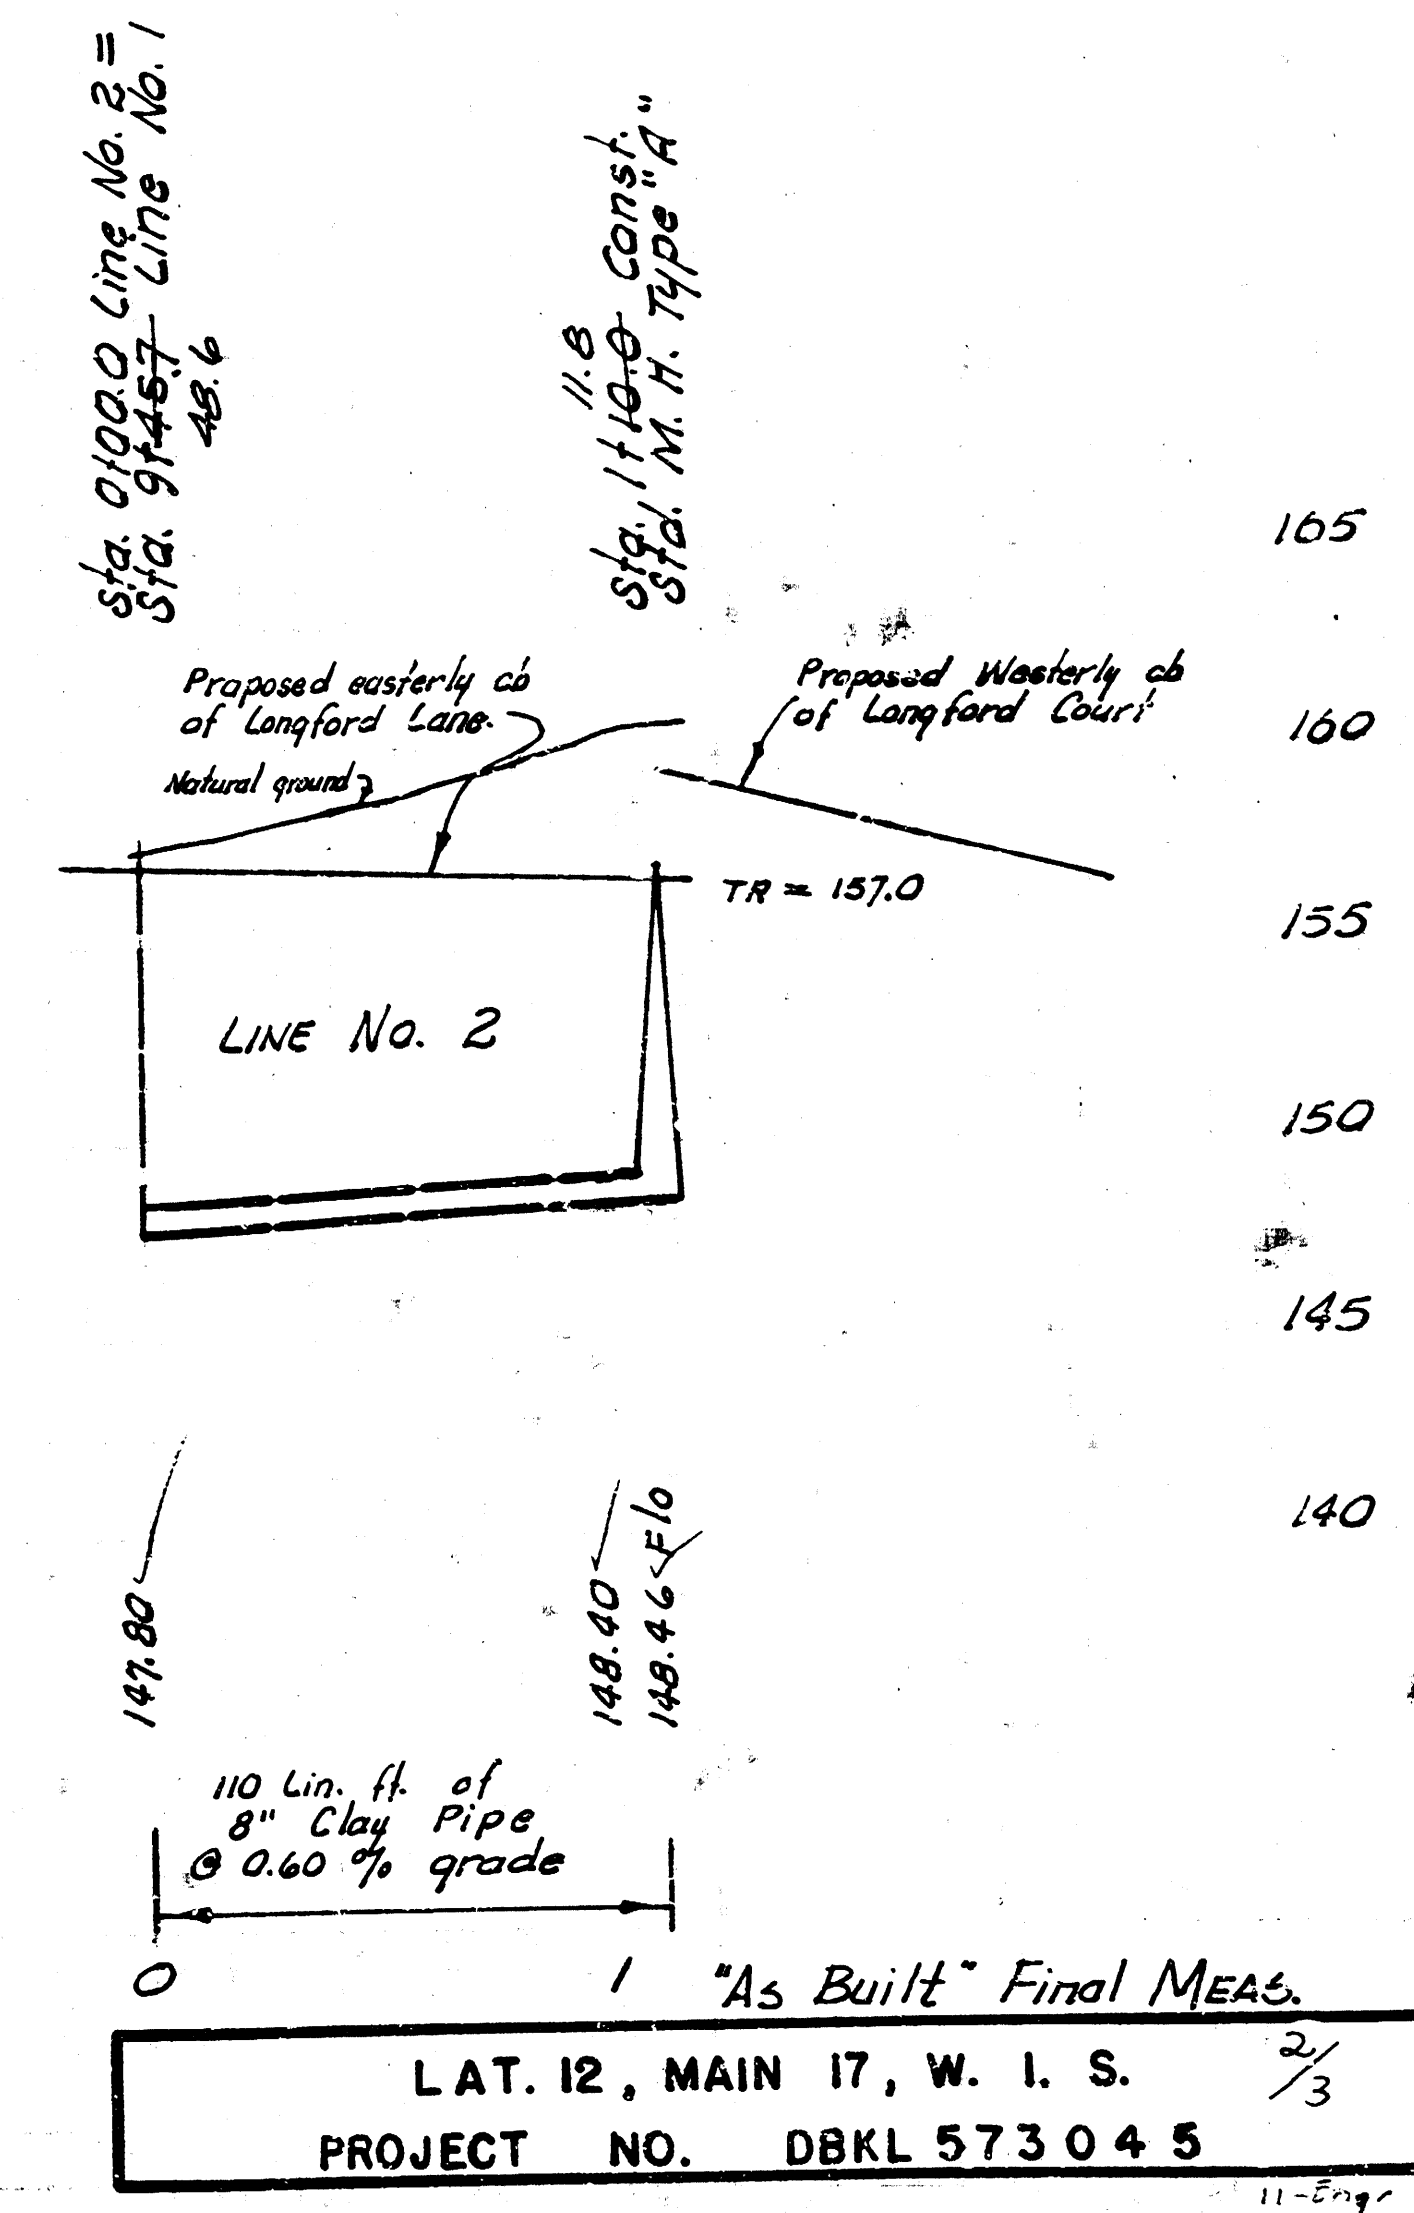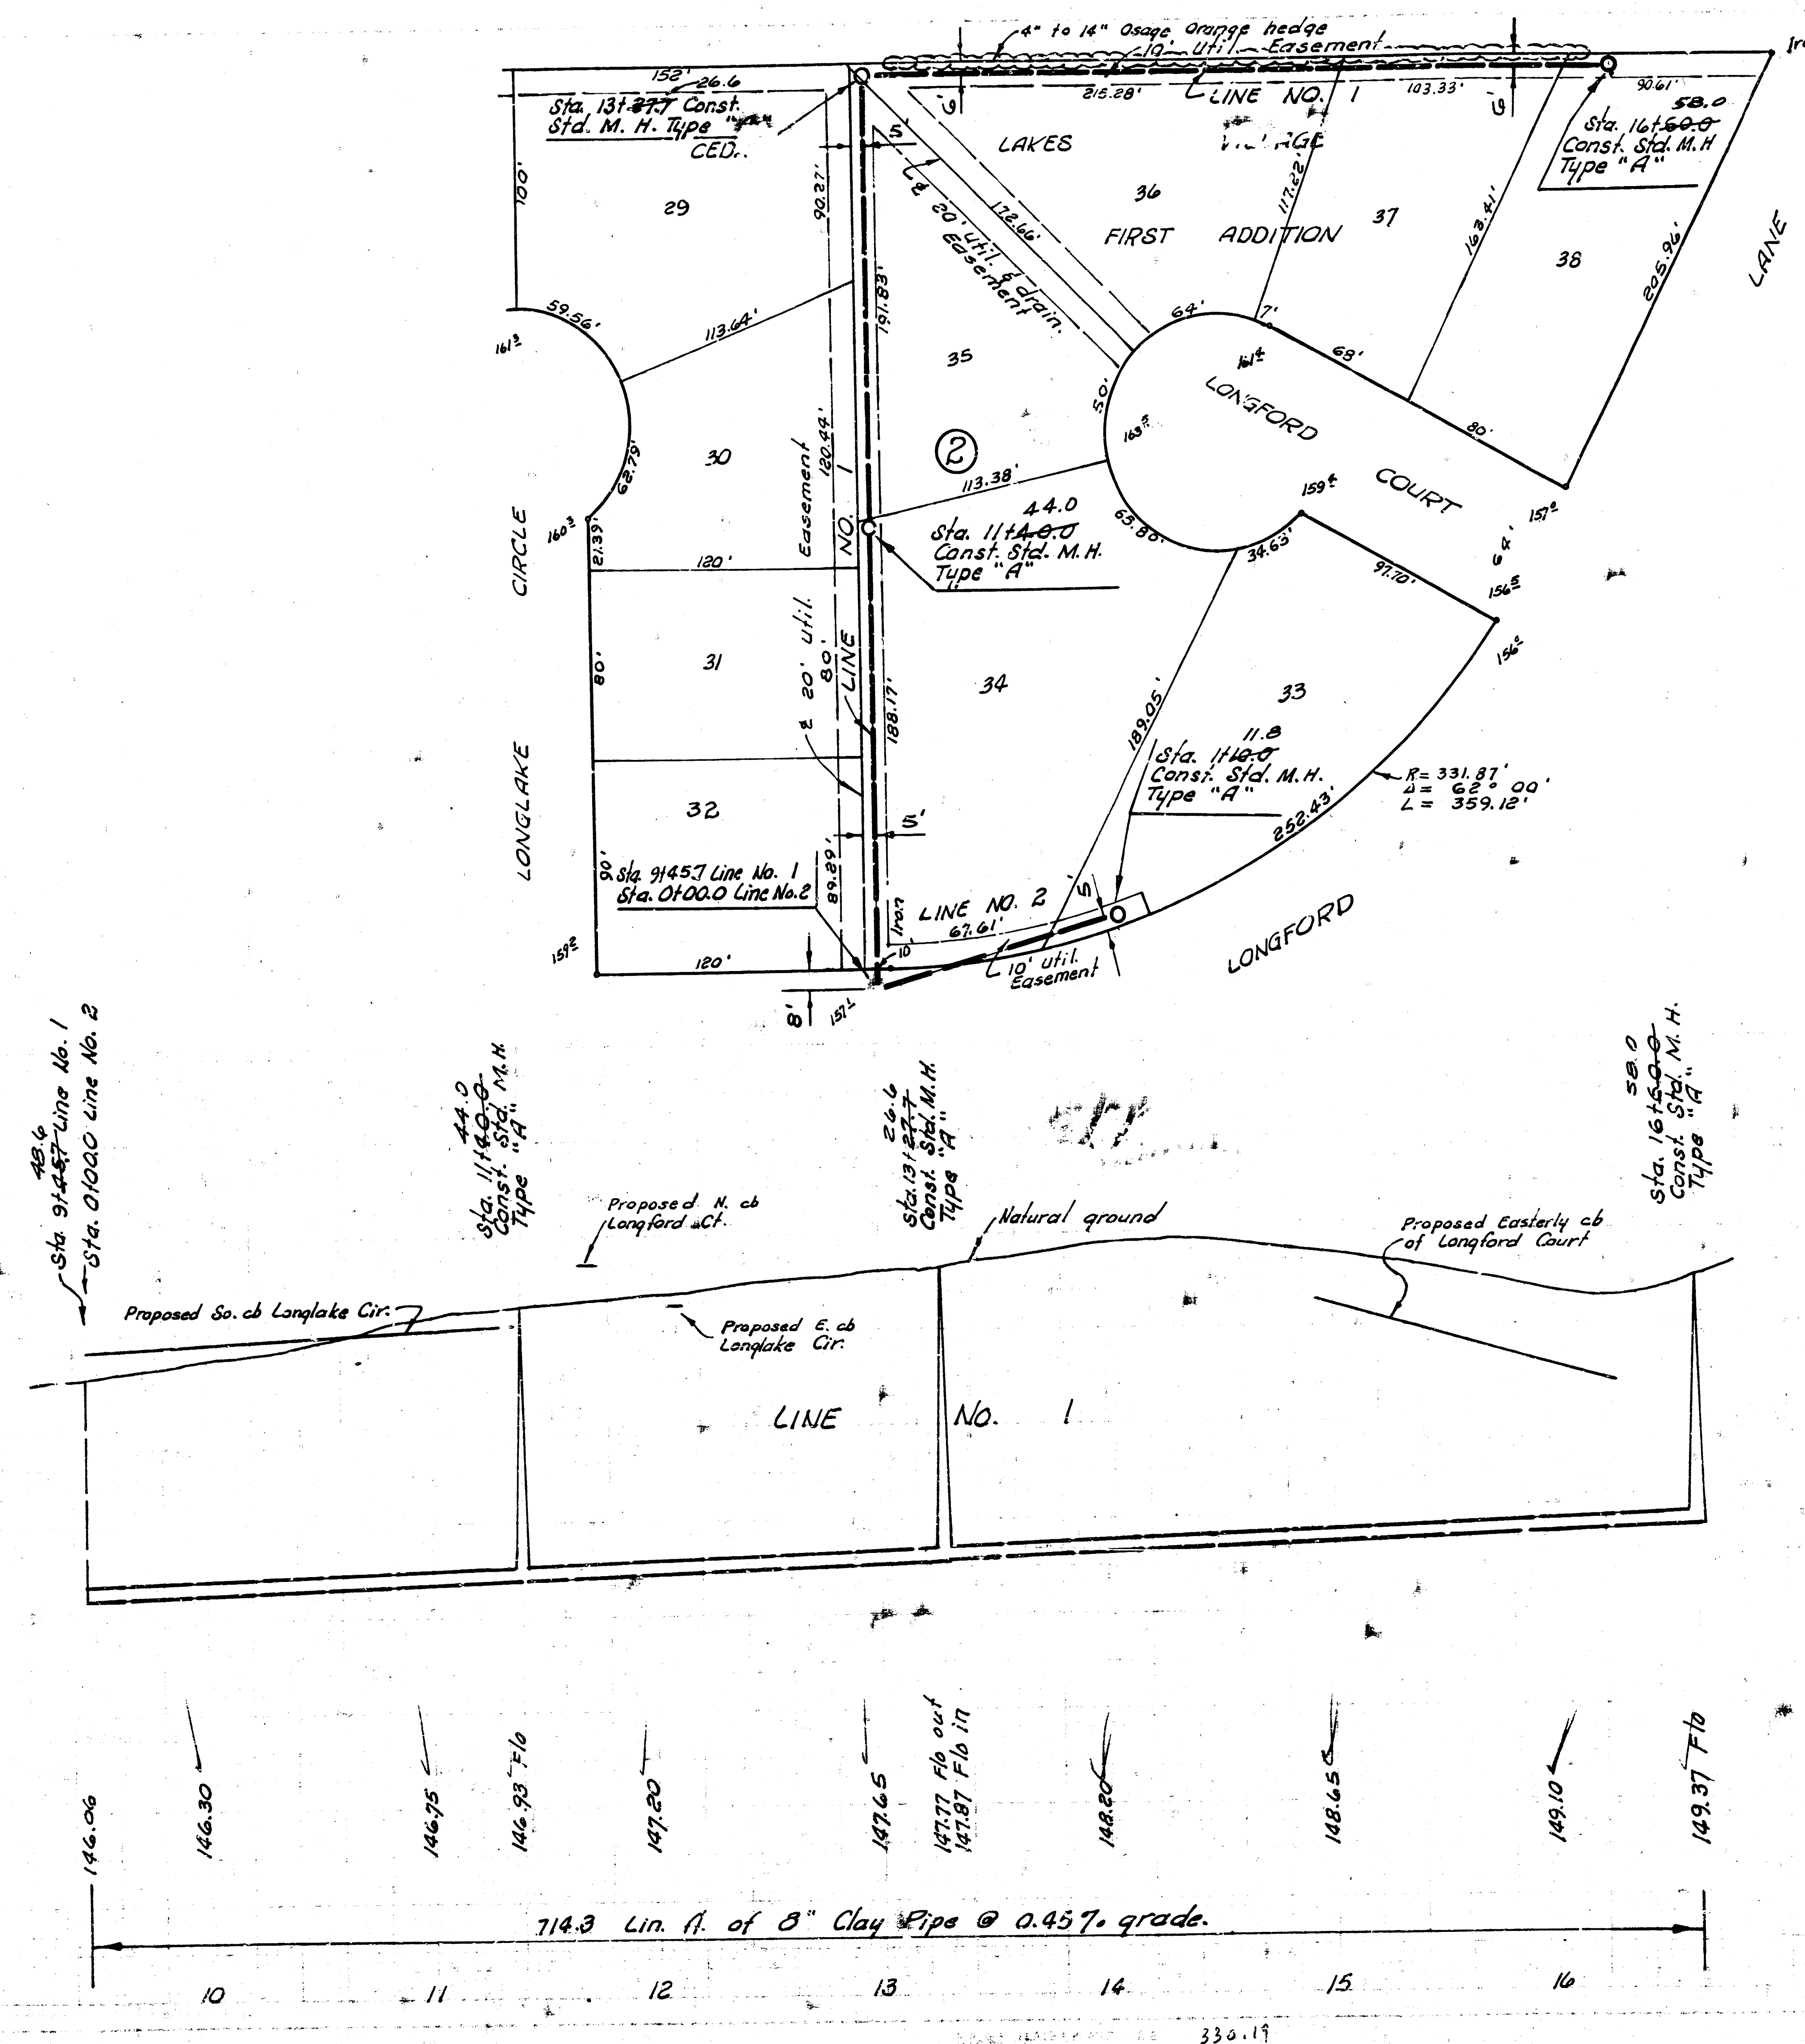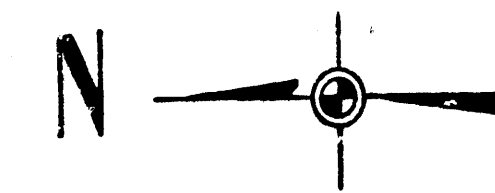

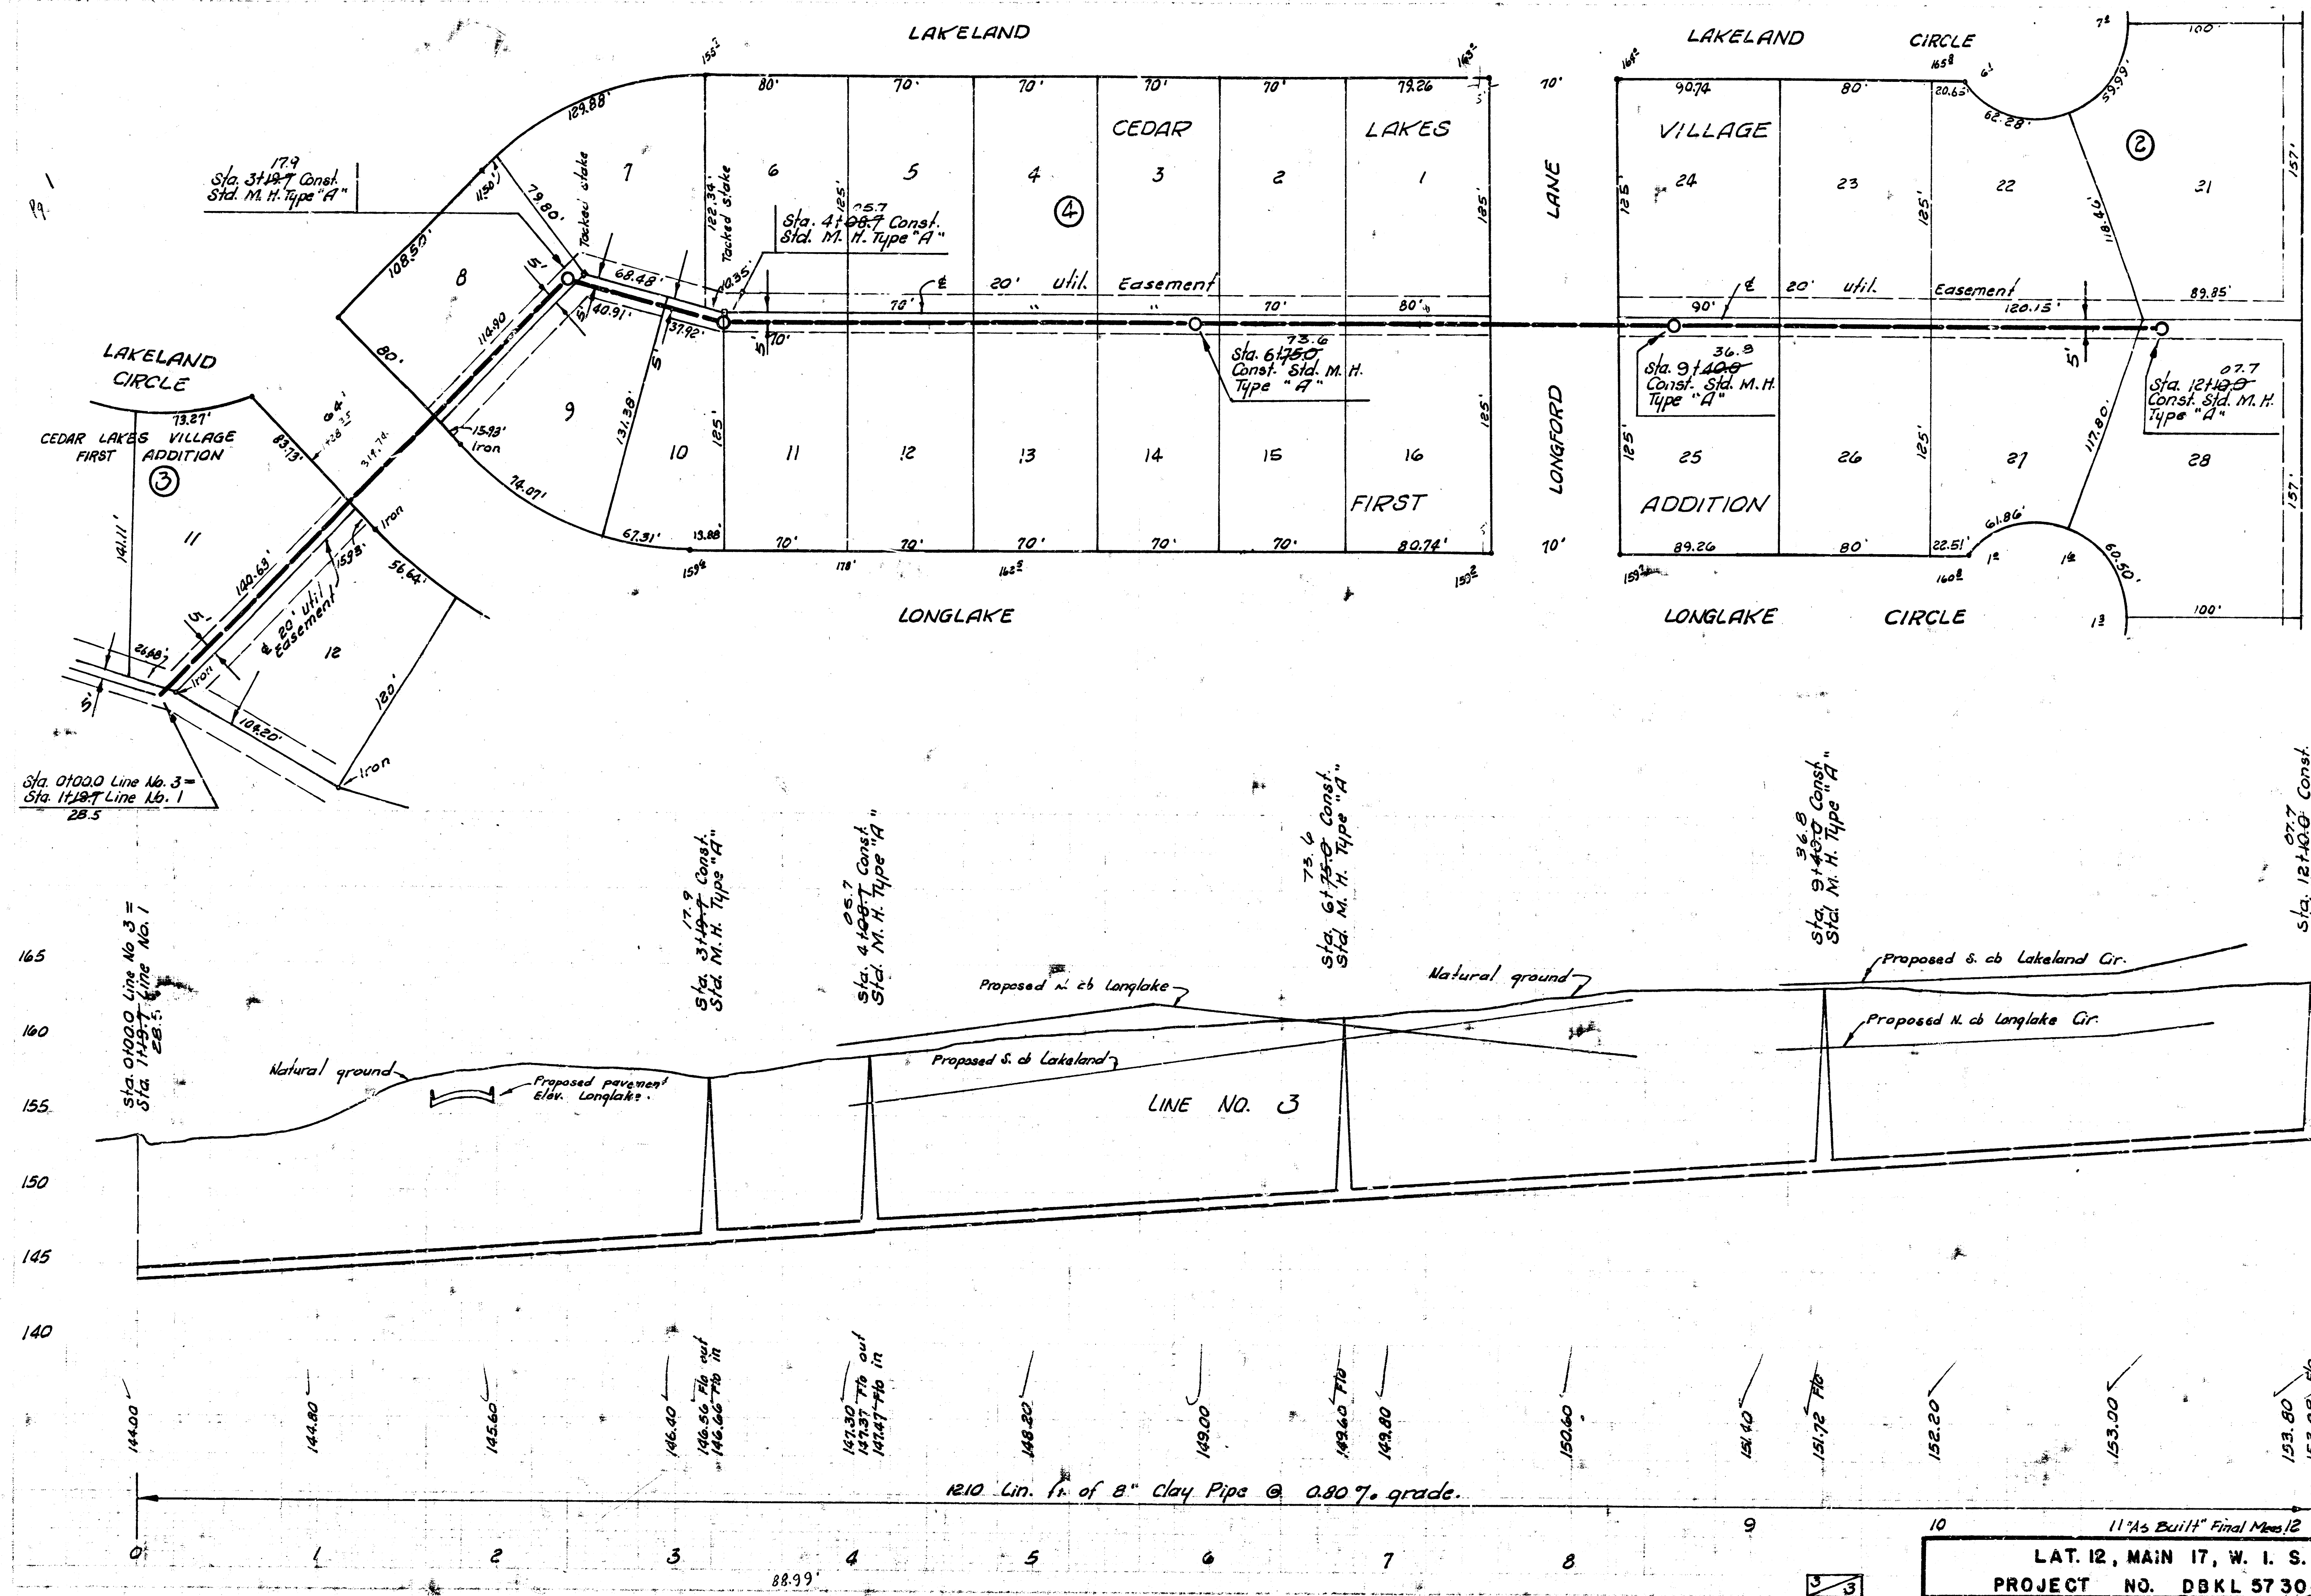

LAT. 12, MAIN 17, W. I. S.
PROJECT NO. DBKL 573045