
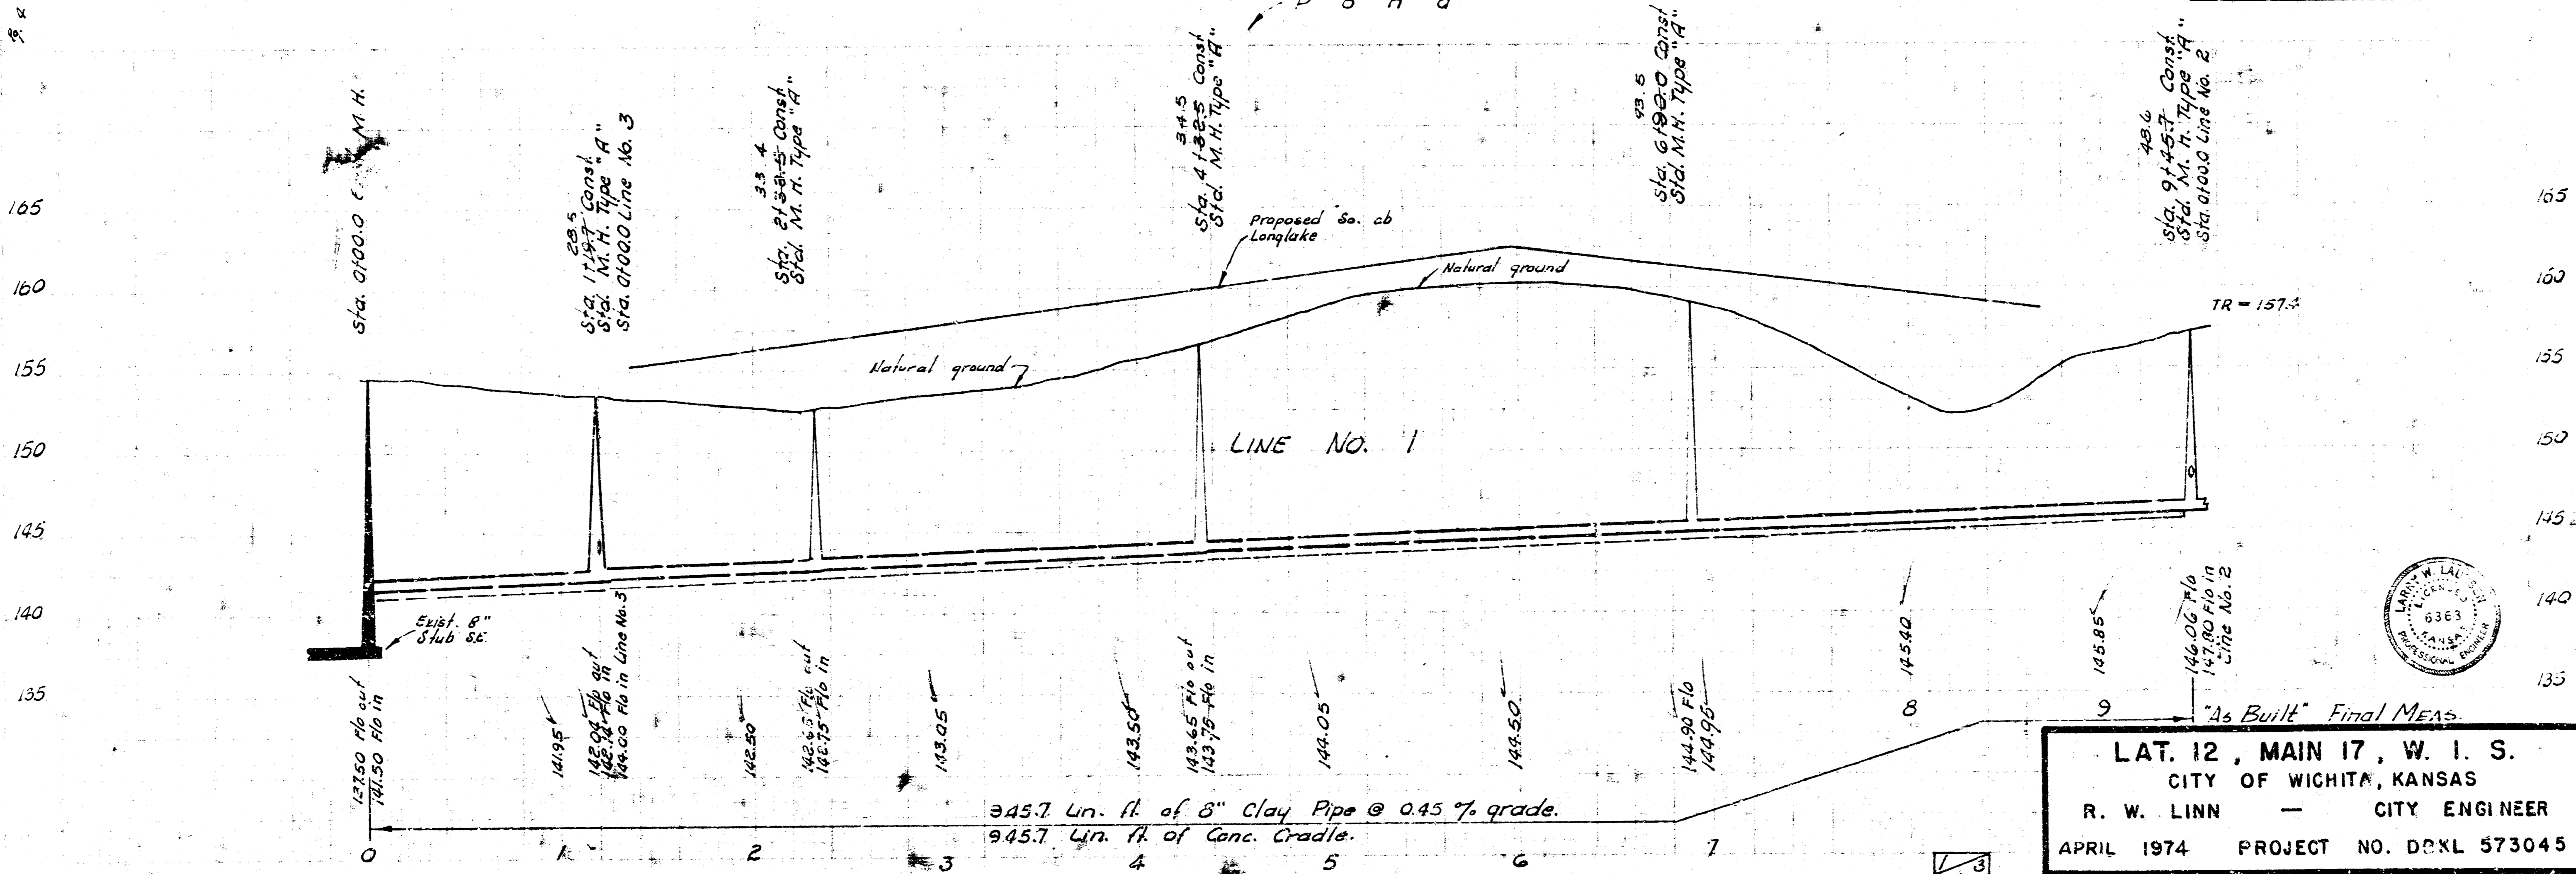


B. M. 153.50 "a" cut NW cor N-Wing wall on top of dam app 130' S. of Lakeland Circle.
 B. M. 163.53 Top steel T. P.C. P. 38' N. of M.L. Langford Lane & E.L. Cedar Lakes Rdn.

Plan Scale 1" = 40' Horz.
 Profile Scale 1" = 5' Vert.

NOTE:
 The Conc. Cradle to manholes with 4 - 3" #4 Steel bars.
 Bid price of Lin. ft. of conc. Cradle is to include the steel.
 Conc. Cradle may be deleted with the approval of the field Engineer.

NOTE:
 The bid price of Lump Sum Clearing Right-of-Way to include all cost of removing trees, hedges, stumps and any other items in the way of the construction of the sewer.

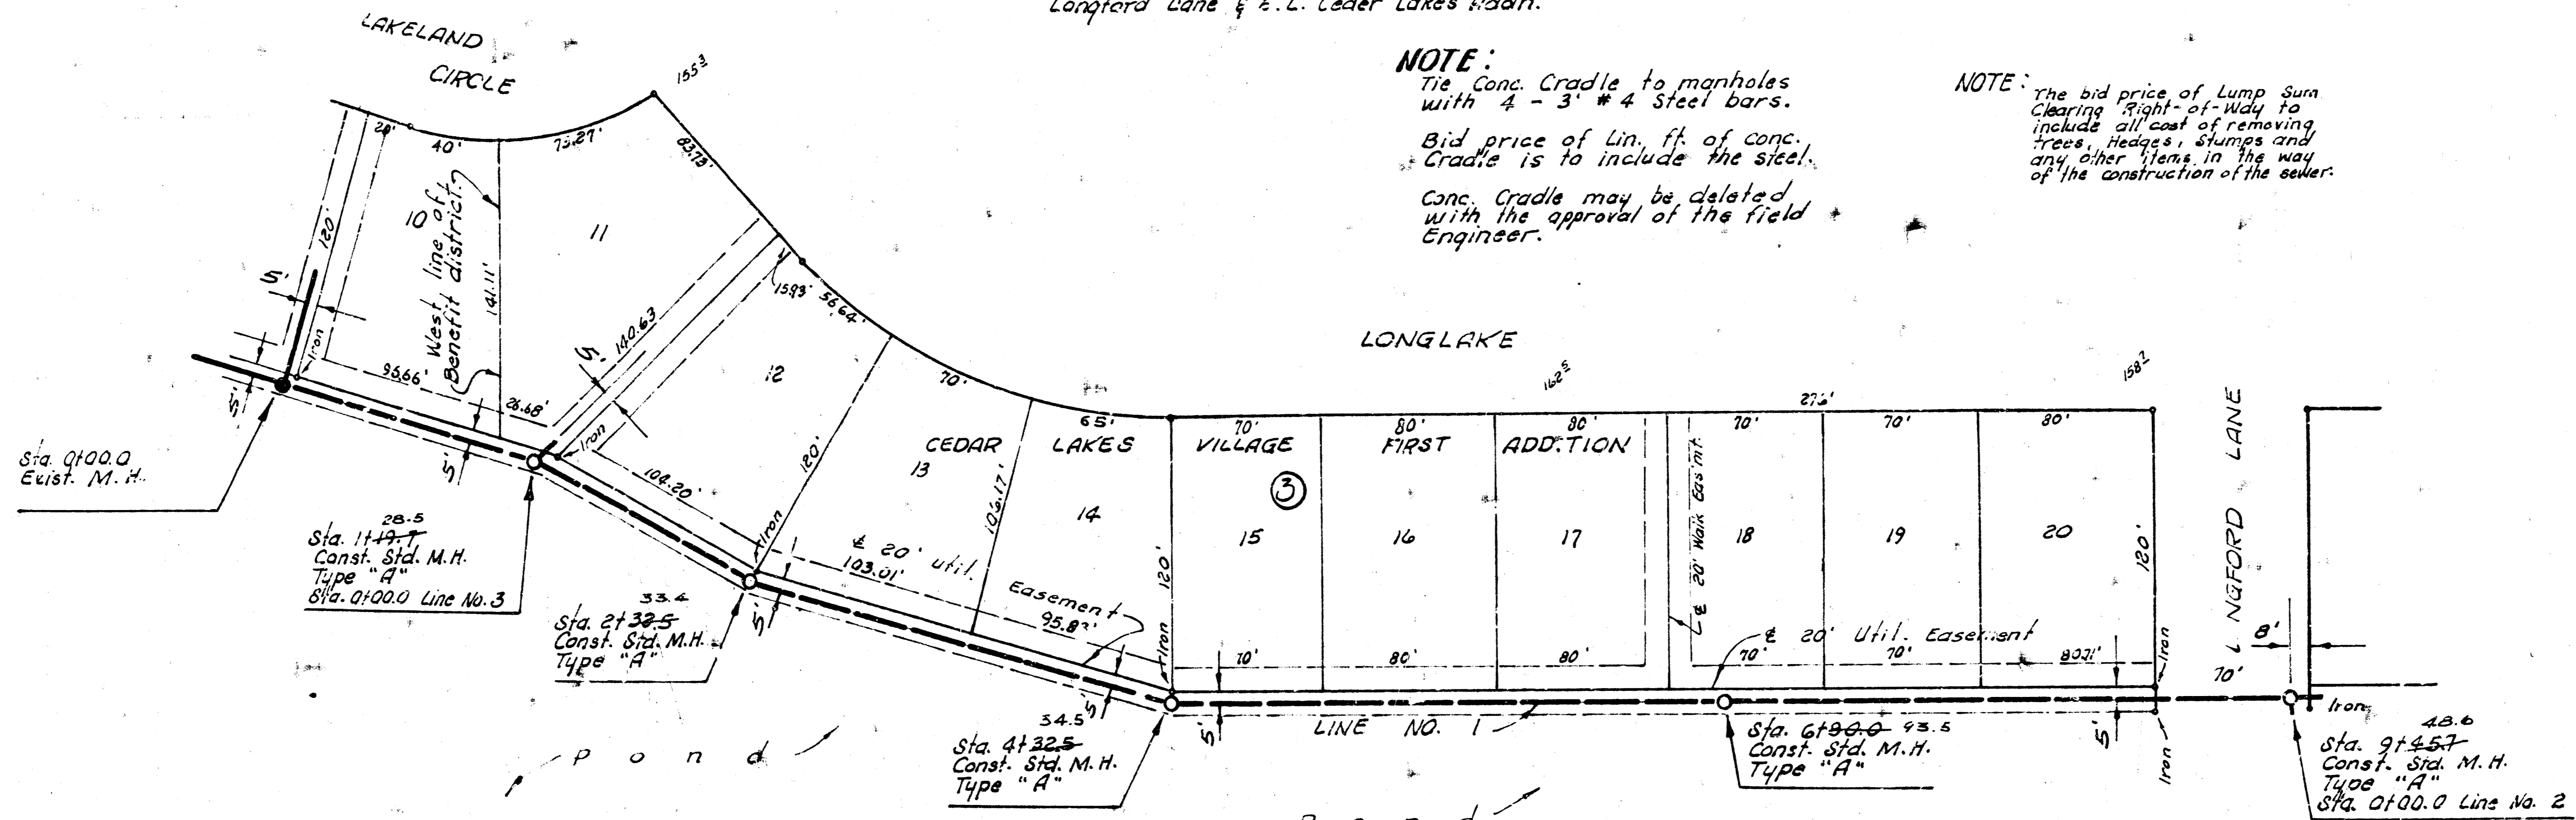

LAT. 12, MAIN 17, W. I. S.
 CITY OF WICHITA, KANSAS
 R. W. LINN — CITY ENGINEER
 APRIL 1974 PROJECT NO. DOKL 573045



