
LAT. 16, MAIN 17, WAR INDUSTRIES SEWER

CITY OF WICHITA, KANSAS

R. W. LINN — CITY ENGINEER

JAN. 1974, PROJECT NO. DBKL 573082

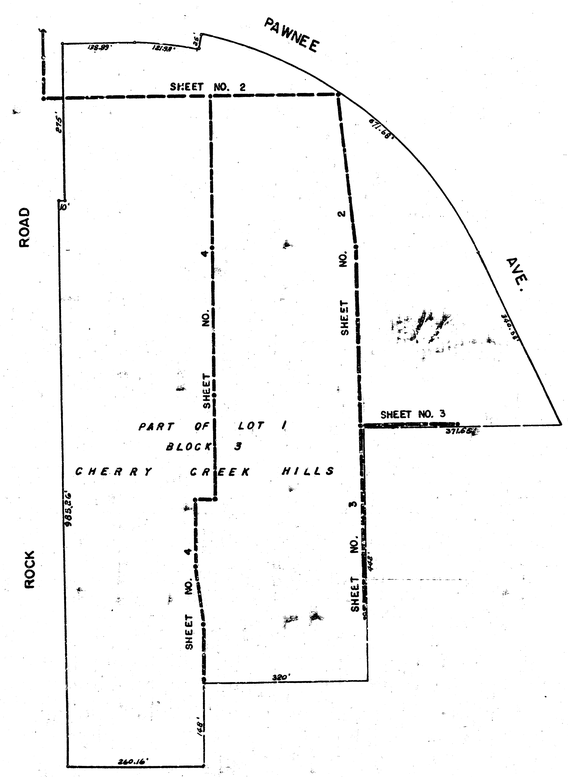

DONALD E. SCHNEIDER LICENSED 6311 KANSAS PROFESSIONAL ENGINEER

DONALD E. SELLERS LICENSED 3683 KANSAS PROFESSIONAL ENGINEER


As Built "Final Mens. 9-E

LAT. 16, MAIN 17, W. I. S. 1/4

PROJECT NO. DBKL573082

FILMED FROM THE BEST AVAILABLE COPY


B. M. 165.71 "X" in pavement @ Rock Rd. & @ Pawnee West.

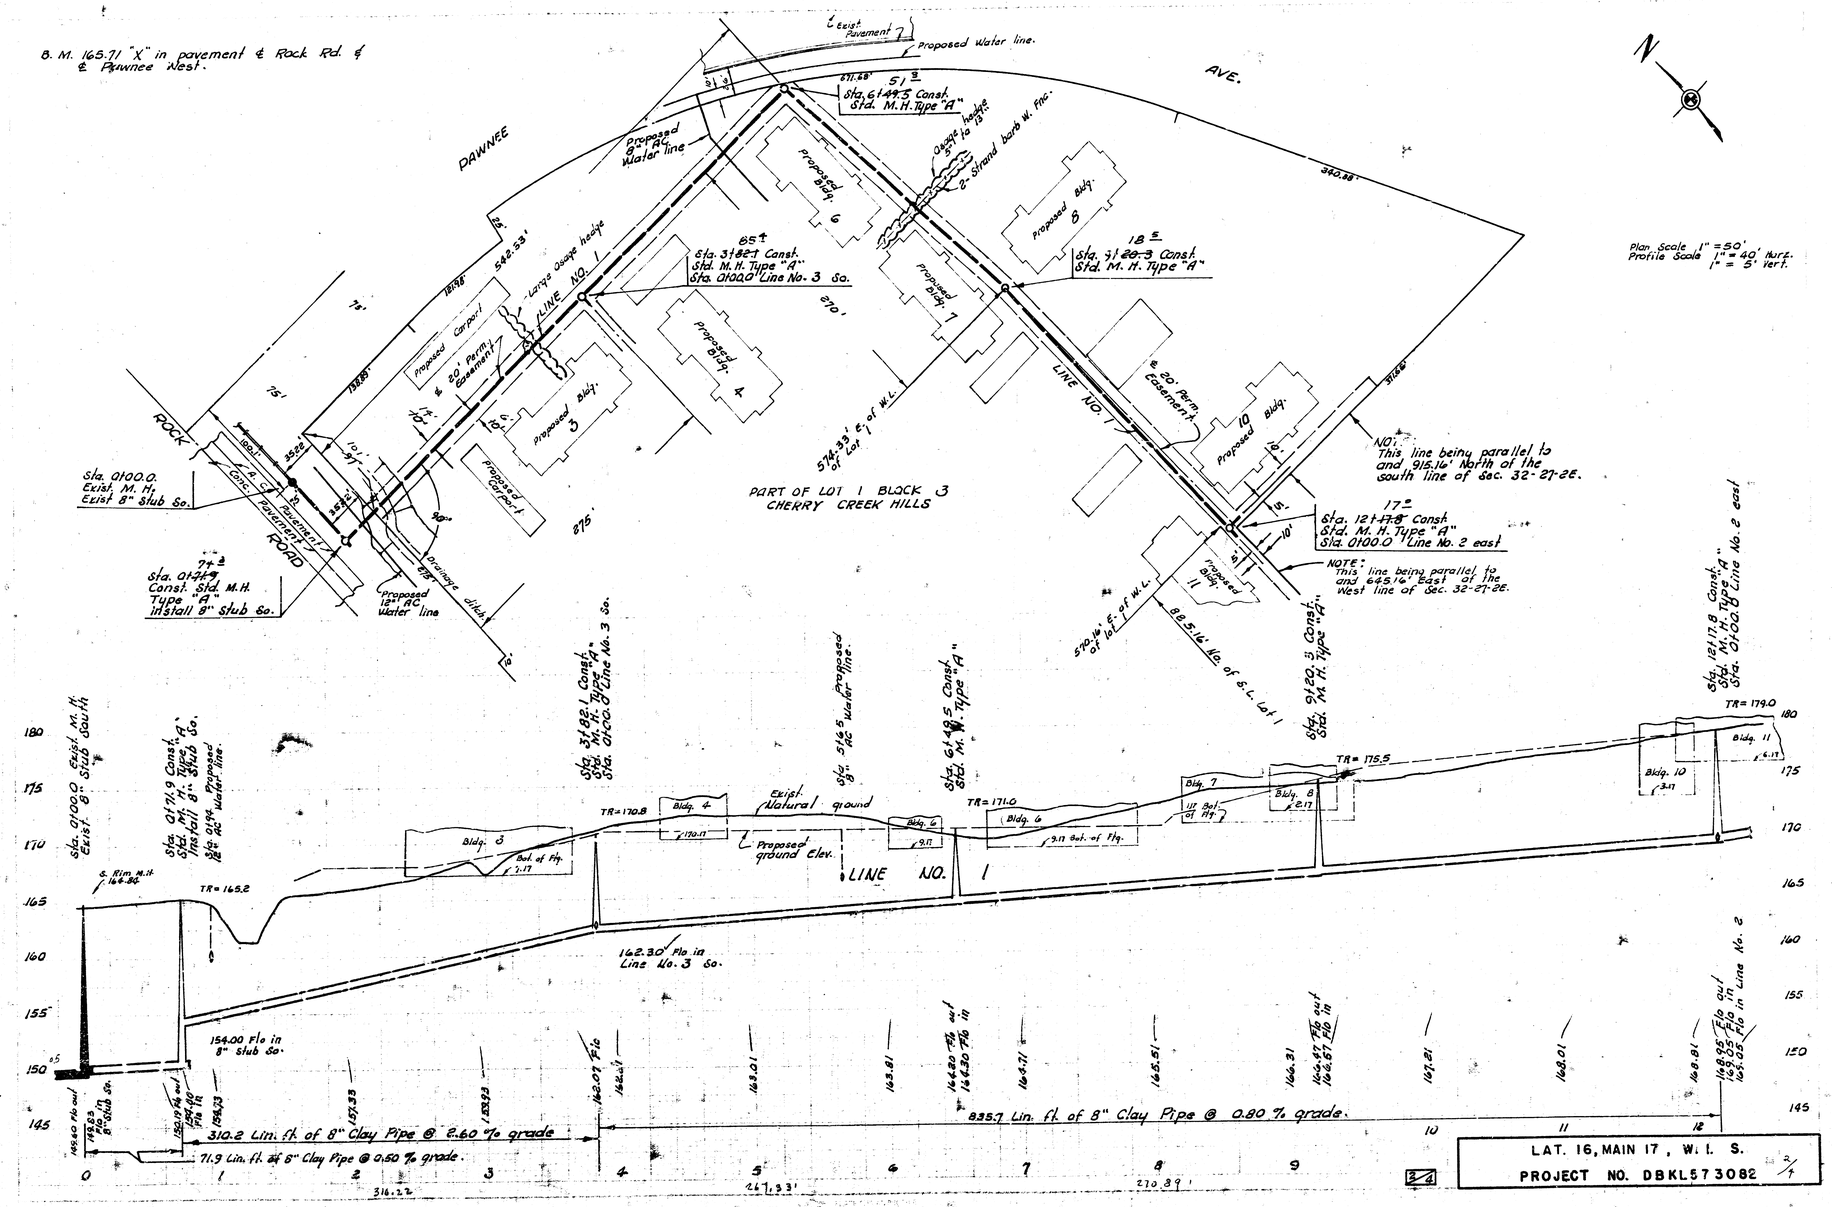



N

Plan Scale 1" = 50'
Profile Scale 1" = 5' Vert.

LAT. 16, MAIN 17, W. I. S.
PROJECT NO. DBKL573082

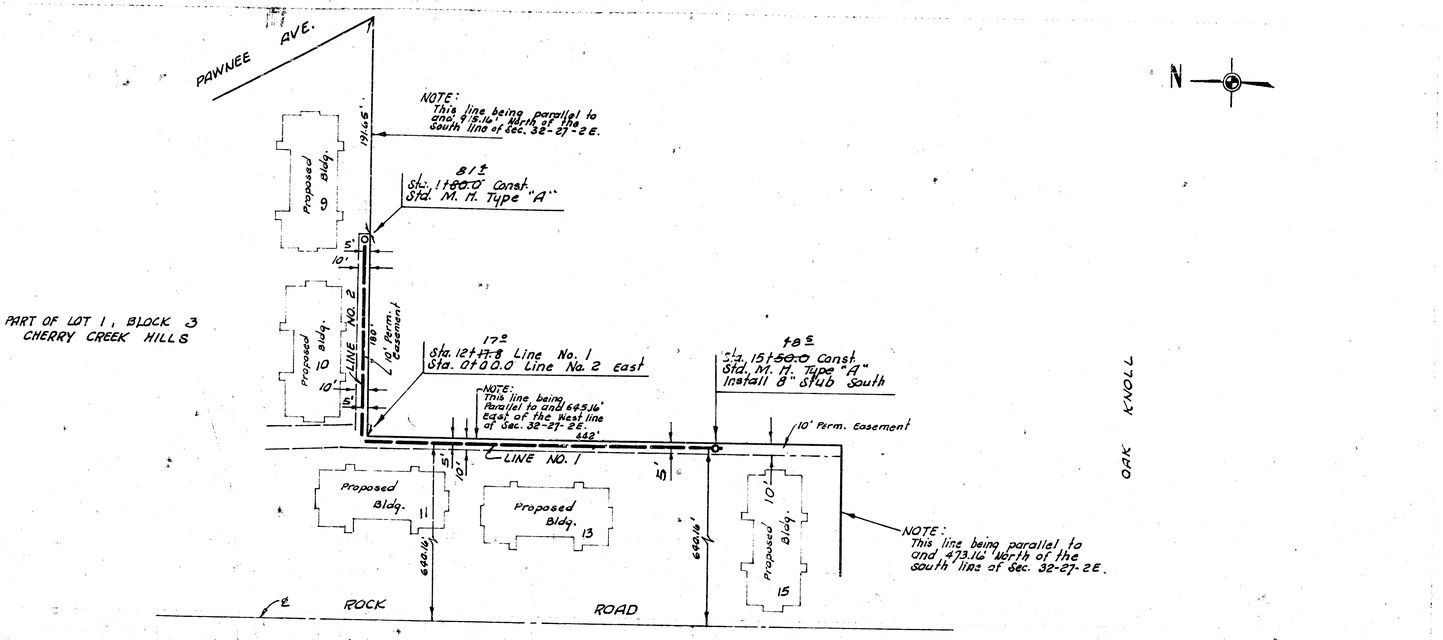

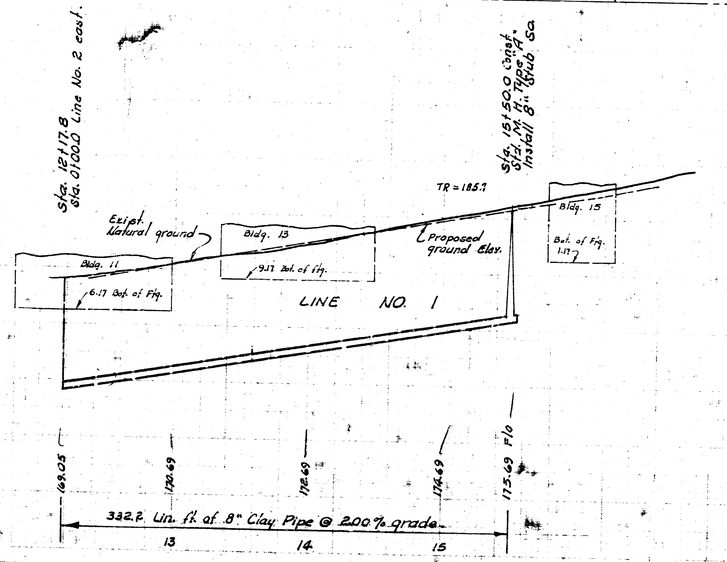


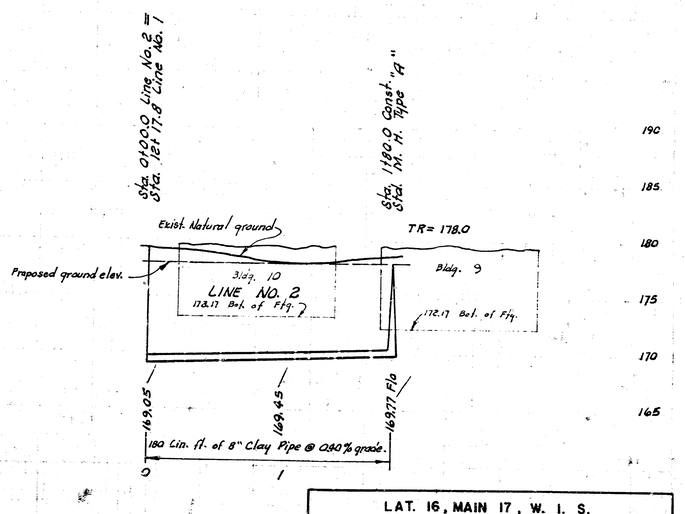

LAT. 16, MAIN 17, W. I. S.
PROJECT NO. DBKL573082

3/4

3/7

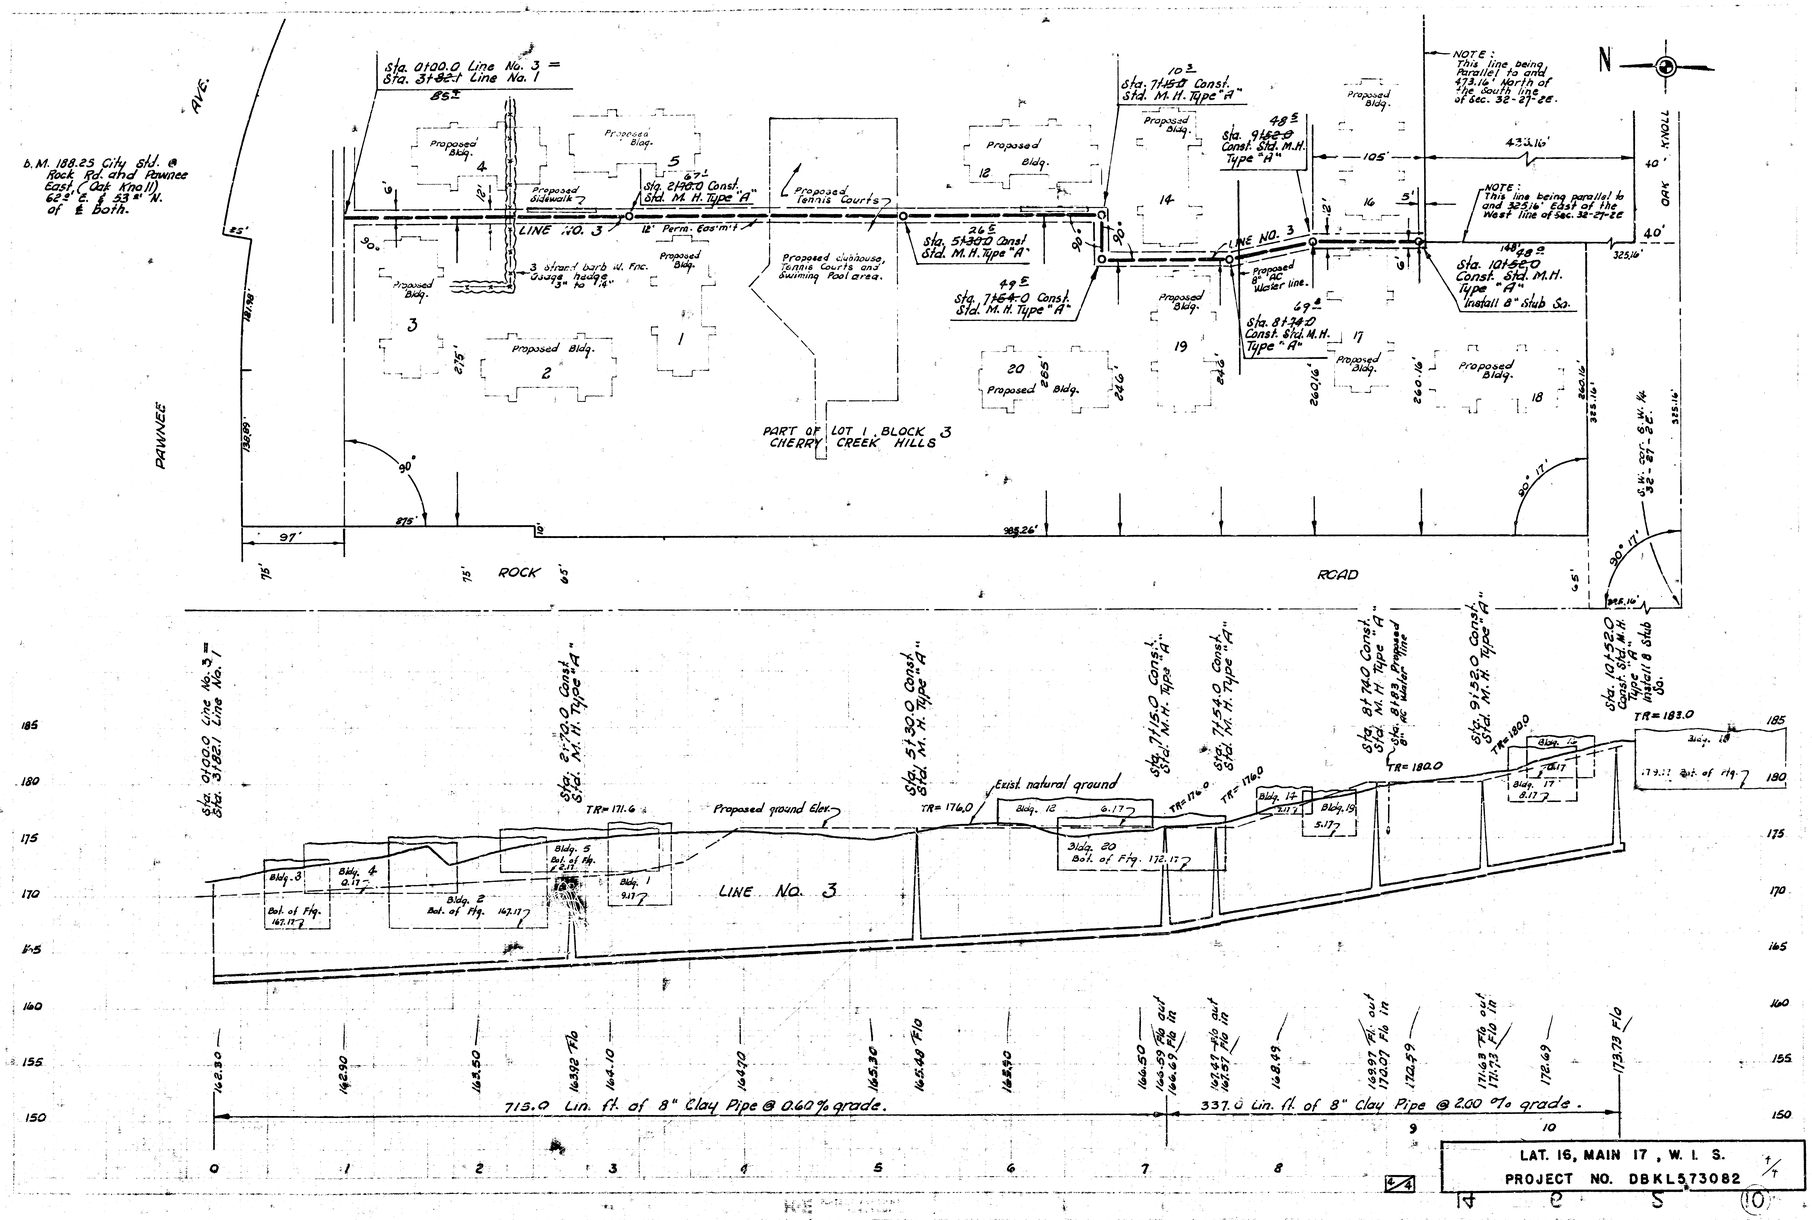
Sta. 0+00.0 Line No. 3 = Sta. 3+82.1 Line No. 1
B.M. 188.25 City Std. @ Rock Rd. and Pawnee East, (Cut Knoll) 62'± E. & 33'± N. of E both.
PAWNEE AVE.
NOTE: This line being Parallel to and 473.16' North of the South line of Sec. 32-27-22.
NOTE: This line being parallel to and 325.16' East of the West line of Sec. 32-27-22.
Sta. 2+90.0 Const. Std. M.H. Type "A"
Sta. 5+30.0 Const. Std. M.H. Type "A"
Sta. 7+64.0 Const. Std. M.H. Type "A"
Sta. 7+15.0 Const. Std. M.H. Type "A"
Sta. 9+62.0 Const. Std. M.H. Type "H"
Sta. 8+74.0 Const. Std. M.H. Type "A"
Sta. 10+15.0 Const. Std. M.H. Type "A" Install 8" Stub So.
LINE NO. 3
12' Perm. Easm't
3 strand barb wi. Fnc. Gauge hedge 3" to 1/4"
Proposed Tennis Courts
Proposed clubhouse, Tennis Courts and Swimming Pool area.
Proposed Sidewalk
8" AC Water line.
PART OF LOT 1, BLOCK 3 CHERRY CREEK HILLS
ROCK ROAD
713.0 Lin. ft. of 8" Clay Pipe @ 0.60% grade.
337.0 Lin. ft. of 8" Clay Pipe @ 2.00 % grade.
Proposed ground Elev.
Exist. natural ground
LINE NO. 3
LAT. 16, MAIN 17, W. I. S.
PROJECT NO. DBKL573082