
LAT. 16, MAIN 17, WAR INDUSTRIES SEWER

CITY OF WICHITA, KANSAS

R. W. LINN — CITY ENGINEER

JAN. 1974, PROJECT NO. DBKL 57 3082

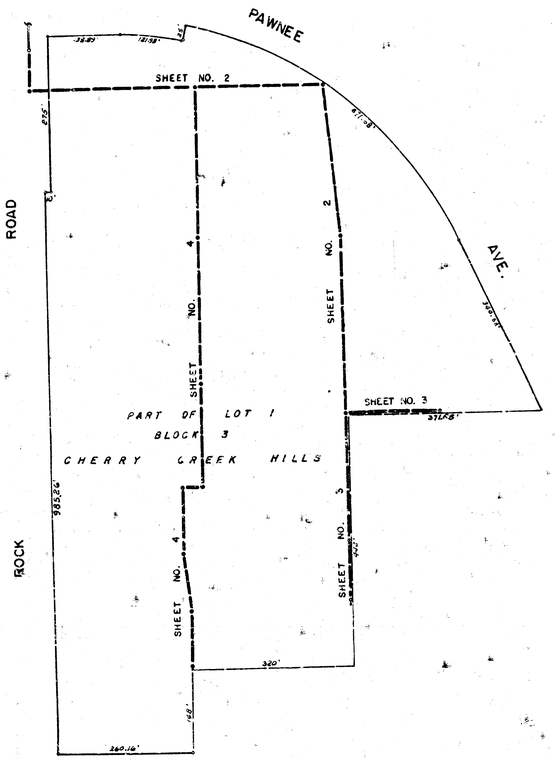


N

1" = 100'

As Built Final Mess. 9-E


LAT. 16, MAIN 17, W. I. S.
PROJECT NO. DBKL573082

3. M. 165.71 "X" in pavement @ Rock Rd. & @ Pawnee West.

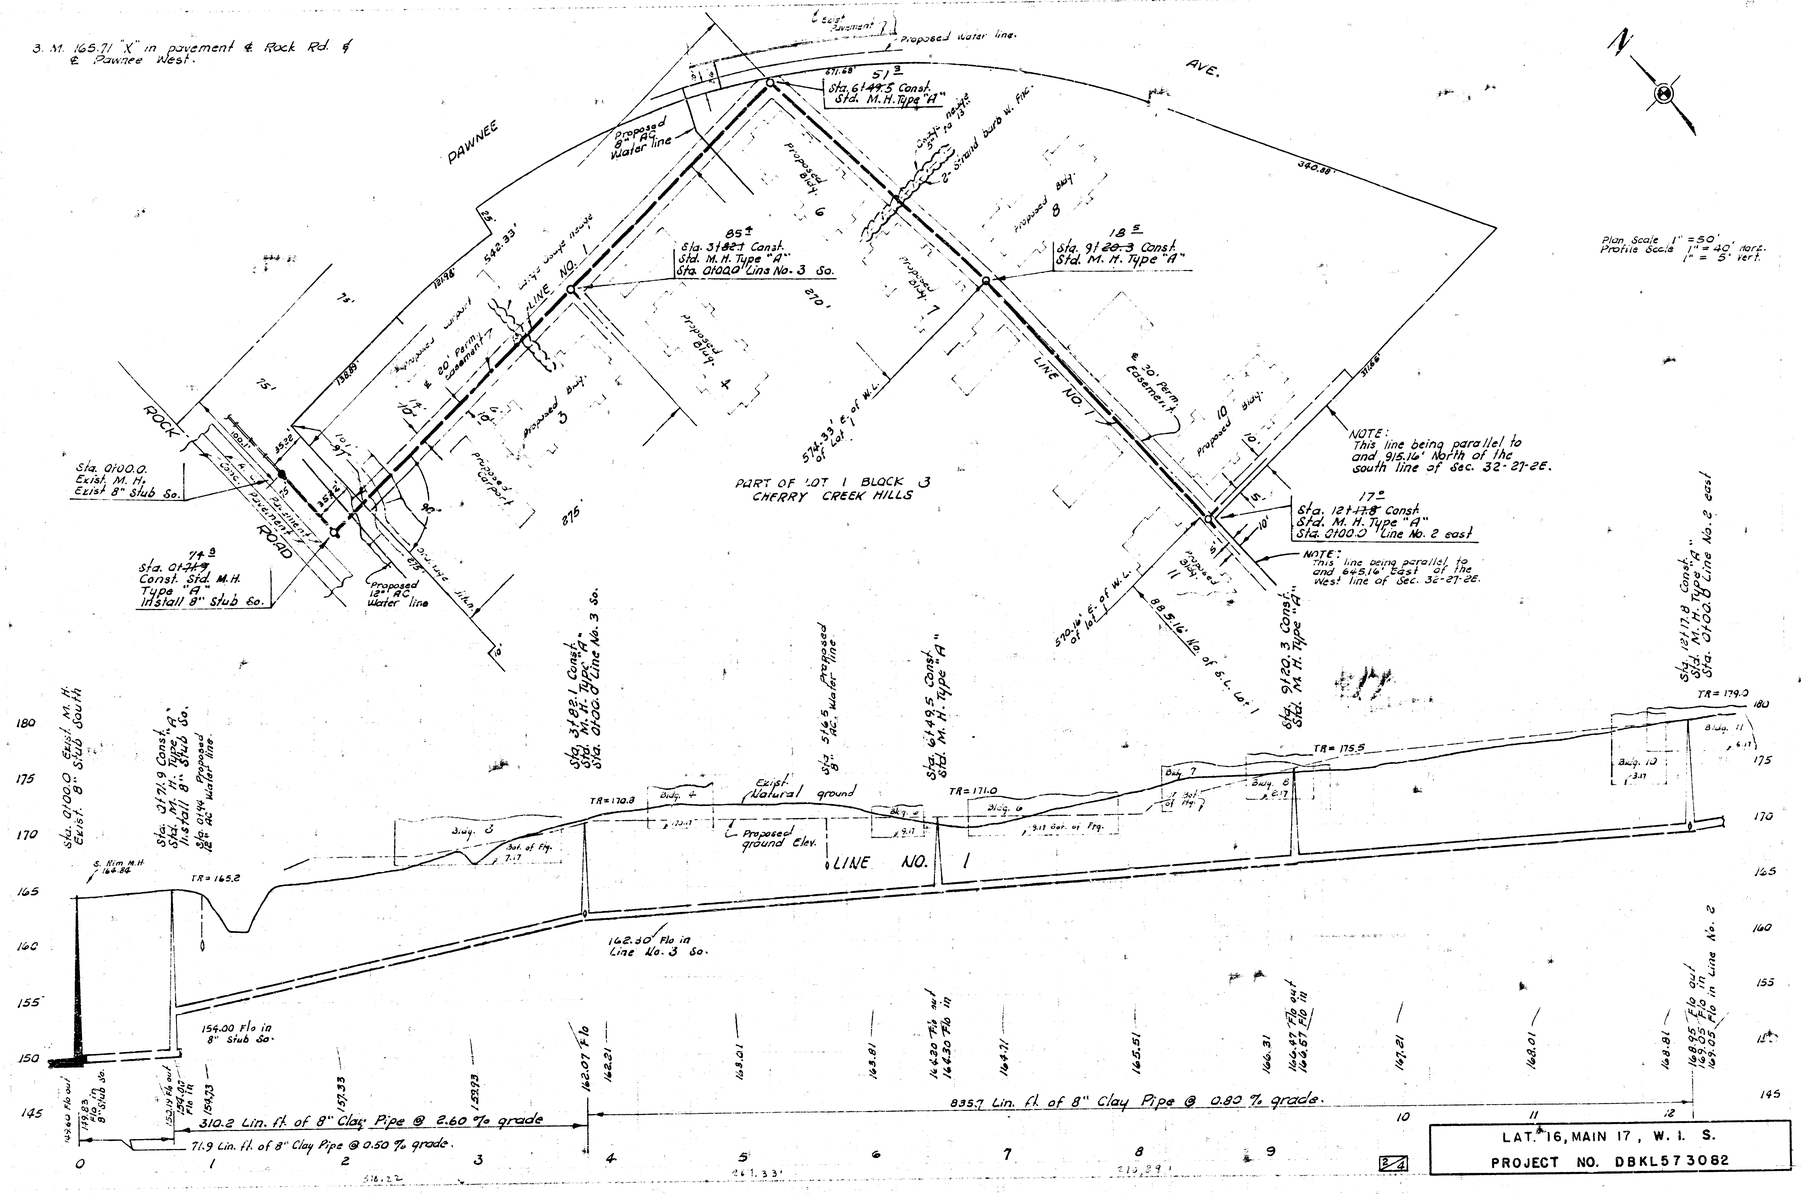

Plan Scale 1" = 50'
Profile Scale 1" = 40' Horz.
1" = 5' Vert.

LAT. 16, MAIN 17, W. I. S.
PROJECT NO. DBKL573082

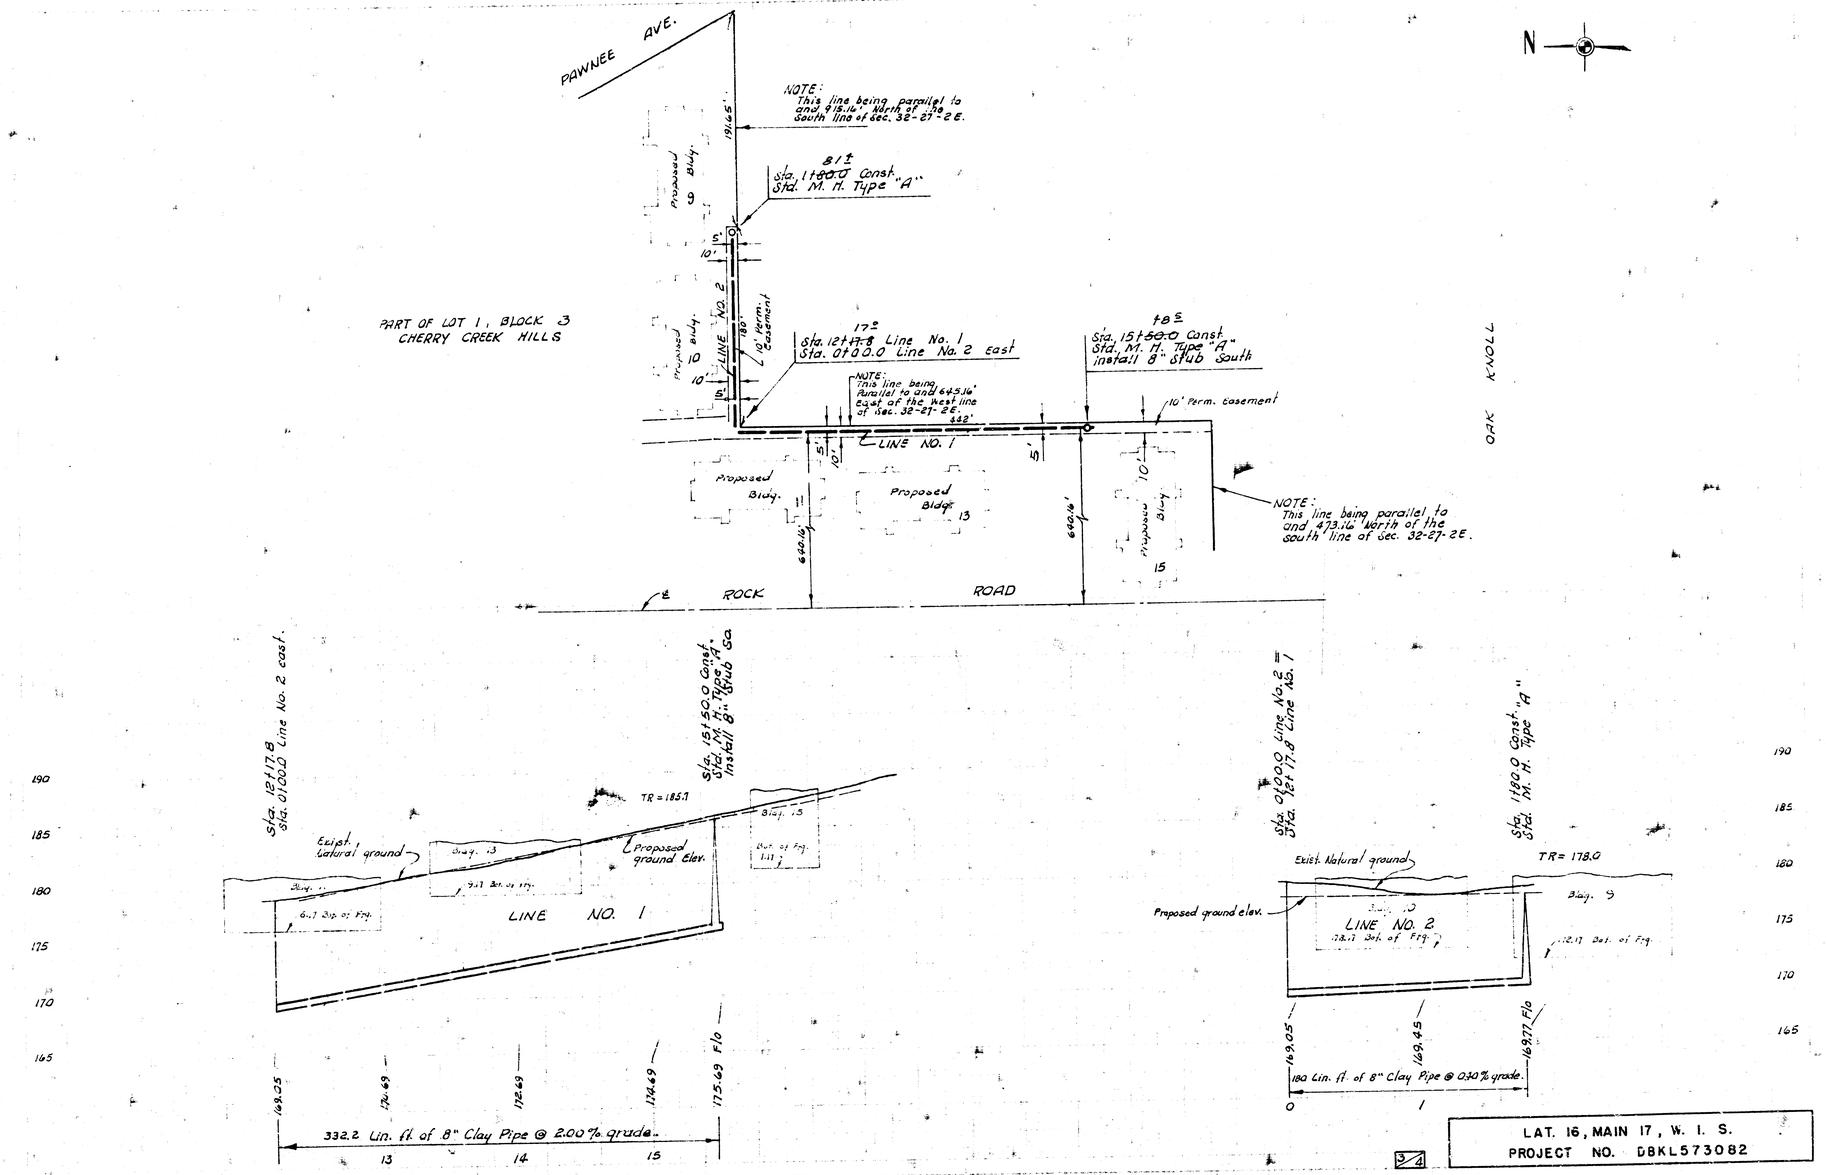

PART OF LOT 1, BLOCK 3
CHERRY CREEK HILLS

LAT. 16, MAIN 17, W. I. S.
PROJECT NO. DBKL573082

3/4

B.M. 139.25 City Std. @ Rock Rd. and Pawnee East, (Oak Knoll) 62° E & 53° N. of ℄ Bath.

PAWNEE AVE.

Sta. 0100.0 Line No. 3 = Sta. 3+82.1 Line No. 1

85 ℄

Proposed Bldg.

Proposed Sidewalk

Sta. 2+70.0 Const. Std. M.H. Type "A"

67 ℄

Proposed Tennis Courts

LINE NO. 3

12' Perm. Easm't.

3 strand barb w. fnc.

Proposed Clubhouse, Tennis Courts and Swimming Pool area.

Sta. 5+30.0 Const. Std. M.H. Type "A"

26 E

Sta. 7+64.0 Const. Std. M.H. Type "A"

49 E

Sta. 7+15.0 Const. Std. M.H. Type "A"

10 ℄

Sta. 9+52.0 Const. Std. M.H. Type "A"

48 E

Sta. 8+74.0 Const. Std. M.H. Type "A"

49 ℄

Sta. 10+52.0 Const. Std. M.H. Type "A" Install 8" Stub So.

48 ℄

8" AC water line.

NOTE: This line being parallel to and 473.16' North of the South line of Sec. 32-27-22.

NOTE: This line being parallel to and 325.16' East of the West line of Sec. 32-27-22

+33.16'

105'

OAK KNOLL

40'

PART OF LOT 1, BLOCK 3 CHERRY CREEK HILLS

ROCK ROAD

985.26'

S.W. COR. S.W. ¼ 32-27-22

Sta. 0+00.0 Line No. 3 = Sta. 3+82.1 Line No. 1

Sta. 2+70.0 Const. Std. M.H. Type "A"

Sta. 5+30.0 Const. Std. M.H. Type "A"

Sta. 7+15.0 Const. Std. M.H. Type "A"

Sta. 7+54.0 Const. Std. M.H. Type "A"

Sta. 8+74.0 Const. Std. M.H. Type "A"

Sta. 8+83. Proposed 8" AC water line

Sta. 9+52.0 Const. Std. M.H. Type "A"

Sta. 10+52.0 Const. Std. M.H. Type "A" Install 8" Stub So.

Existed natural ground

Proposed ground elev.

TR= 171.6

TR= 176.0

TR= 174.0

TR= 176.0

TR= 182.0

TR= 180.0

TR= 183.0

LINE NO. 3

Bldg. 3 Bldg. 4 Bldg. 2 Bldg. 1 Bldg. 5 Bldg. 50 Bldg. 12 Bldg. 13 Bldg. 14 Bldg. 17

Bot. of Fig. 142.1

Bot. of Fig. 143.17

Bot. of Fig. 172.11

185 180 175 170 165 160 155 150

162.30 162.90 163.50 163.92 F/O 164.10 164.70 165.30 165.48 F/O 165.62 166.50 166.59 F/O out 166.69 F/O in 166.87 167.47 F/O out 168.69 169.97 F/O out 170.07 F/O in 170.59 171.63 F/O out 171.73 F/O in 172.69 173.73 F/O

715.0 Lin. ft. of 8" Clay Pipe @ 0.60% grade.

337.0 Lin. ft. of 8" Clay Pipe @ 2.00 % grade.

0 1 2 4 5 6 7 8 9 10

LAT. 16, MAIN 17, W. I. S.
PROJECT NO. DBKL573082

Sheet 4/4