






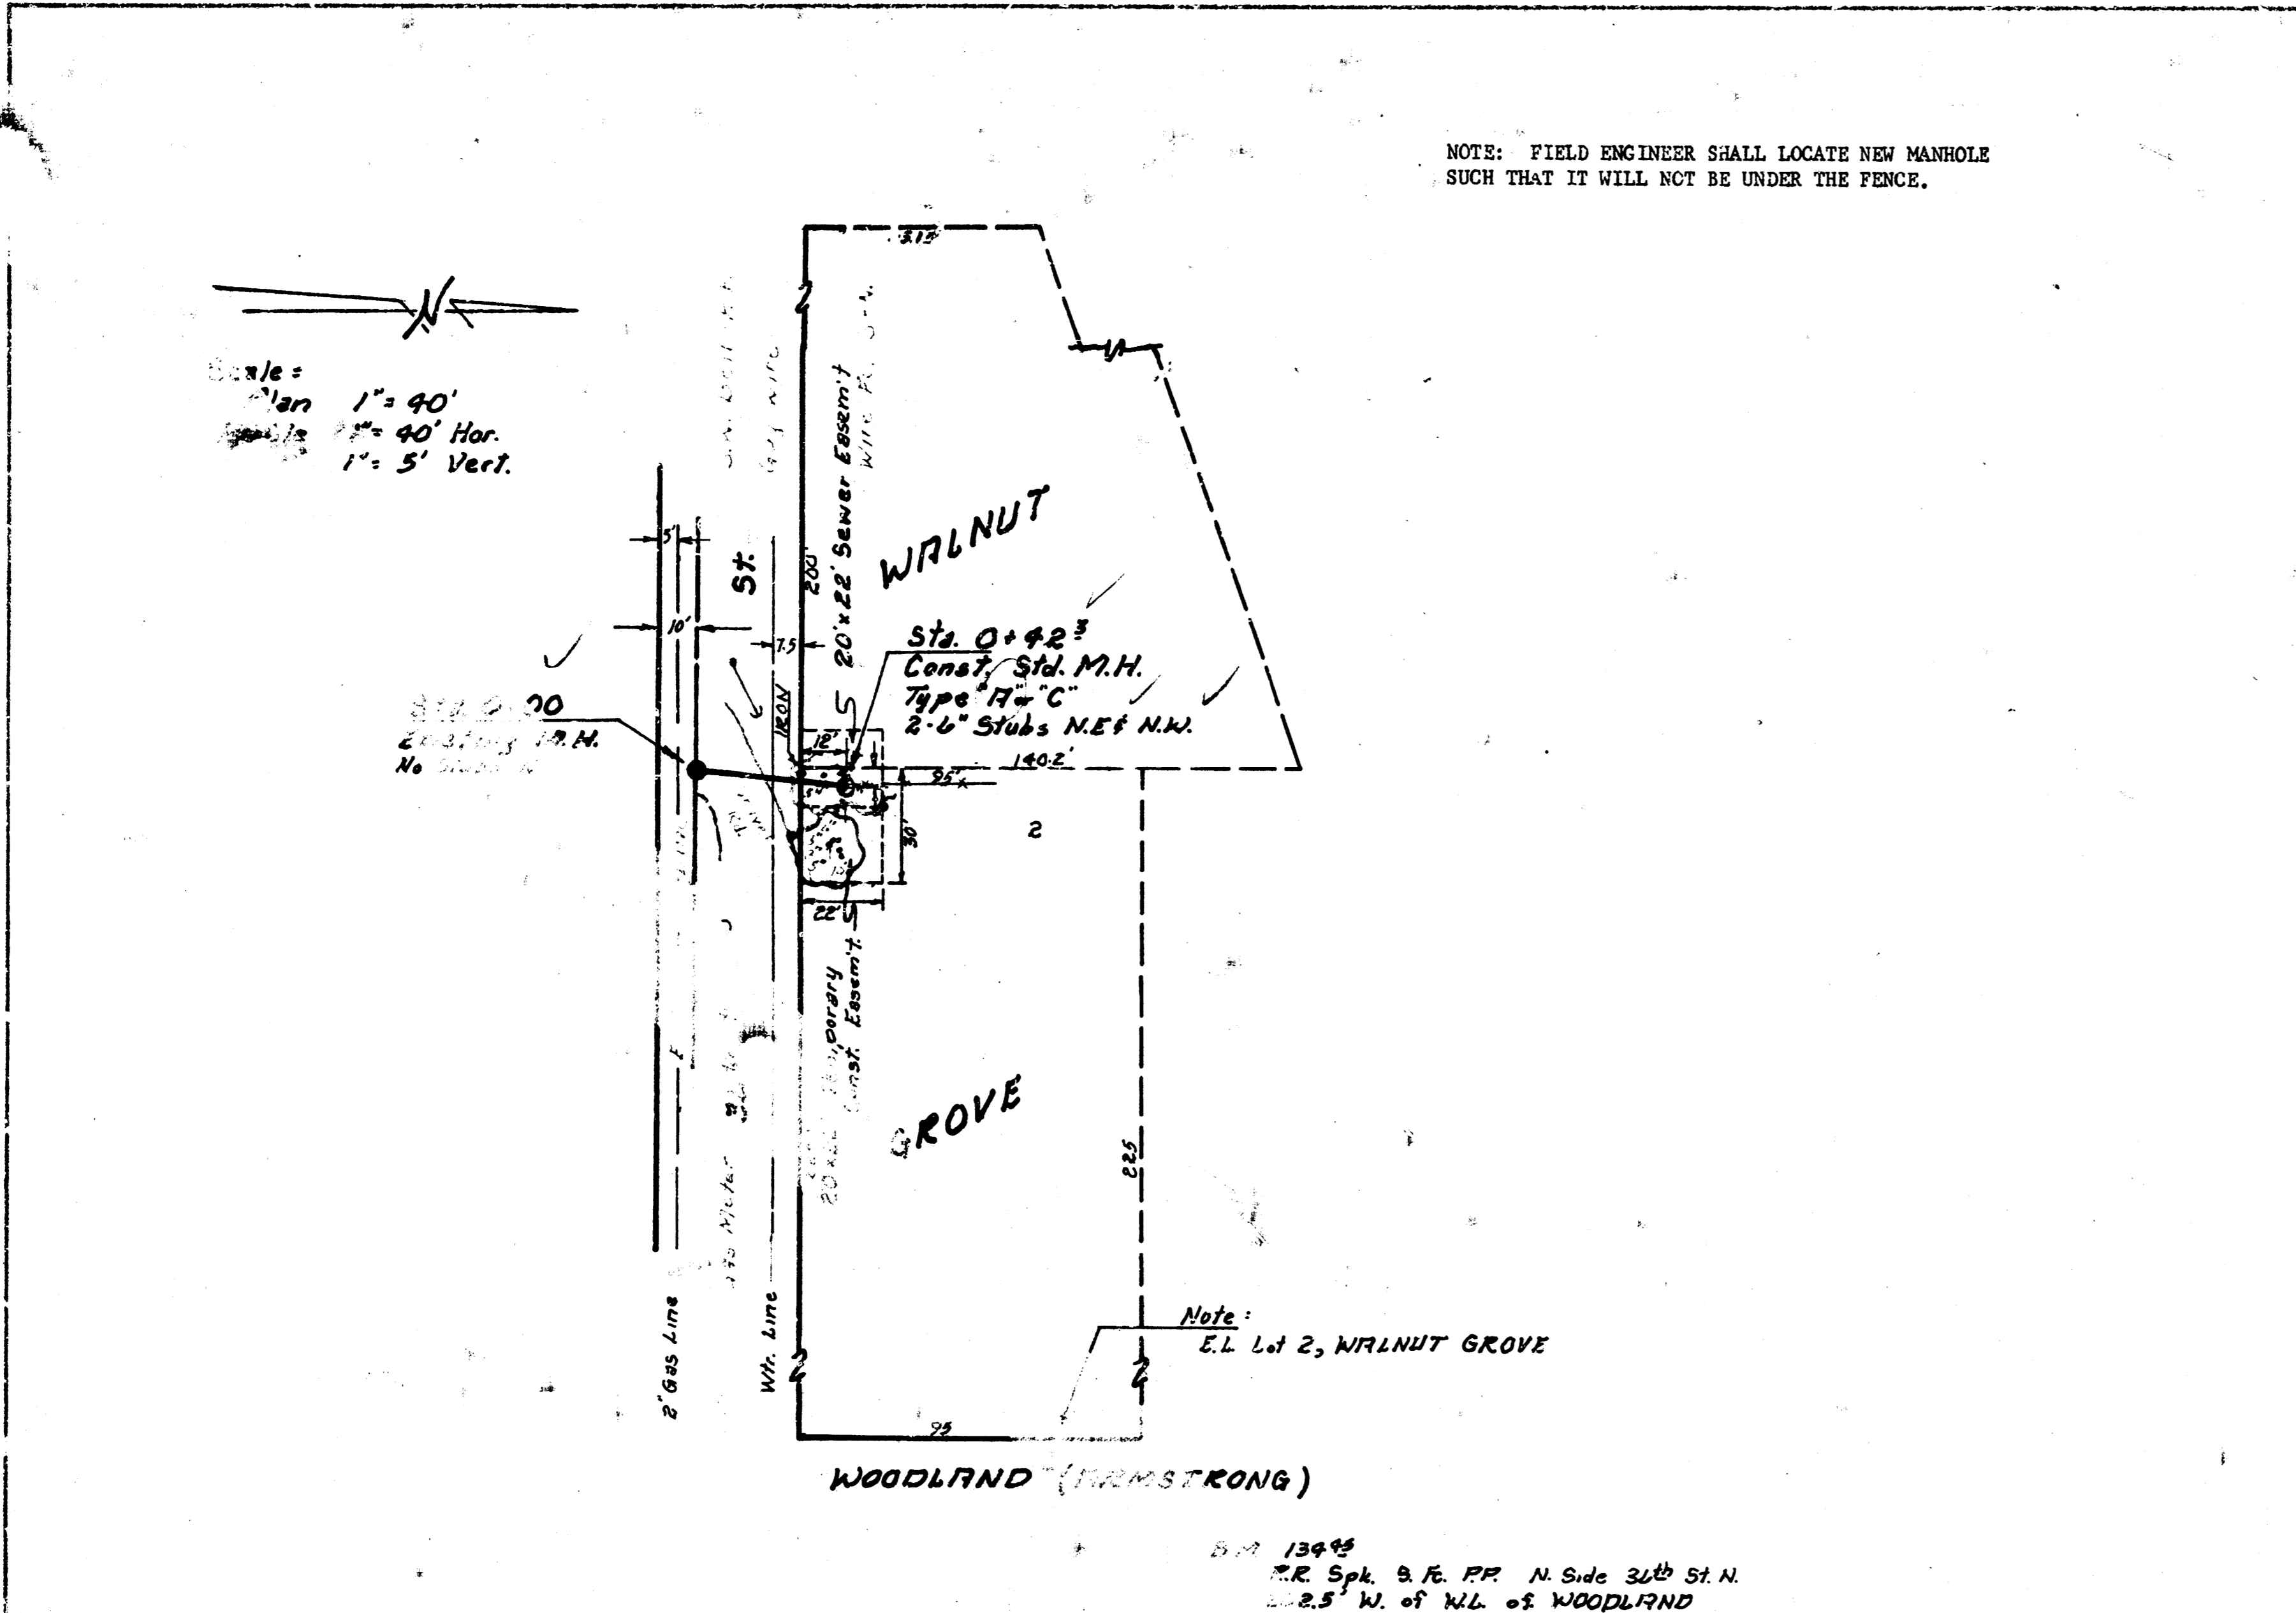


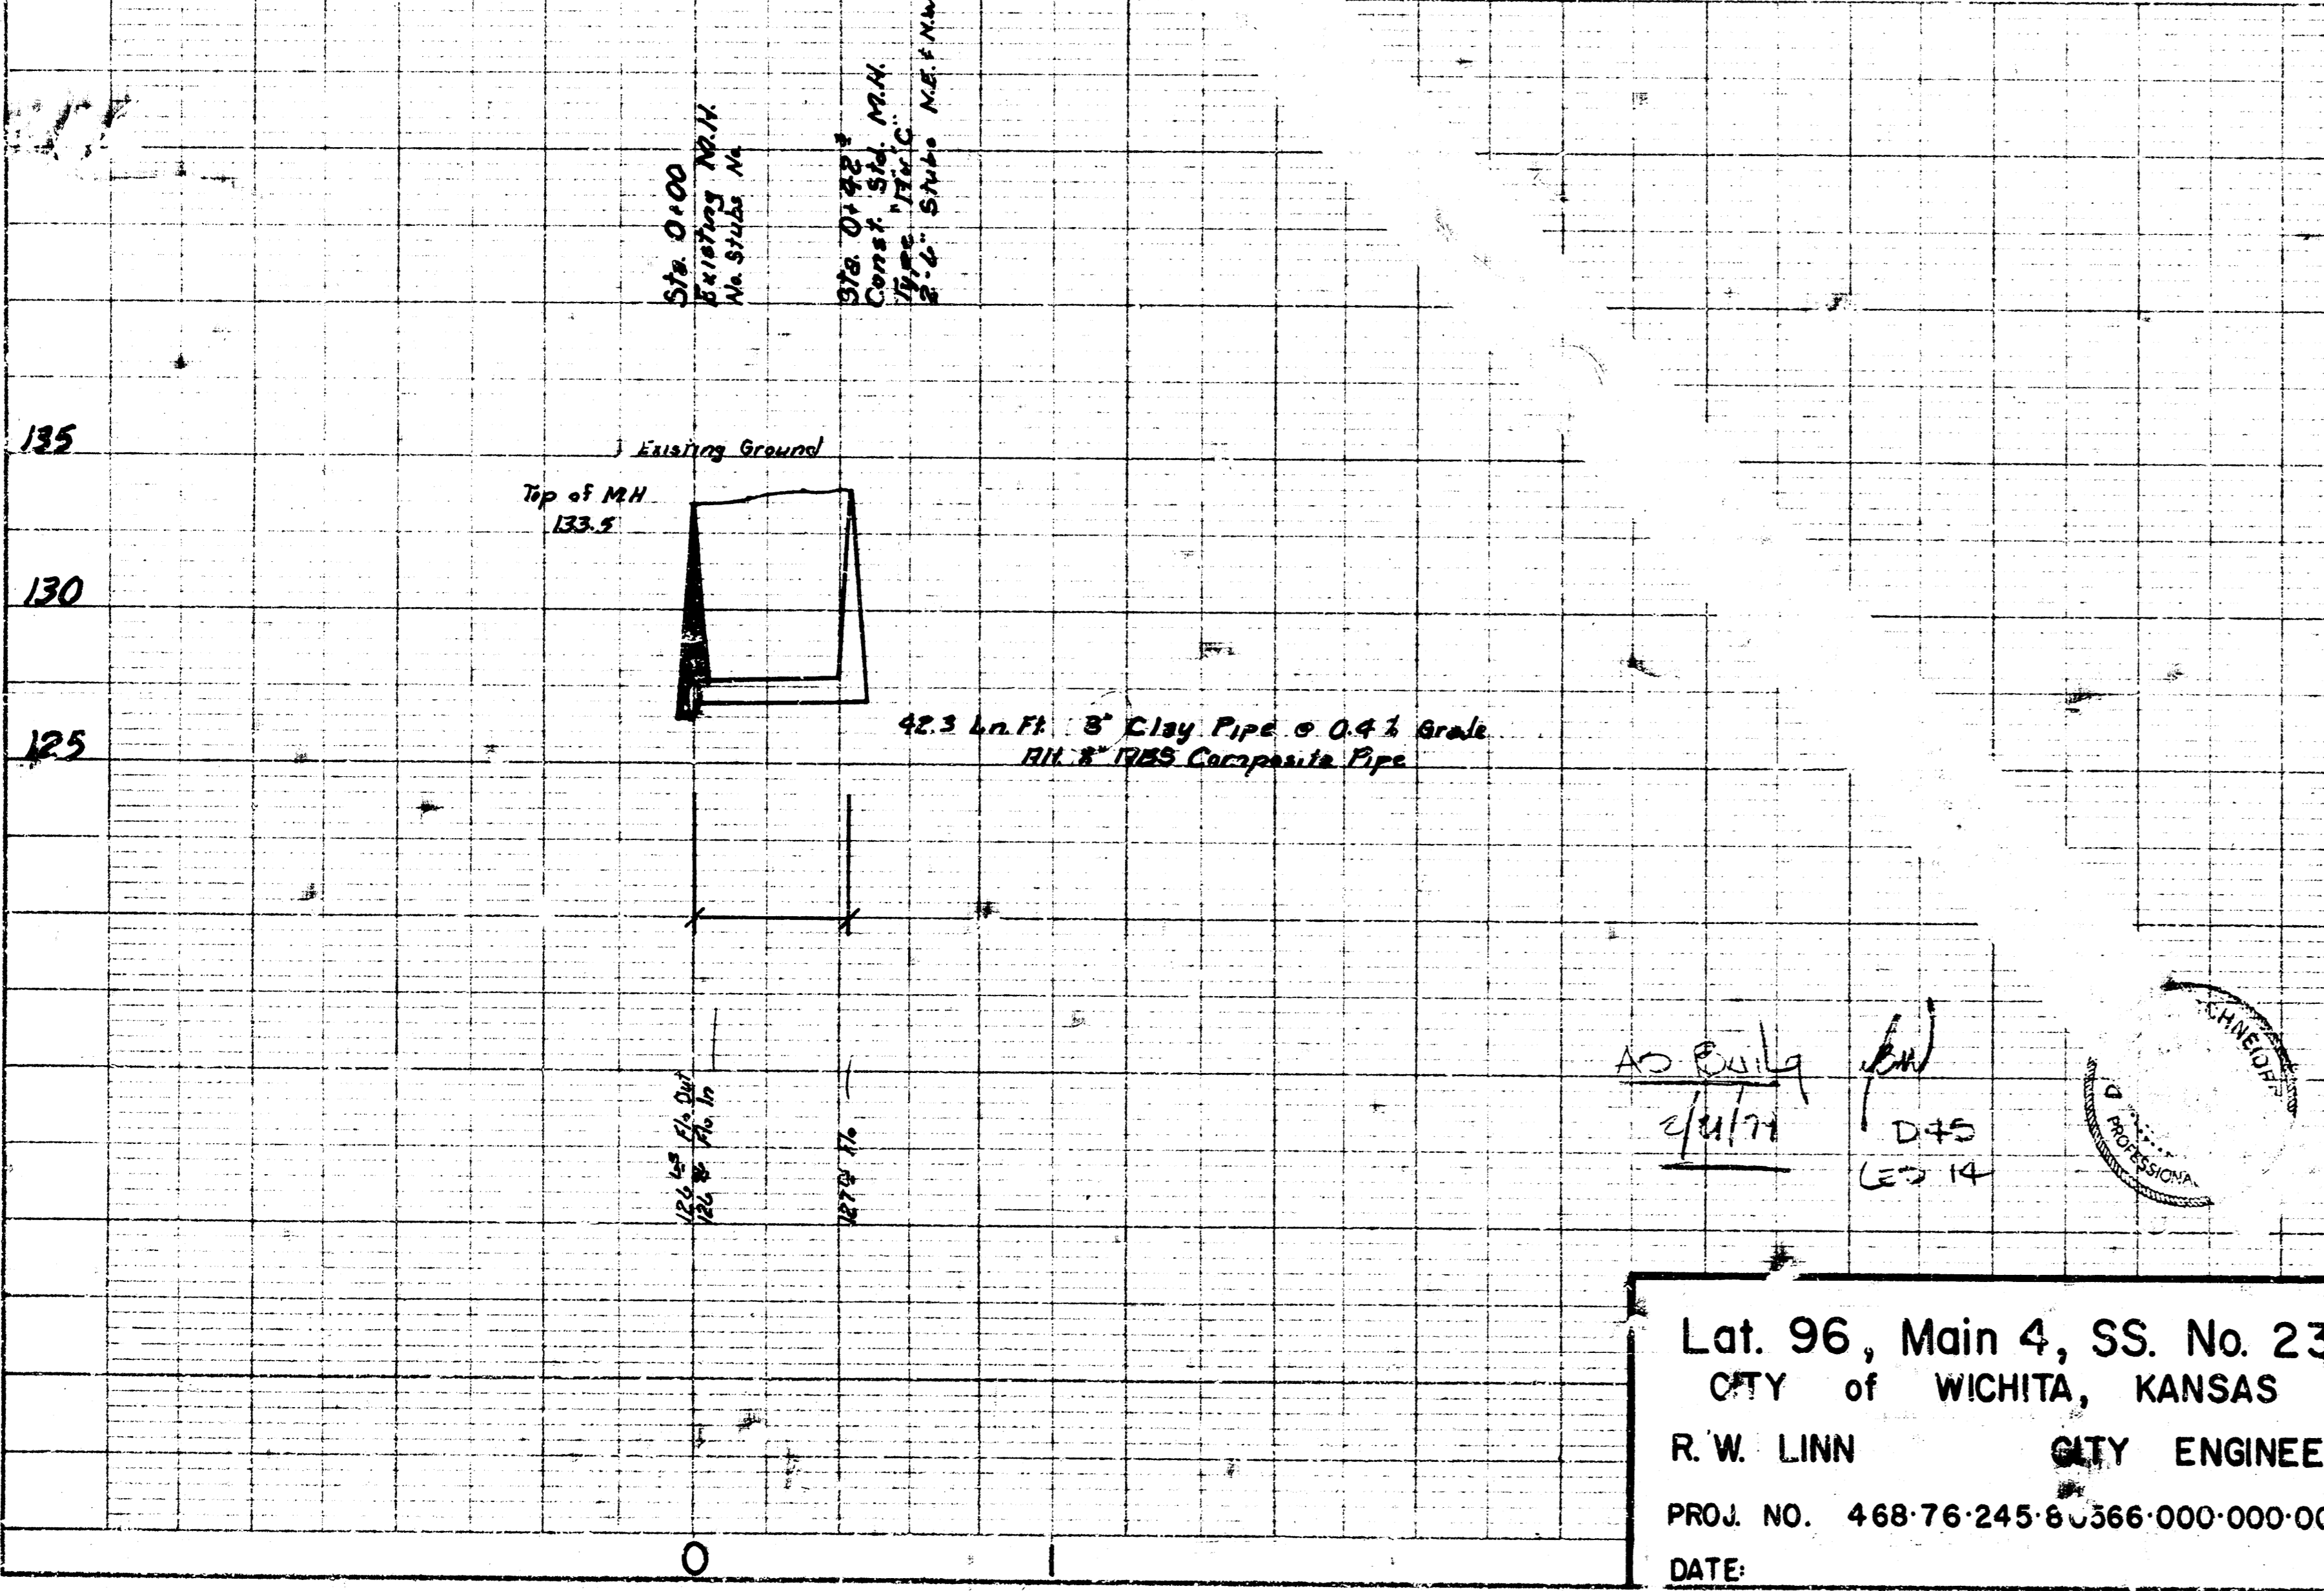

Lat. 96, Main 4, SS. No. 23
 CITY of WICHITA, KANSAS
 R. W. LINN CITY ENGINEER
 DATE:

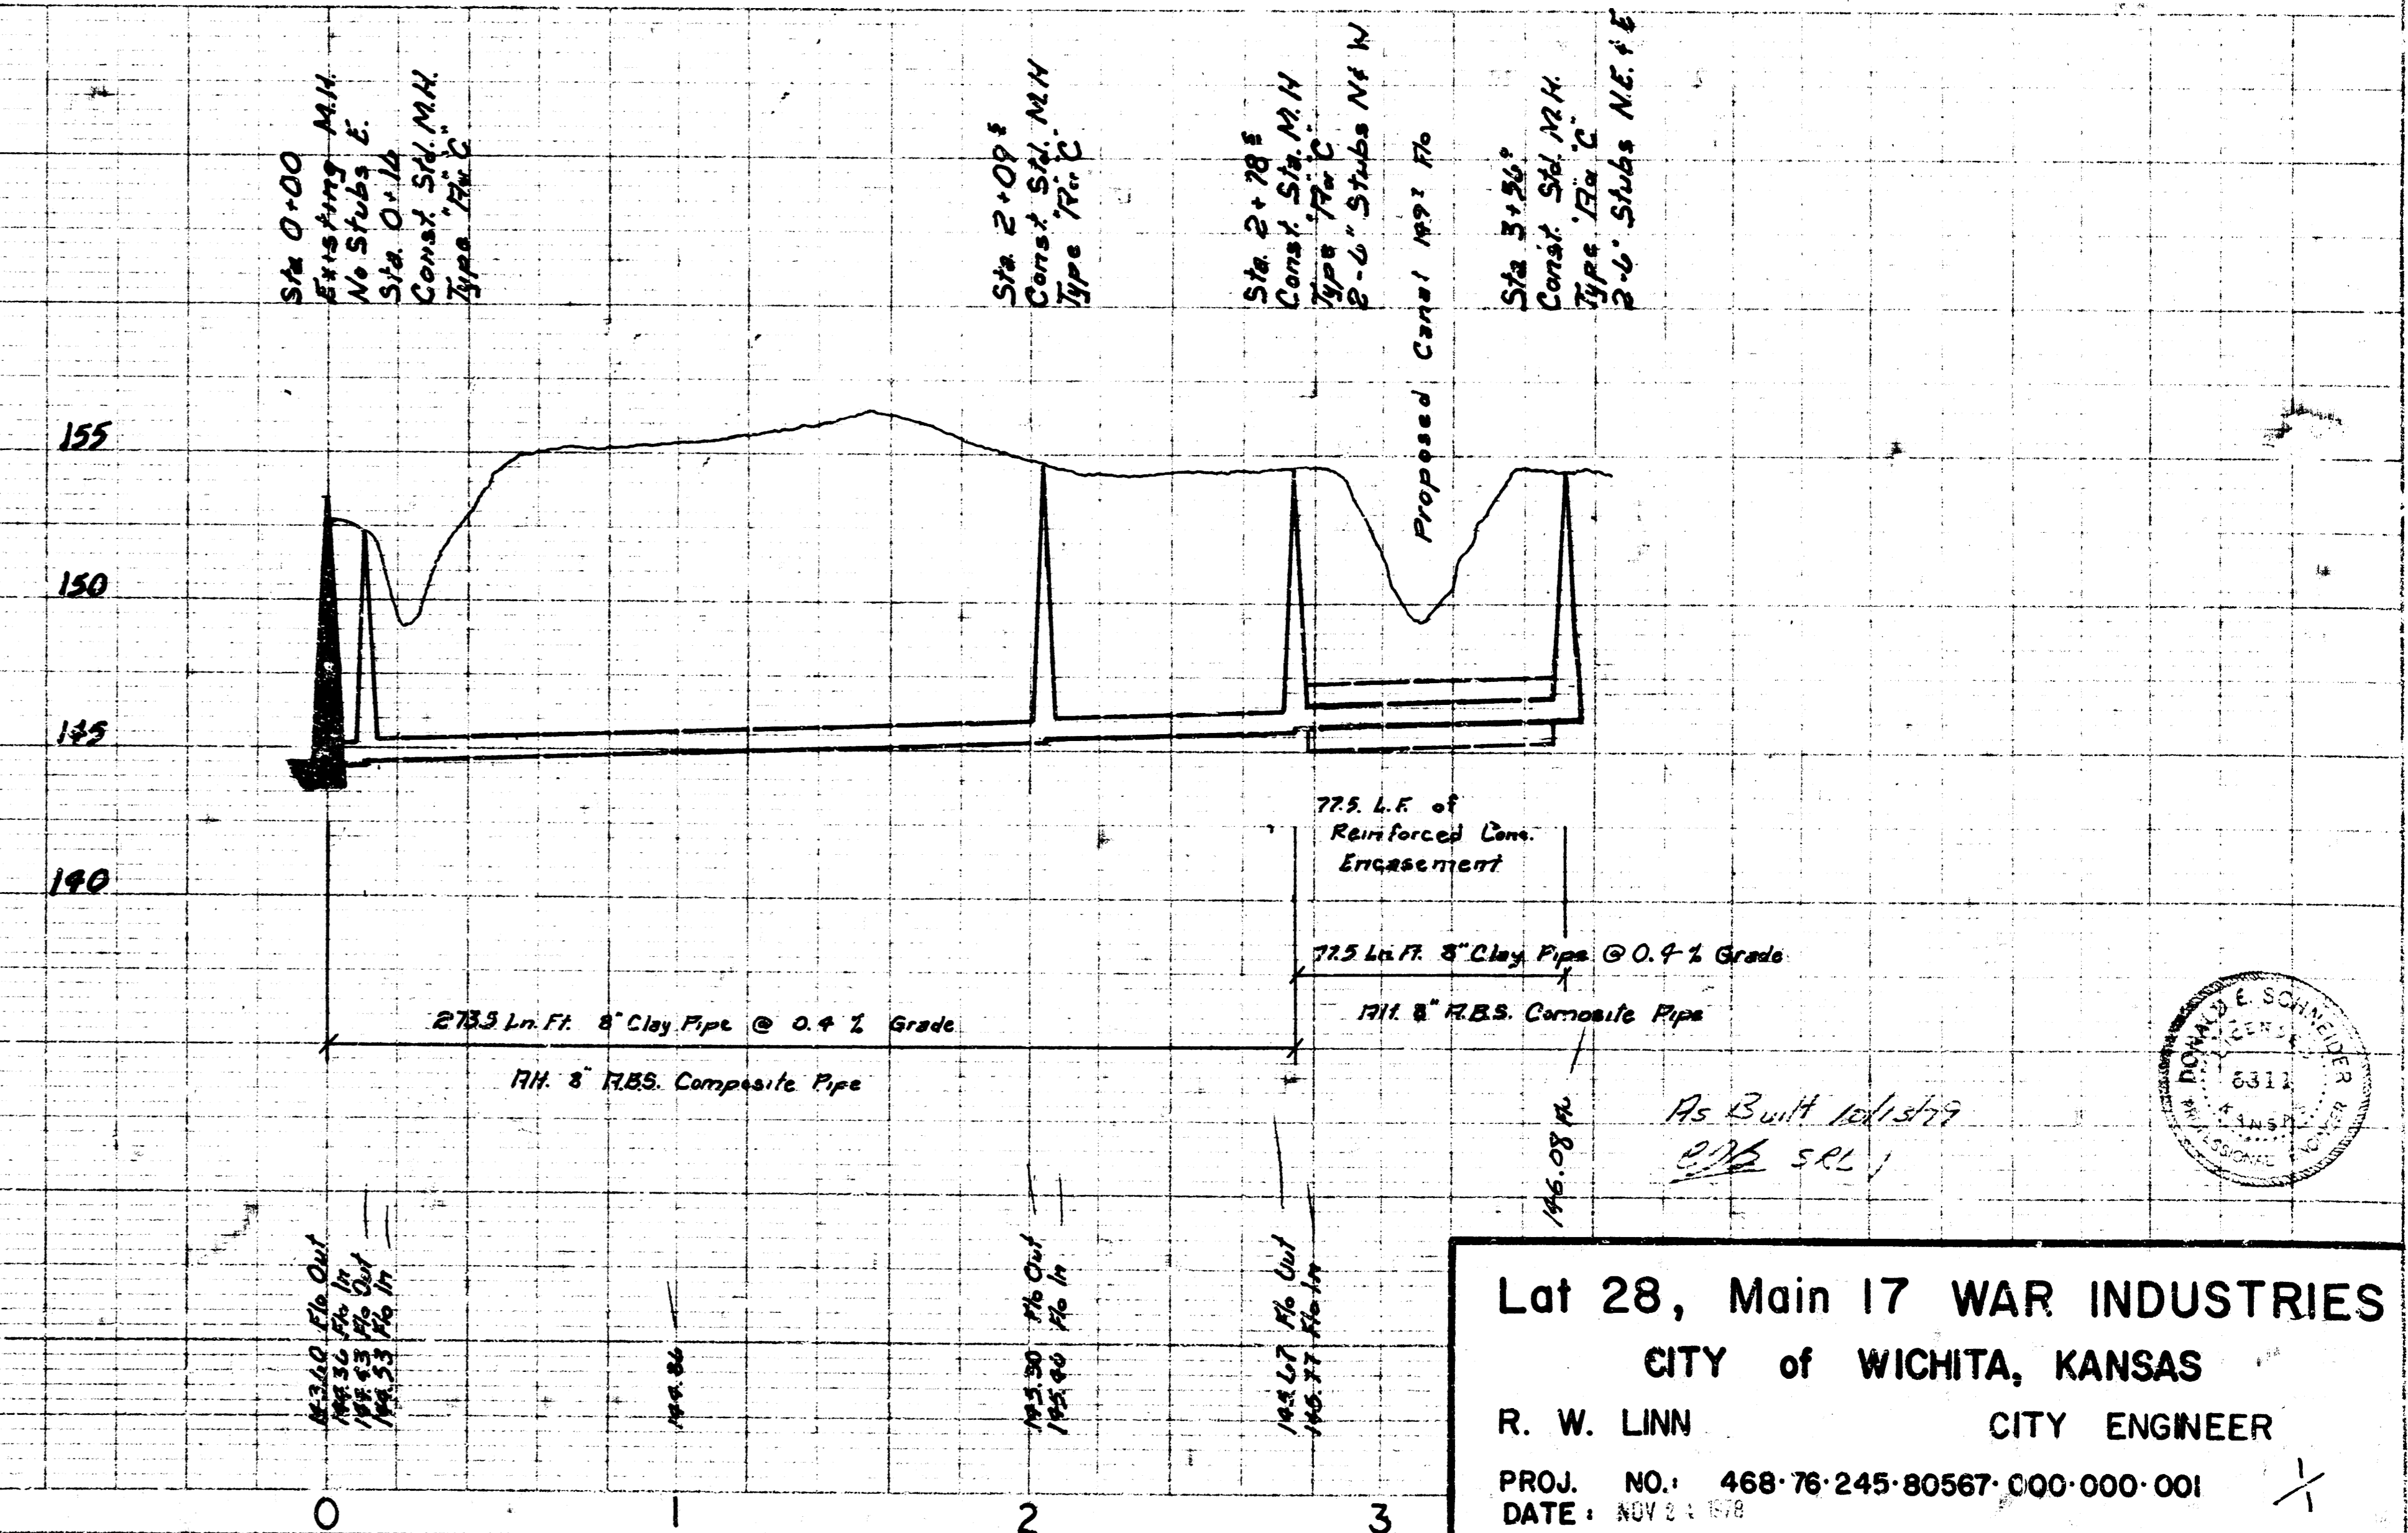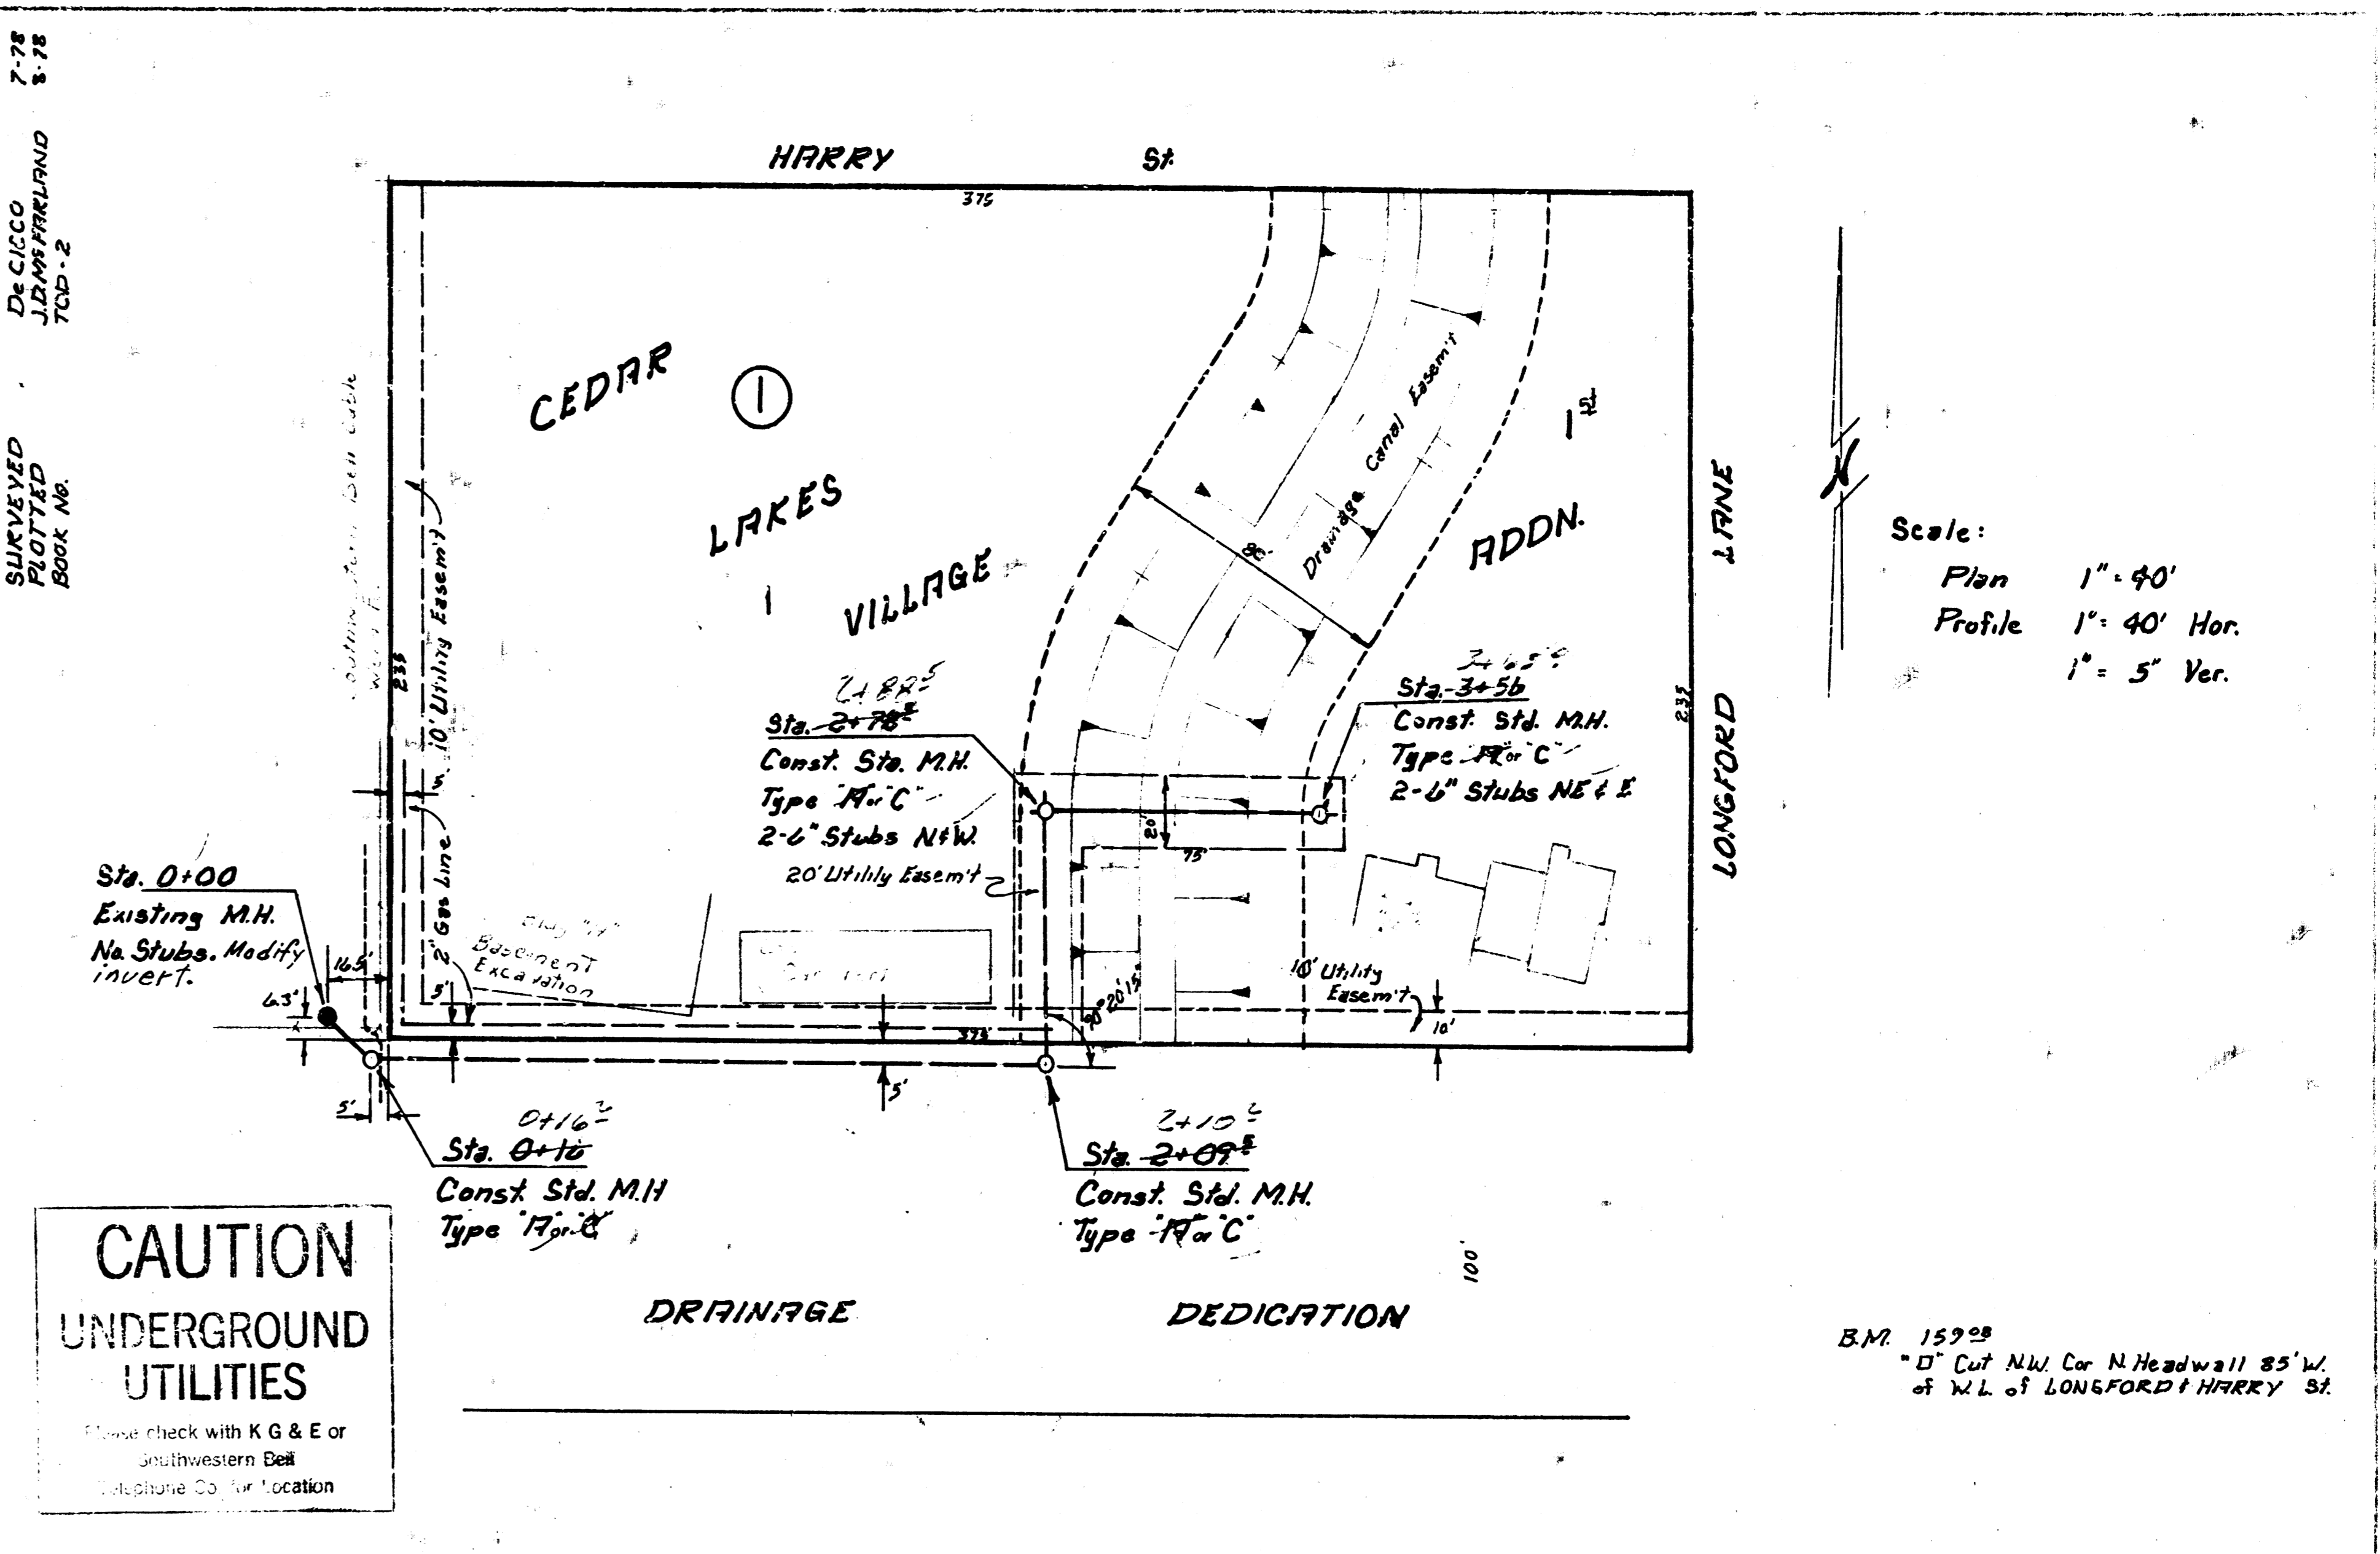

Lat. 28, Main 17 WAR INDUSTRIES
 CITY of WICHITA, KANSAS
 R. W. LINN CITY ENGINEER
 PROJ. NO. 468-76-245-80567-000-001
 DATE: NOV 2 1978