
MAIN 18 , WAR INDUSTRIES SEWER

CITY OF WICHITA, KANSAS

R. W. LINN – CITY ENGINEER

FEB. 1974, PROJECT NO. DBKM573068

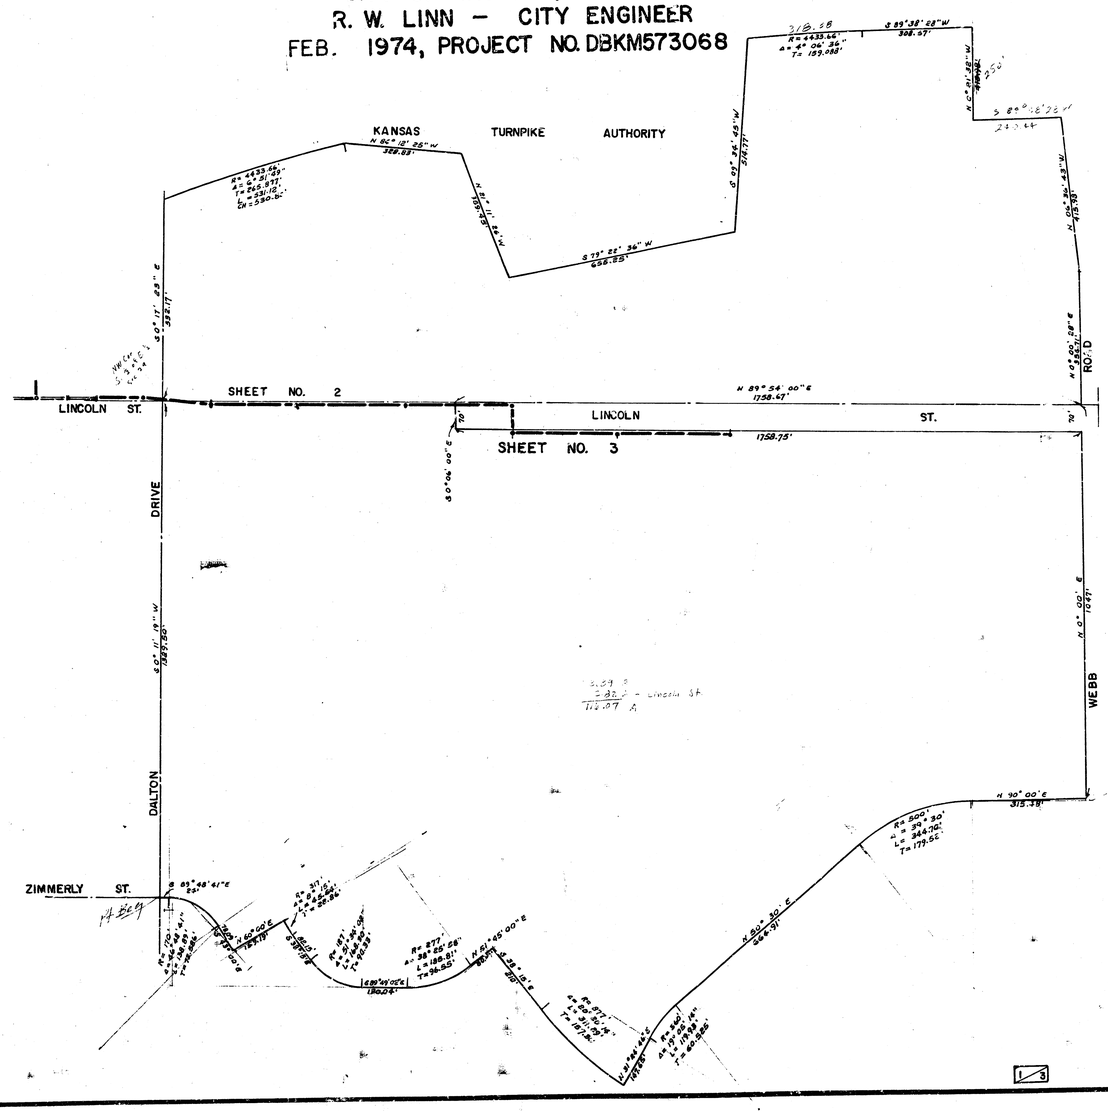

"As Built" Final Meas. 268.8

NOTE: Sheet No. 3 Revised March 6, 1974

1/3

1/3

B. M. 172.03 City Std. S.W. cor. Harry - Webb Road 48' S. & 46' W. of ℄ both.

B. M. 174.66 R.R. spk. S-face hedge cor. post W-Side Webb Road 1/8 mi N. of Harry.

TIES TO IRON CTR. SEC. 29-27-2E
86.57' S.W. to "T" lap S-cb Lincoln.
43' W. of W.L. Dalton.
57.20' S.W. to "T" lap S-cb. Lincoln
11.5' W. of W.L. Dalton.
51.20' S.W. to nail in pap on W-face P.P.
S.W. cor. Lincoln & Dalton.
85.31' S.W. to NE cor. garage.

B. M. 165.272 use Std. N.W. cor. Rosalia & Zimmerly.

B. M. 161.745 R.R. Spike E-face Street lite pole S.W. cor. Lincoln & Dalton.

Plan Scale 1" = 40' Horz.
Profile Scale 1" = 5' Vert.

N

LINCOLN COURT

LINCOLN MEADOWS ADDITION

Proposed

NOTE: Reset Iron.

Kansas Turnpike Right of Way
TRACT NO. 556
20' Perm. Easement

179°-05'

135.9'

165.96'

443.65'

10' x 150' Perm. Easement

20' temp. Const. Easement.

377.30'

℄ Proposed Easm't. S.C.

Sta. 8105
2-36" R.C. Pipes
Flo 148.00

Sta. 10+40.0 Const. Std. M.H. Type "A"

Sta. 8130 End Cradle

10' Perm. Easement

139.00'

94'±

Sta. 4193.6 const. Std. M.H. Type "A" Install 8" Stub North Install 8" Stub South

Sta. 7+30.0 Const. Std. M.H. Type "A" Install 8" Stub SE Begin Cradle

Proposed Easement

Proposed BRECKENRIDGE ADDITION

CYPRESS

LINCOLN ST. Exist. A.C. Pavement

DALTON DR.

Sta. 0+00.0 Exist. M.H.

Sta. 1+74.9 Beg. project Const. Std. M.H. Type "A" over exist. 10" S.S.

NOTE: * Extend steel above Center of Pipe from Sta. 7+10 to Sta. 8+30

Pour to Center of pipe.
No. 5 bars at 2'-0" Ctrs.
2-No. 5 bars in Corners
8" min. sides and bottom.
SECTION A-A

Trench
No. 5 bars at 2'-0" Ctrs.
6 Sack paving mix
2-No. 5 bars in corners
SECTION B-B

Sta. 7+30 to Sta. 8+30

REINFORCED CONCRETE CRADLE

NOTE: Lump Sum bid for clearing of R/w is to include the removal of fences, trees, hedge etc. necessary to construct the project.

Natural ground

Exist. 10" S.S. @ 0.40 % grade.

153.81 E. Rim M.H.

Bot 36" SWS 147.67
Top 10" SS 147.38

100 Lin. ft. of 8" Reinf. Conc. Cradle. See detail on this Sheet.

NOTE: Extend the cradle steel into the base and wall of M.H.

144.68 Flo exist

145.21' Plan Flo
145.26
145.46
145.66
145.85 Flo
146.02 Flo in 8" Stubs
146.06
146.26
146.39 Flo
146.49 Flo in 8" Stub SE
146.46
146.66
146.86
146.94 Flo

565.1 Lin. ft. of 10" Clay Pipe @ 0.20 % grade.

160
155
150
145
140

0 1 2 3 4 5 6 7 8 9 10


MAIN 18, WAR INDUSTRIES SEWER
CITY OF WICHITA, KANSAS 2/3
R. W. LINN — CITY ENGINEER
FEB. 1974 PROJECT NO. DBKM573068

2/3

FILMED FROM THE BEST AVAILABLE COPY....

B. M. 160.76 Std. South side of Harry ½ mile east of Rock Rd. (Elev. not established)

B. M. 174.64 R. R. spk. S-face hedge cor. post W-side Webb Road ½ mile N. of Harry.

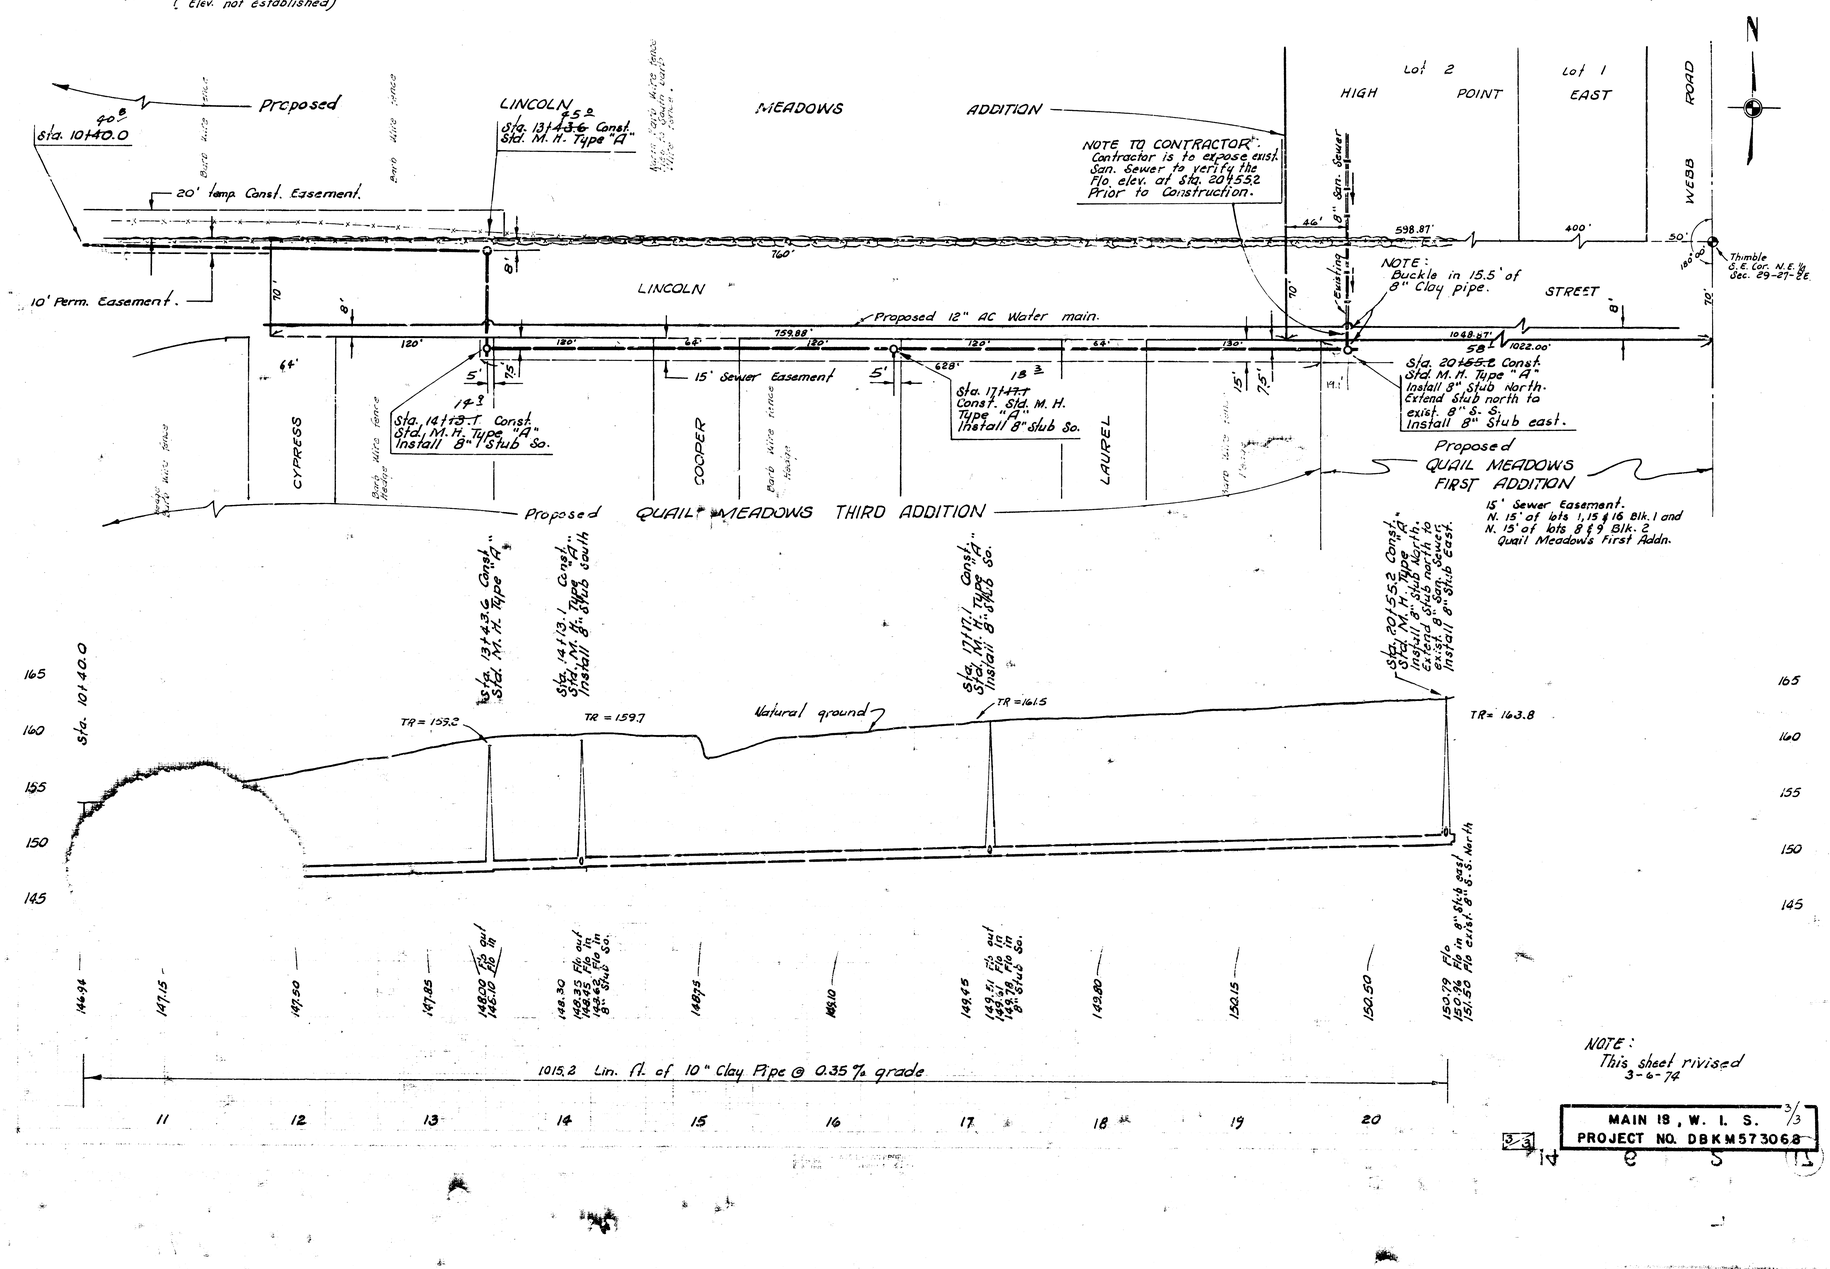

NOTE:
This sheet rivised
3-6-74

MAIN 18, W. I. S. 3/3
PROJECT NO. DBKM573068

FILMED FROM THE BEST COPY