
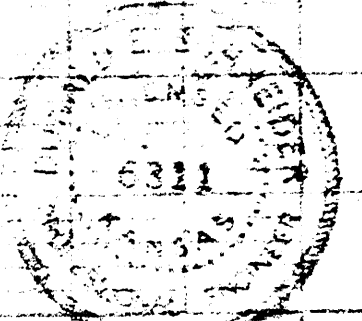
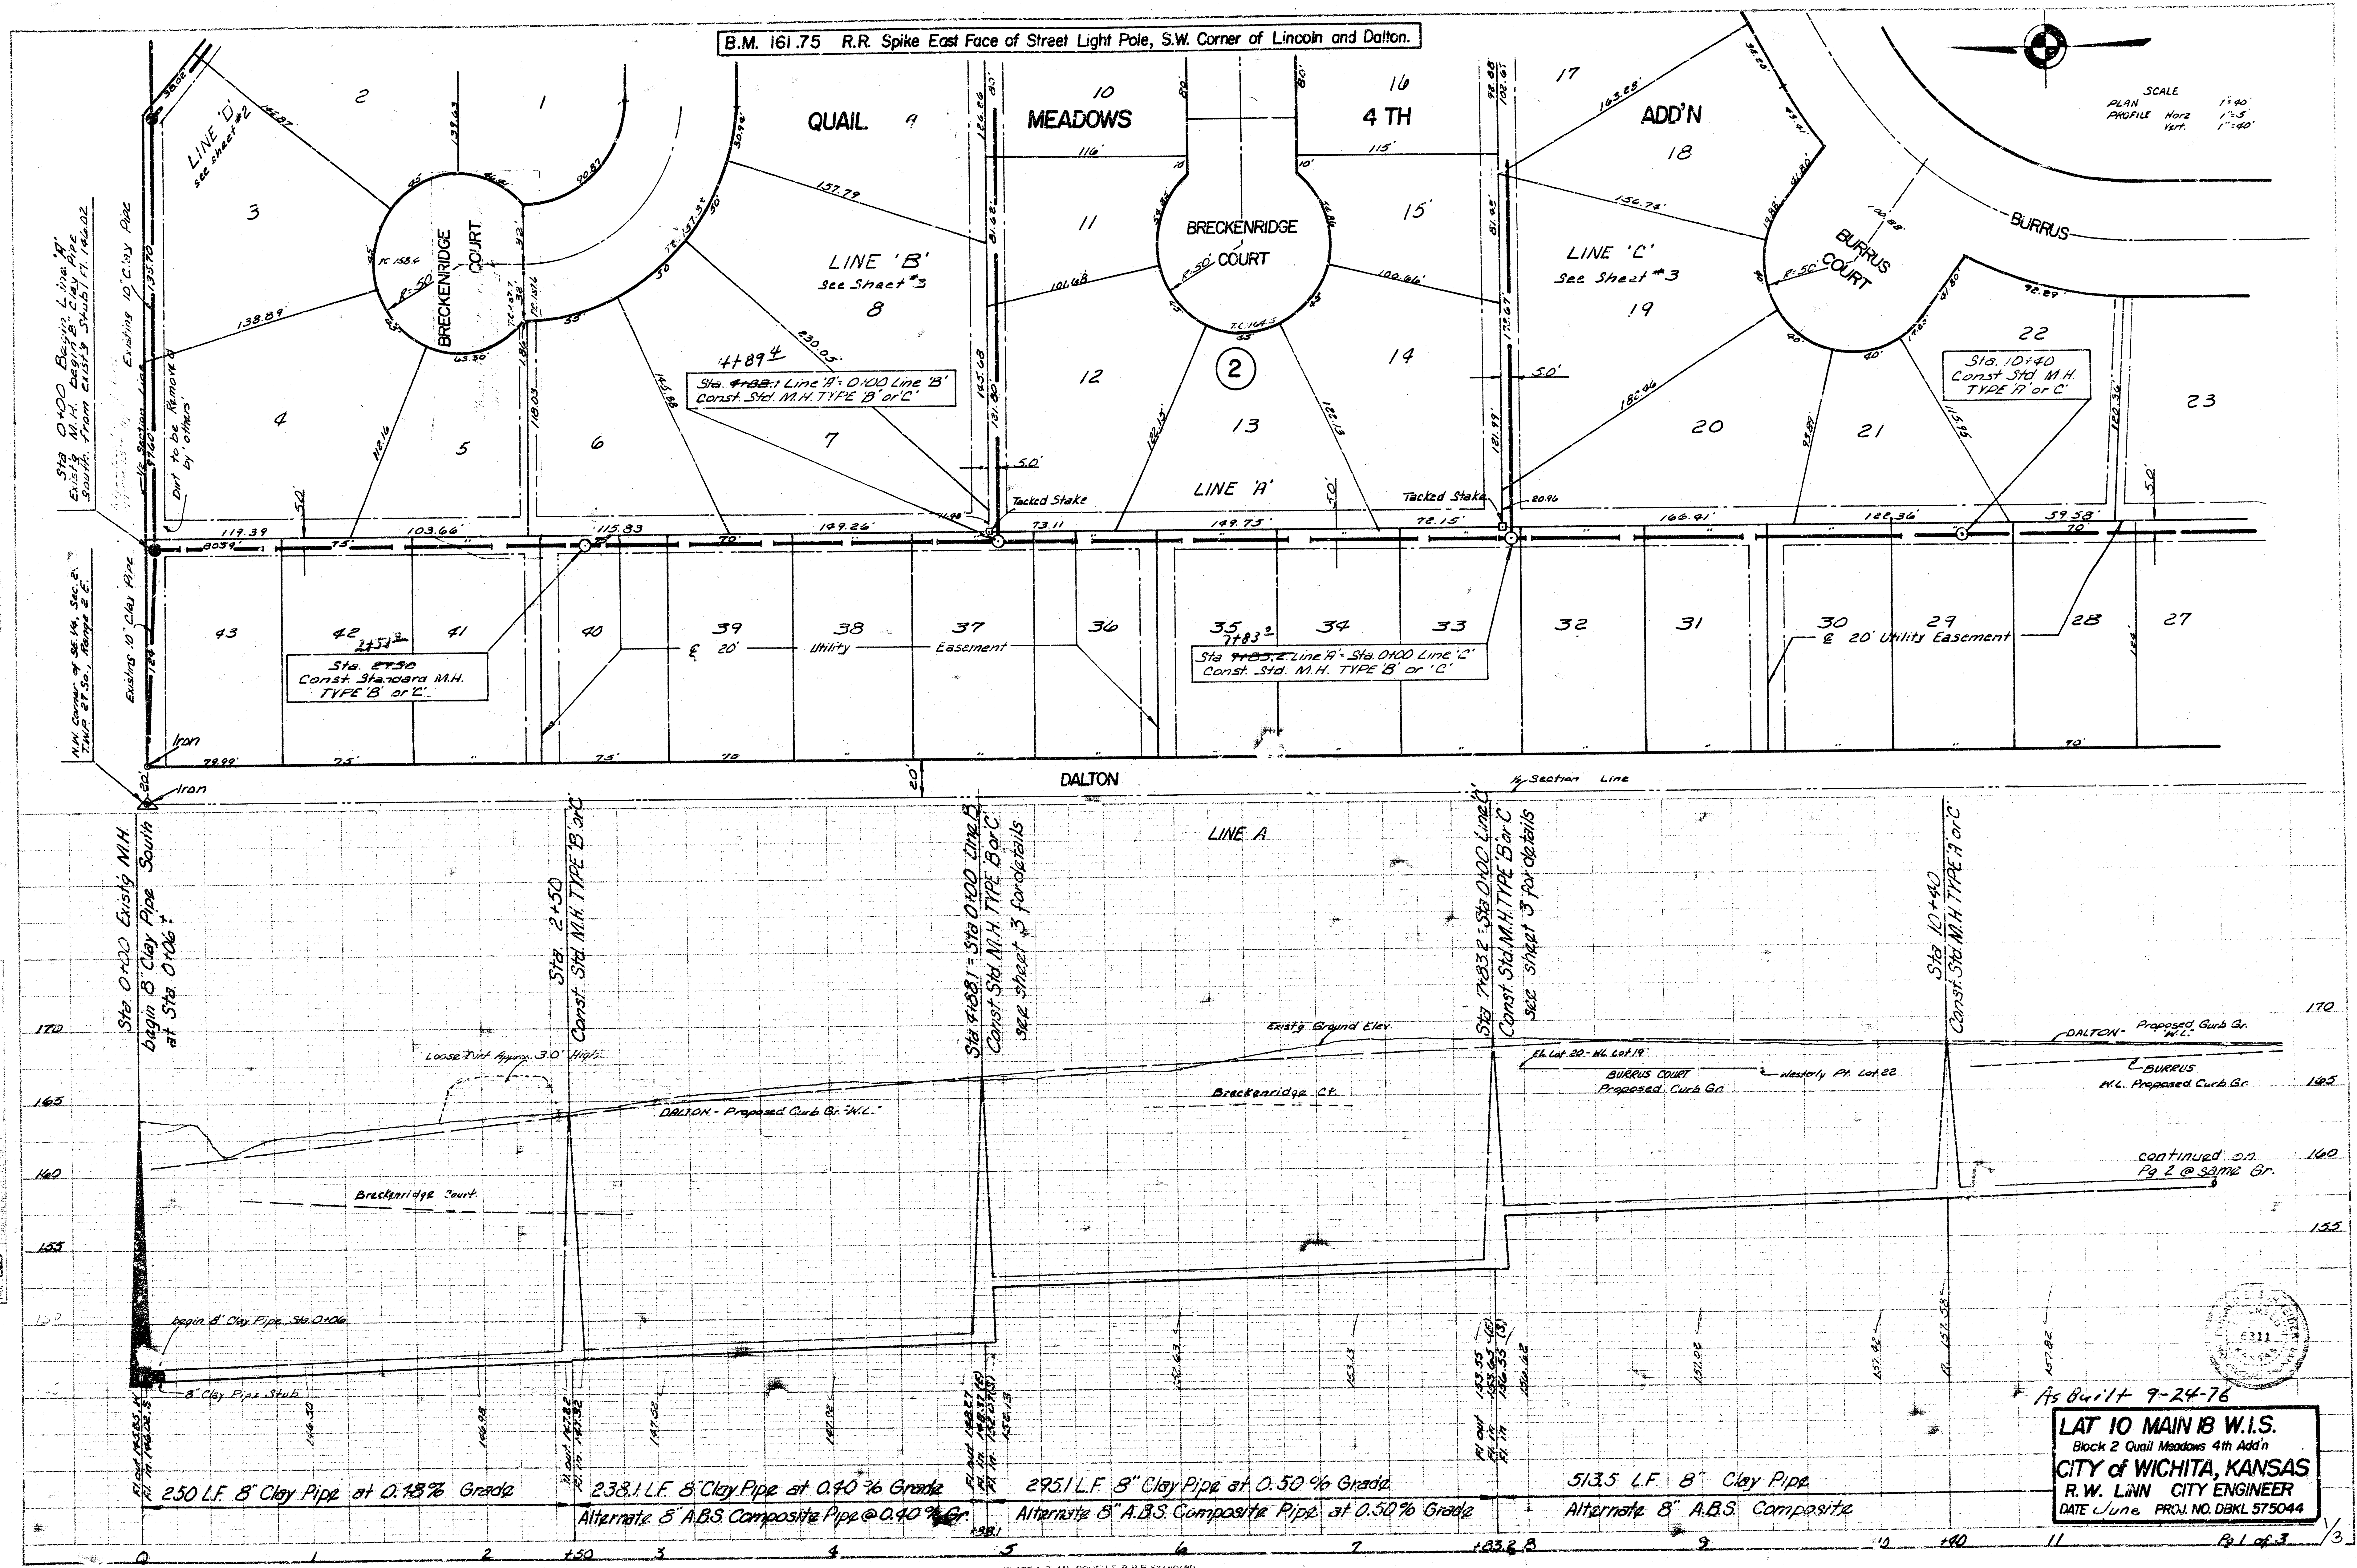
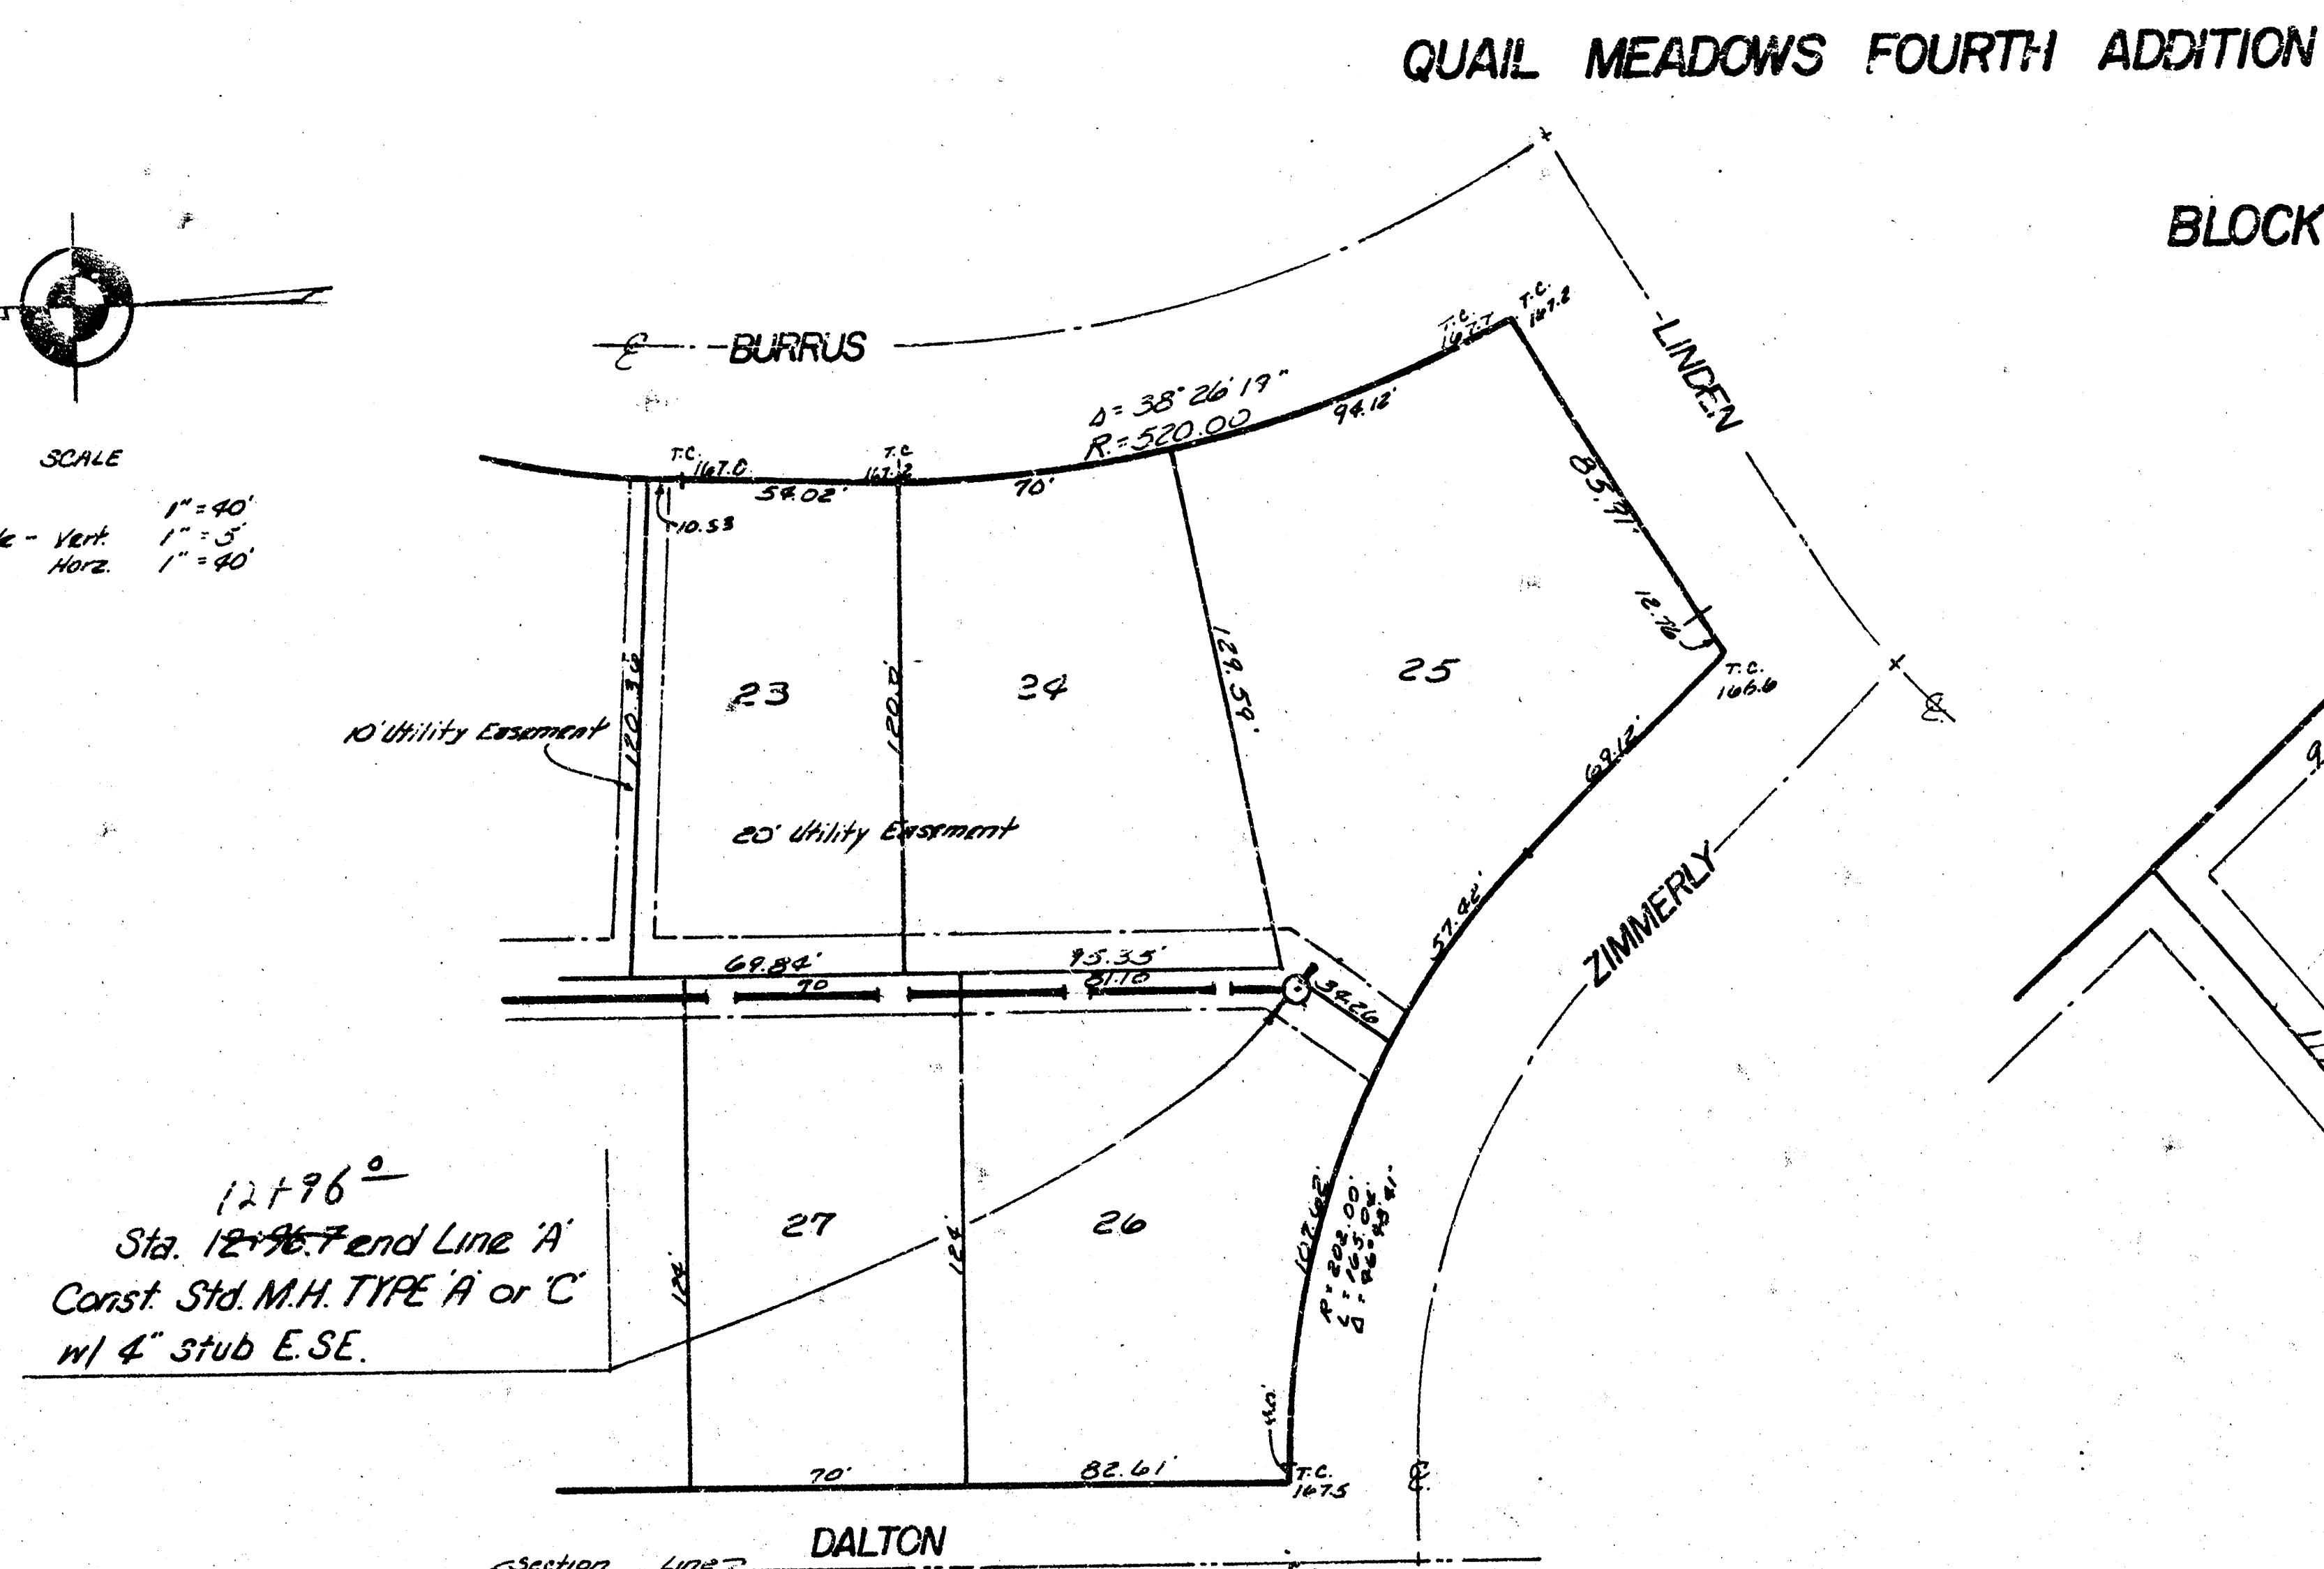


PLAN
 1" = 40'
 1" = 40'

PLAN
 1" = 40'
 1" = 40'

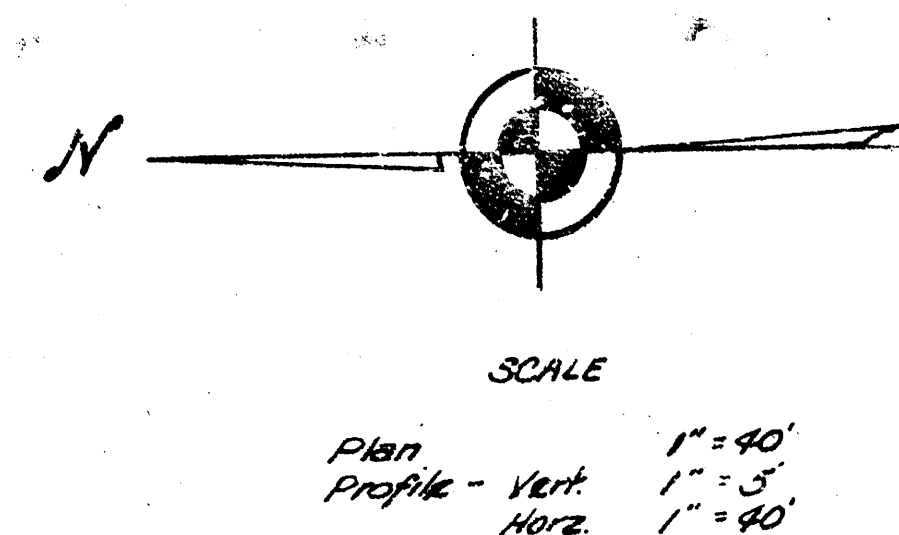


[illegible]

BLOCK NO. 2



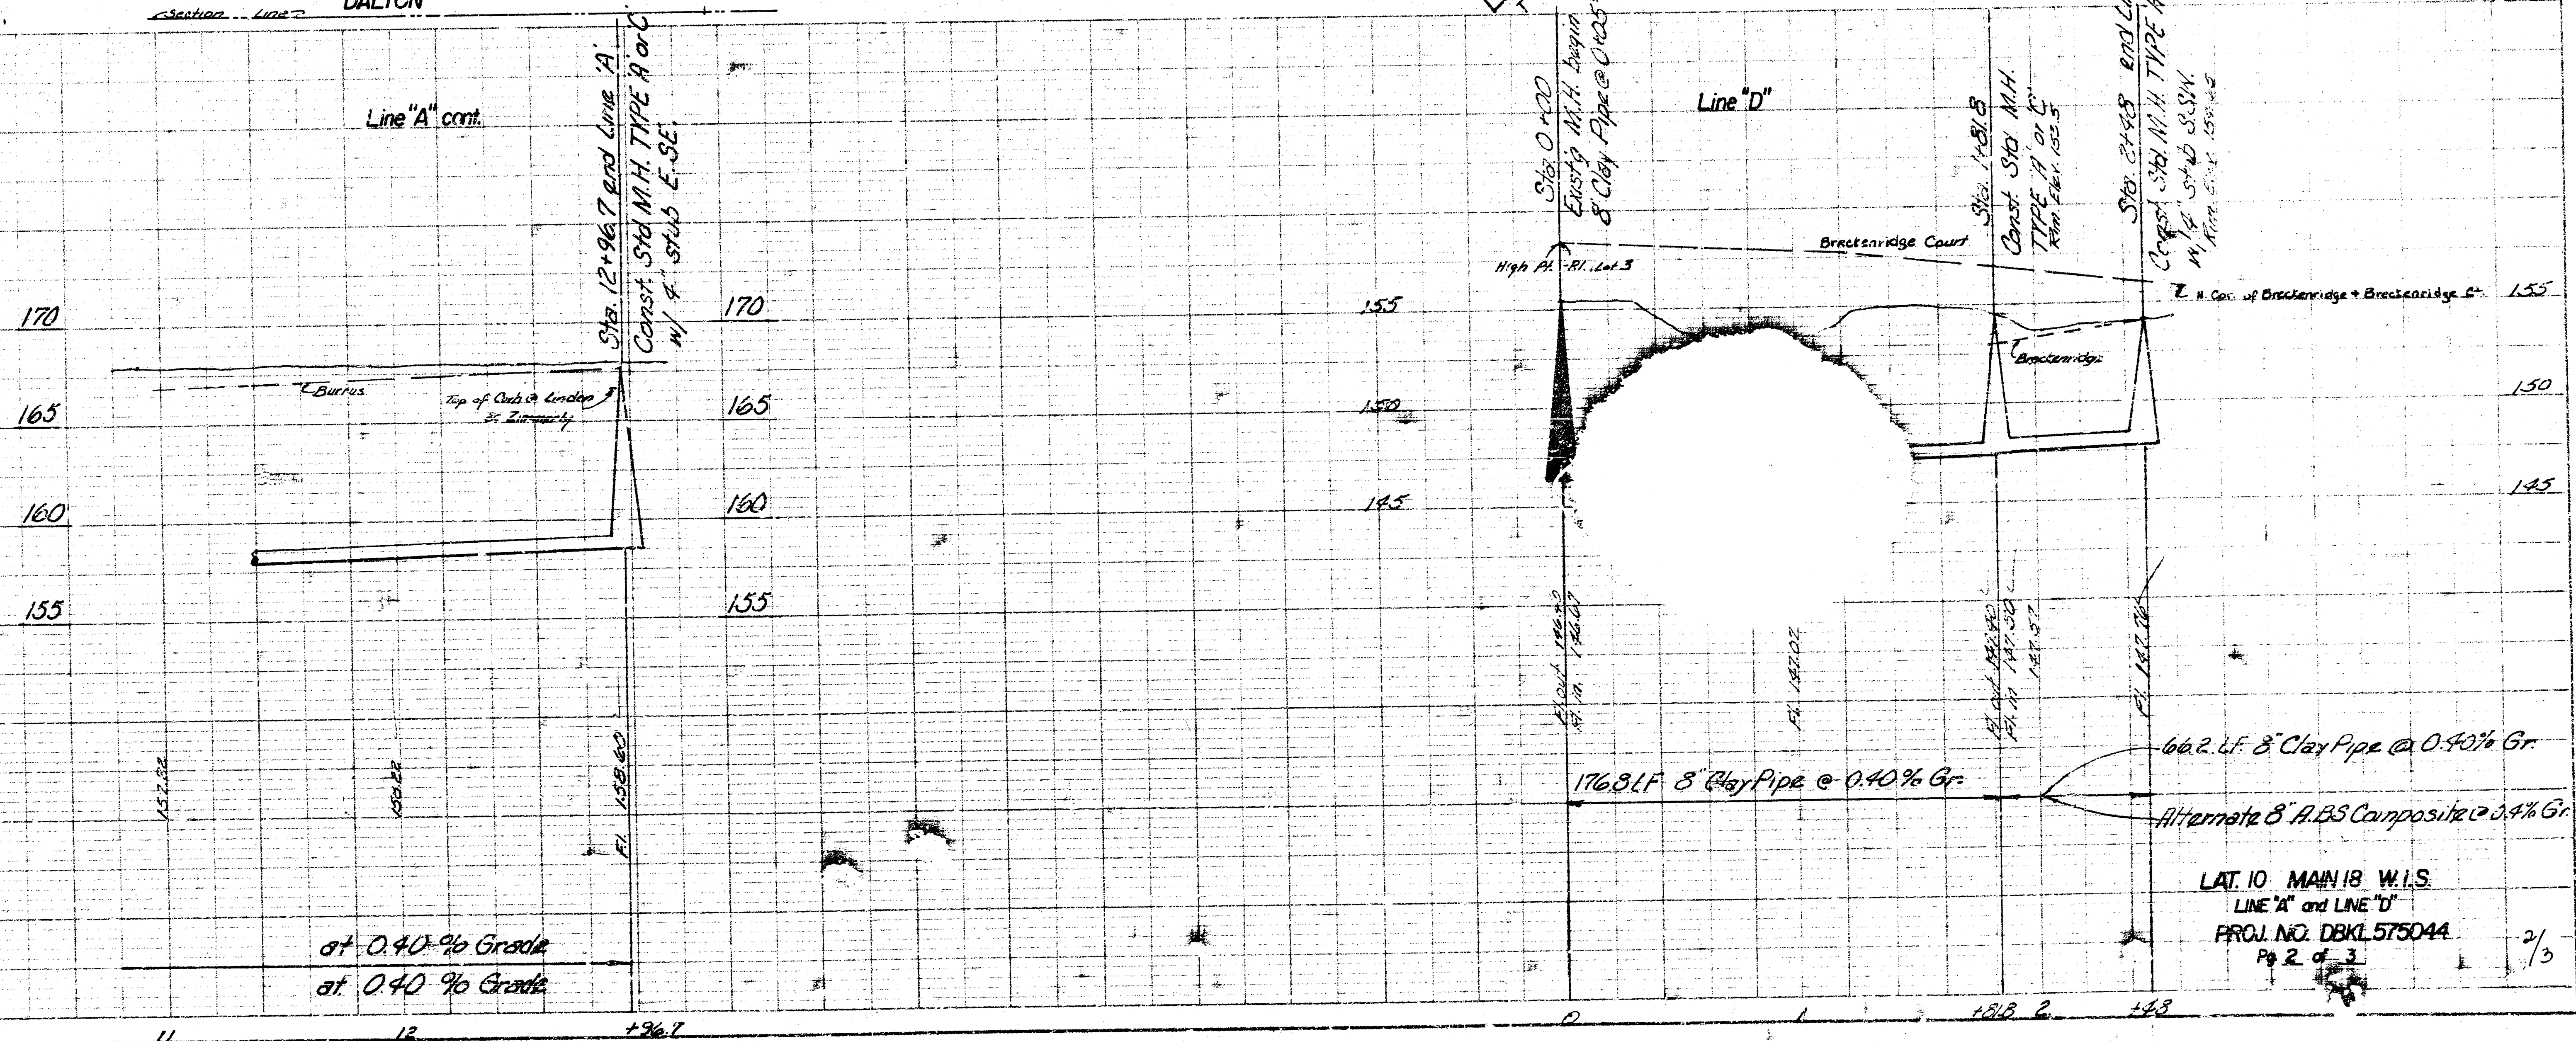


PLATE 1 PLAN-PROFILE B P R STANDARD

B.M. 161.75 R.R. Spike East Face of Street Light Pole, S.W. Corner of Lincoln and Dalton

FOURTH
BLOCK NO. 2

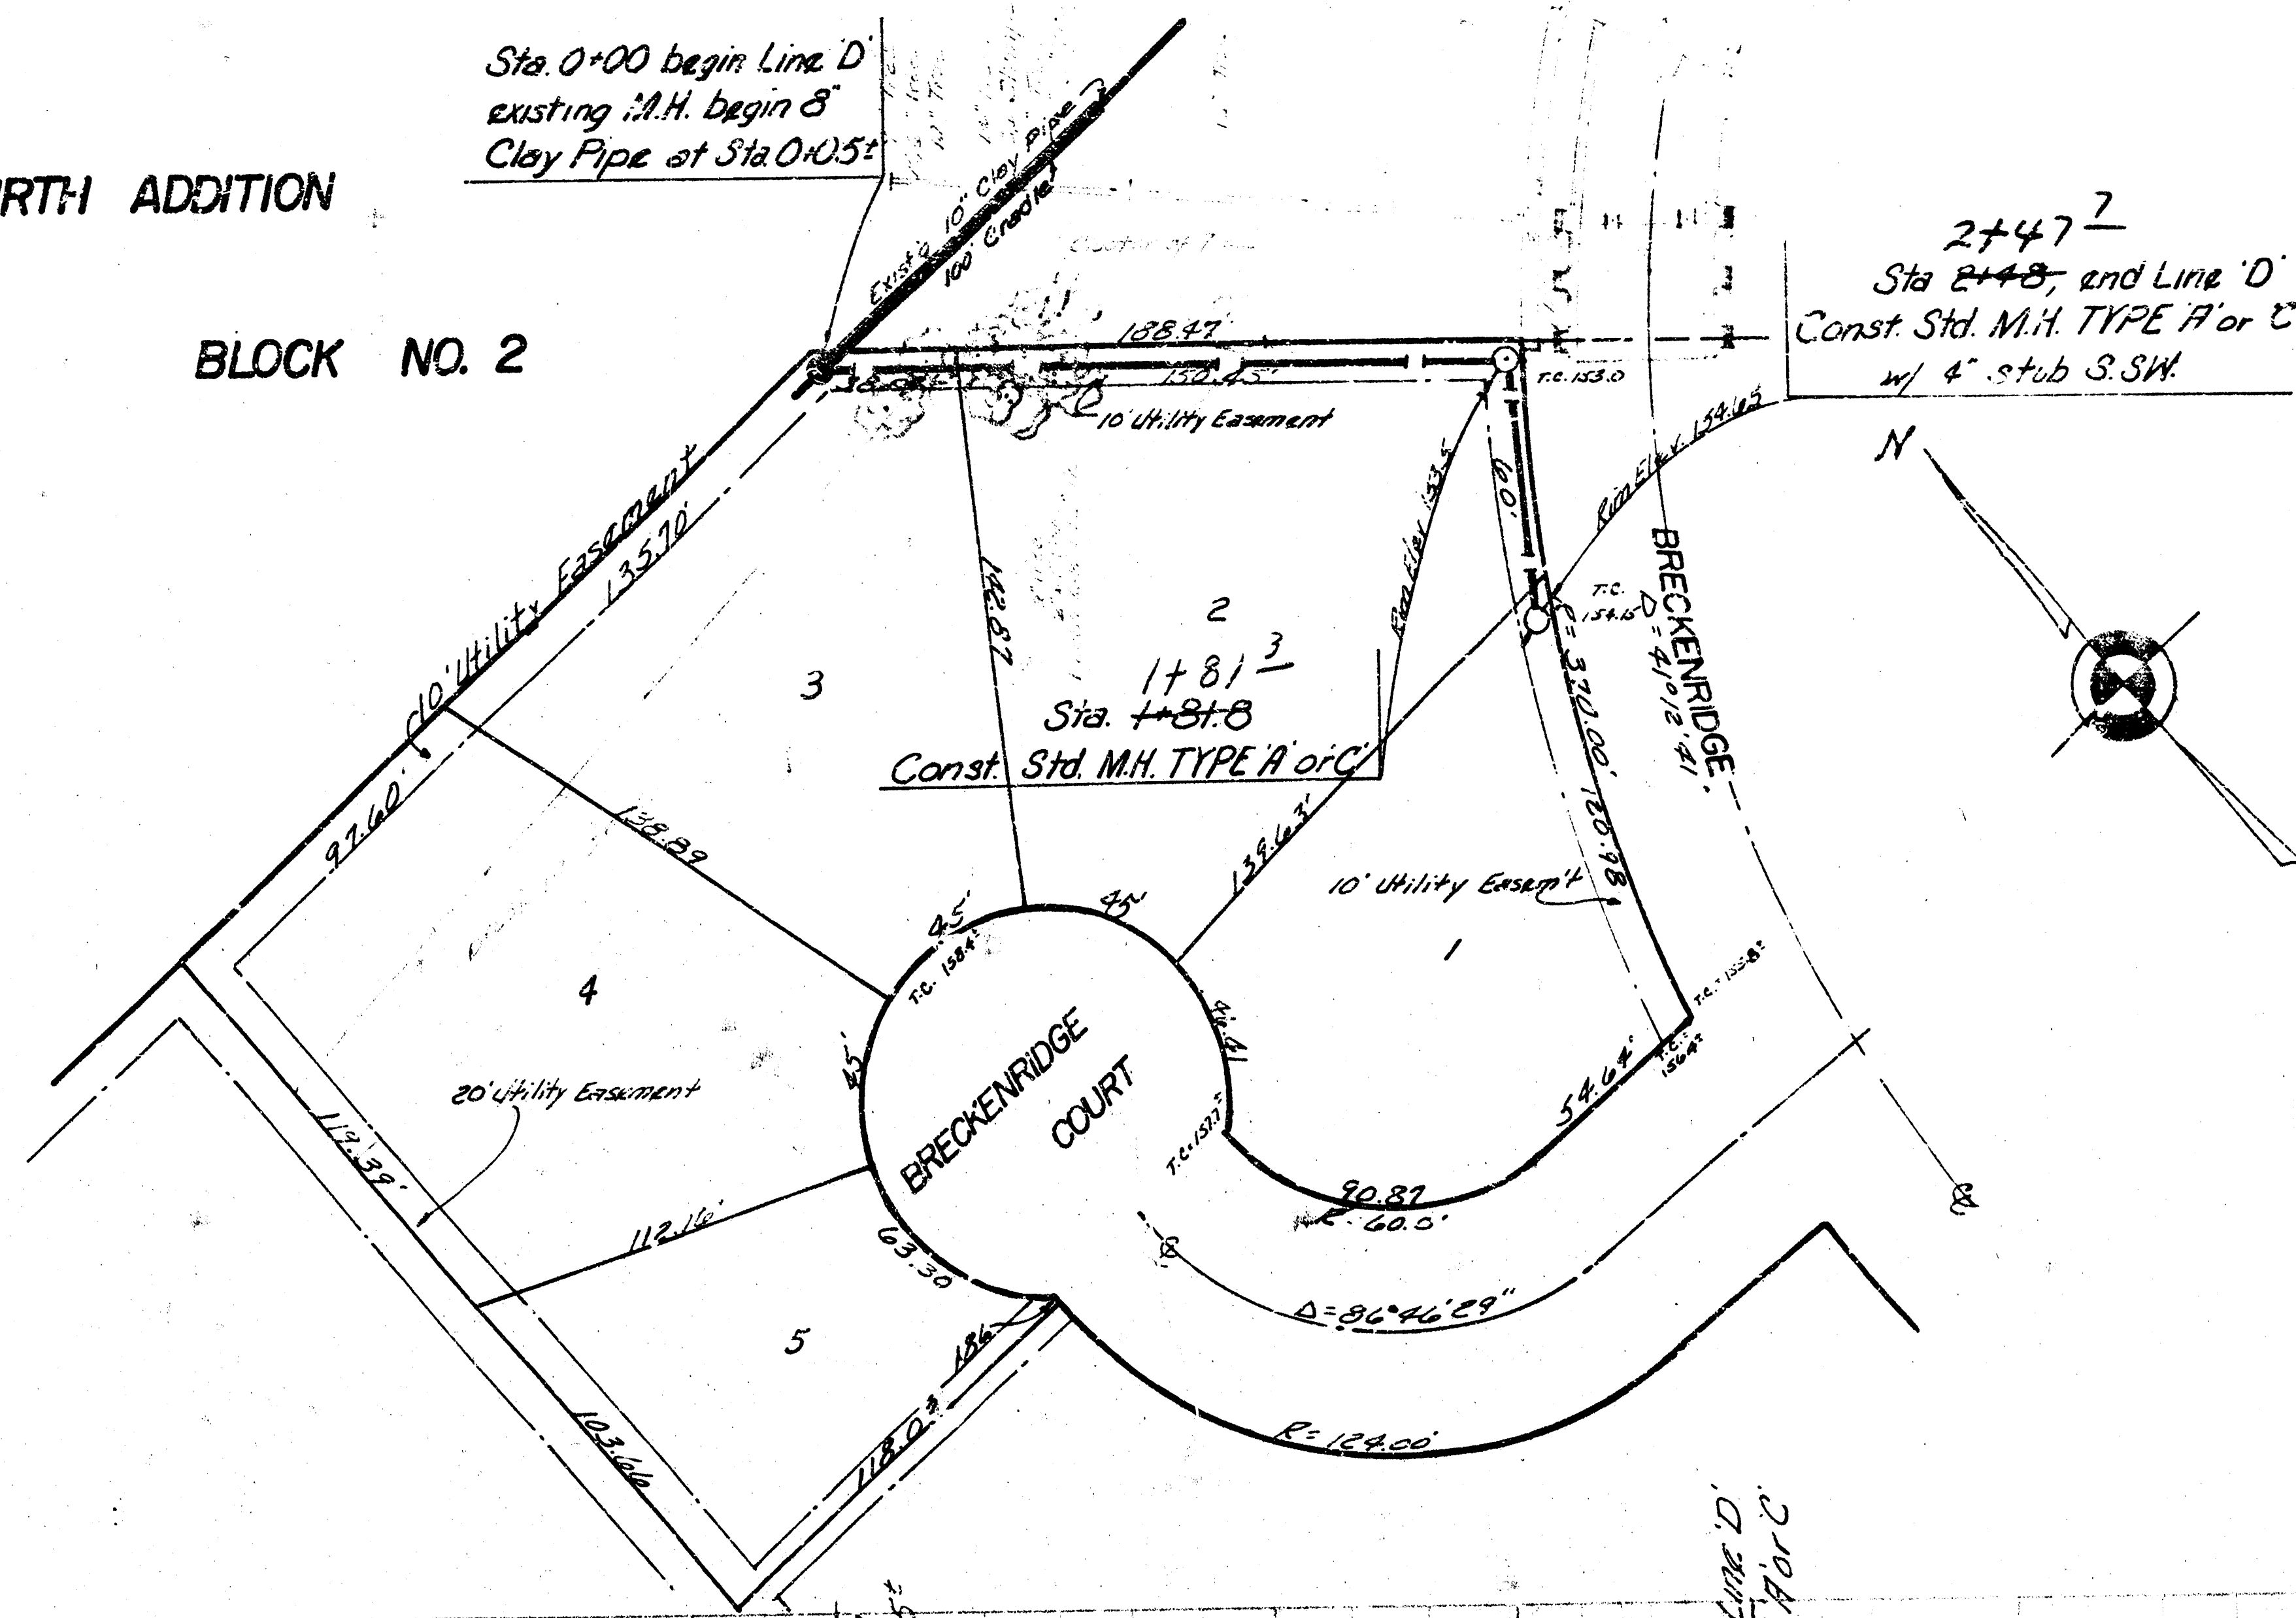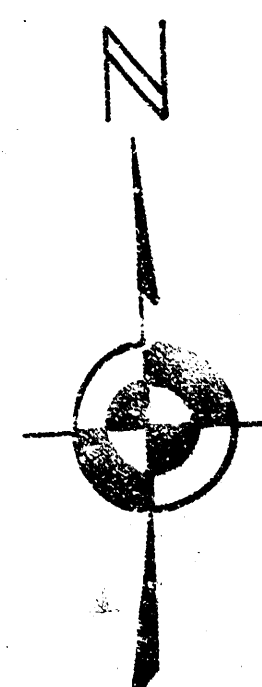

SCALE
PLAN 1"=40'
PROFILE Vert. 1"=5'
HORZ. 1"=40'



Sta 0+00 Line B = Sta 4+88.1
Line A, begin 8" ABS Composite Pipe, East, see sheet 1

LINE "A"
SHEET NO. 1

LINE "A"
Sta 0+00 Line C = Sta 7+83.2
Line A, begin 8" S.S. East
see sheet No. 1

2+14.2
Sta. 2+13.4 and Line B
Const. Std. M.H. TYPE "A" or "C"
w/ 4" stub S.E.

2+13.2
Sta. 2+13.4 and Line C
Const. Std. M.H. TYPE "A" or "C"
w/ 4" stub N.E.

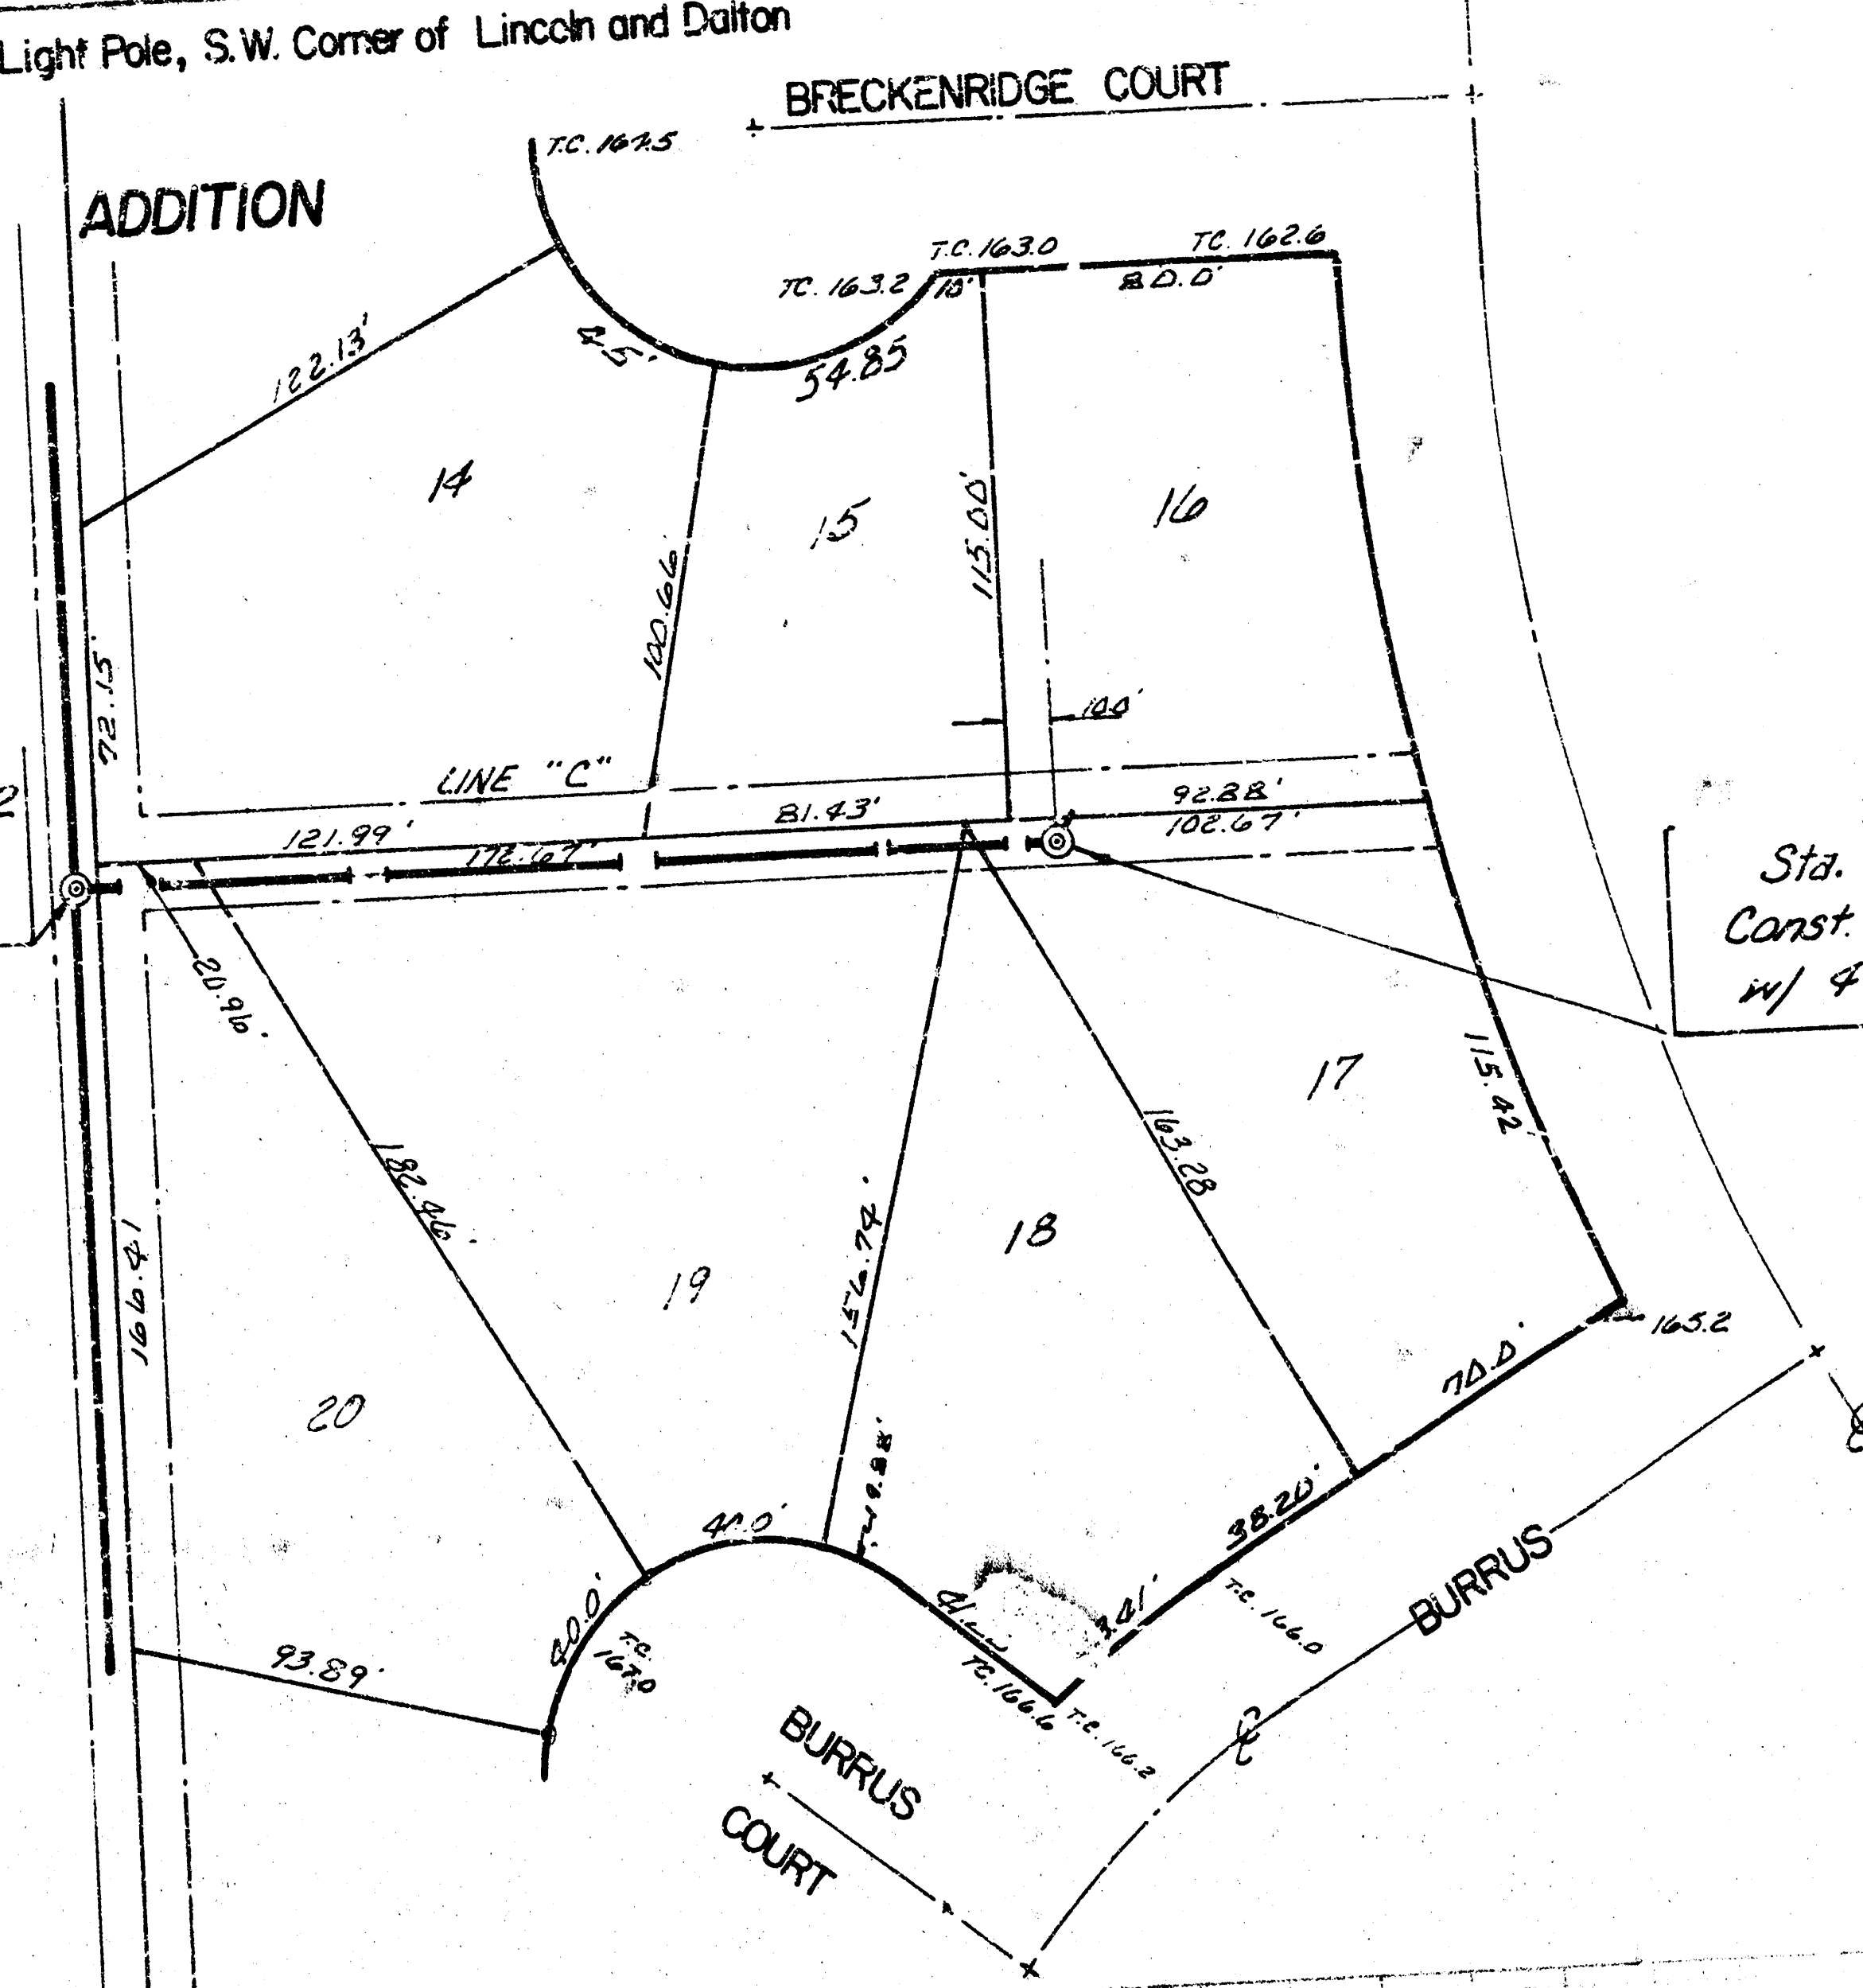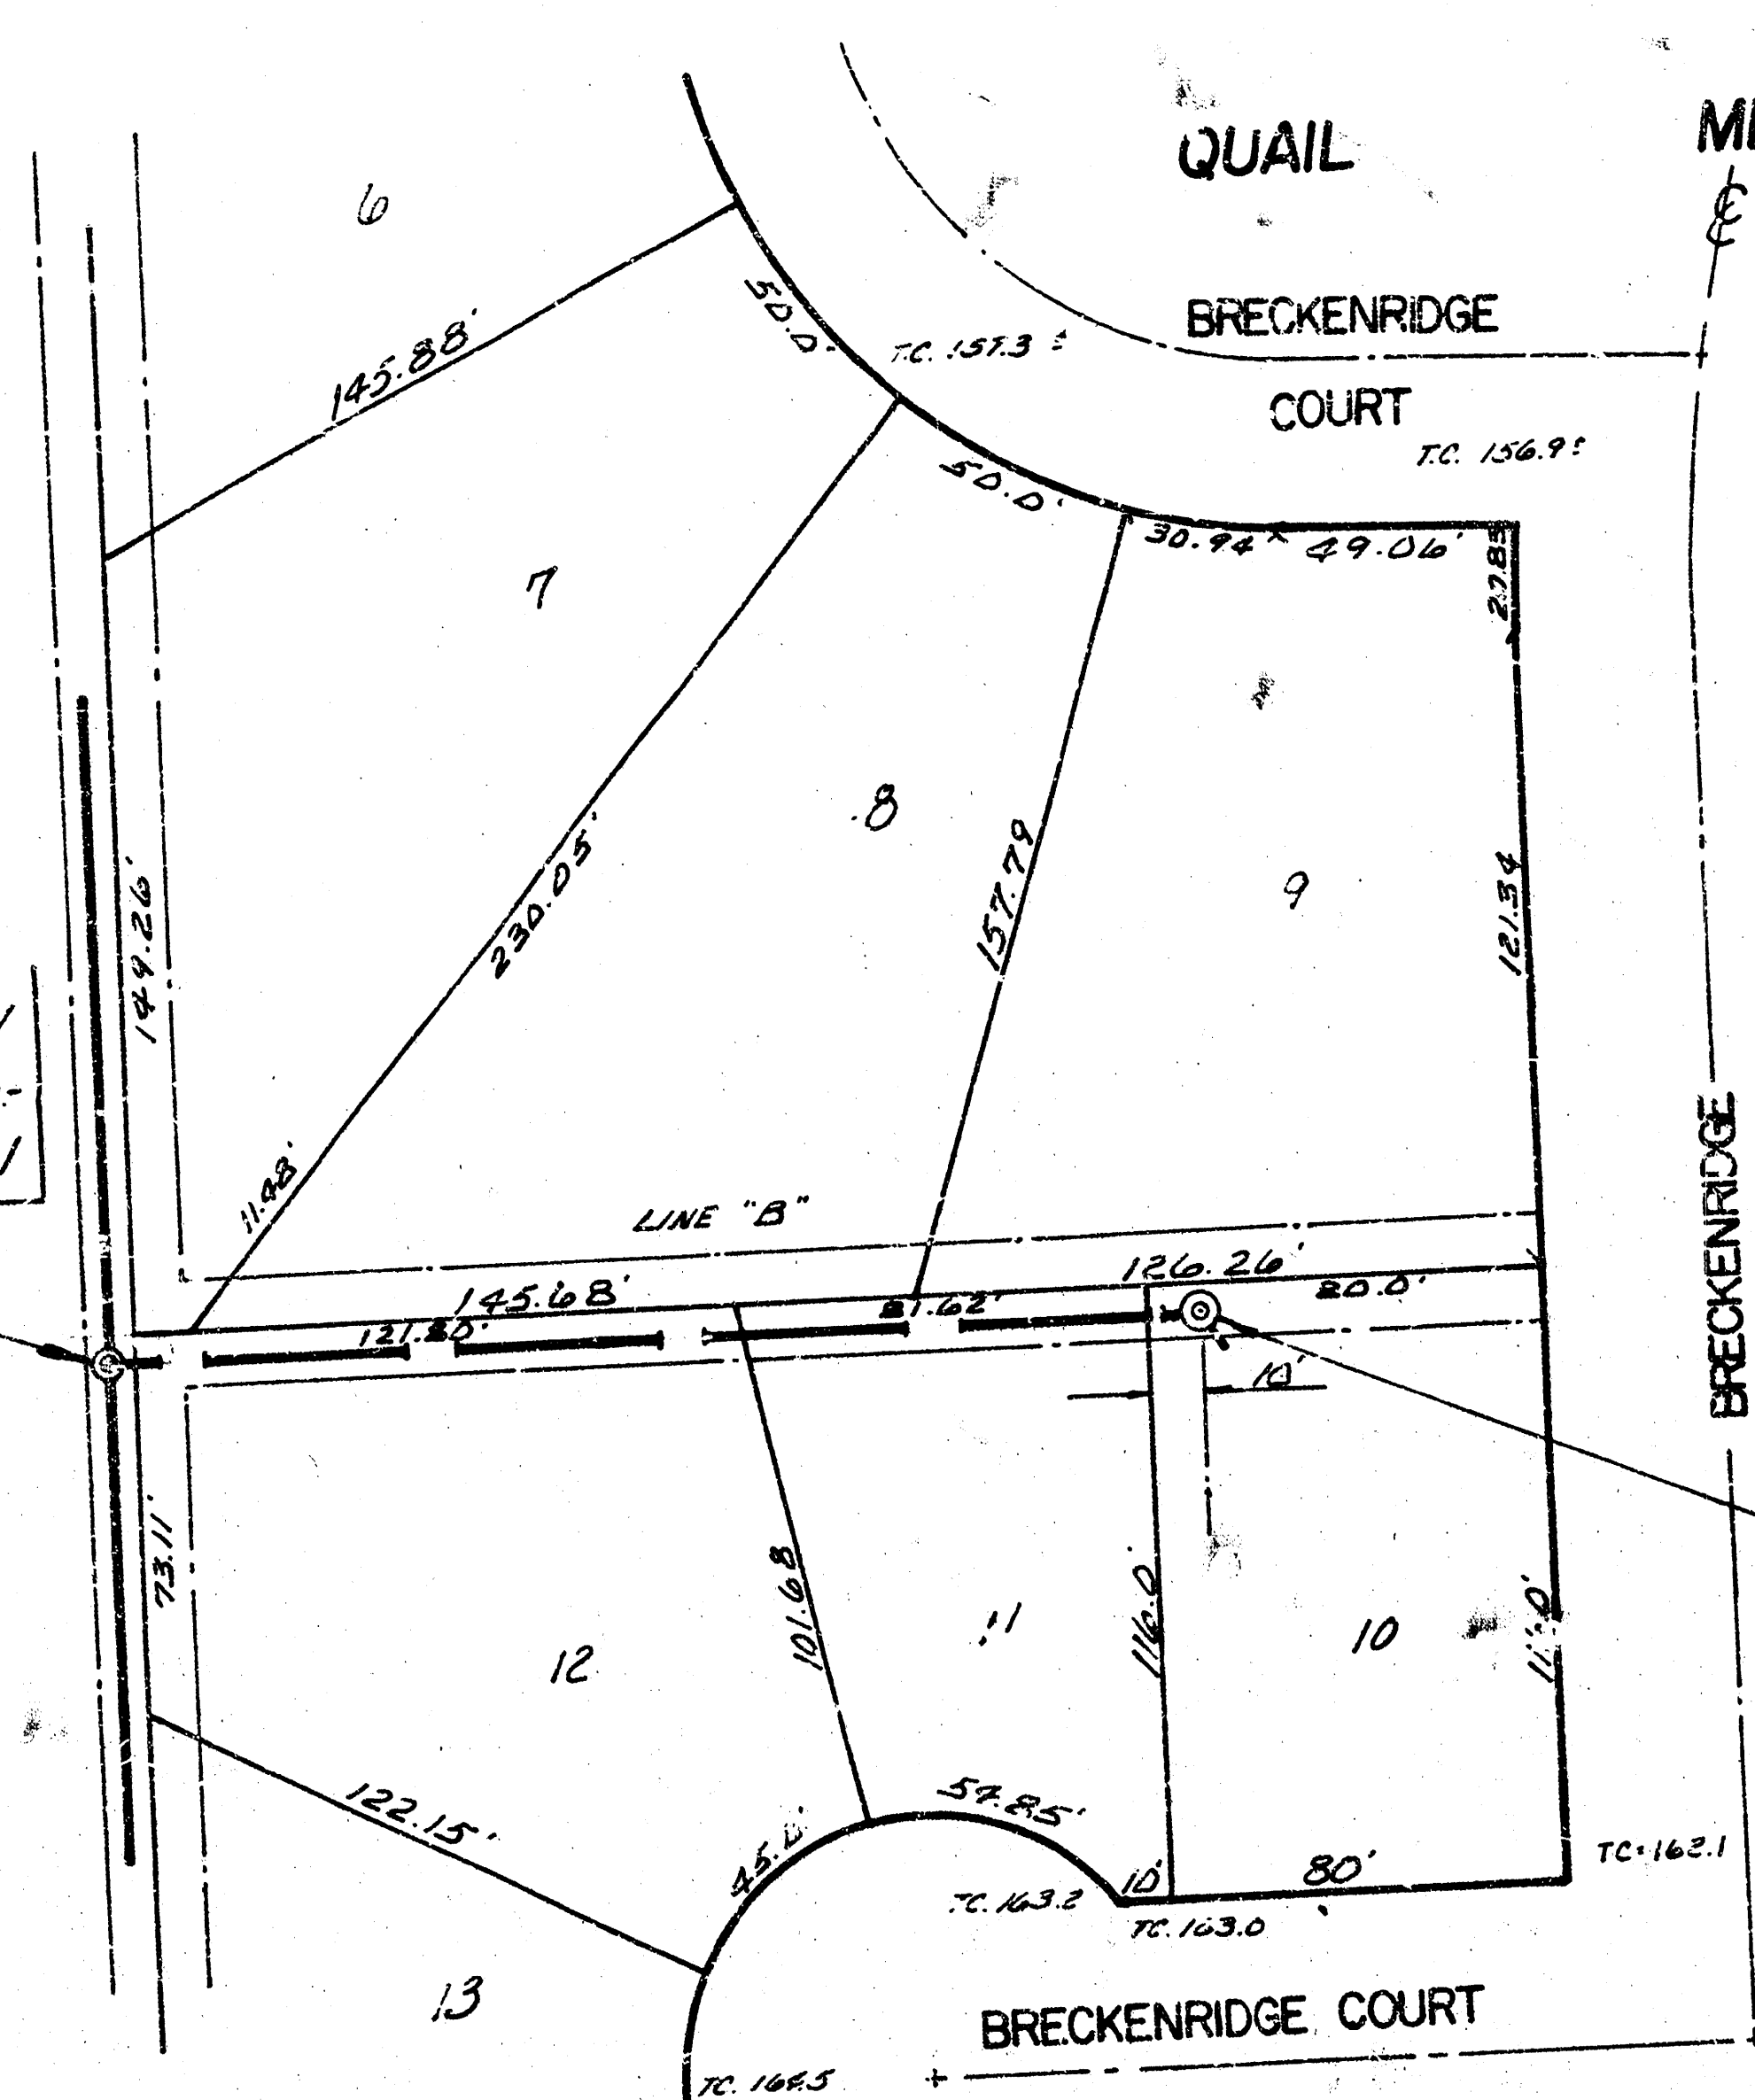

LAT. 10 MAIN 18 W.L.S.
LINE "B" and "C"
PROJ. NO. DBKL575044
Pg. 3 of 3