

B. Bibler 2/60
R. Coons 3/60

O.K. JB

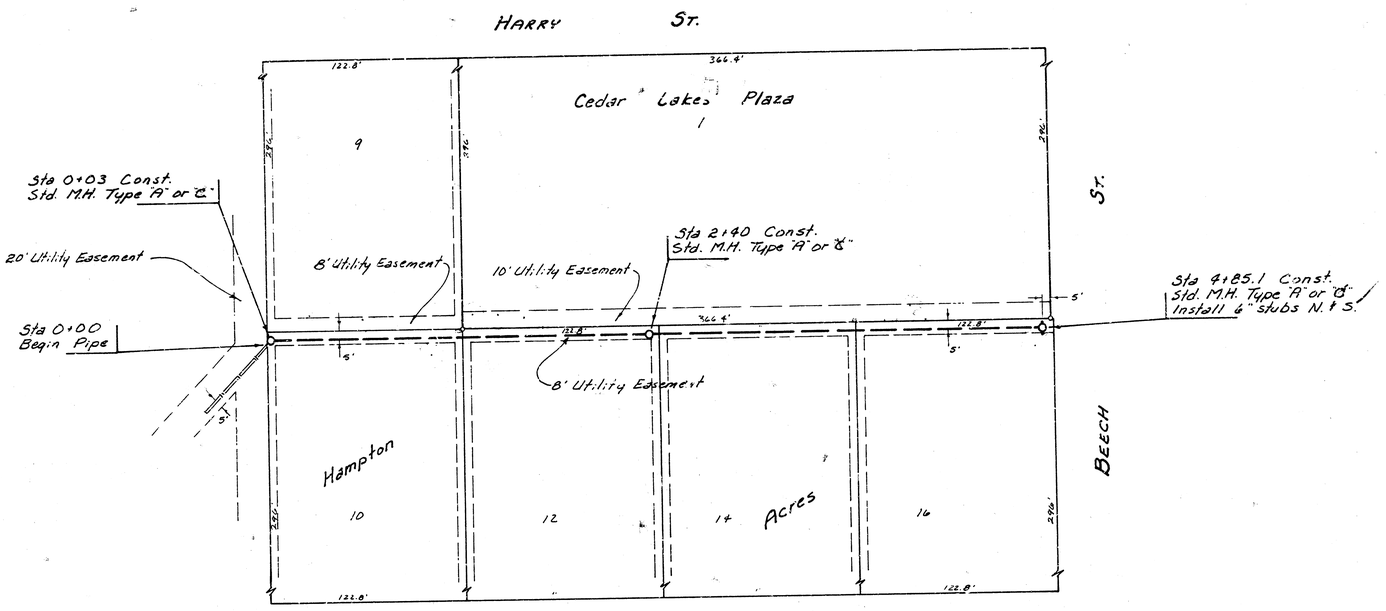

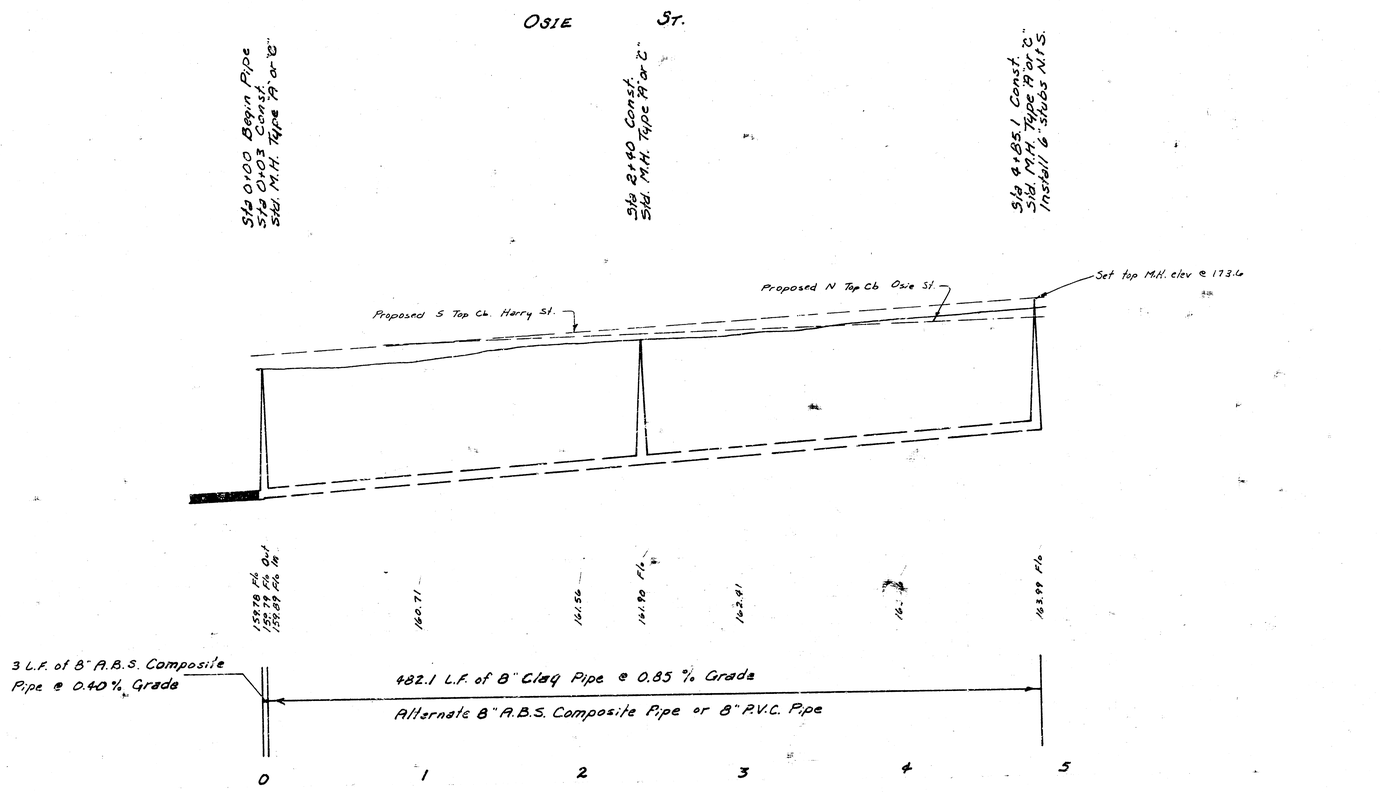

Scale Plan 1" : 40'
Profile 1" : 40' Horz.
1" : 5' Vert.

B.M. 172.03 City Std. 48' S. & 46' W of ℄'s Webb Rd. & Harry.

B.M. 173.05 Bridge Spike, S Face of P.P. ≅ 295' S of SL Harry St. & ≅ 7' E. of WL. of Beech.

As Built
9-30-59
E231

LAT 10, MAIN 19, WAR INDUSTRIES SEWER
CITY OF WICHITA, KANSAS
DEAN SELLERS — CITY ENGINEER
PROJ. NO. 468-76-245-80900-000-000-001 1/1