

LATERAL 12, MAIN 20, W.I.S.



PROJECT NO.

463-76-245-8055-000-000-001

CITY OF WICHITA, KANSAS

R.W. LINN CITY ENGINEER

JULY, 1978

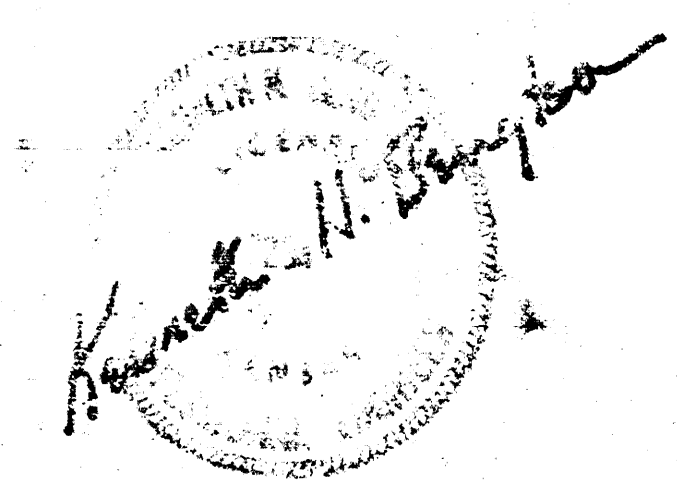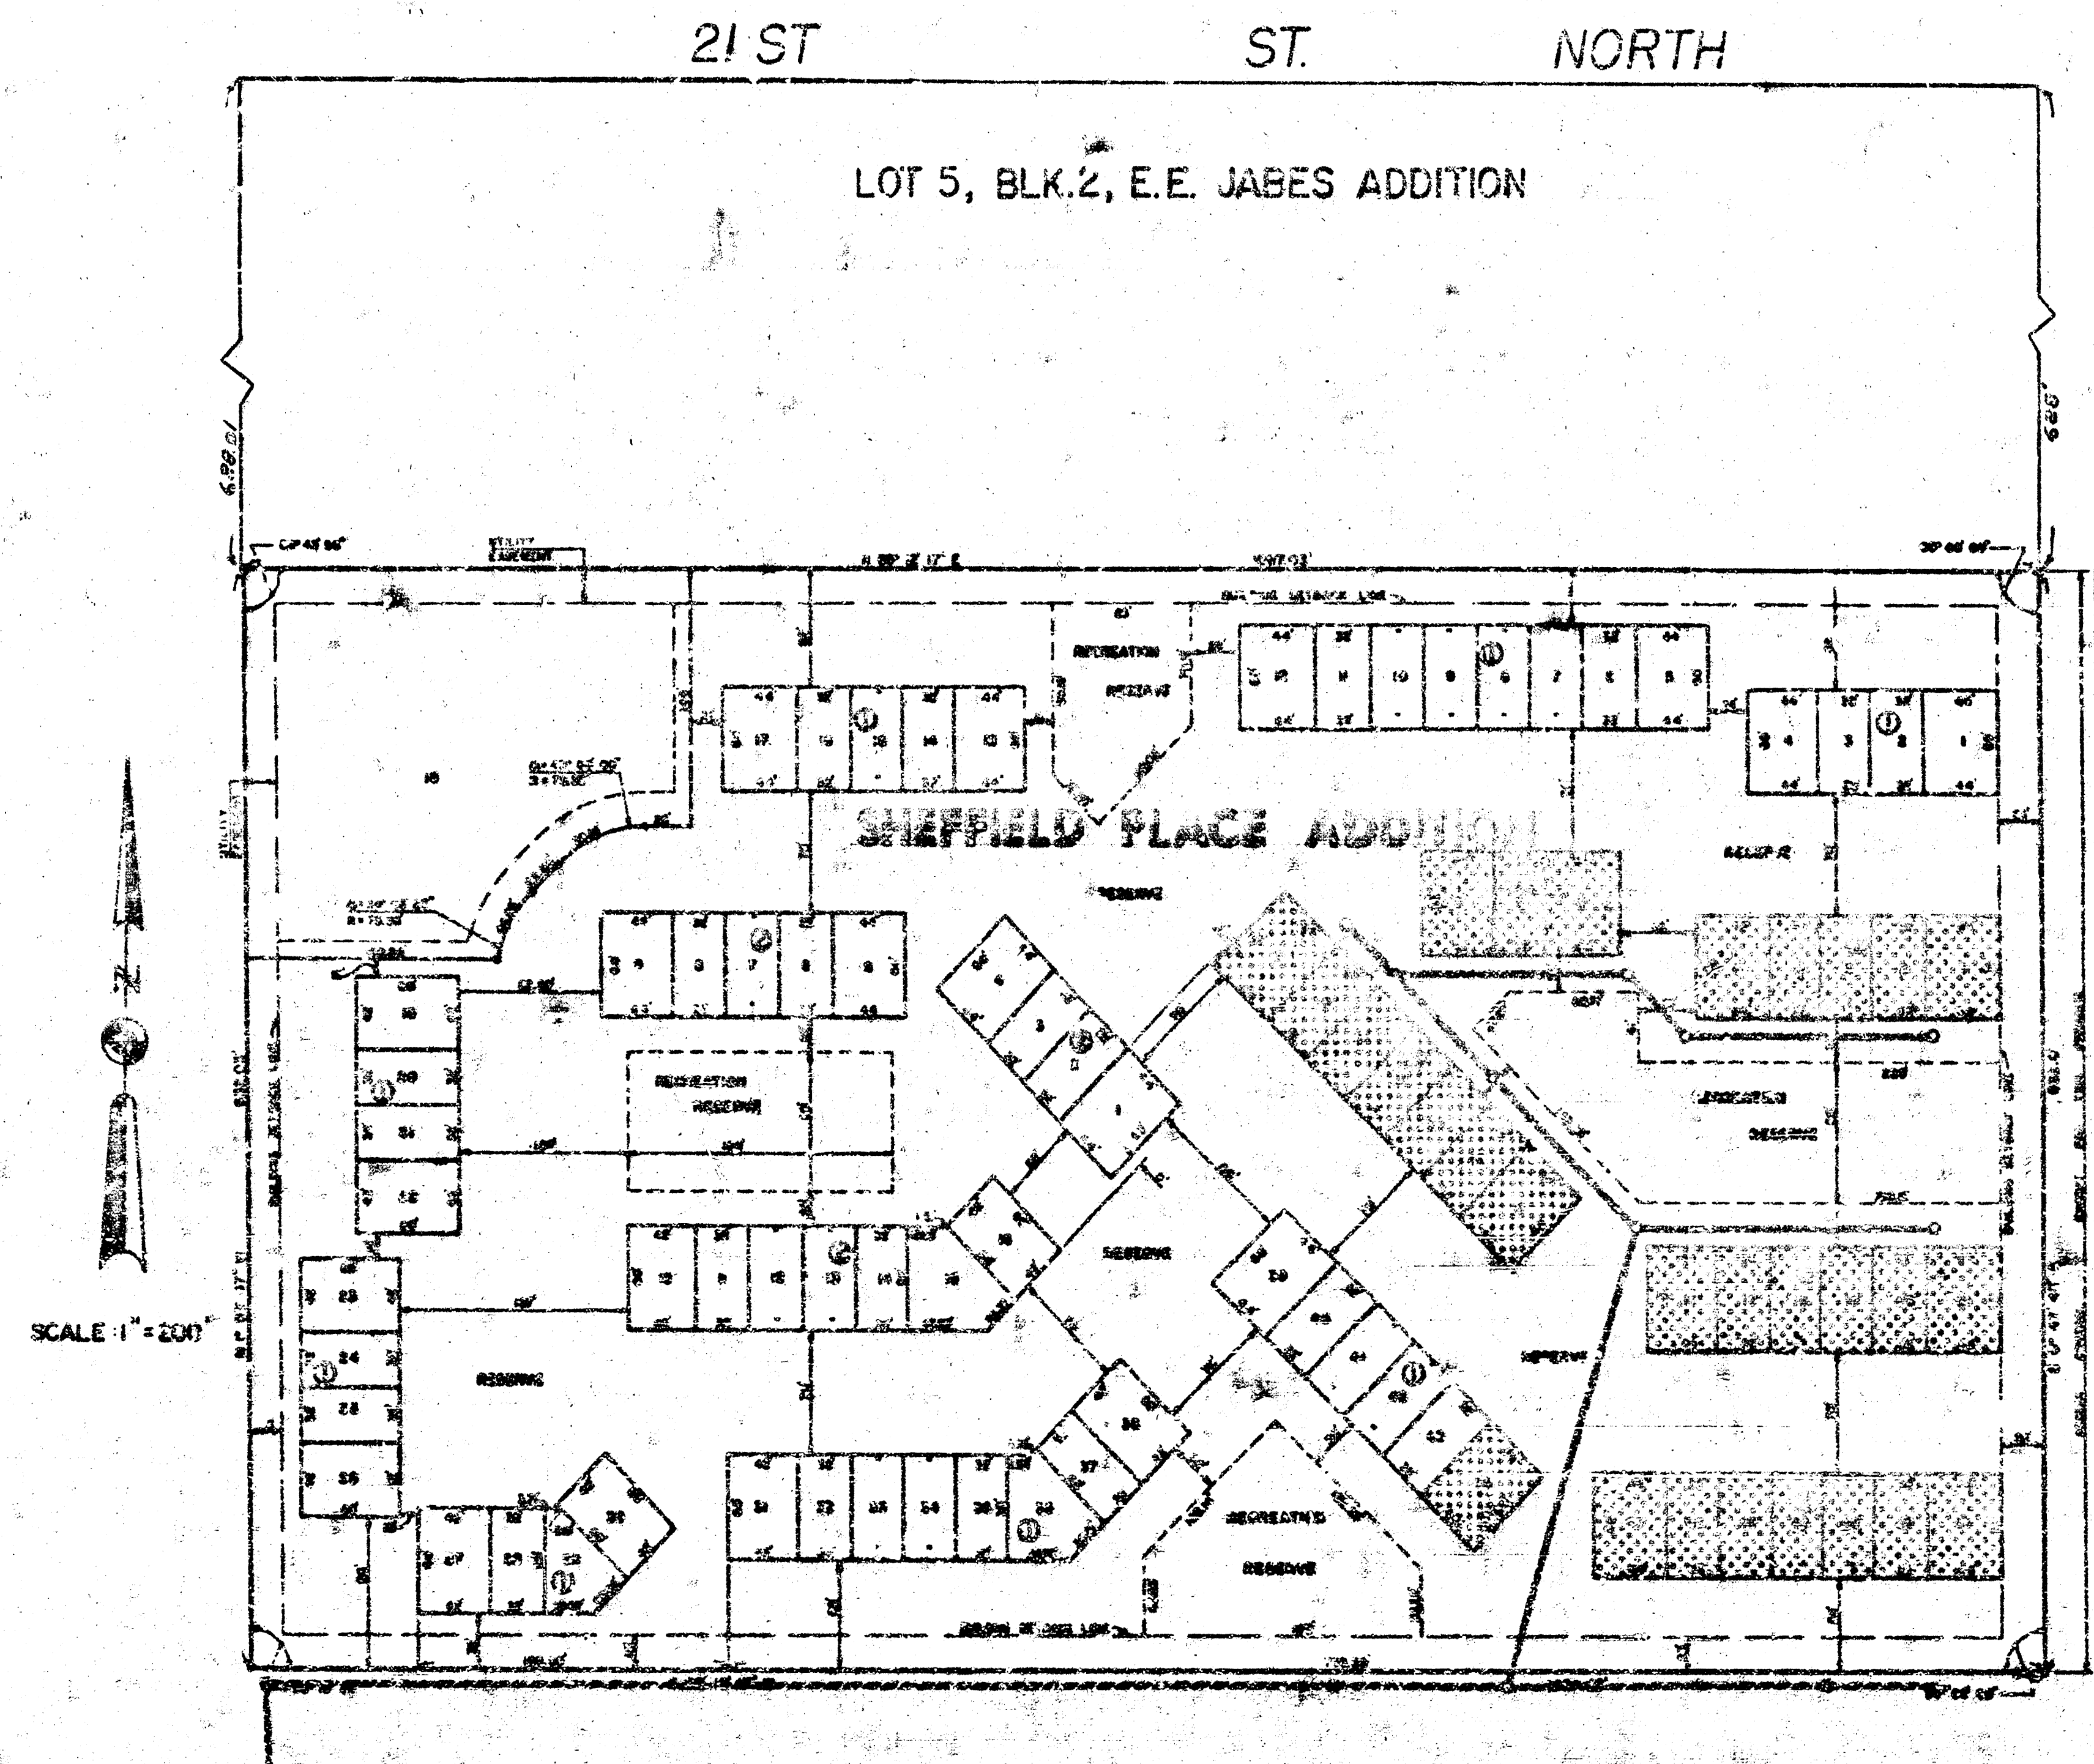


As Bldg
/s/ 3/6/79
B-1-94
D-41

BENEFIT DISTRICT DESCRIPTION - LOTS 44 THROUGH 51, BLOCK 1, AND ALL LOTS IN BLOCK 2, SHEFFIELD PLACE ADDITION

B.M. 217.23 - RR Spike S.S. TP No. Side 21st St No. and P. 1
E.L. Broadmoor

SCALE: 1" = 50' Horiz.
1" = 5' Vert.

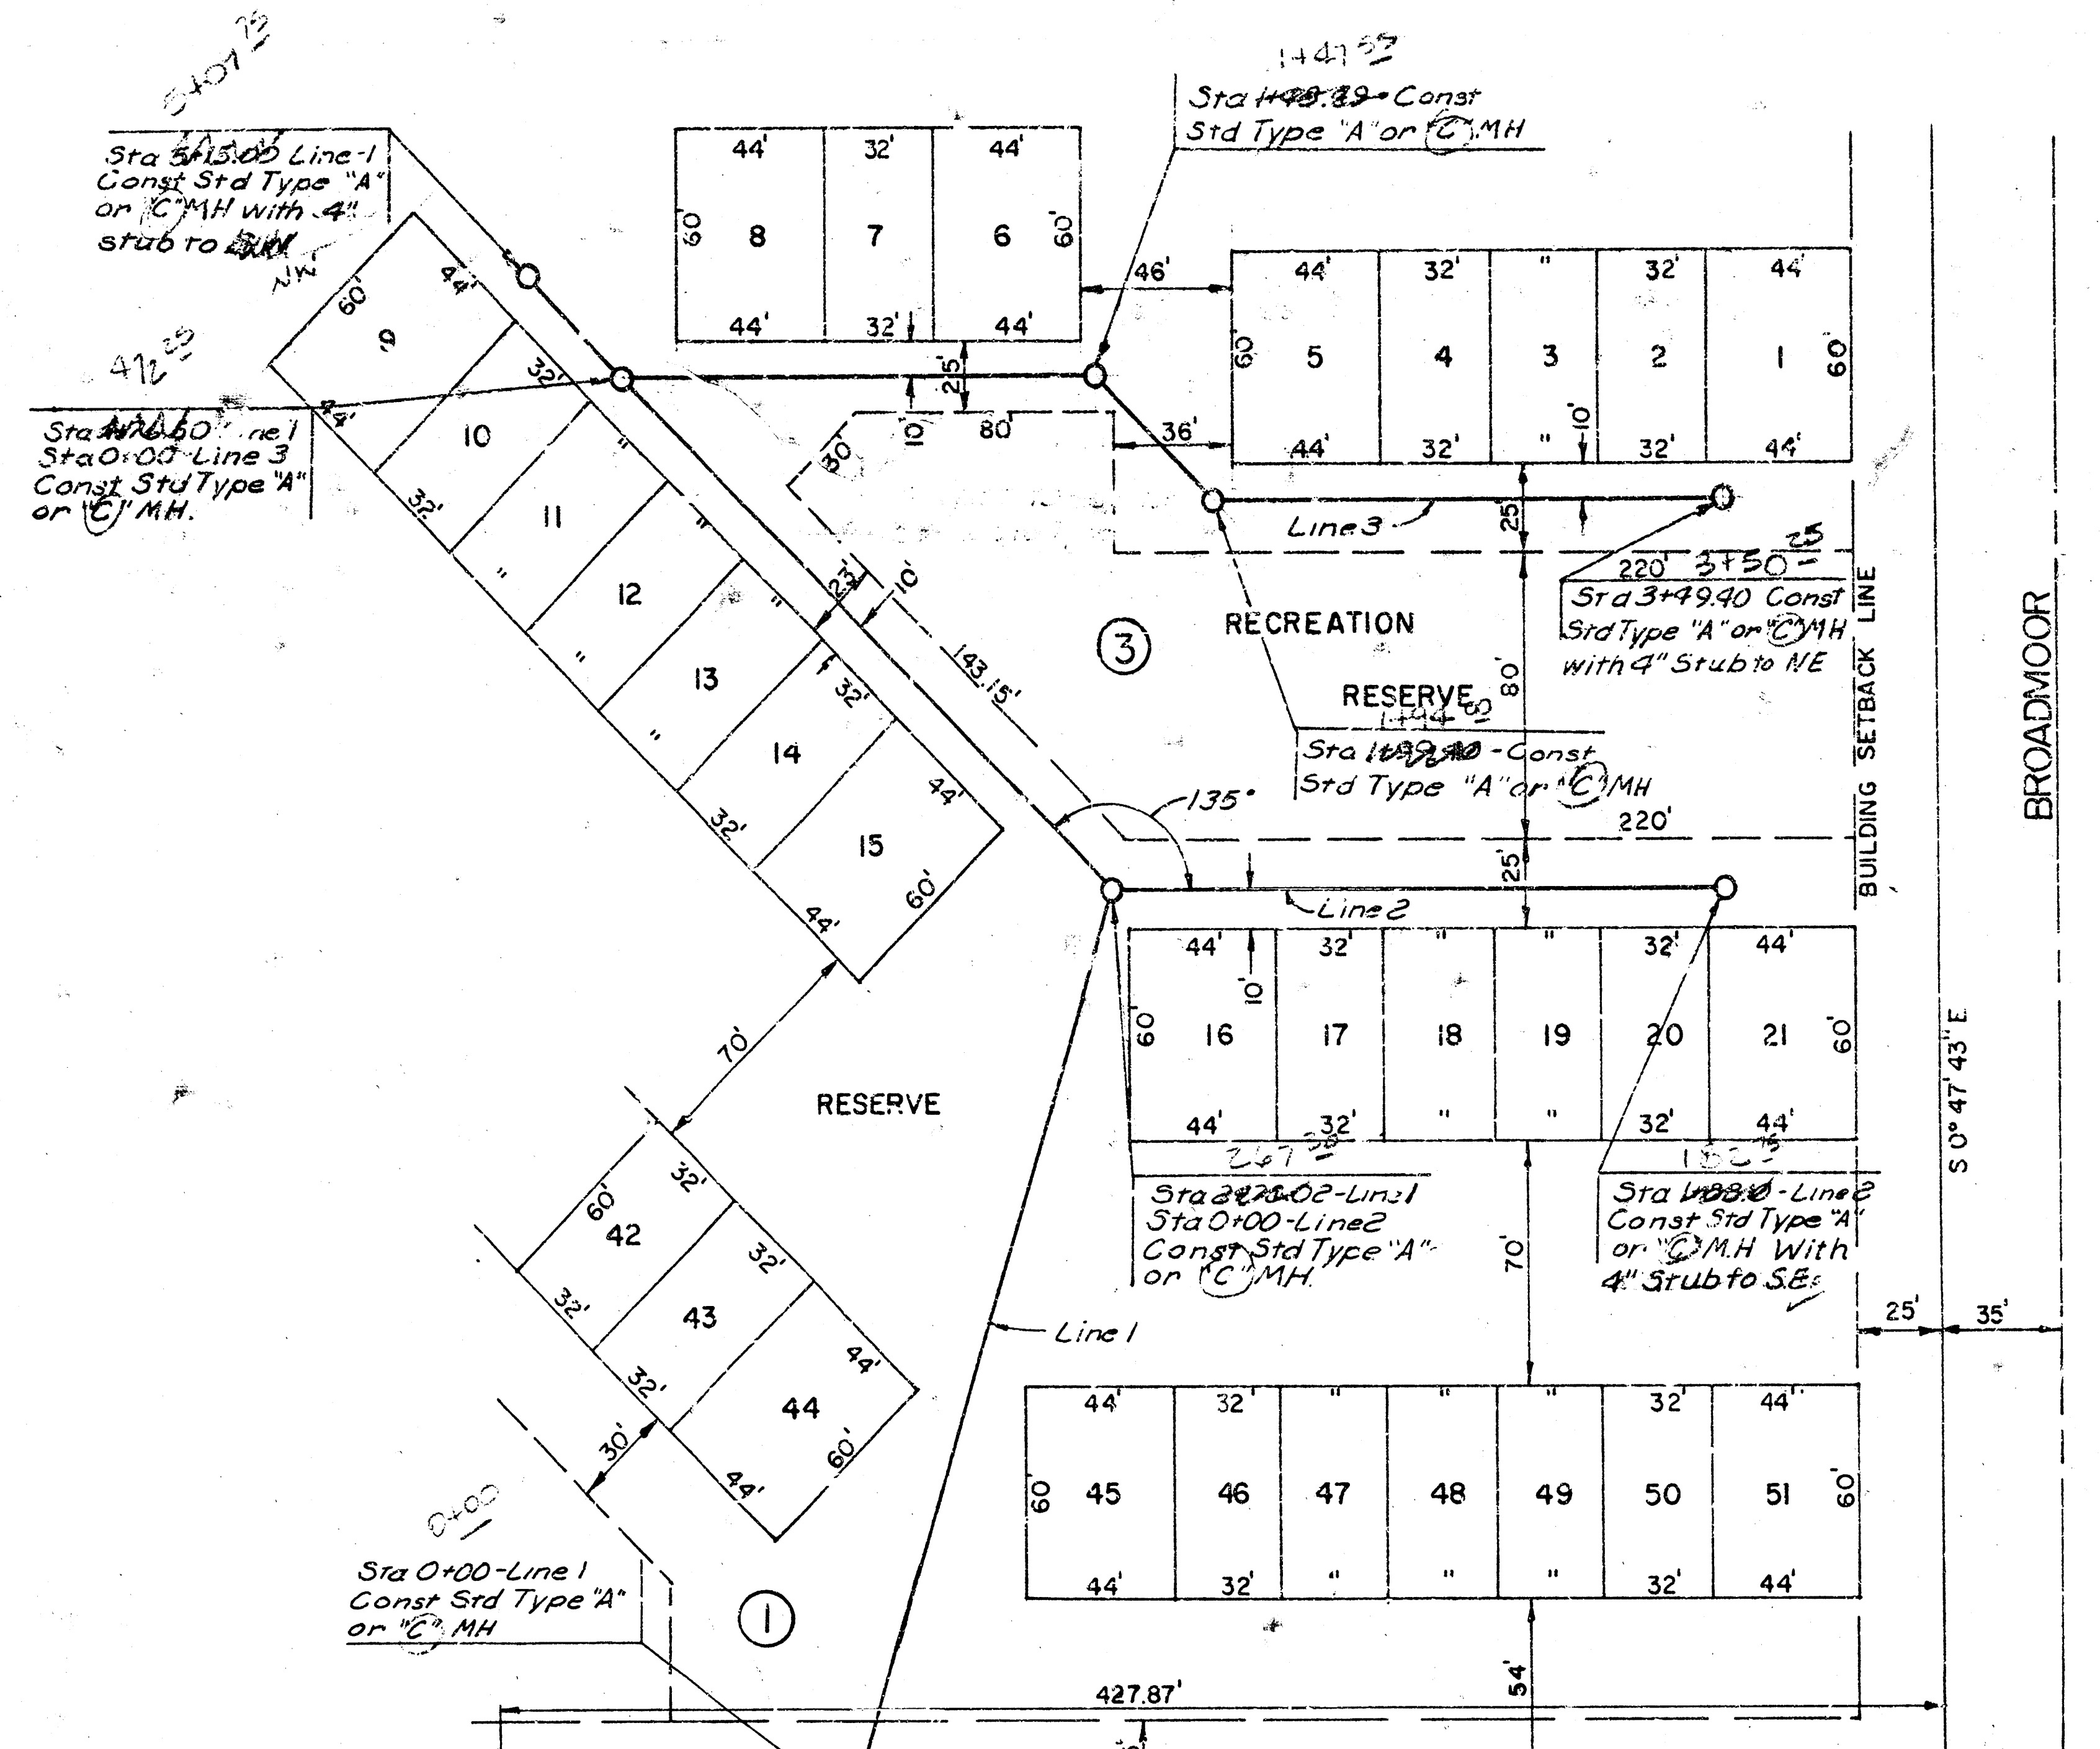

Sta 0+00 - Line 1
Const. Std. Type "A"
or "C" M.H.











215
210
205
200

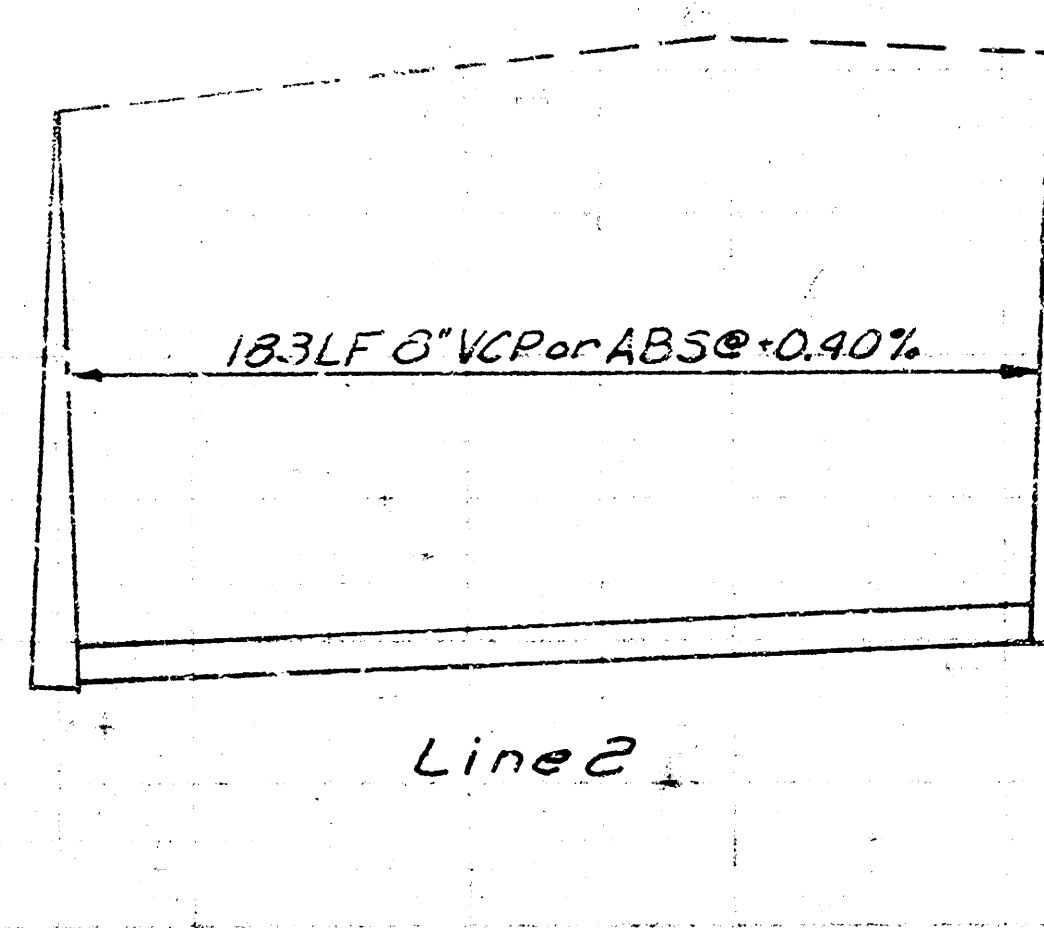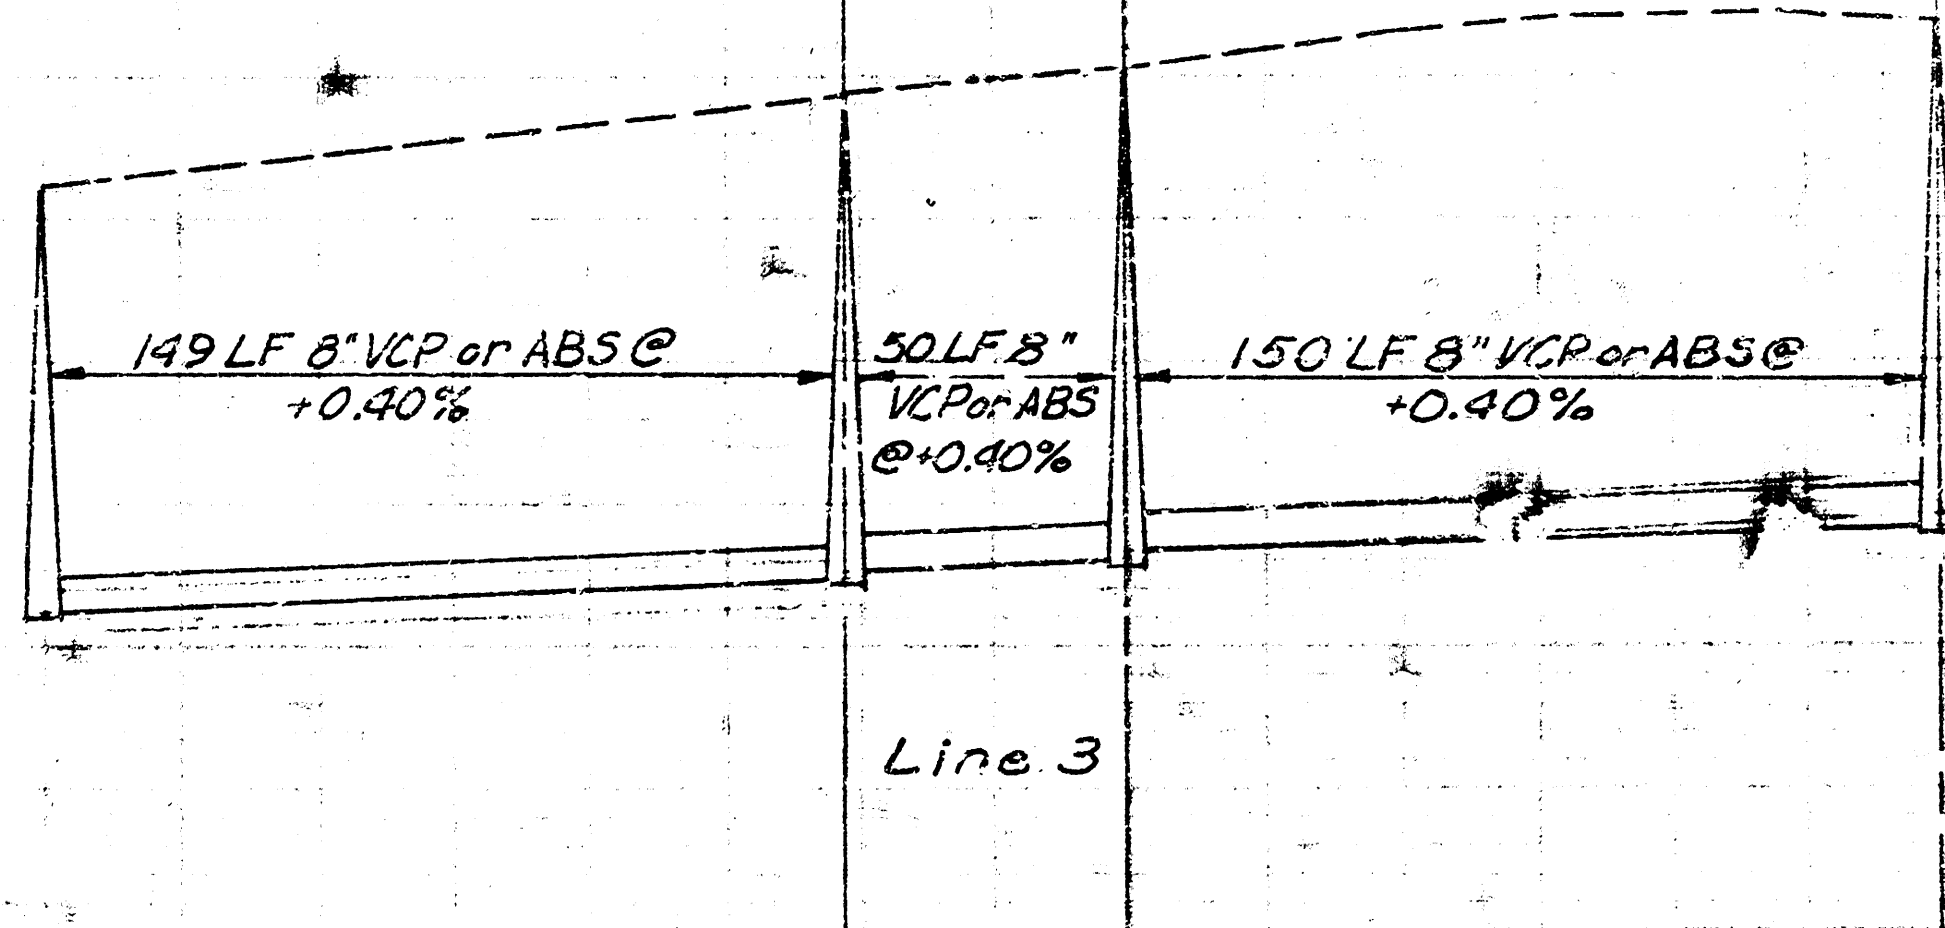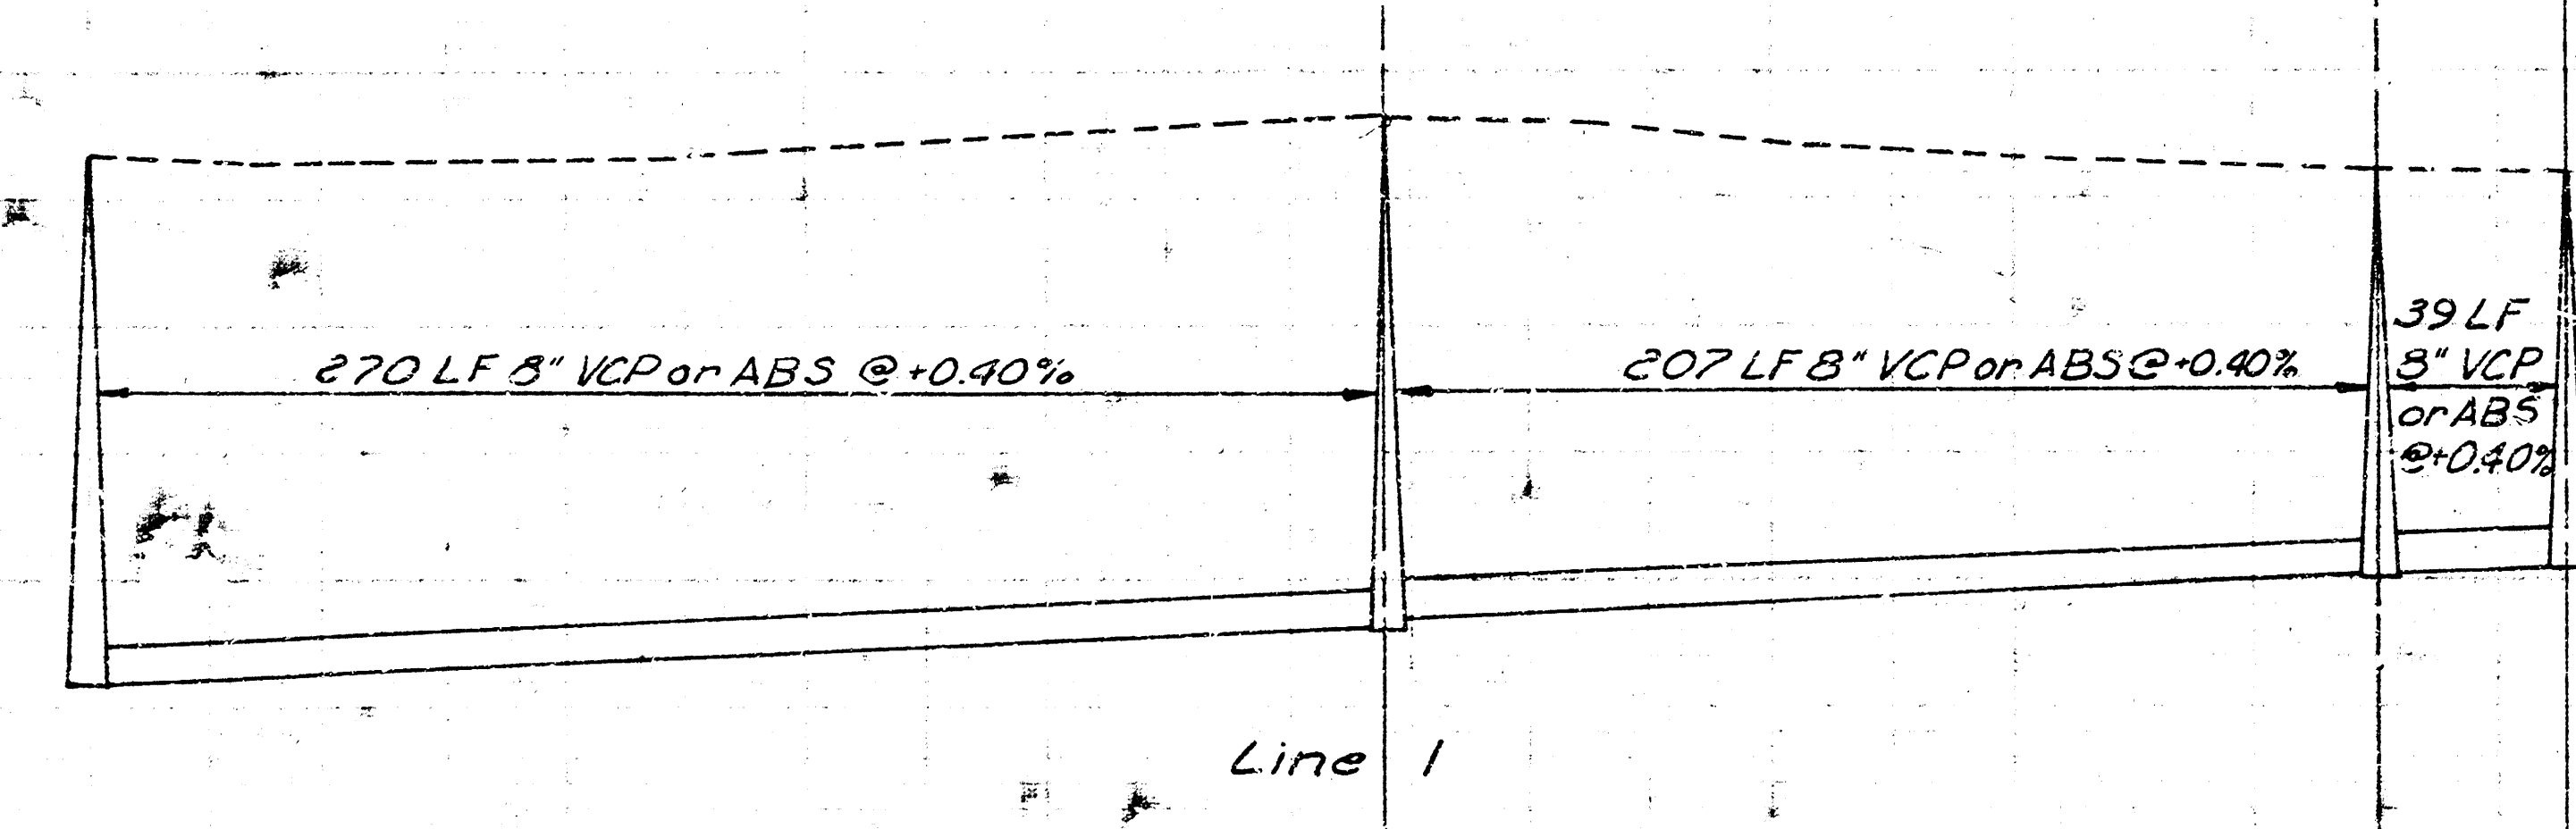
























AD RULY
H-4
D-A