


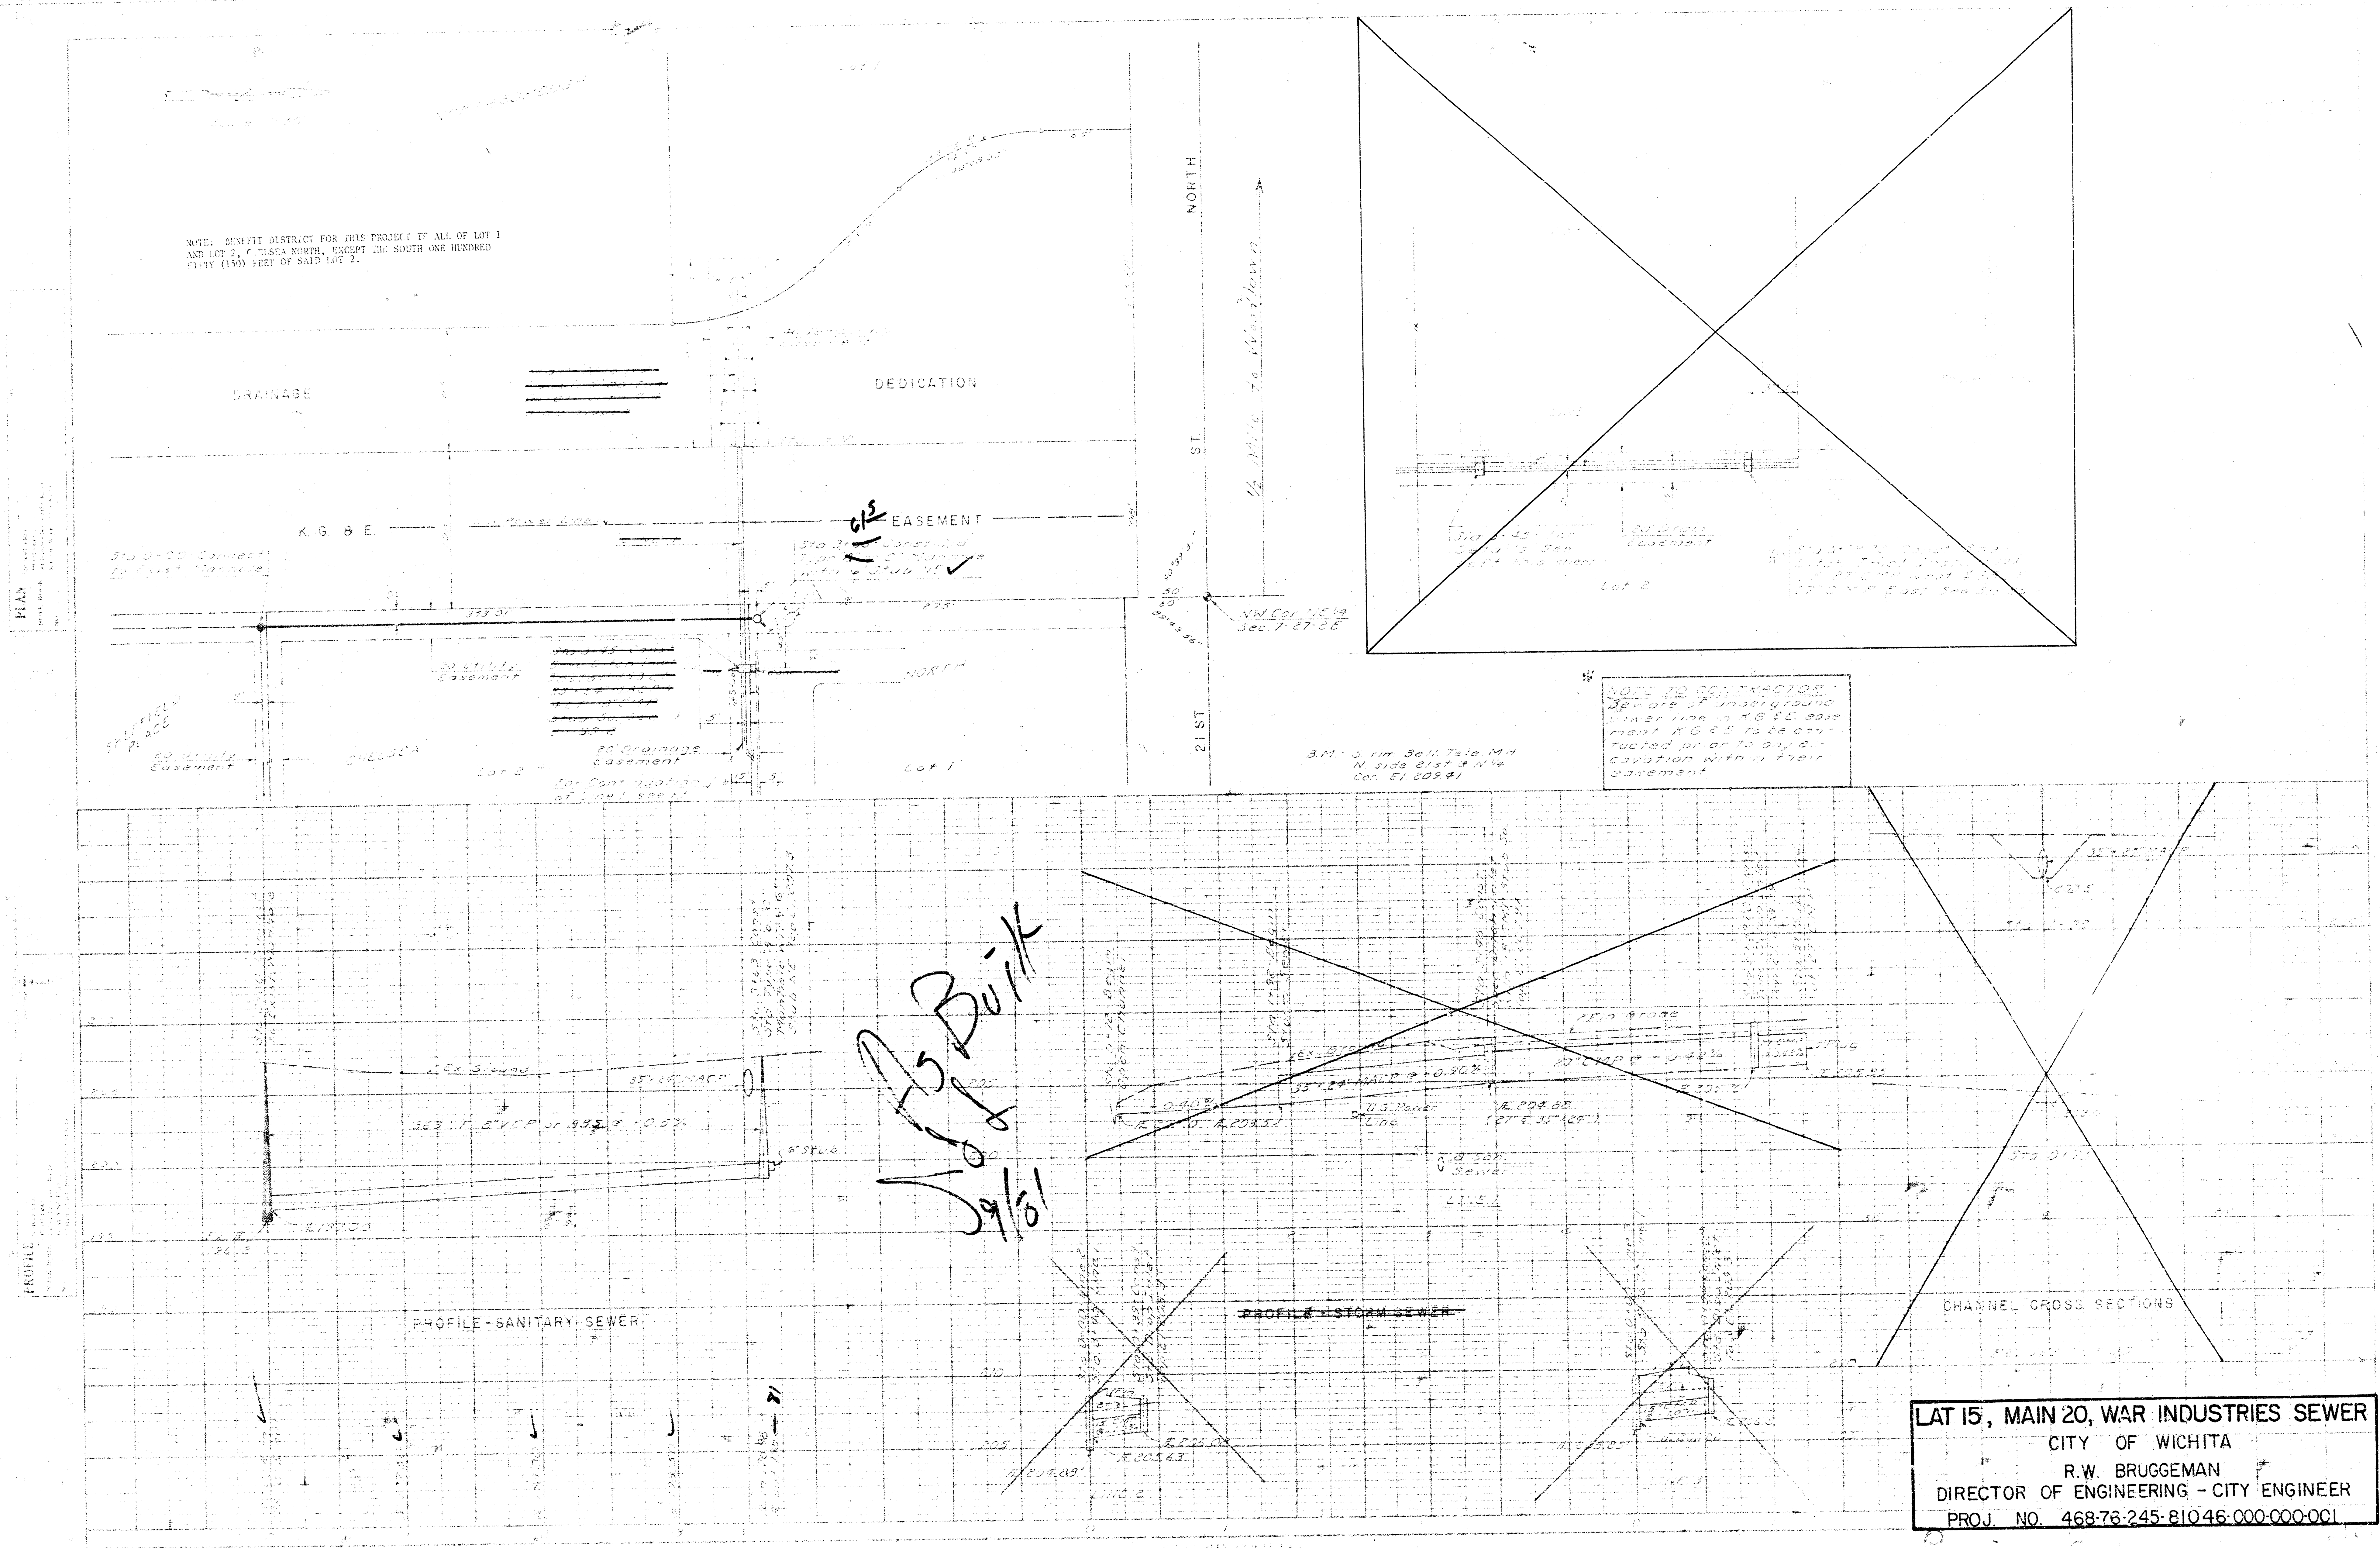

NOTE: BENEFIT DISTRICT FOR THIS PROJECT IS ALL OF LOT 1 AND LOT 2, C. CLSEA NORTH, EXCEPT THE SOUTH ONE HUNDRED FIFTY (150) FEET OF SAID LOT 2.

DRAINAGE

DEDICATION

K.G. & E

EASEMENT

NORTH

ST

21ST

A

1/2 Mile to Woodward

NW Cor NE 1/4 Sec 7 E 7-25

3 M. S. in Bell Tole Md N side 21st & N 1/4 Sec 7 E 7-25

NOTE TO CONTRACTOR: Before any underground line is laid in K.G. & E. easement K.G. & E. to be constructed prior to any excavation within their easement

PROFILE - SANITARY SEWER

PROFILE - STORM SEWER

CHANNEL CROSS SECTIONS

LAT 15, MAIN 20, WAR INDUSTRIES SEWER  
CITY OF WICHITA  
R.W. BRUGGEMAN  
DIRECTOR OF ENGINEERING - CITY ENGINEER  
PROJ. NO. 468-76-245-81046-000-001

FILMED FROM THE BEST