





BM = 153.46 "□" on SW Cor. Conc. Headwall to Dyke

NOTE: SEE BENEFIT ORDINANCE FOR BENEFIT DISTRICT

RESERVE "A"

Note Type C' Manholes were installed instead of type A

Plan Scale 1" = 40'
Profile Scale 1" = 40' Horiz.
1" = 5' Vert.

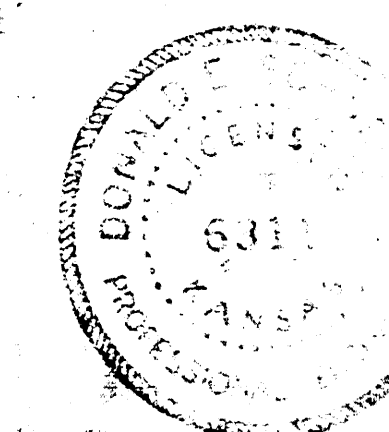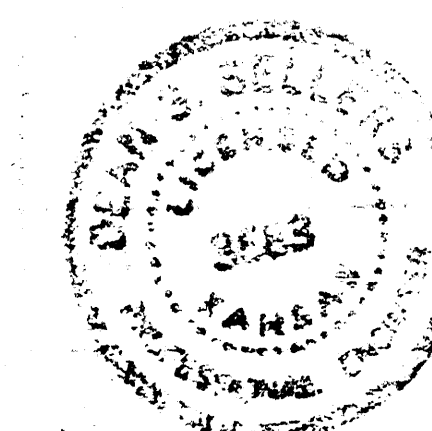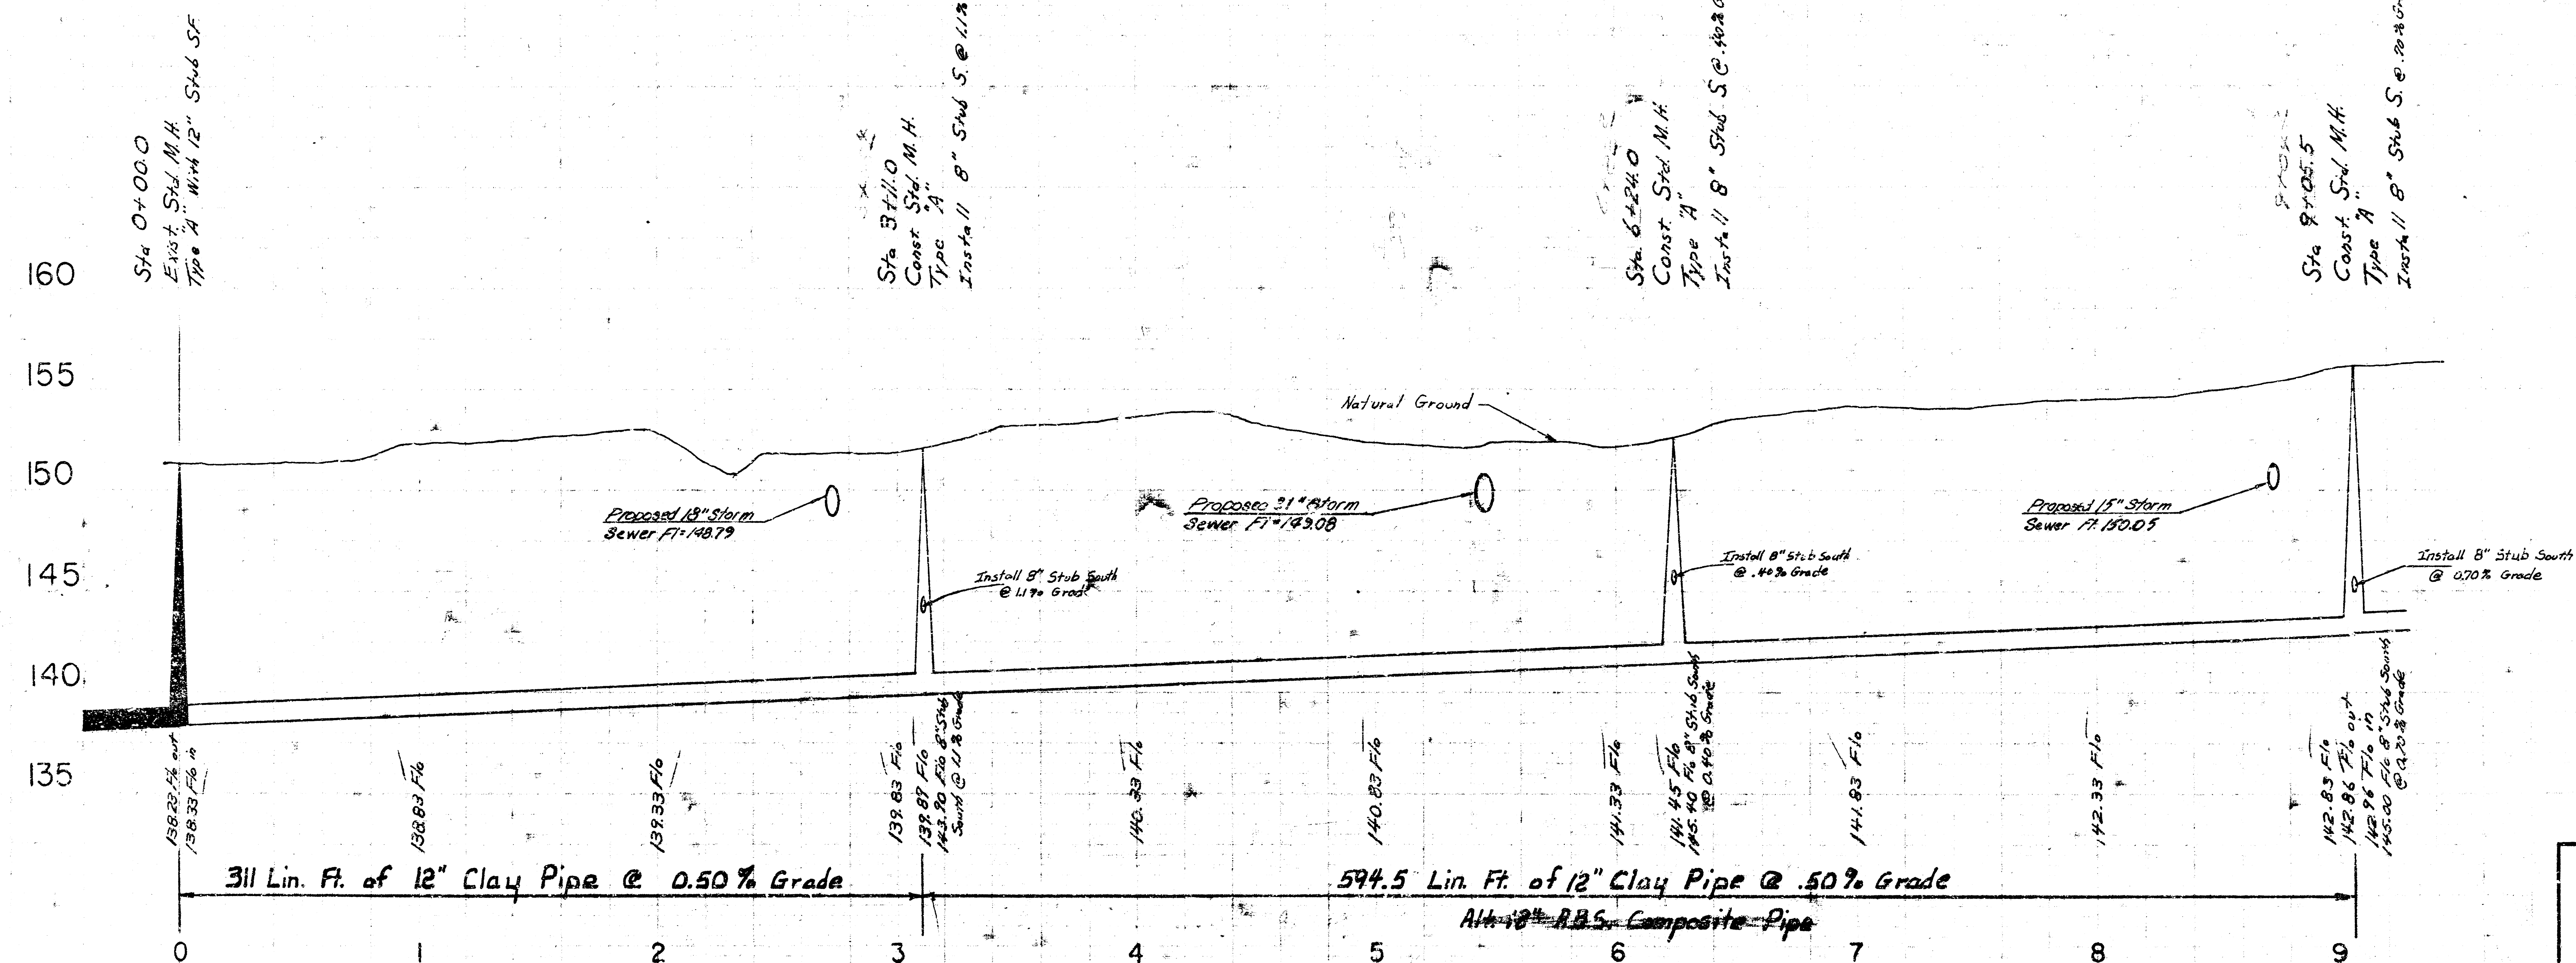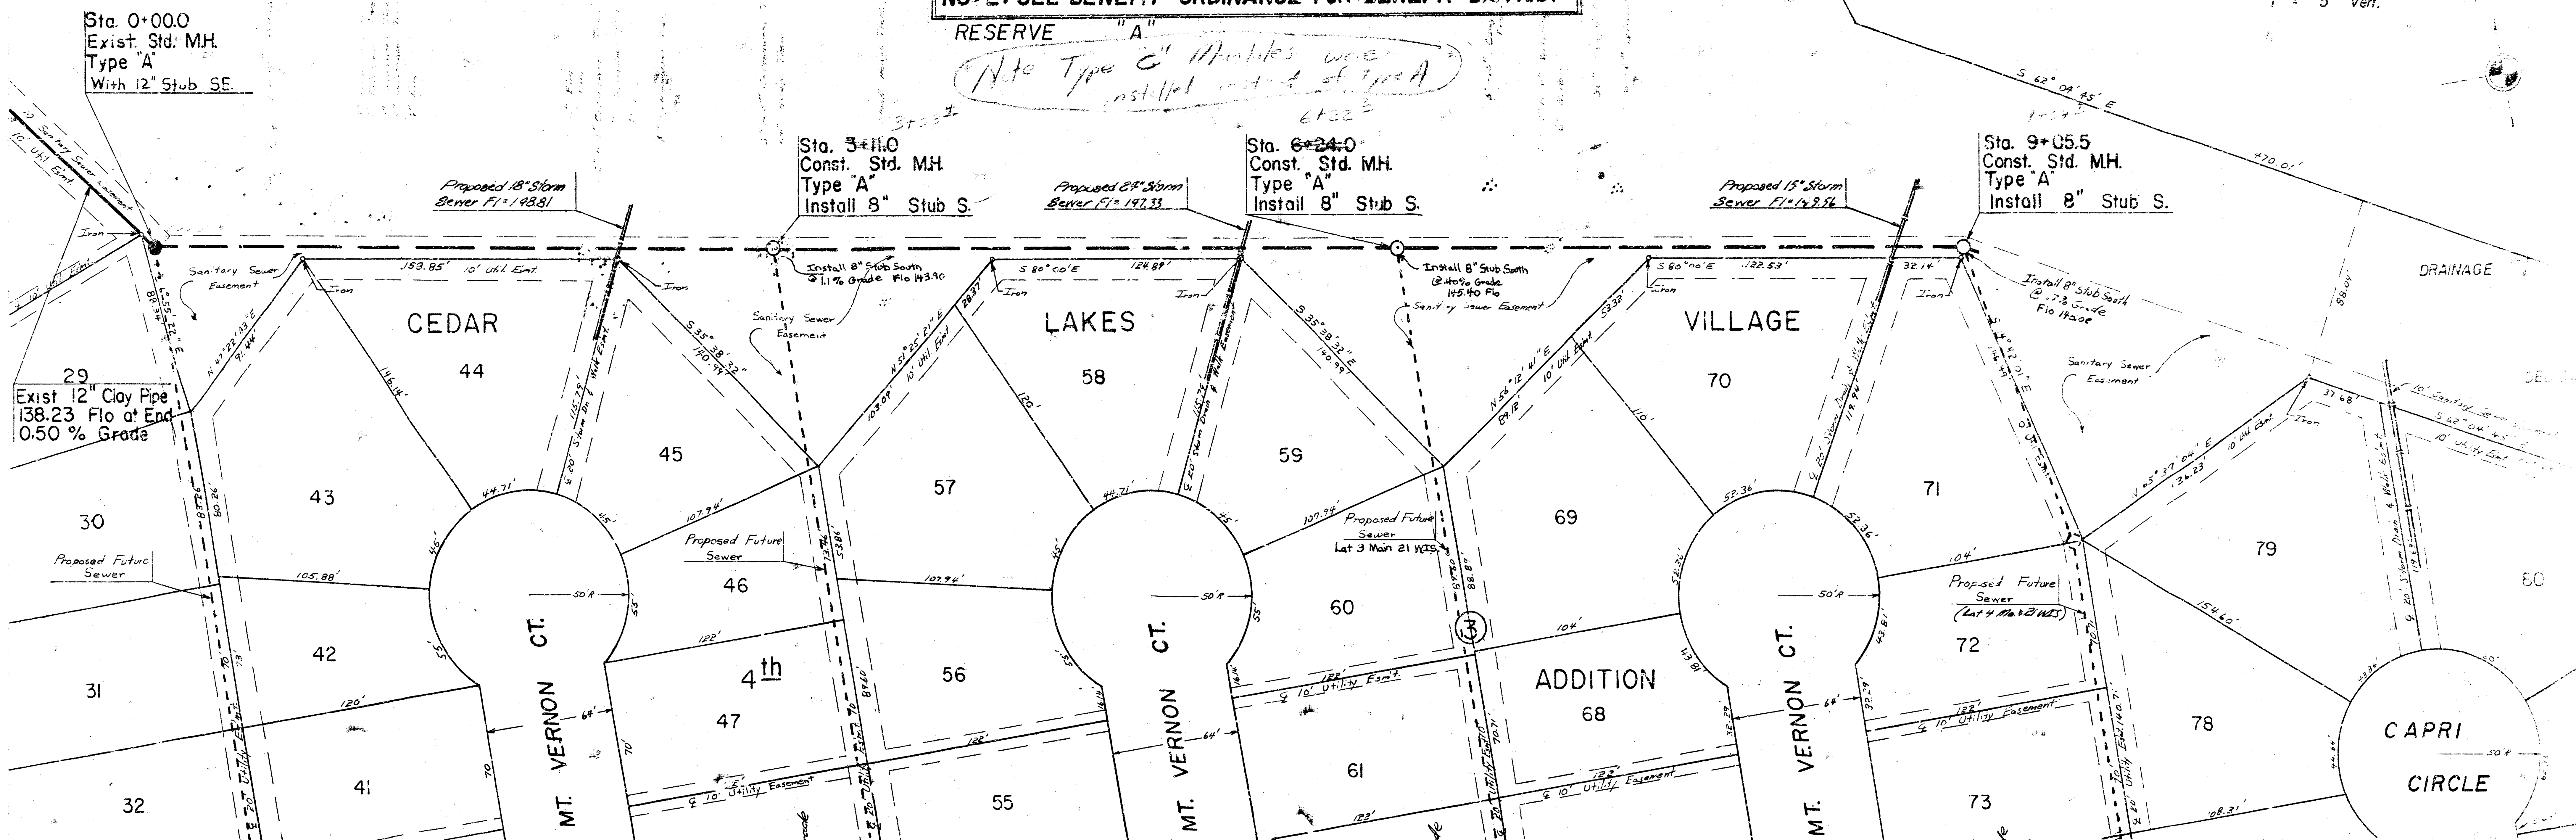

MAIN 21 WAR INDUSTRIES


CITY OF WICHITA, KANSAS

R. W. LINN — CITY ENG


PROJECT NO. DRKAM

RESERVE

"A"

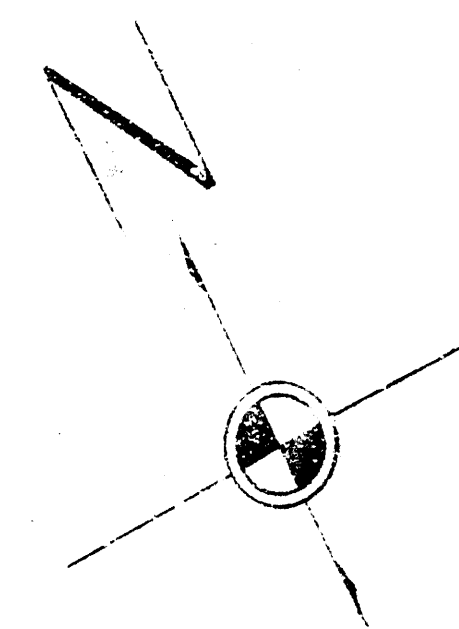

Plan Scale 1"=40'
Profile Scale 1"=40' Horiz.
1"=5' Vert.

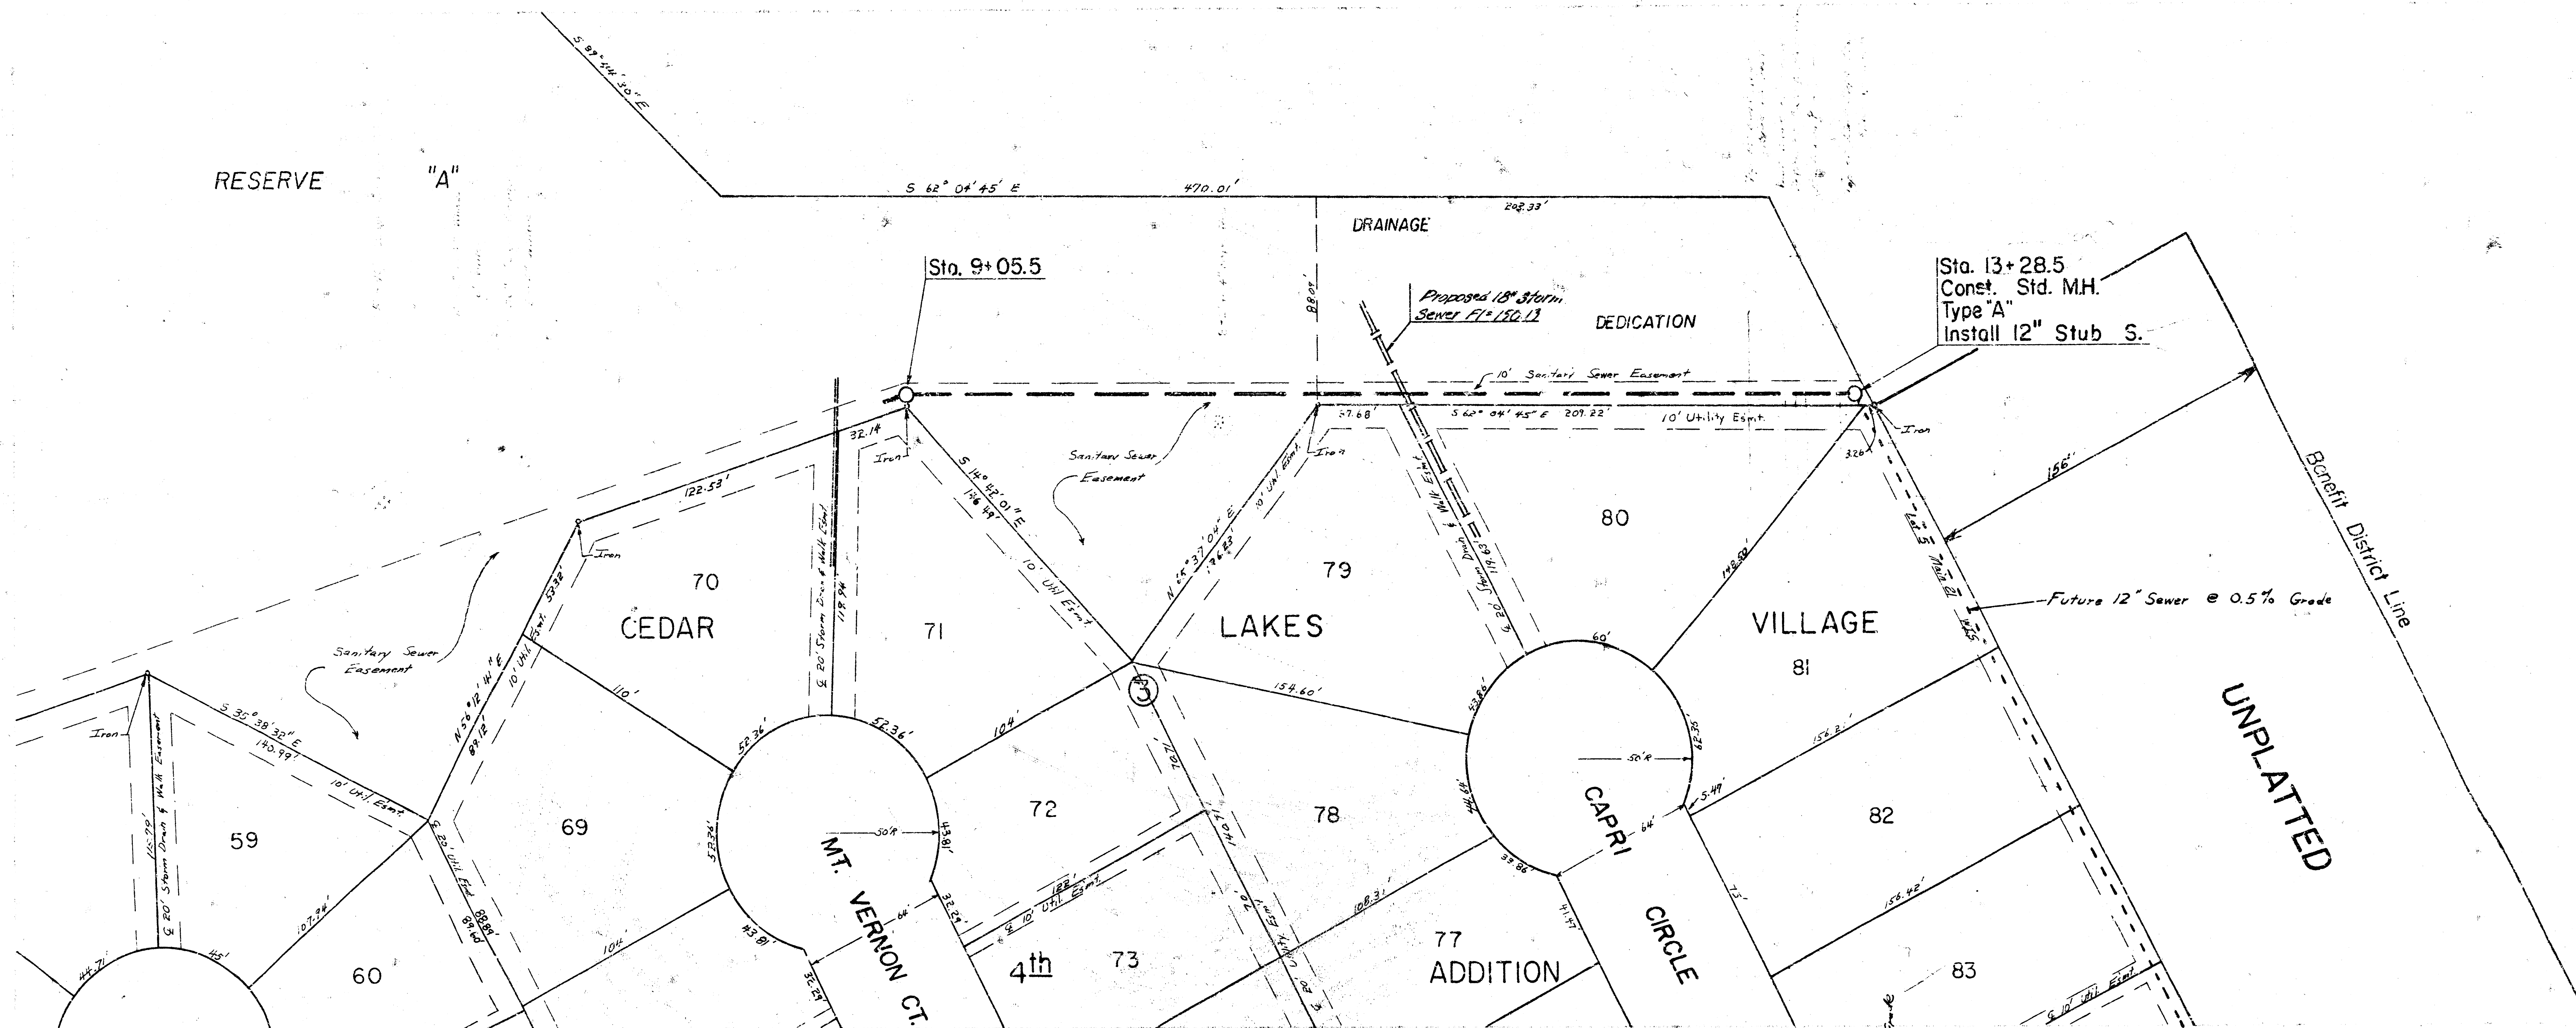

160

155

150

145

140

135

