MAIN EXTENSION - MAIN 22, W. I. S.

PROJECT NO.

468 76 245 80971 000 000 001

CITY OF WICHITA, KANSAS

DEAN SELLERS, ACTING CITY ENGINEER

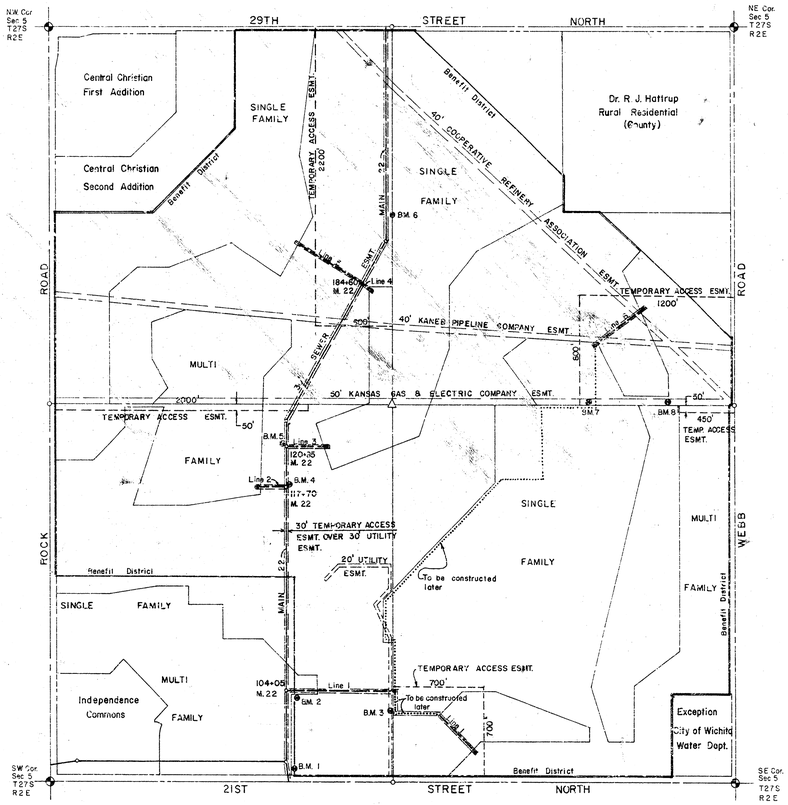

Scale 1" = 500'

INDEX TO DRAWINGS

SHEET	DESCRIPTION
1	TITLE SHEET
2-3	LINE 1
4	LINE 2 & LINE 3
5	LINE 4 & LINE 5
6	LINE 6

Van Doren - Hazard - Stallings

Architects • Engineers • Planners

Topeka Wichita Minneapolis

Sheet 1 of 6

FILMED FROM THE BEST AVAILABLE COPY

MAIN EXTENSION, MAIN 22, W.I.S.
468 76-245-80971-000-000 00!

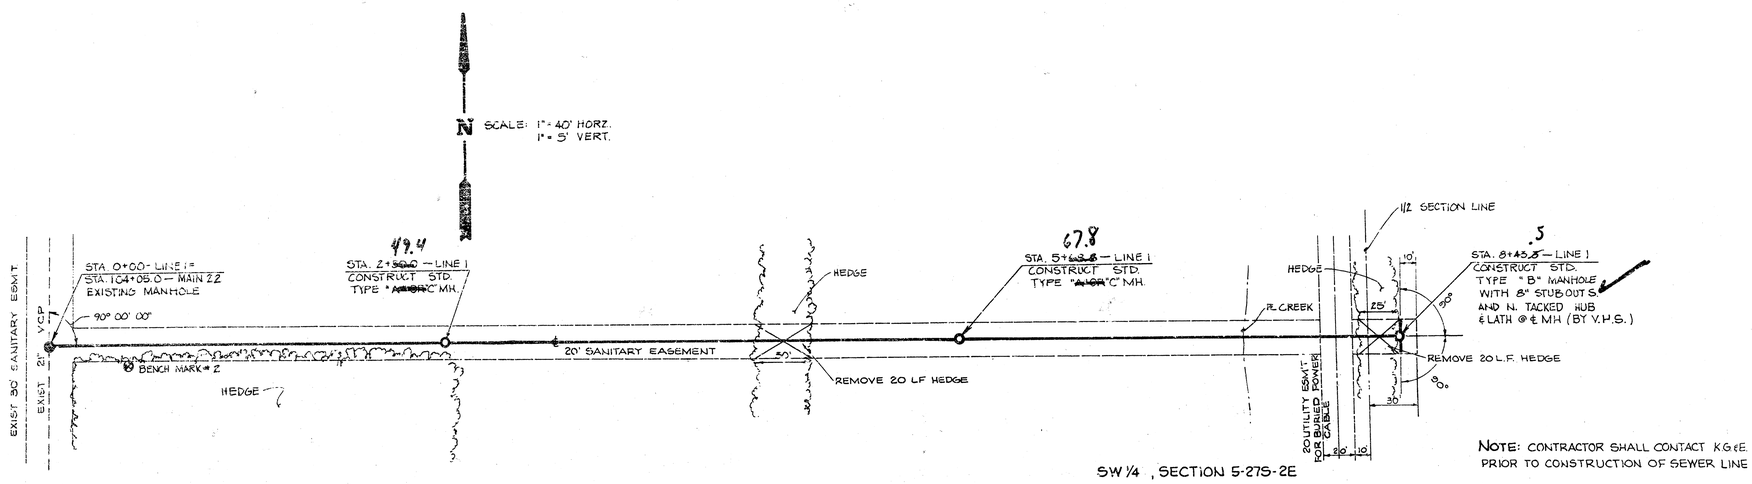

SW 1/4, SECTION 5-27S-2E

NOTE: CONTRACTOR SHALL CONTACT KG&E. PRIOR TO CONSTRUCTION OF SEWER LINE

BENCH MARK # 3

BENCH MARKS:

BENCH MARK # 1: STP SPK E. FC. PP S. SIDE 21ST STREET NORTH 1820' E. ROCK ROAD STA. 96+96, 17' LT. MAIN 22 W.I.S. ELEV. = 193.26

BENCH MARK # 2: RR SPK NE FC 10" ELM., STA 0+50, 12' RT. LINE 1
ELEV. = 194.92

BENCH MARK # 3: TOP BENT SPK E. ROOT 2-6" HEDGE TREES 30' RT. 9+75. ELEV. = 194.86

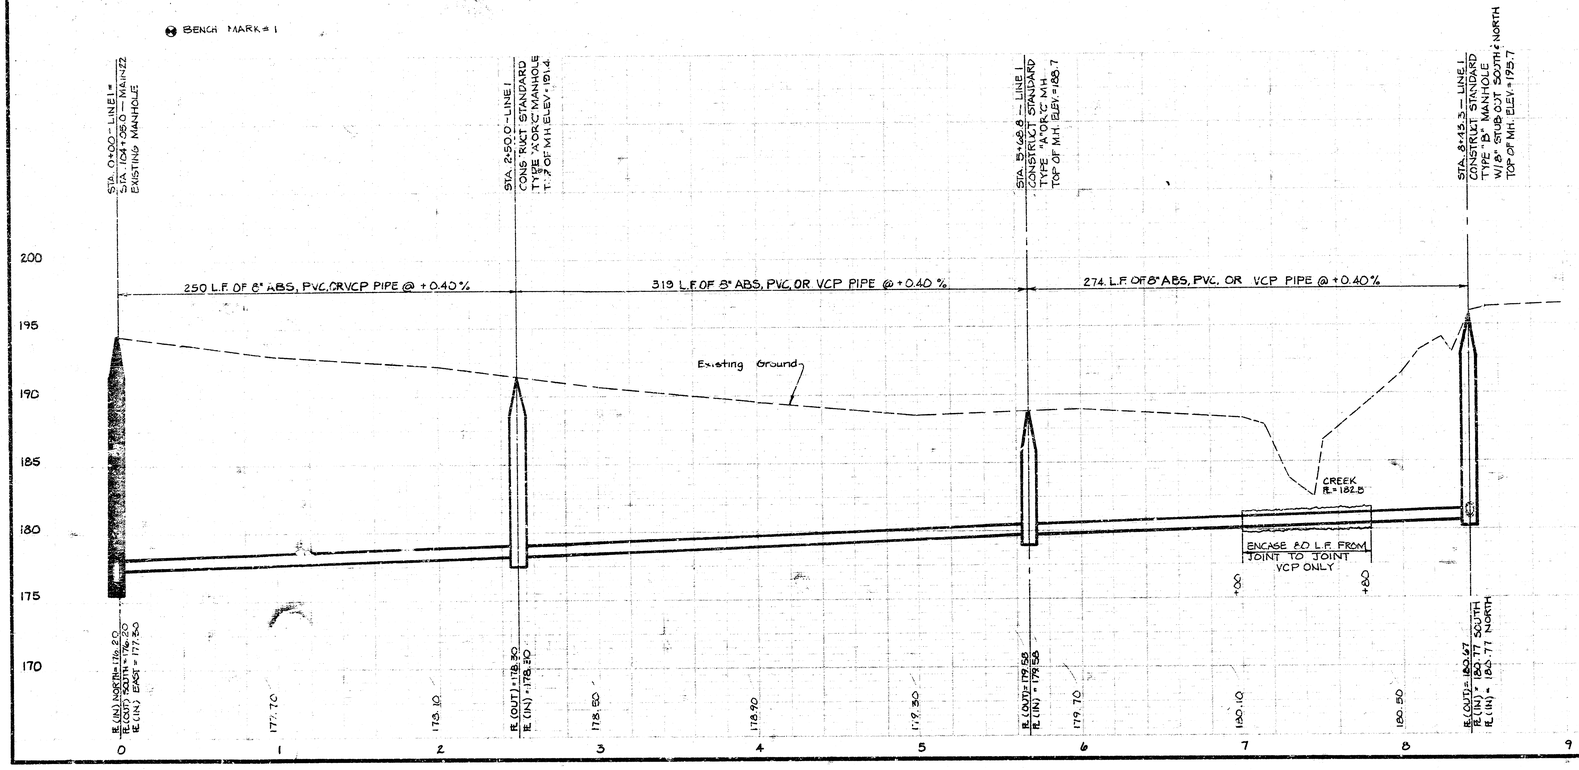

As Built
6/81

FILMED FROM THE BEST AVAILABLE COPY

MAIN EXTENSION, MAIN 22, W.I.S.
468·76·245·80971 ·000·000·001

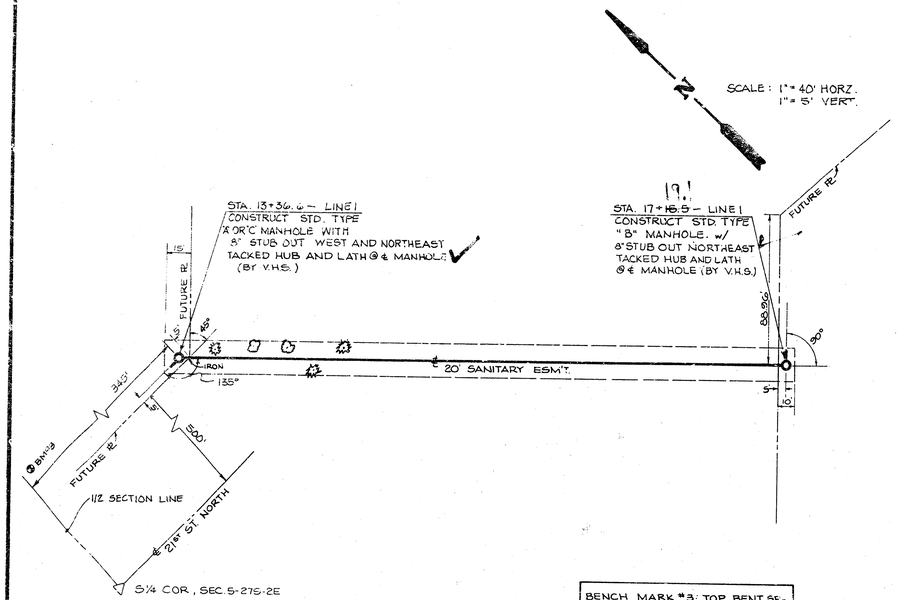

BENCH MARK "3" TOP BENT SP.
E. ROOT 2-6" HEDGE TREES
30' RT. 9+73
ELEV. = 194.36

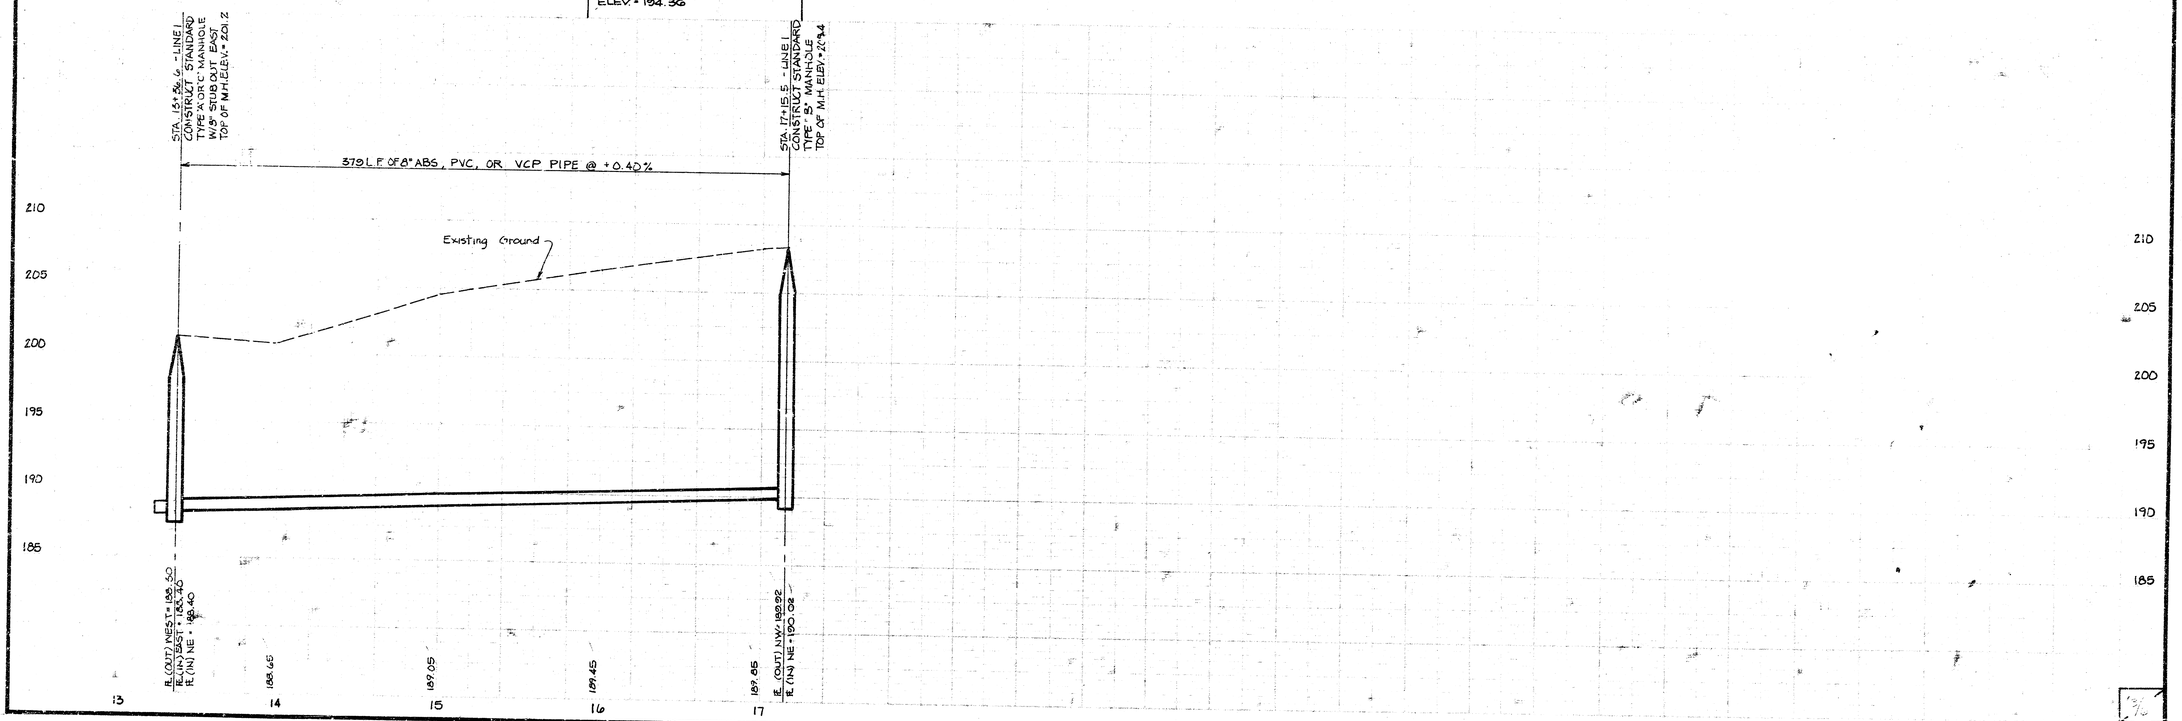

MAIN EXTENSION, MAIN 22, W.I.S.
463-76-245-80971-000-000-001

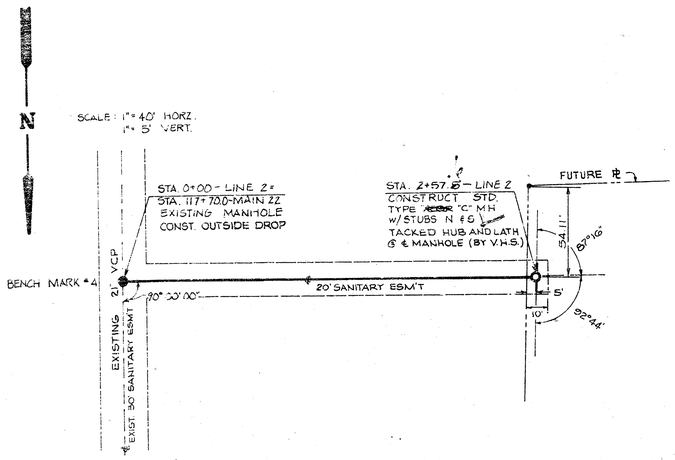

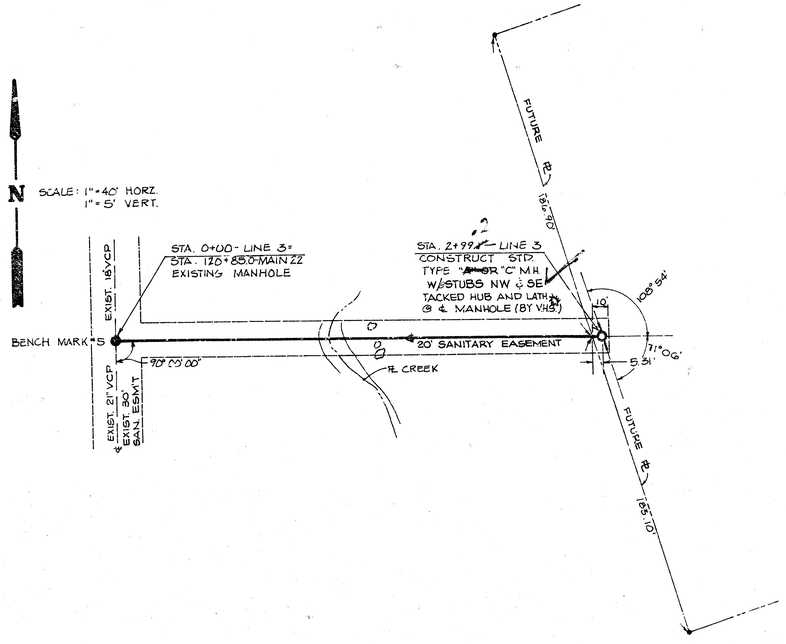

BENCH MARKS:

BENCH MARK #4: SW MH RIM STA. 117+70 ELEV. = 195.26
BENCH MARK #5: E RIM MH. STA. 120+85 ELEV. = 198.38

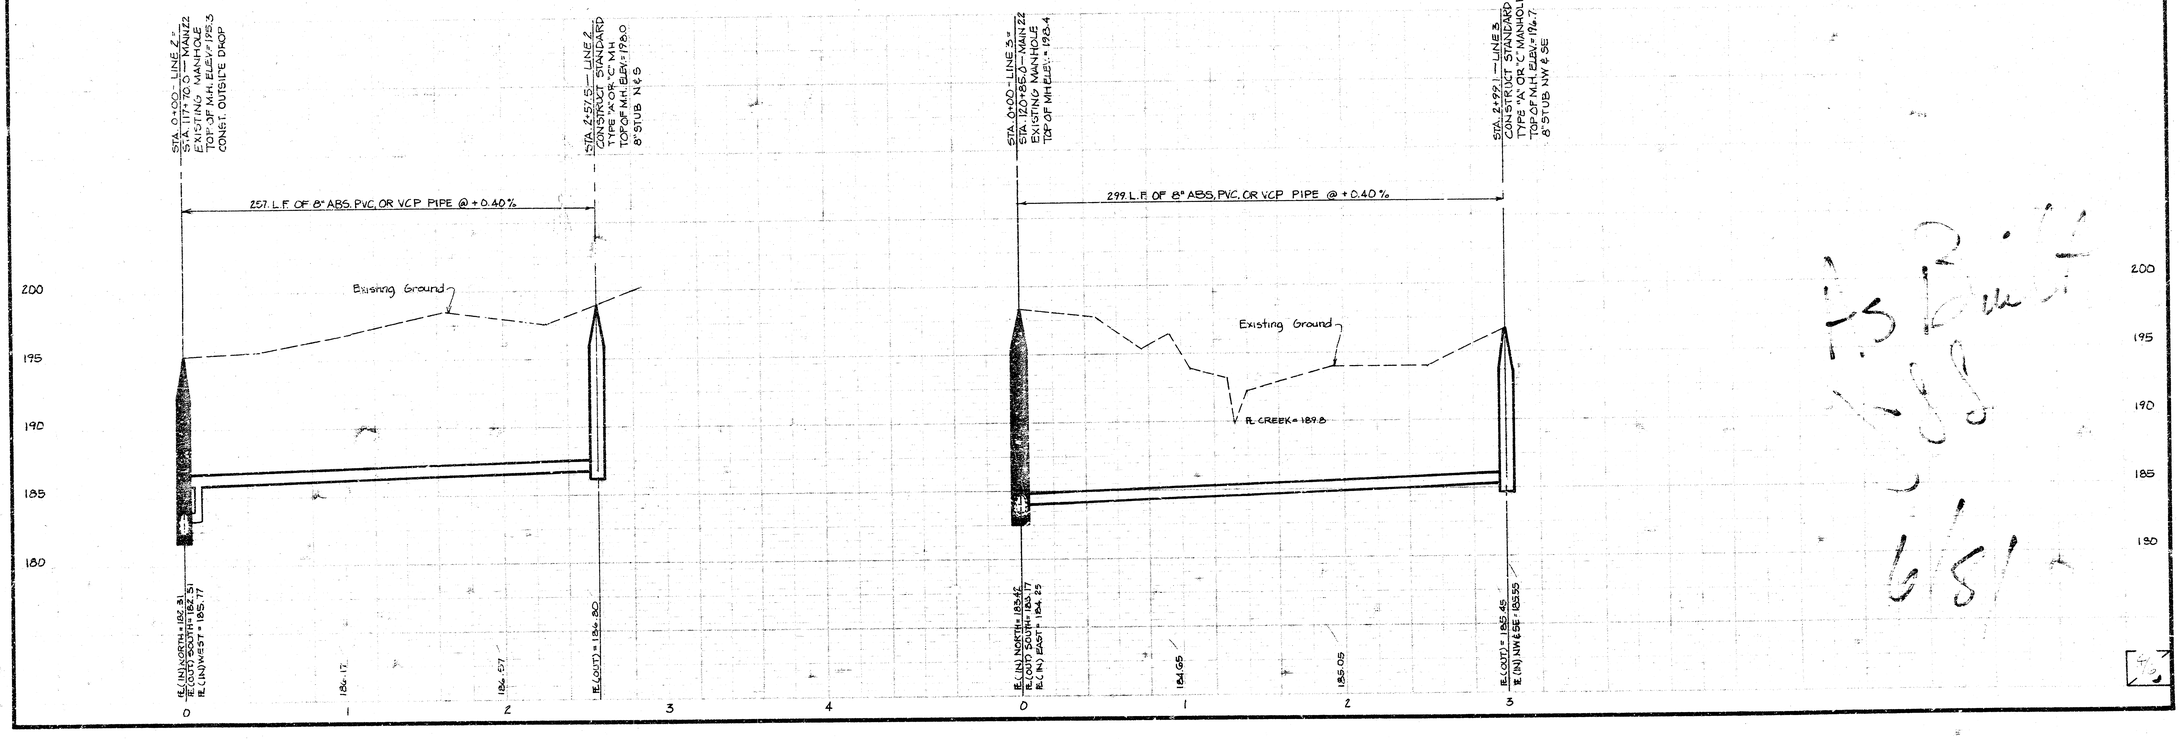

MAIN EXTENSION, MAIN 22, W.I.S.
468-76-245-80971-000-000-001

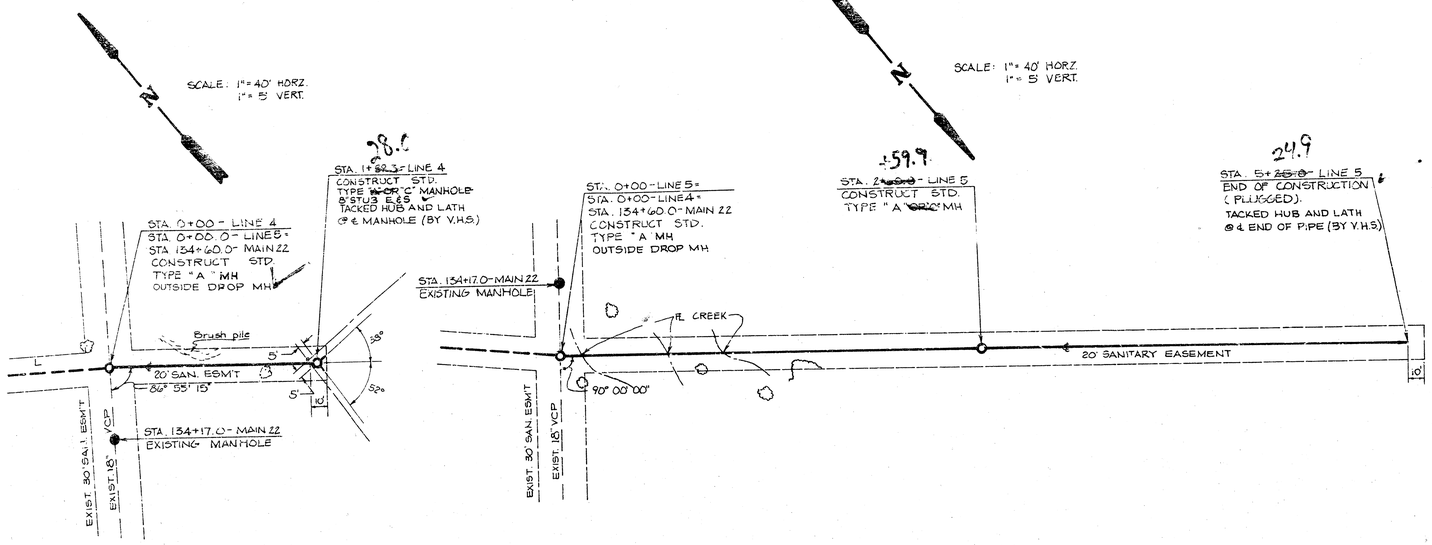

BENCH MARKS:

BENCH MARK # 6: BENT SPIKE
W. ROOT 25" HEDGE 139+72
50' RT. MAIN 22.
ELEV.= 2' 9.06

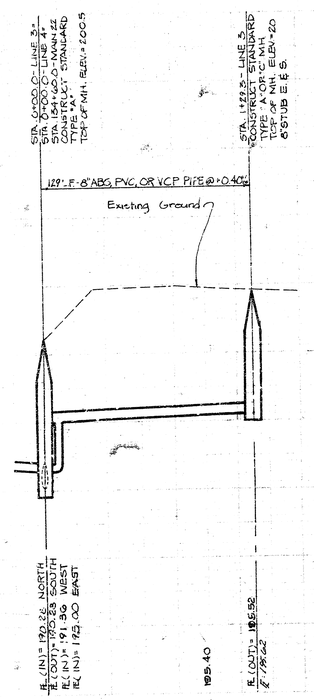

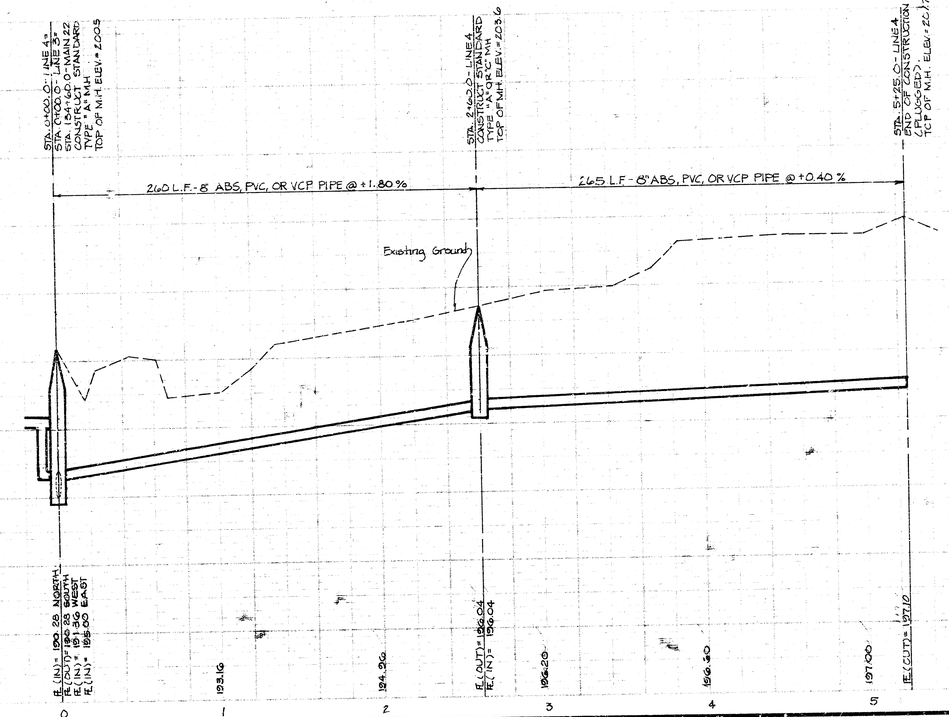

MAIN EXTENSION, MAIN 22, W.I.S.
468·76·245·80971·000·000·001

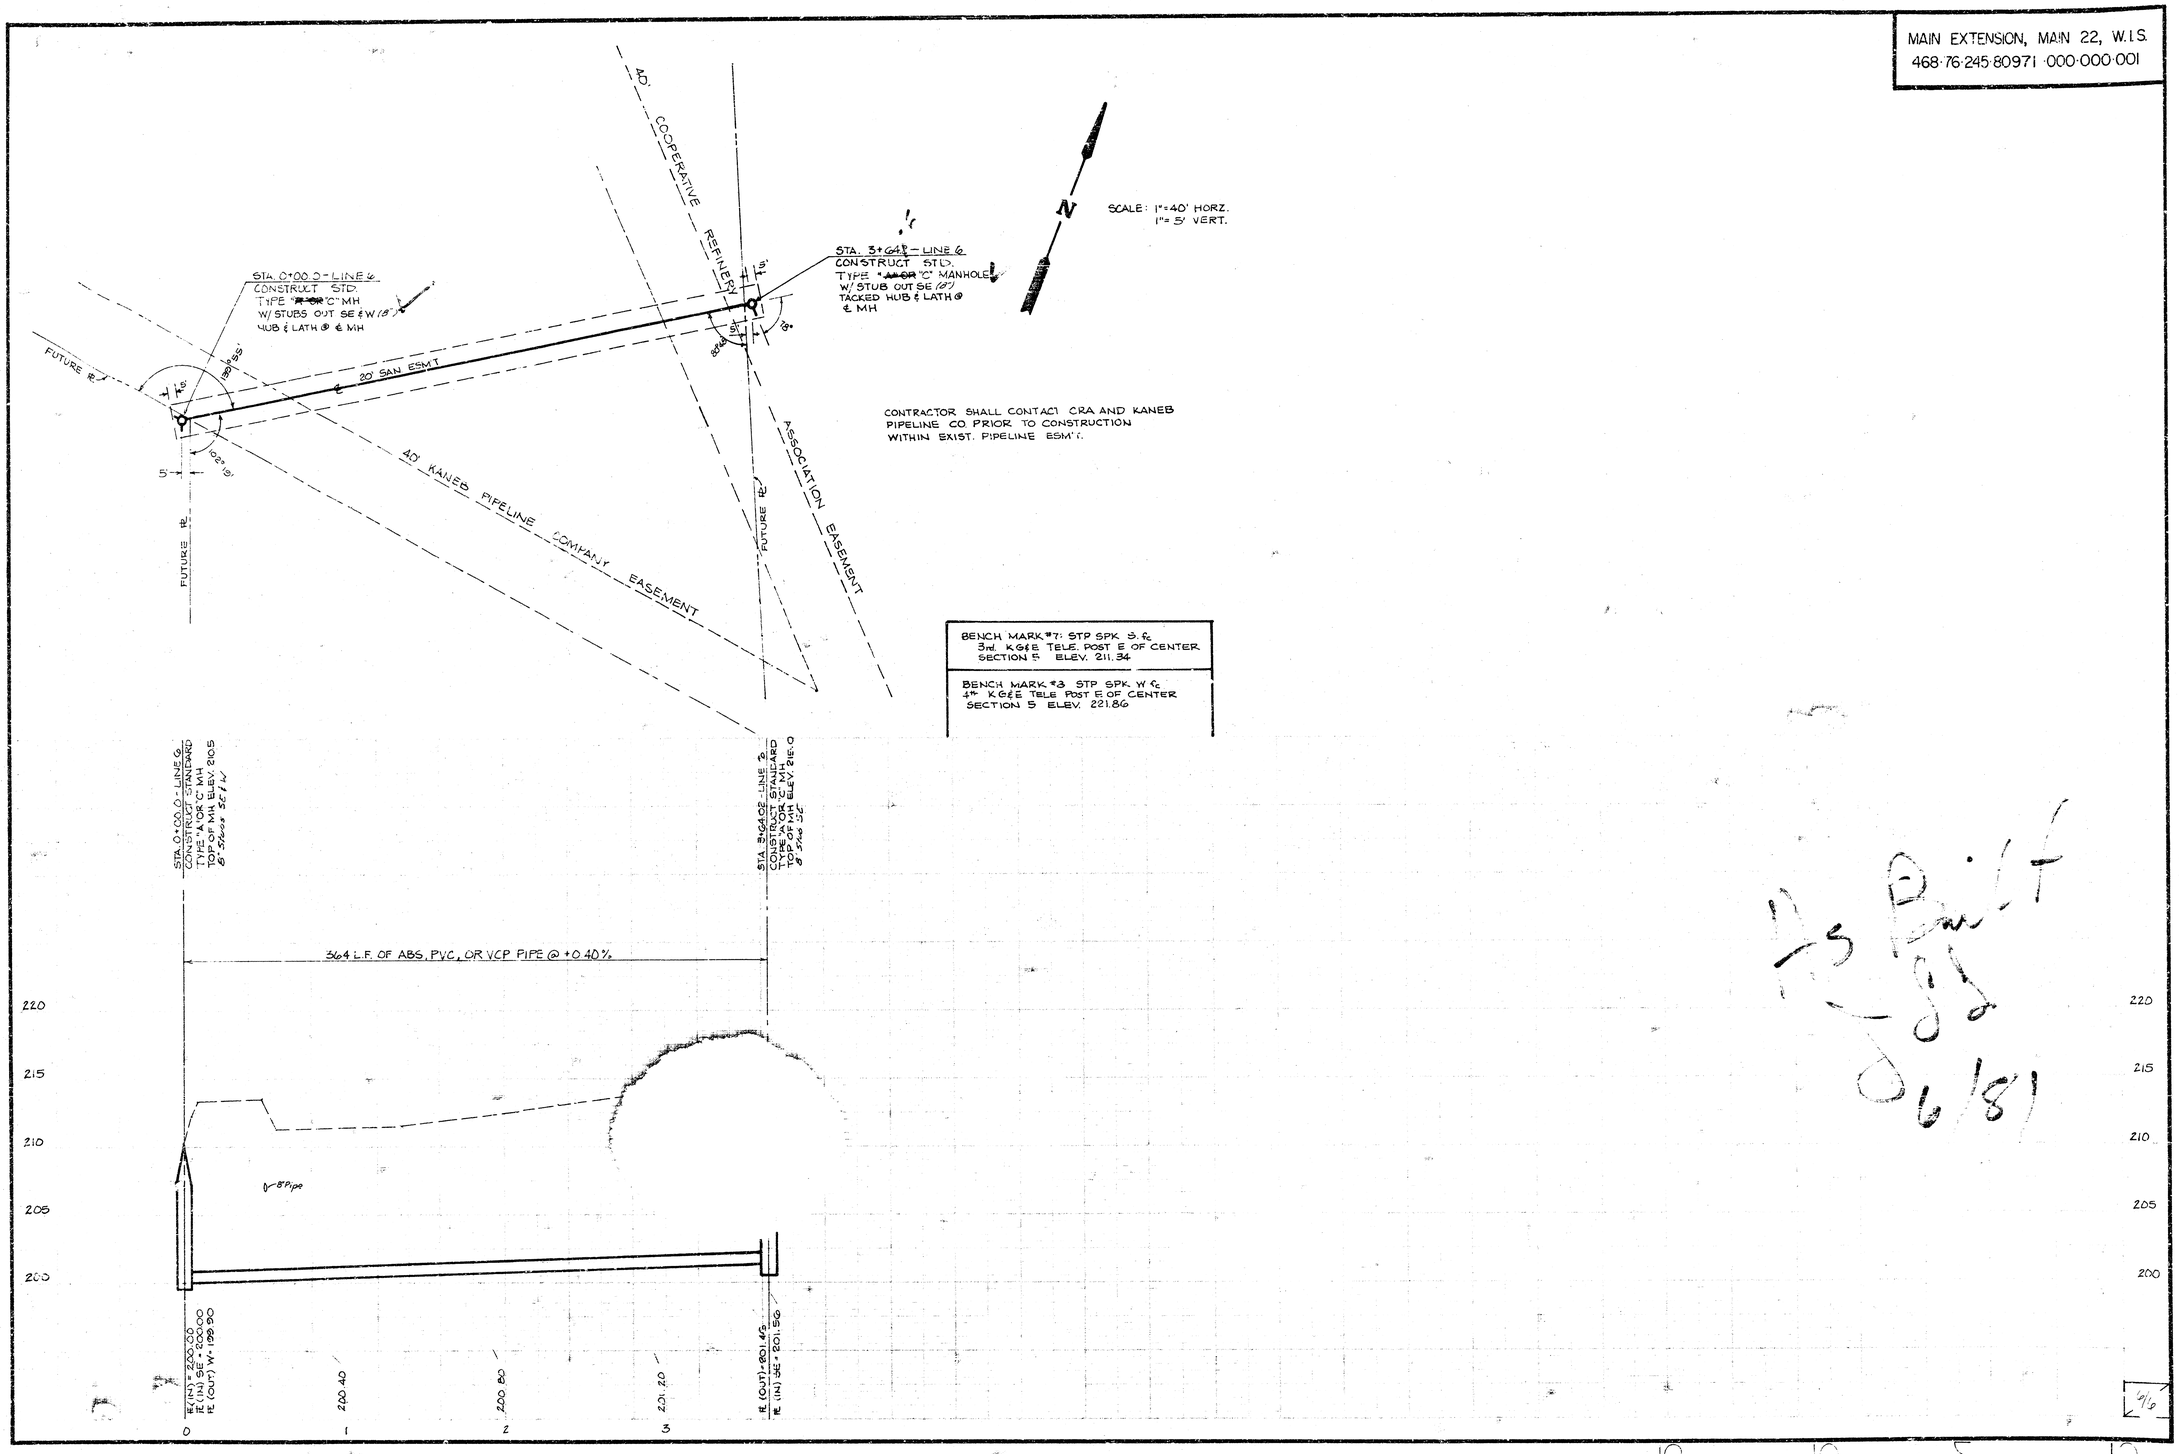

As Built
6/81

6/6