



...
...
...
...
...

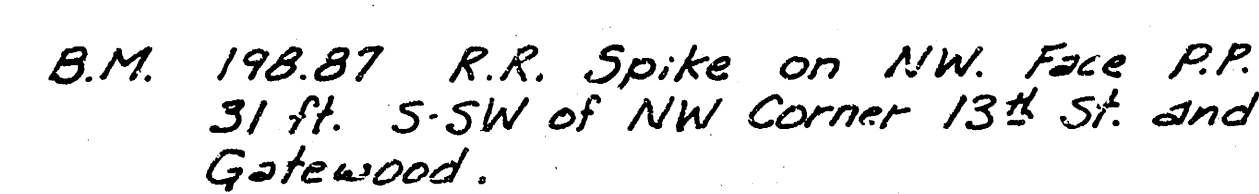

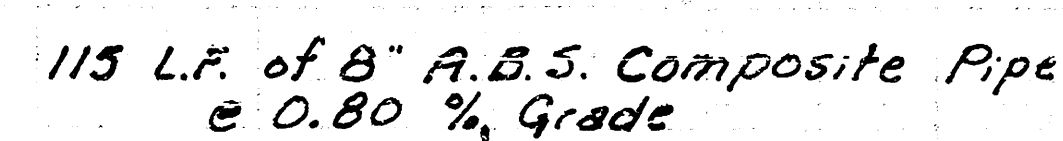

LAT 9, MAIN 22, WAR INDUSTRIES SEWER
CITY OF WICHITA, KANSAS
DEAN SELLERS — CITY ENGINEER
PROJ. NO. 46876245-80840-000-000-001

Q. Built
6-13-81