

LATERAL 11, MAIN 22, W.I.S.

PROJECT NO.
468-76-245-80979-000-000-001


CITY OF WICHITA, KANSAS
R. W. BRUGGEMAN, CITY ENGINEER

AUGUST, 1981
PLUMTHICKET

9 B.M.#2

INDEX TO DRAWINGS

PAGE 1	COVER SHEET
PAGE 2	LINE ONE
PAGE 3	LINE ONE
PAGE 4	LINE ONE
PAGE 5	LINE TWO, THREE & FOUR
PAGE 6	LINE FIVE, SIX
PAGE 7	LINE SEVEN
PAGE 8	PLAT

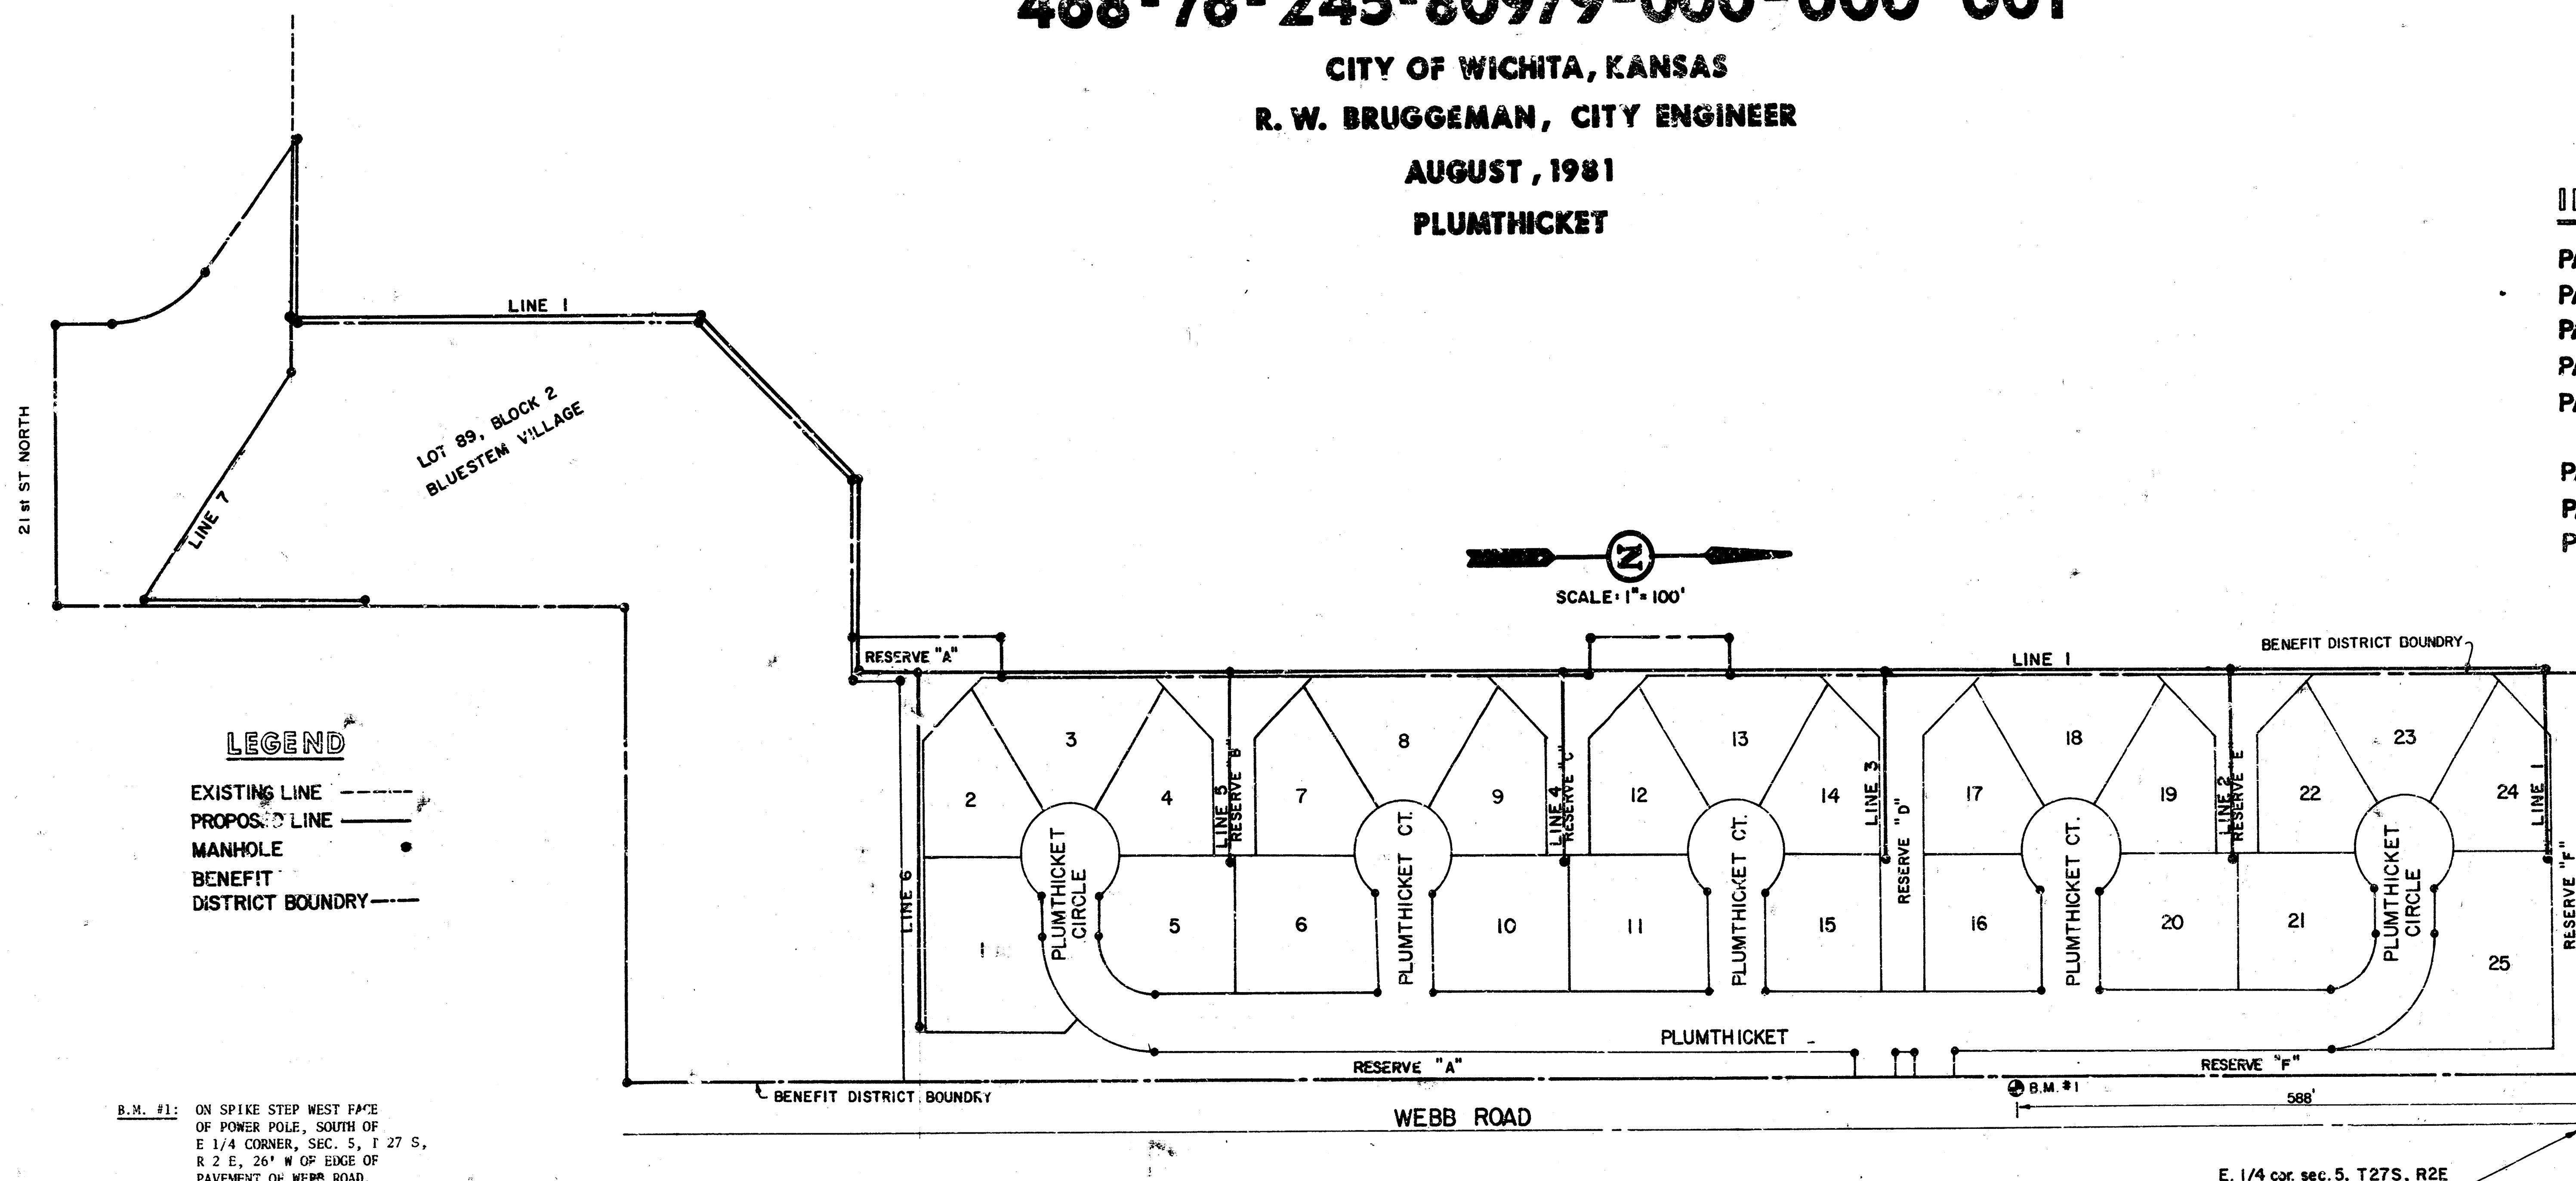

B.M. #1: ON SPINE STEP WEST FACE OF POWER POLE, SOUTH OF E 1/4 CORNER, SEC. 5, T 27 S, R 2 E, 26' W OF EDGE OF PAVEMENT OF WEBB ROAD. ELEV. = 229.85

B.M. #2: SPINE STEP IN WEST FACE OF POWER POLE, EAST OF CENTER SECTION 5, T 27 S, R 2 E. ELEV. = 221.86

NOTE: THE CONTRACTOR SHALL BE RESPONSIBLE FOR PRESERVING PROPERTY IRONS. THE CONTRACTOR SHALL BE REQUIRED TO RE-ESTABLISH ANY PROPERTY IRONS WHICH ARE DAMAGED OR DESTROYED BY HIS CONSTRUCTION OPERATIONS. SUCH IRONS SHALL BE RE-ESTABLISHED BY A LICENSED LAND SURVEYOR OR A LICENSED PROFESSIONAL ENGINEER IN ACCORDANCE WITH STATE LAWS.





Van Doren - Hazard - Stallings
Architects - Engineers - Planners
Topeka Wichita Minneapolis


Sheet 1 of 8

FILMED FROM THE BEST AVAILABLE COPY


PLUMTHICKET
LATERAL 11, MAIN. 22

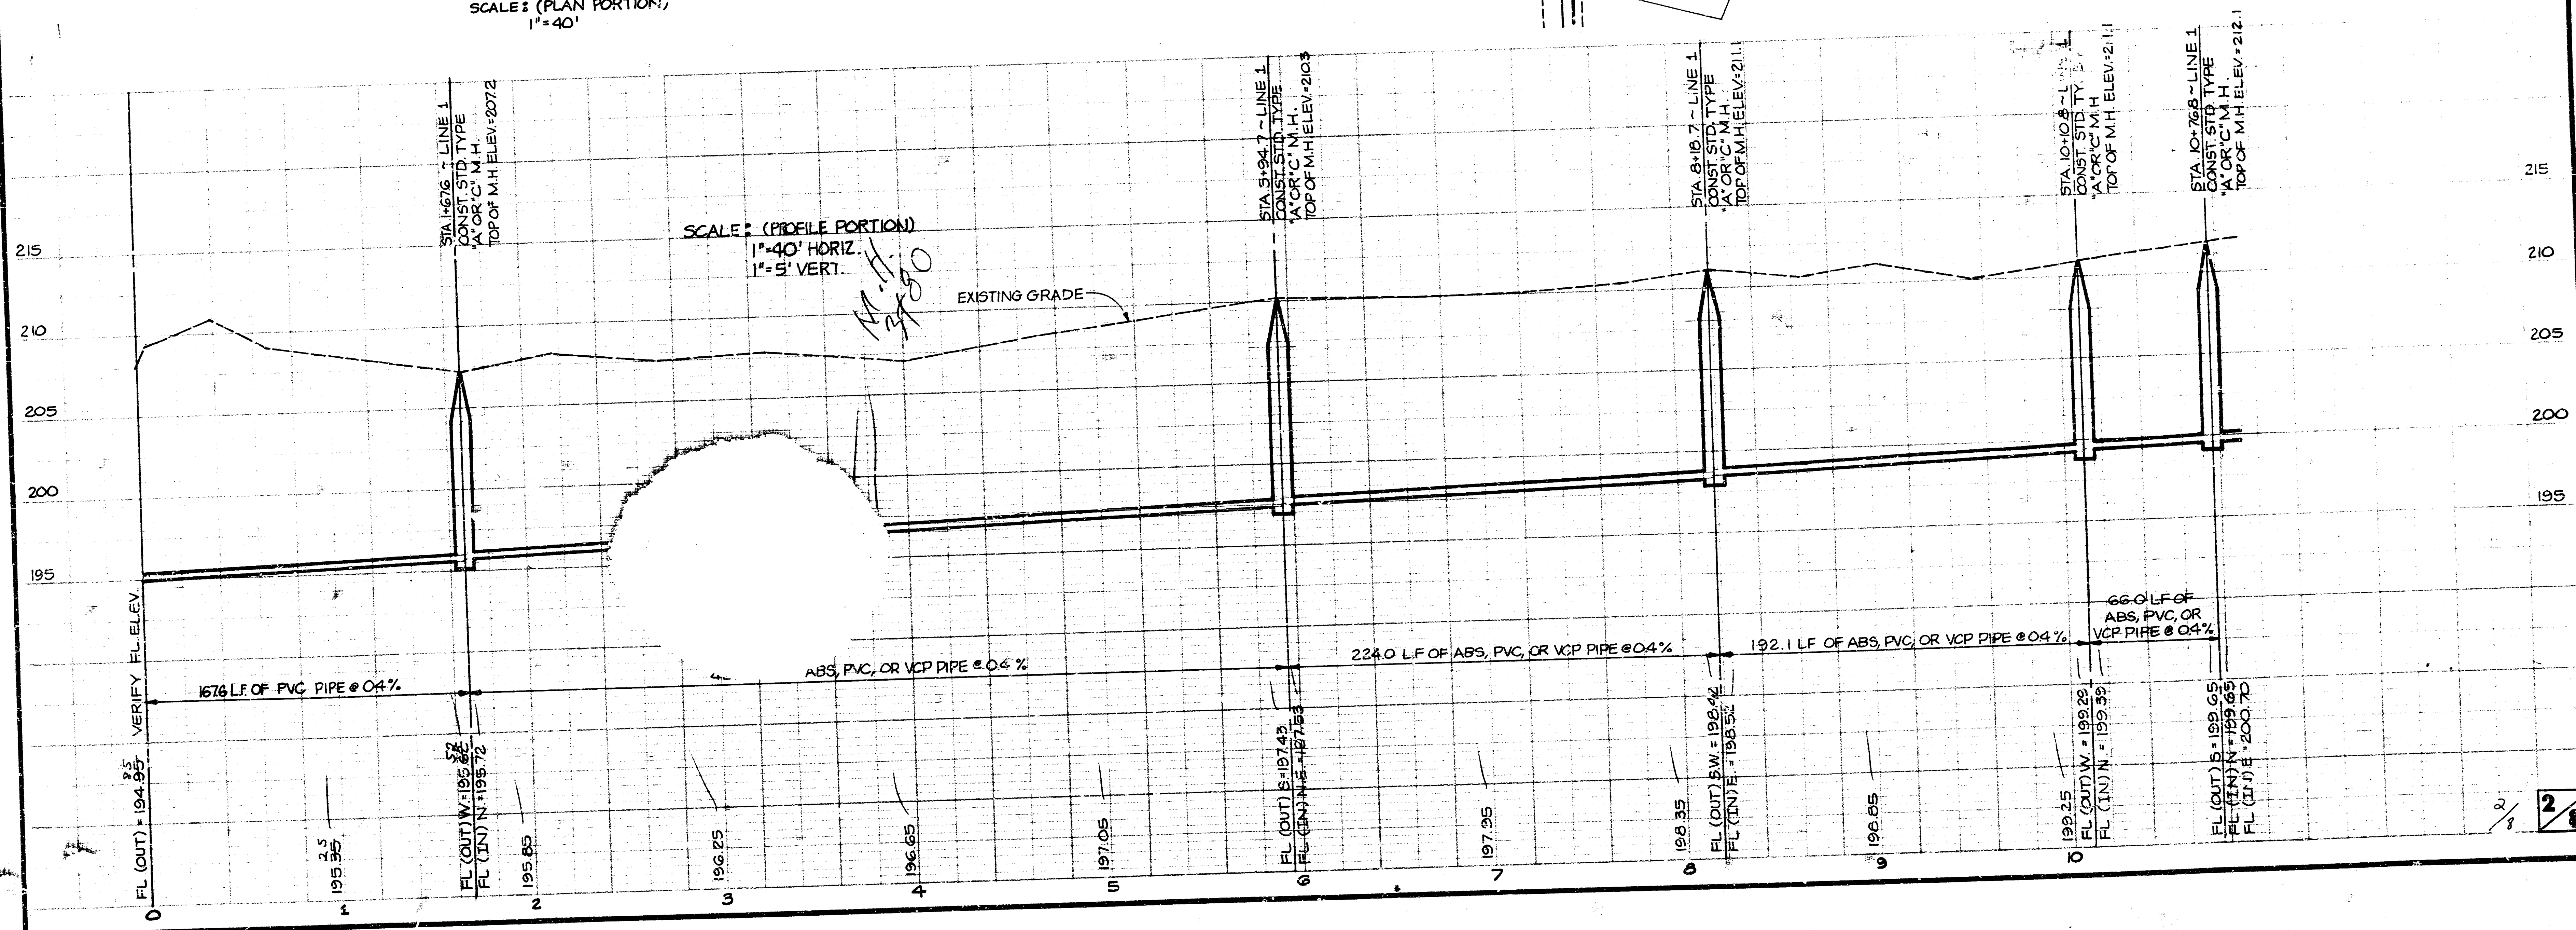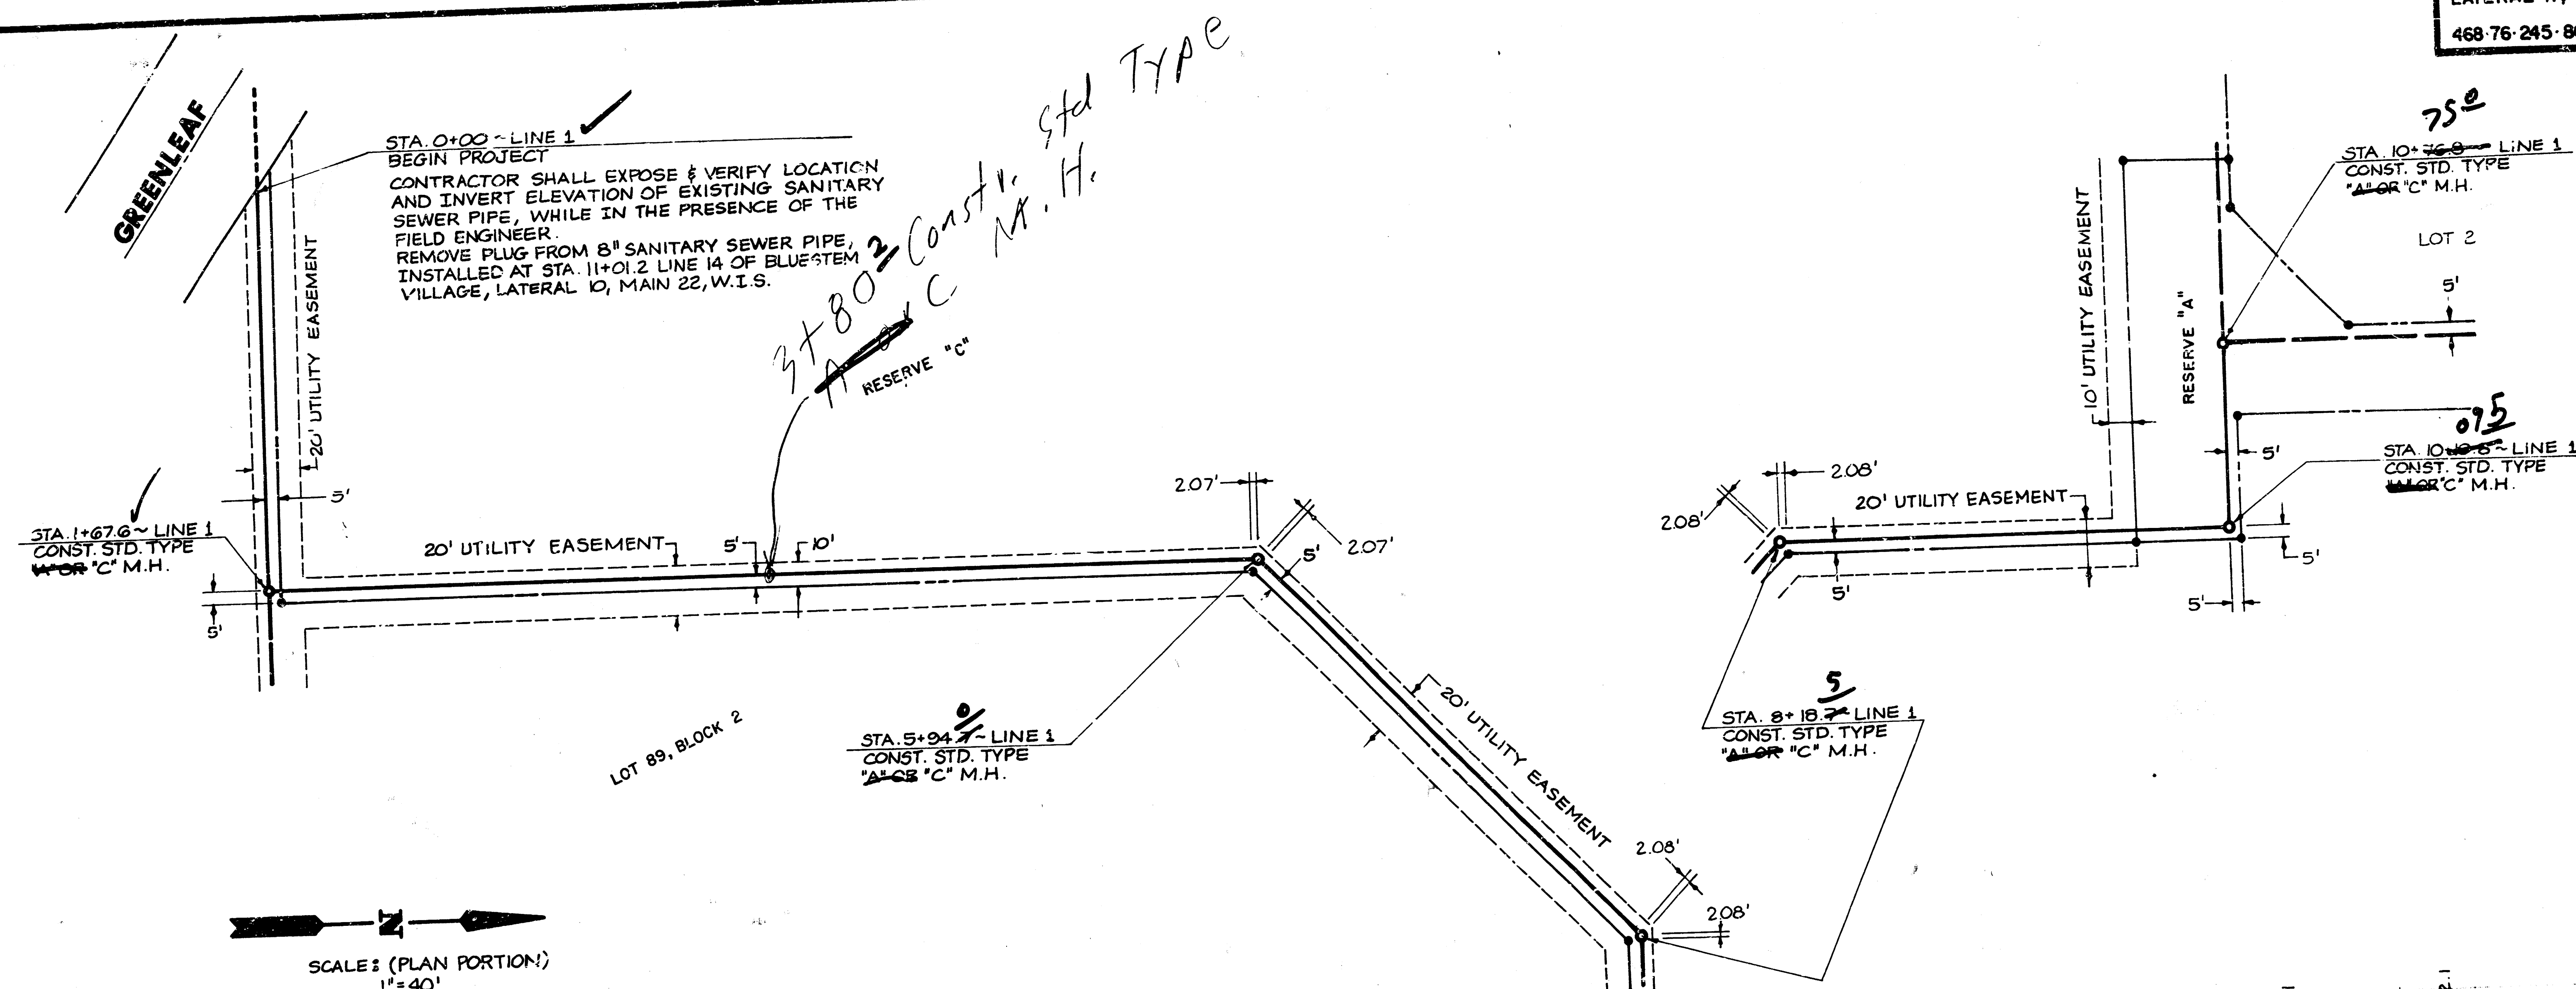



PLUMTHICKET
LATERAL II, MAIN 22
468-76-245-80979-000-000-001

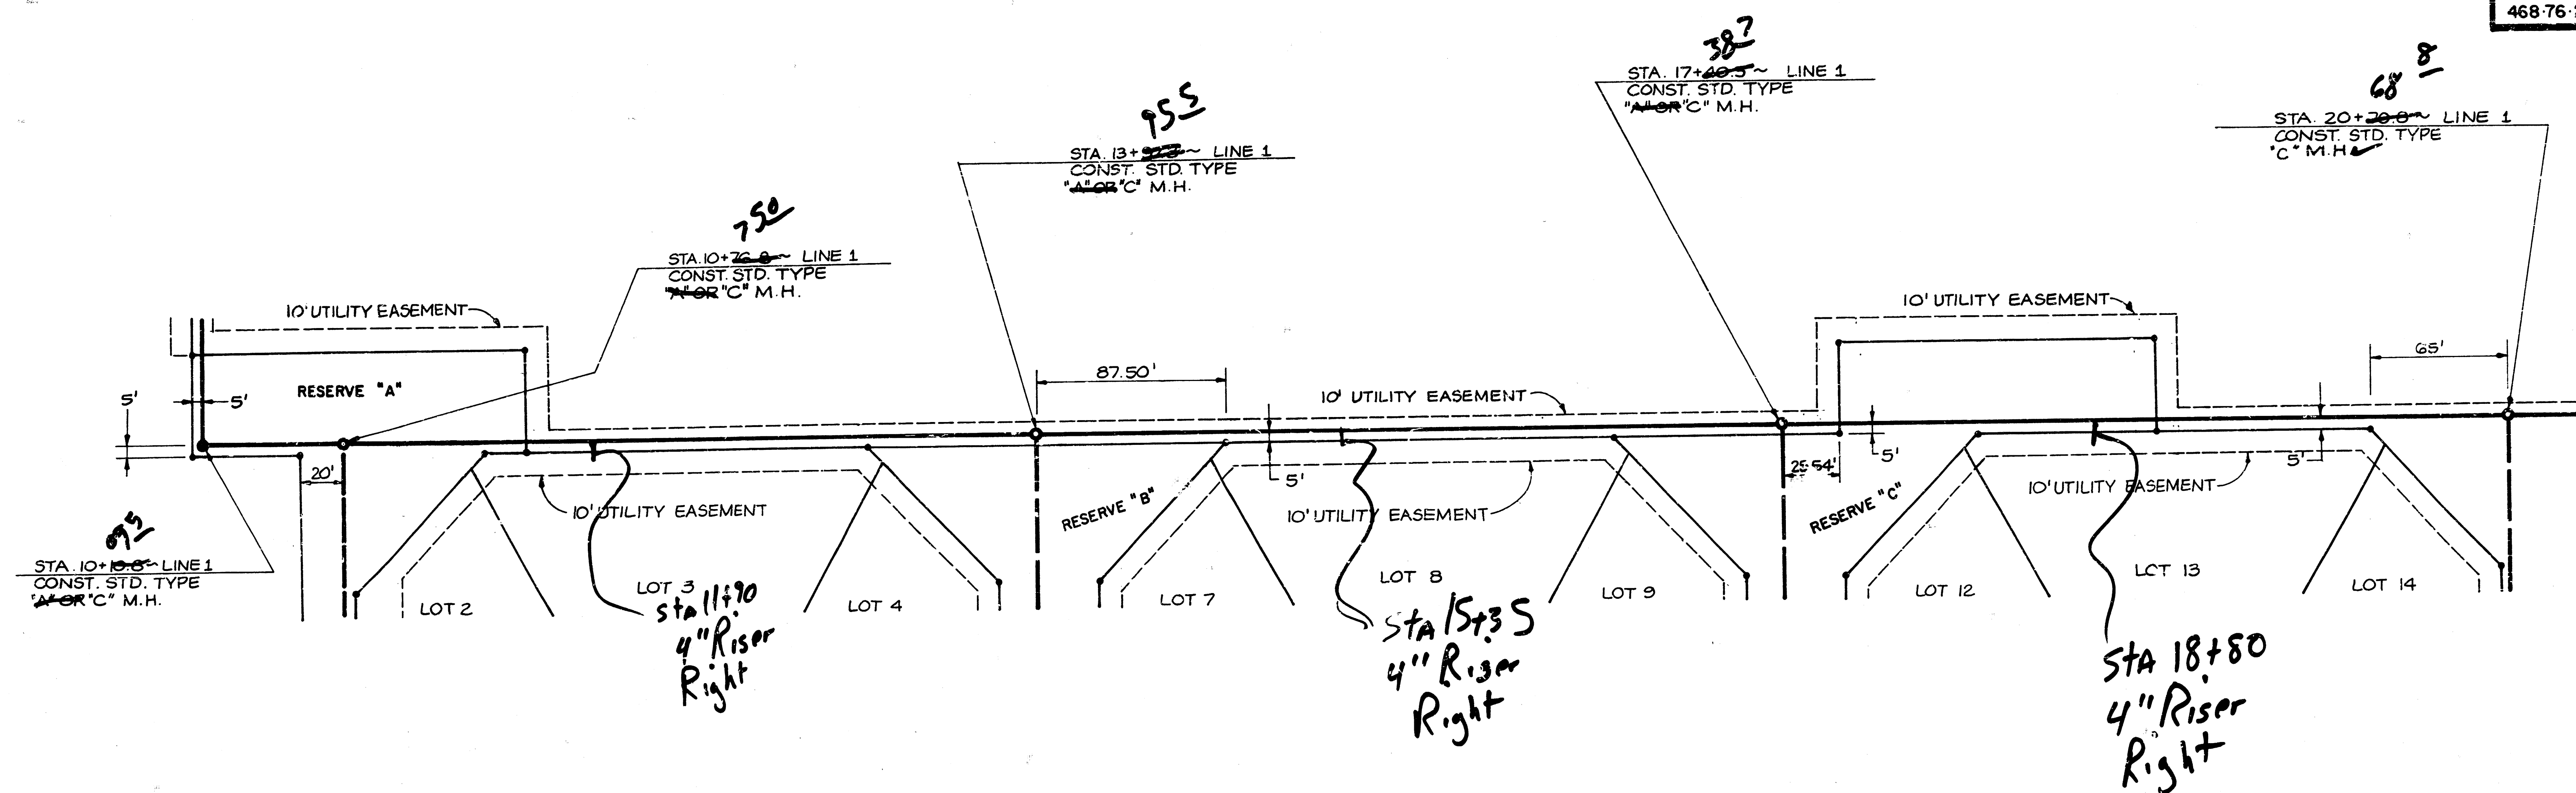





SCALE: (PLAN PORTION)
1"=40'

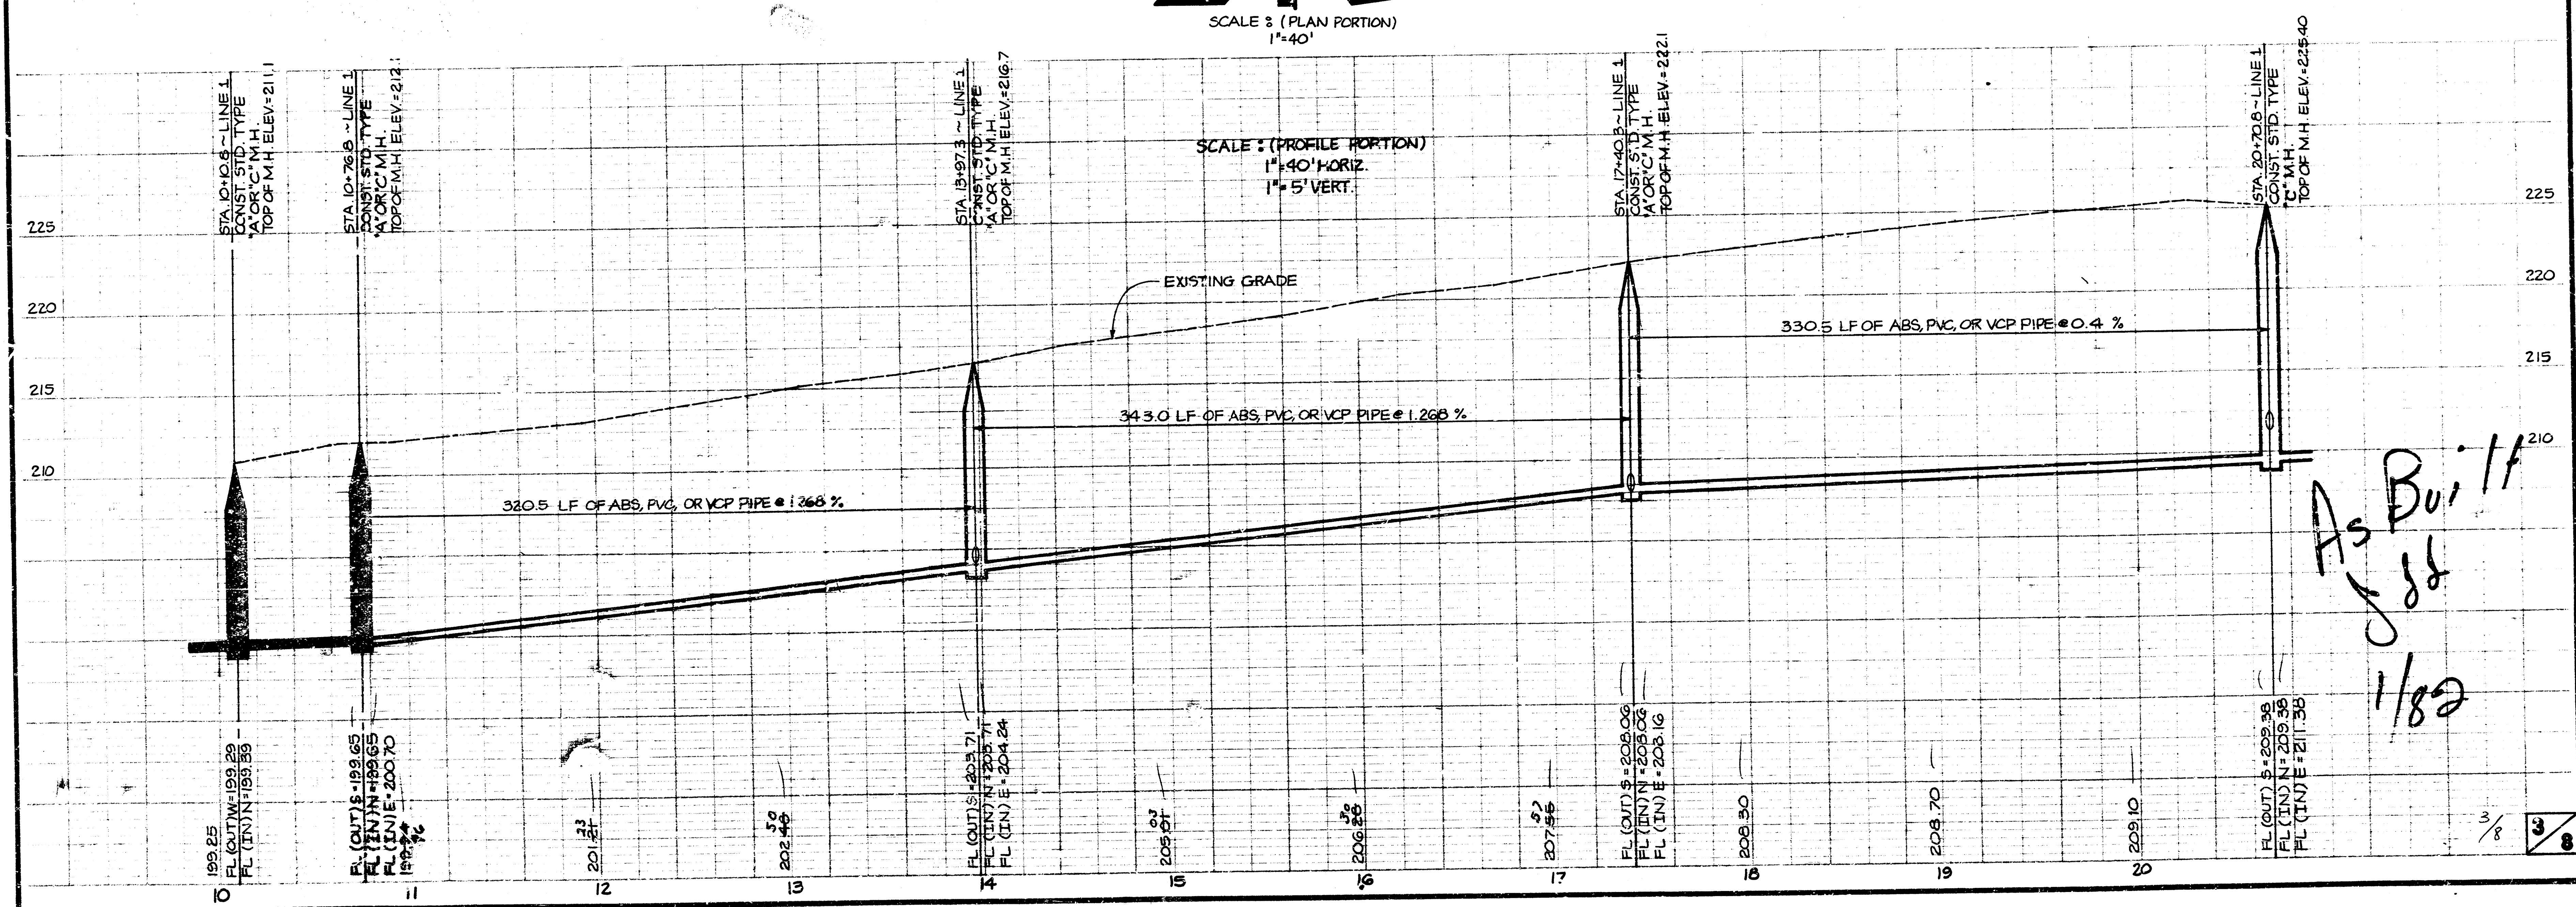

FILMED FROM THE BEST
AVAILABLE COPY....

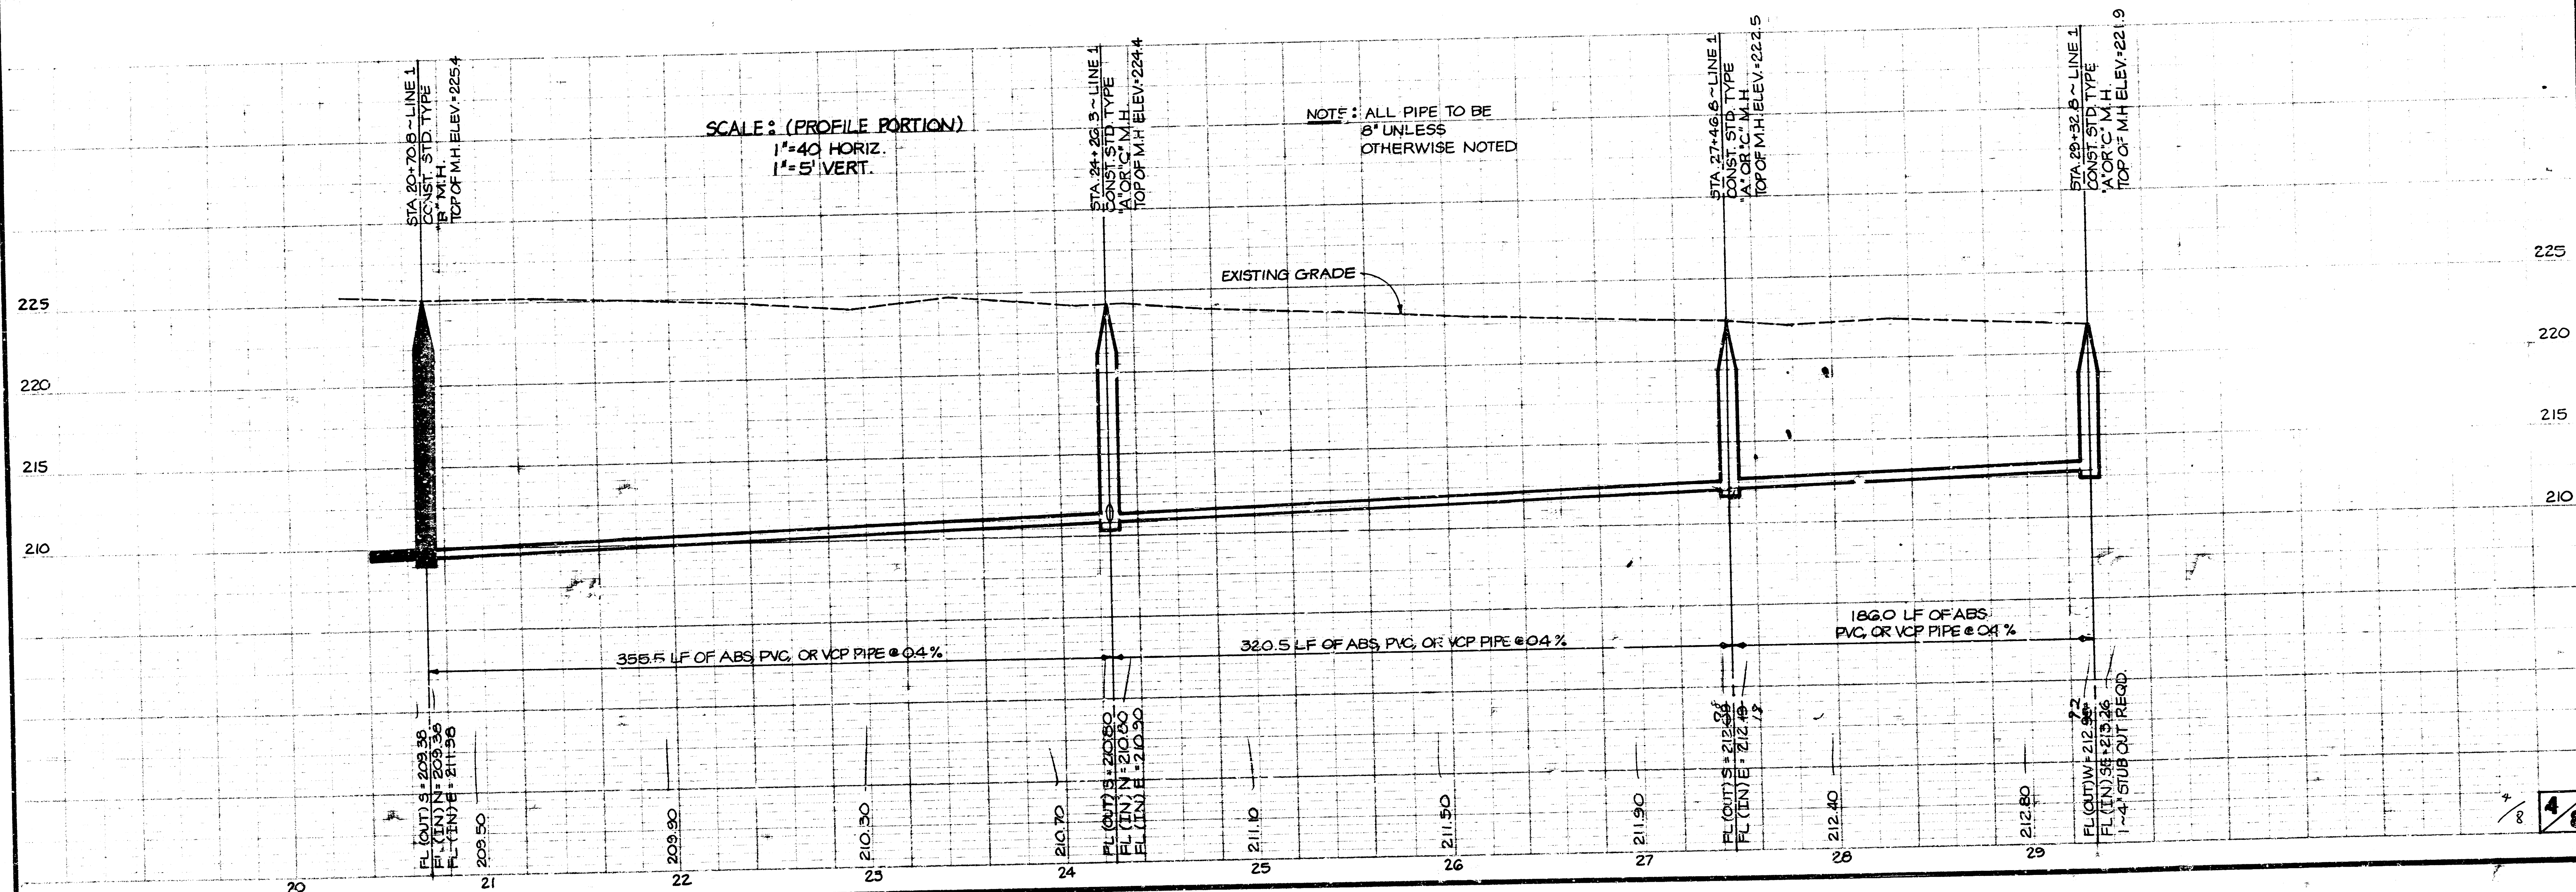
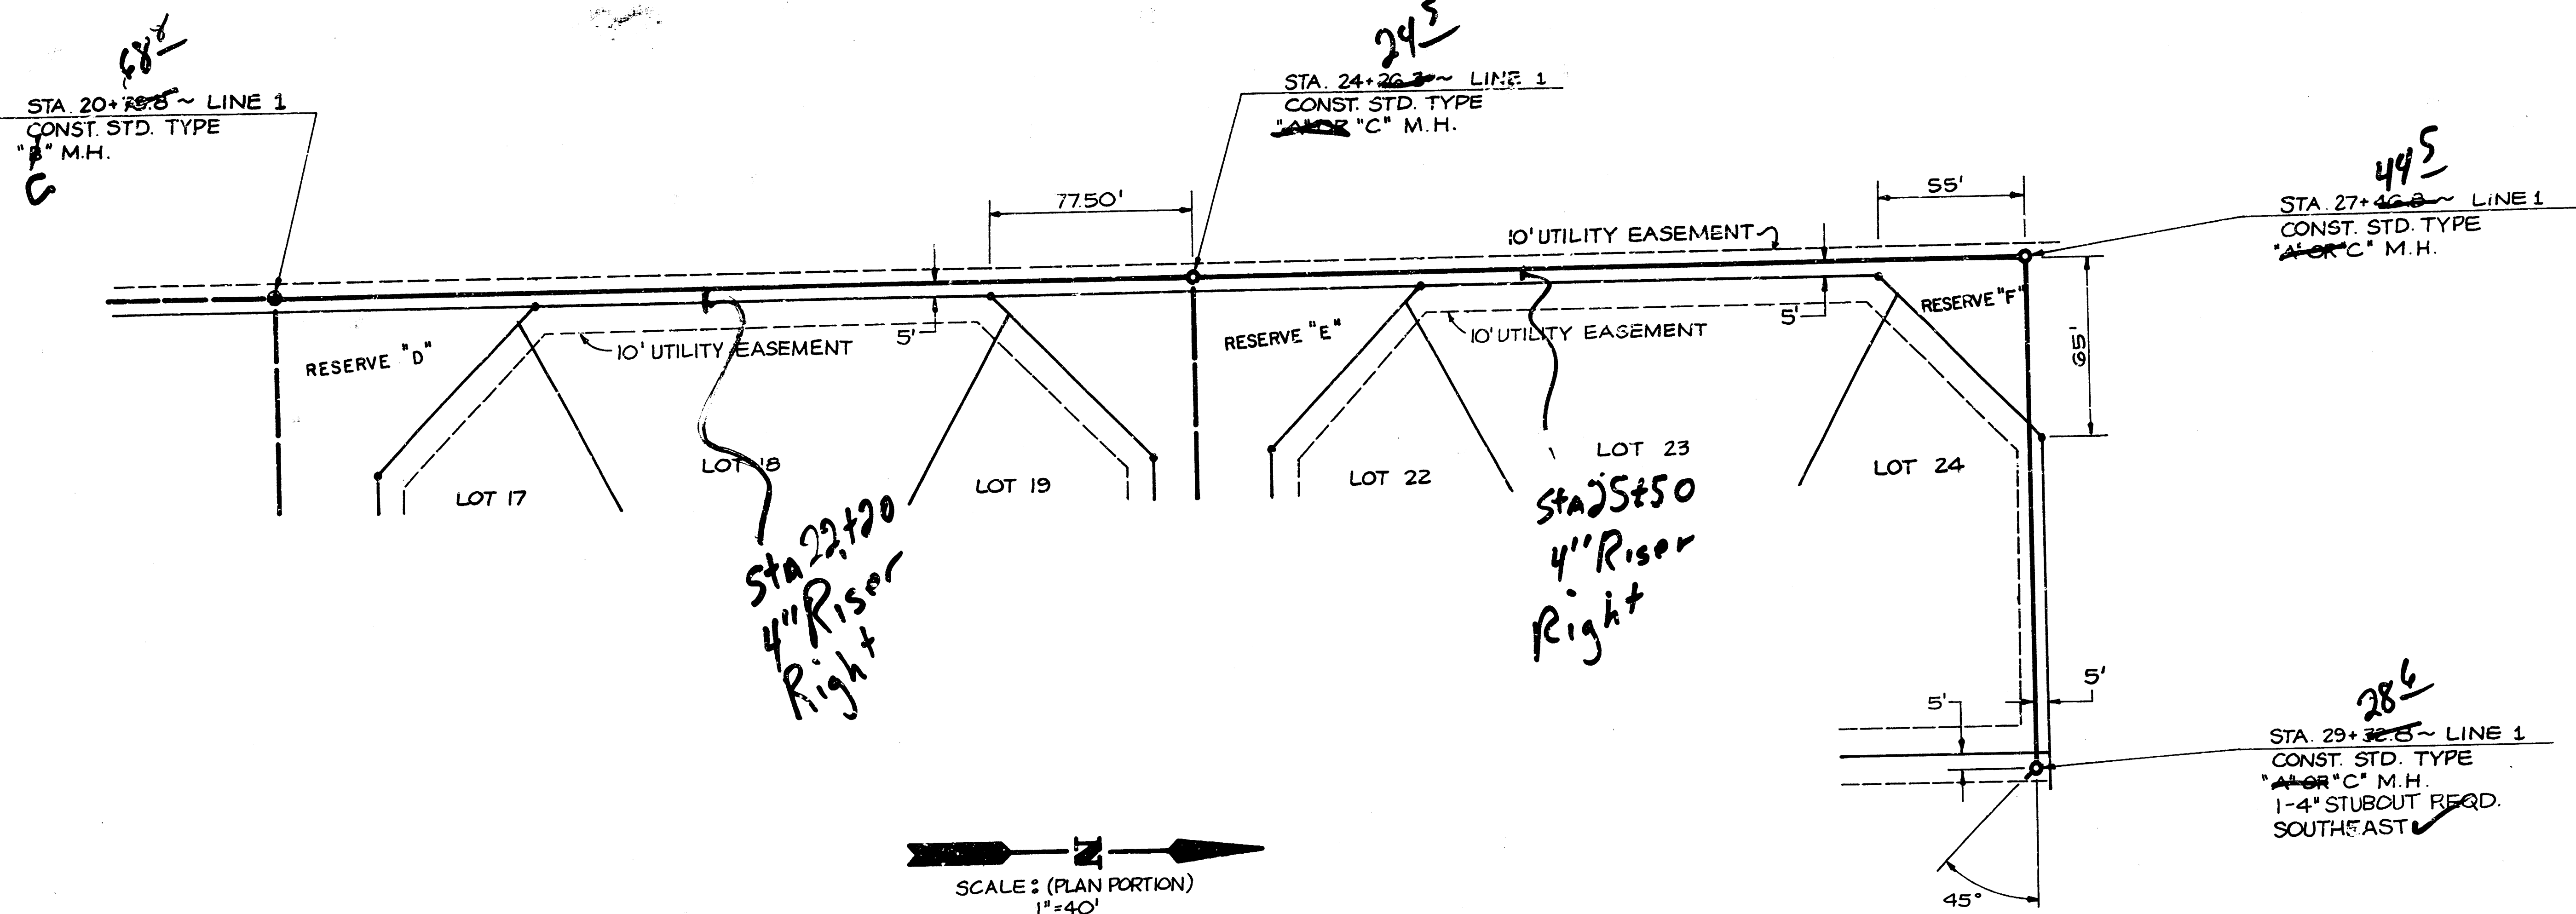


PLUMTHICKET
LATERAL II, MAIN 22
468-76-245-80979-000-000-001

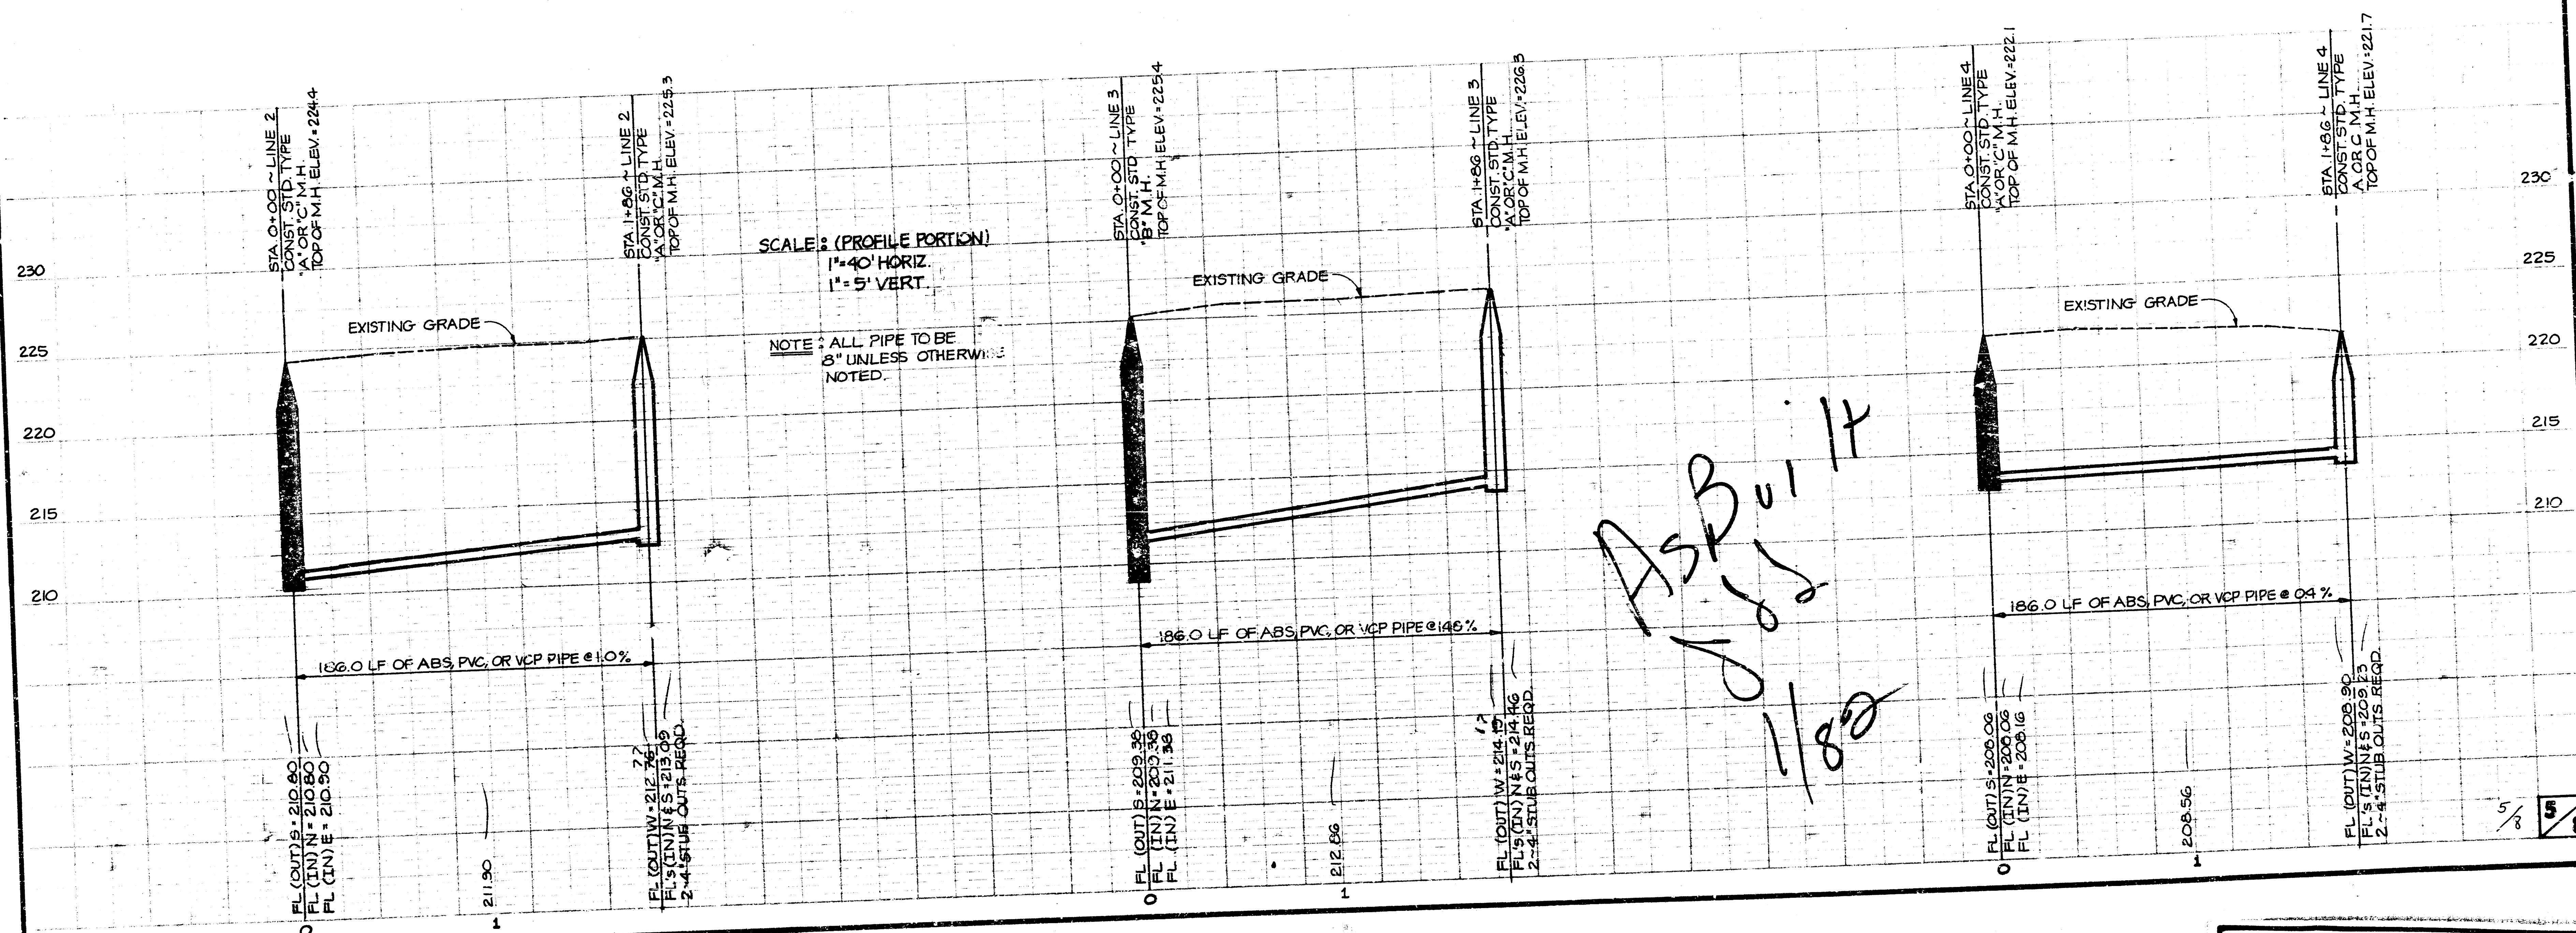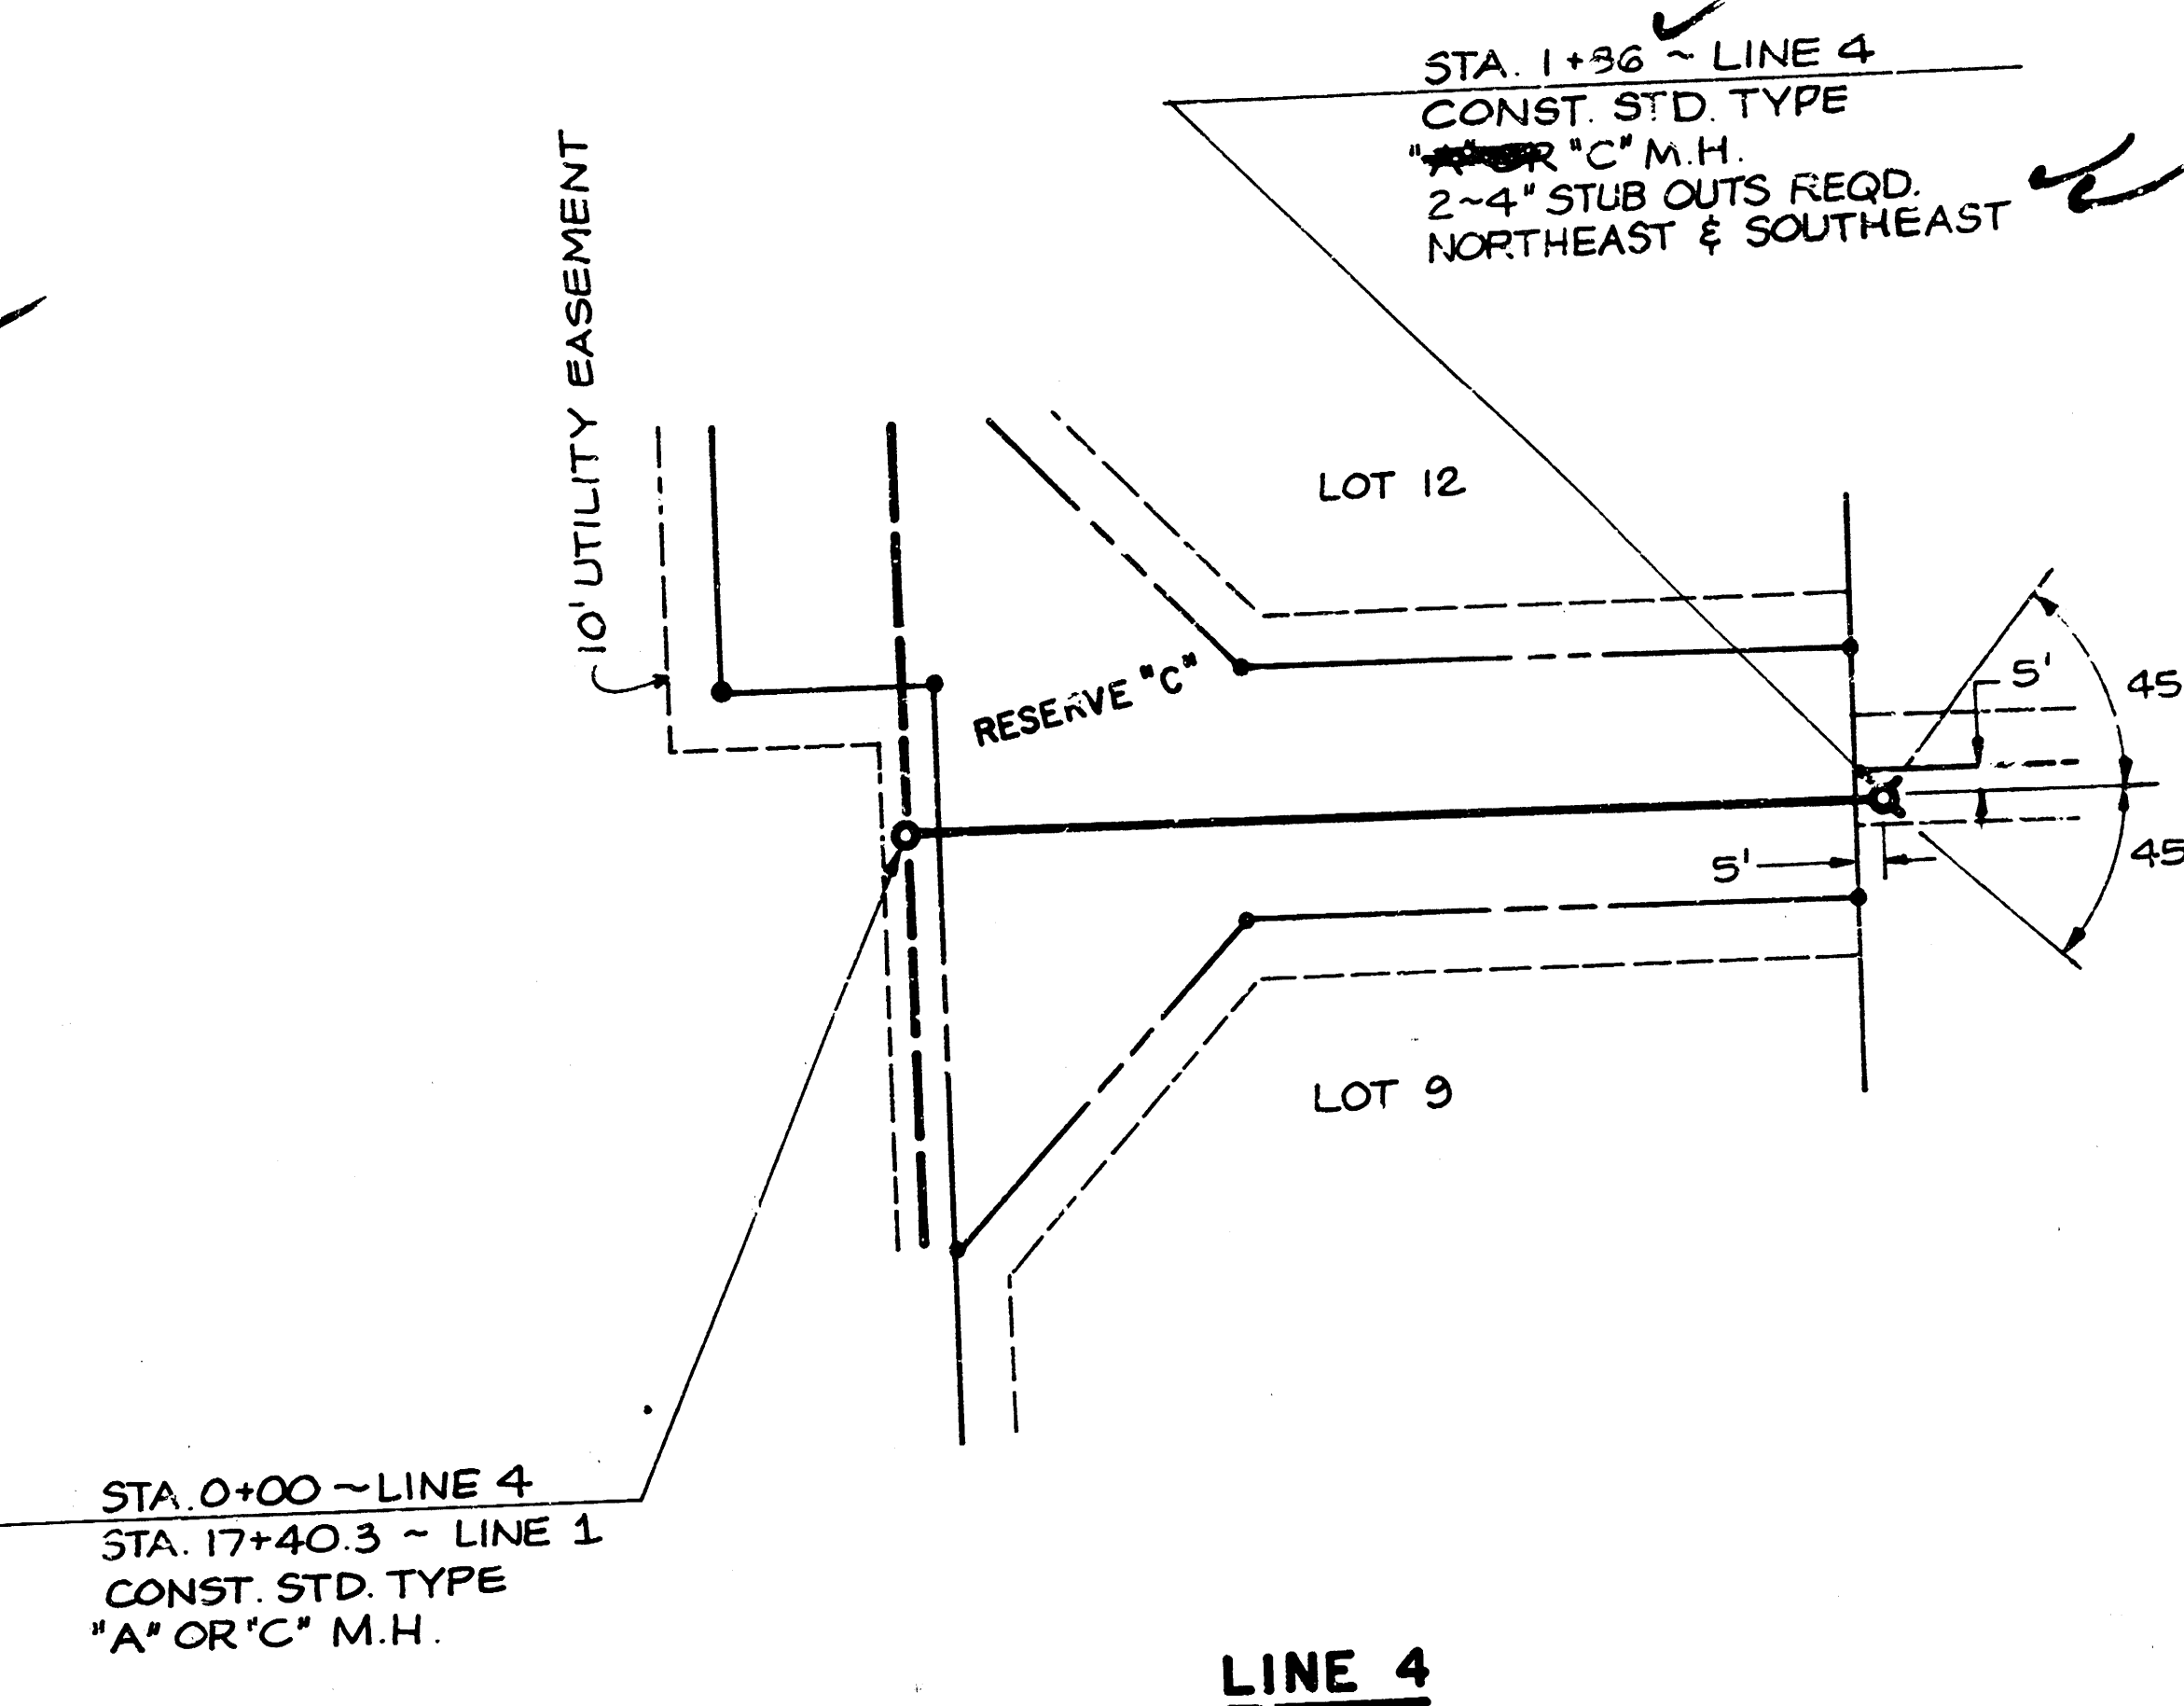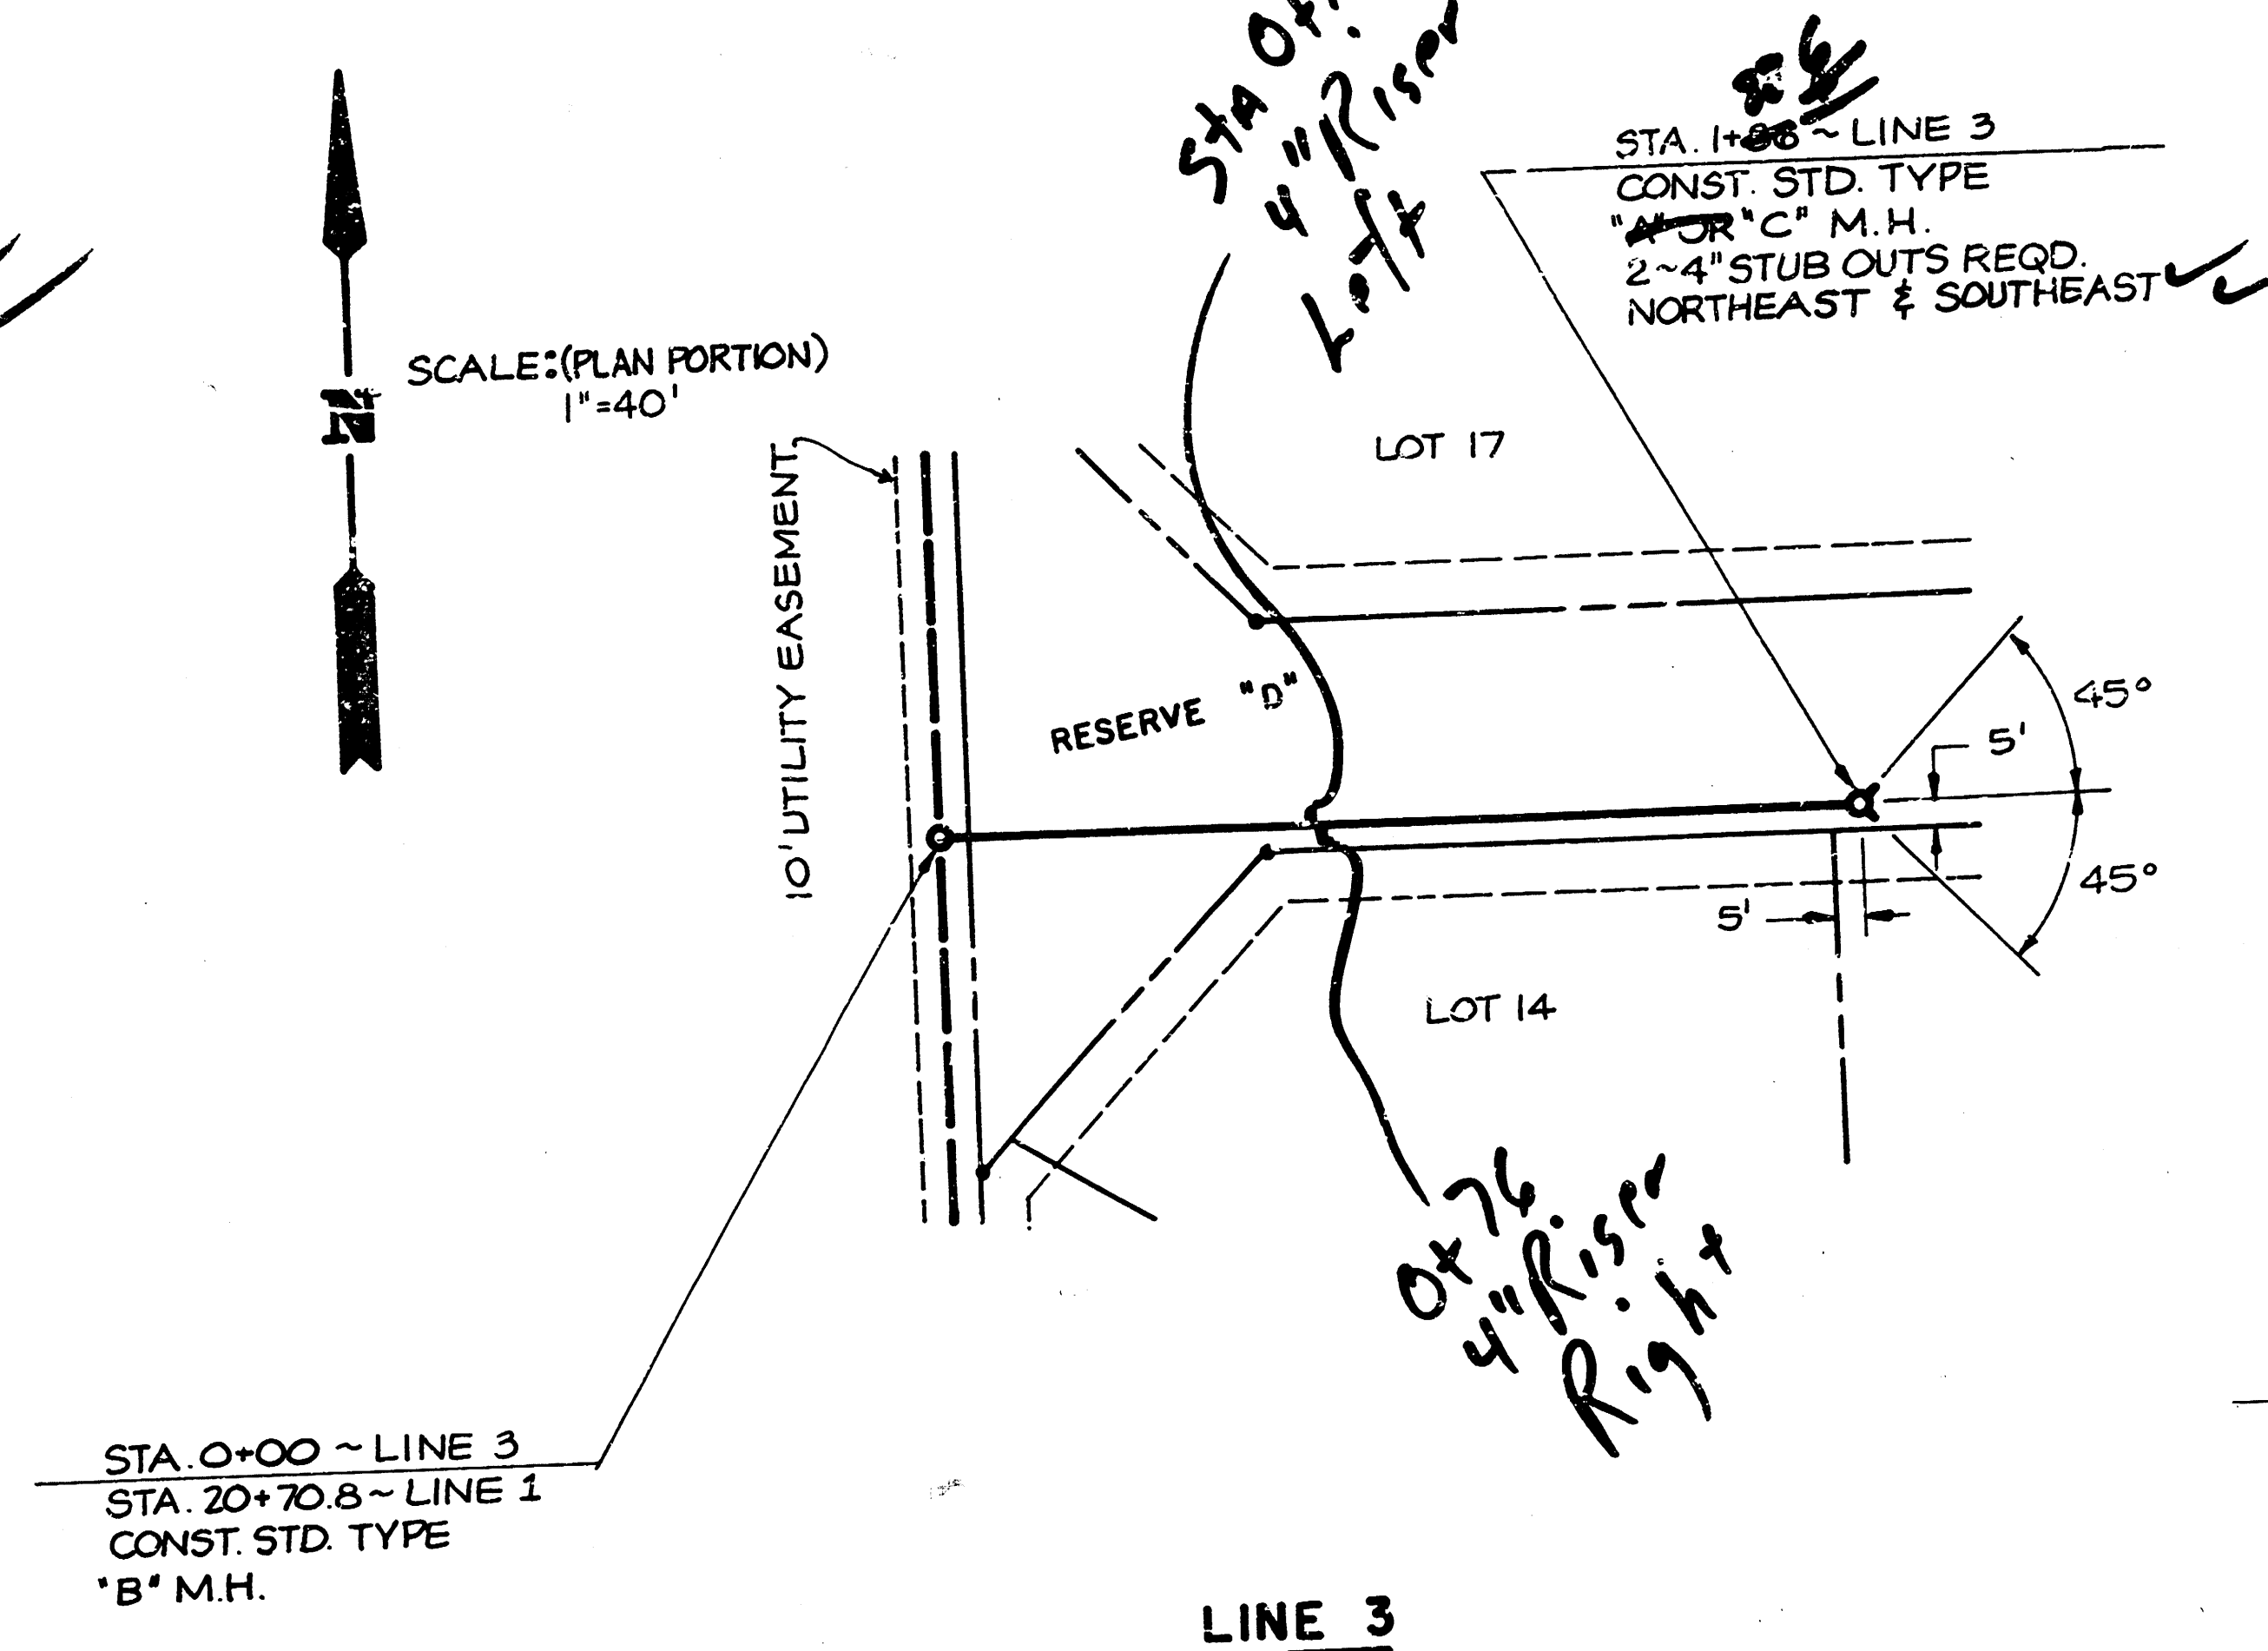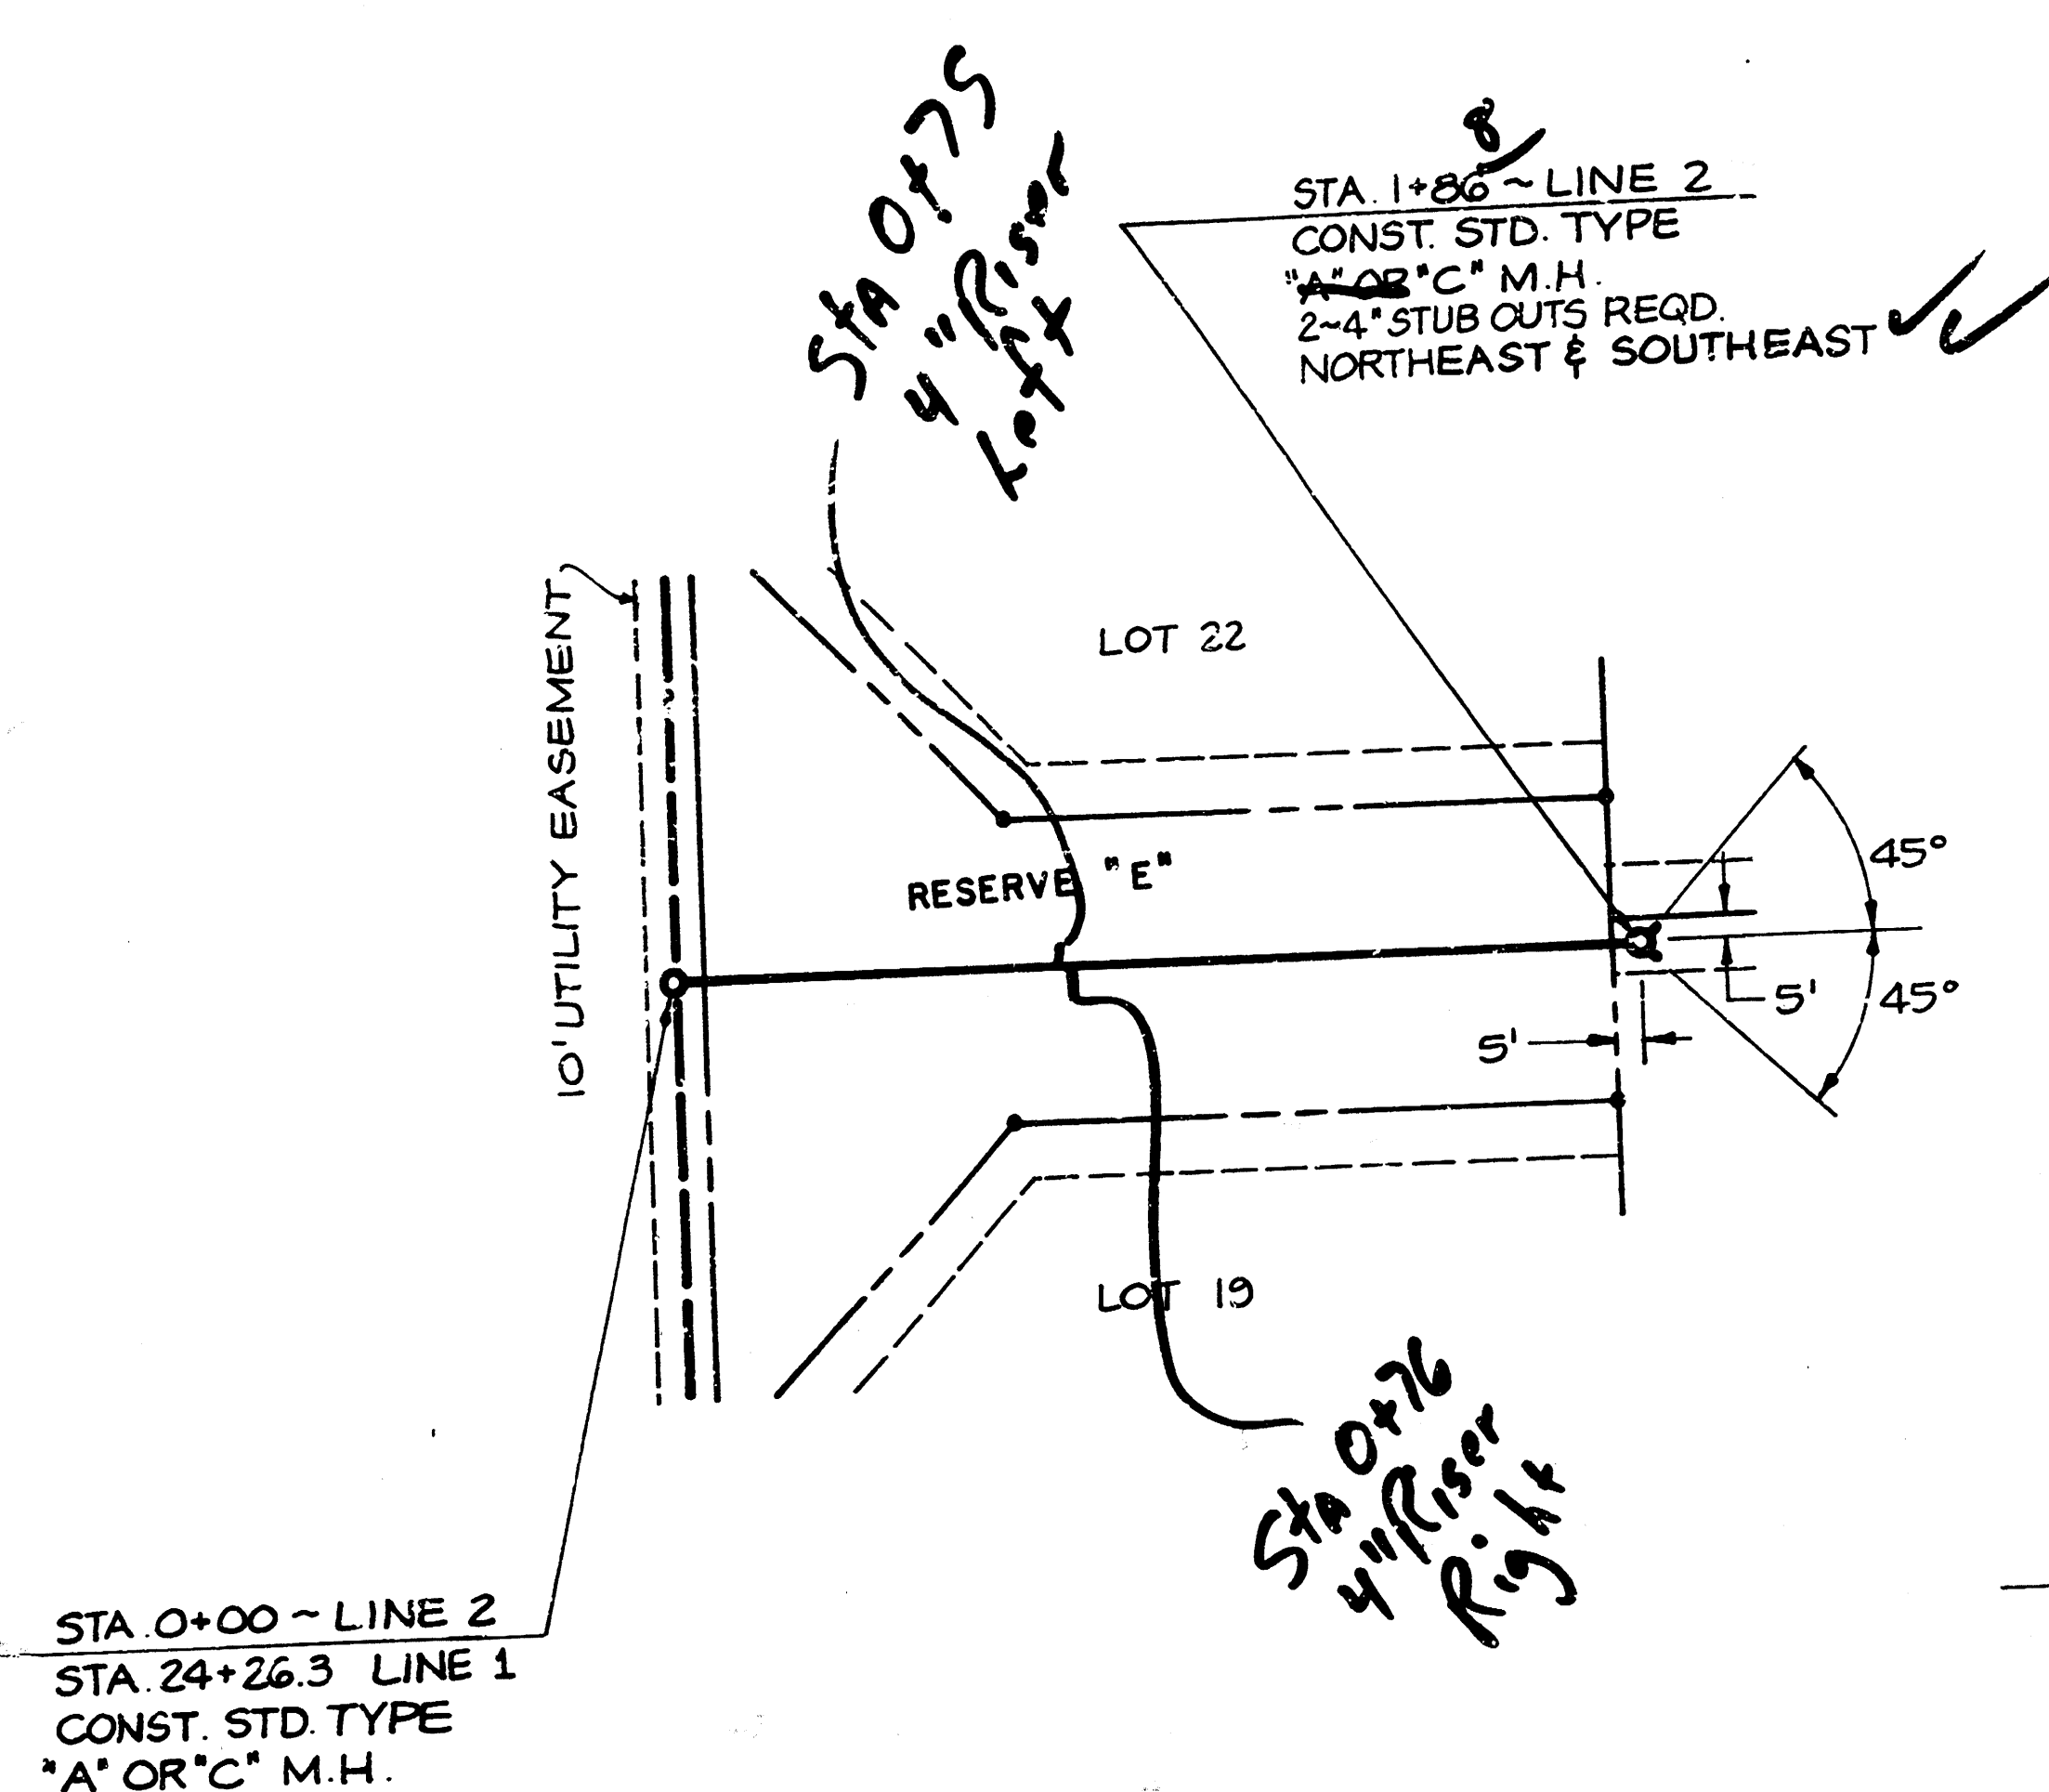


FILMED FROM THE BEST
AVAILABLE COPY....



PLUMTHICKET
LATERAL 11, MAIN 22
468-76-245-80979-000-000-001

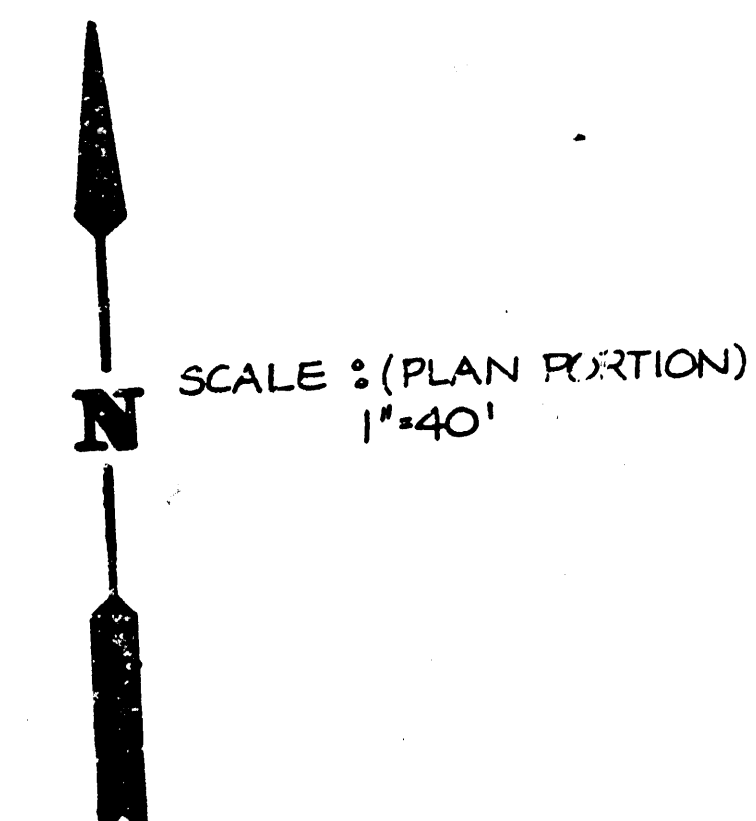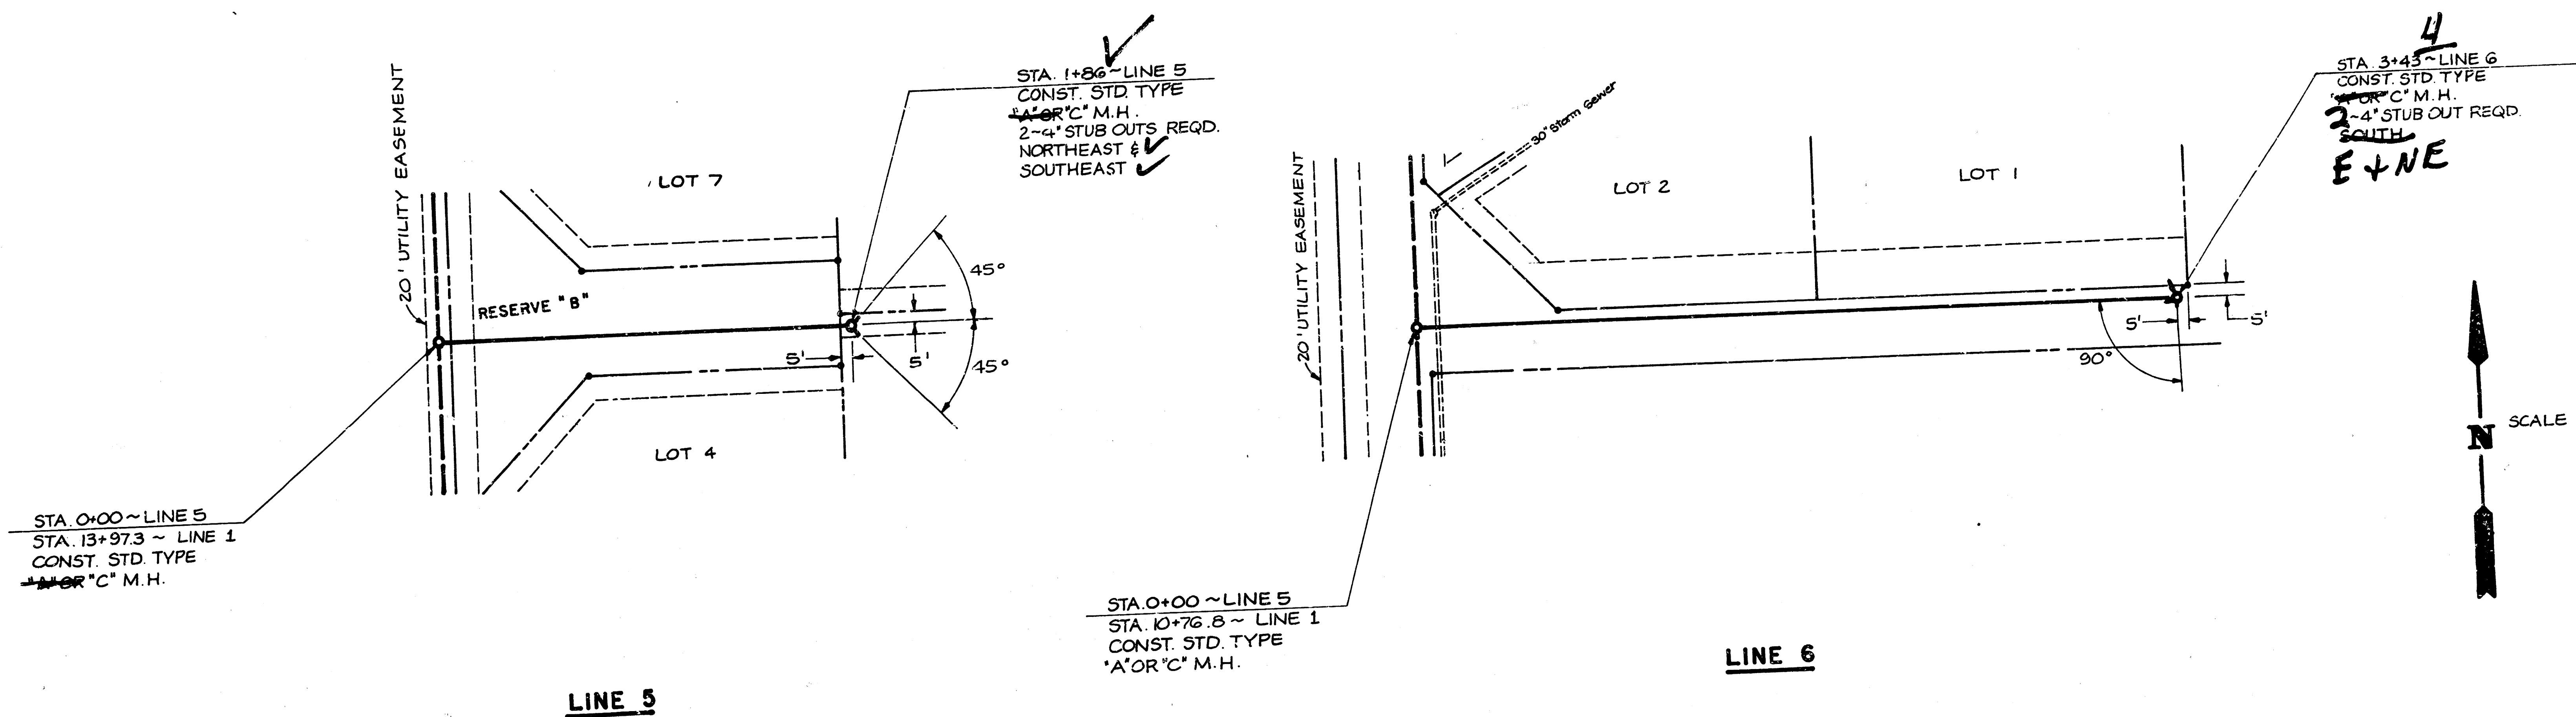

SCALE: (PROFILE PORTION)
1"=40' HORIZ.
1"=5' VERT.

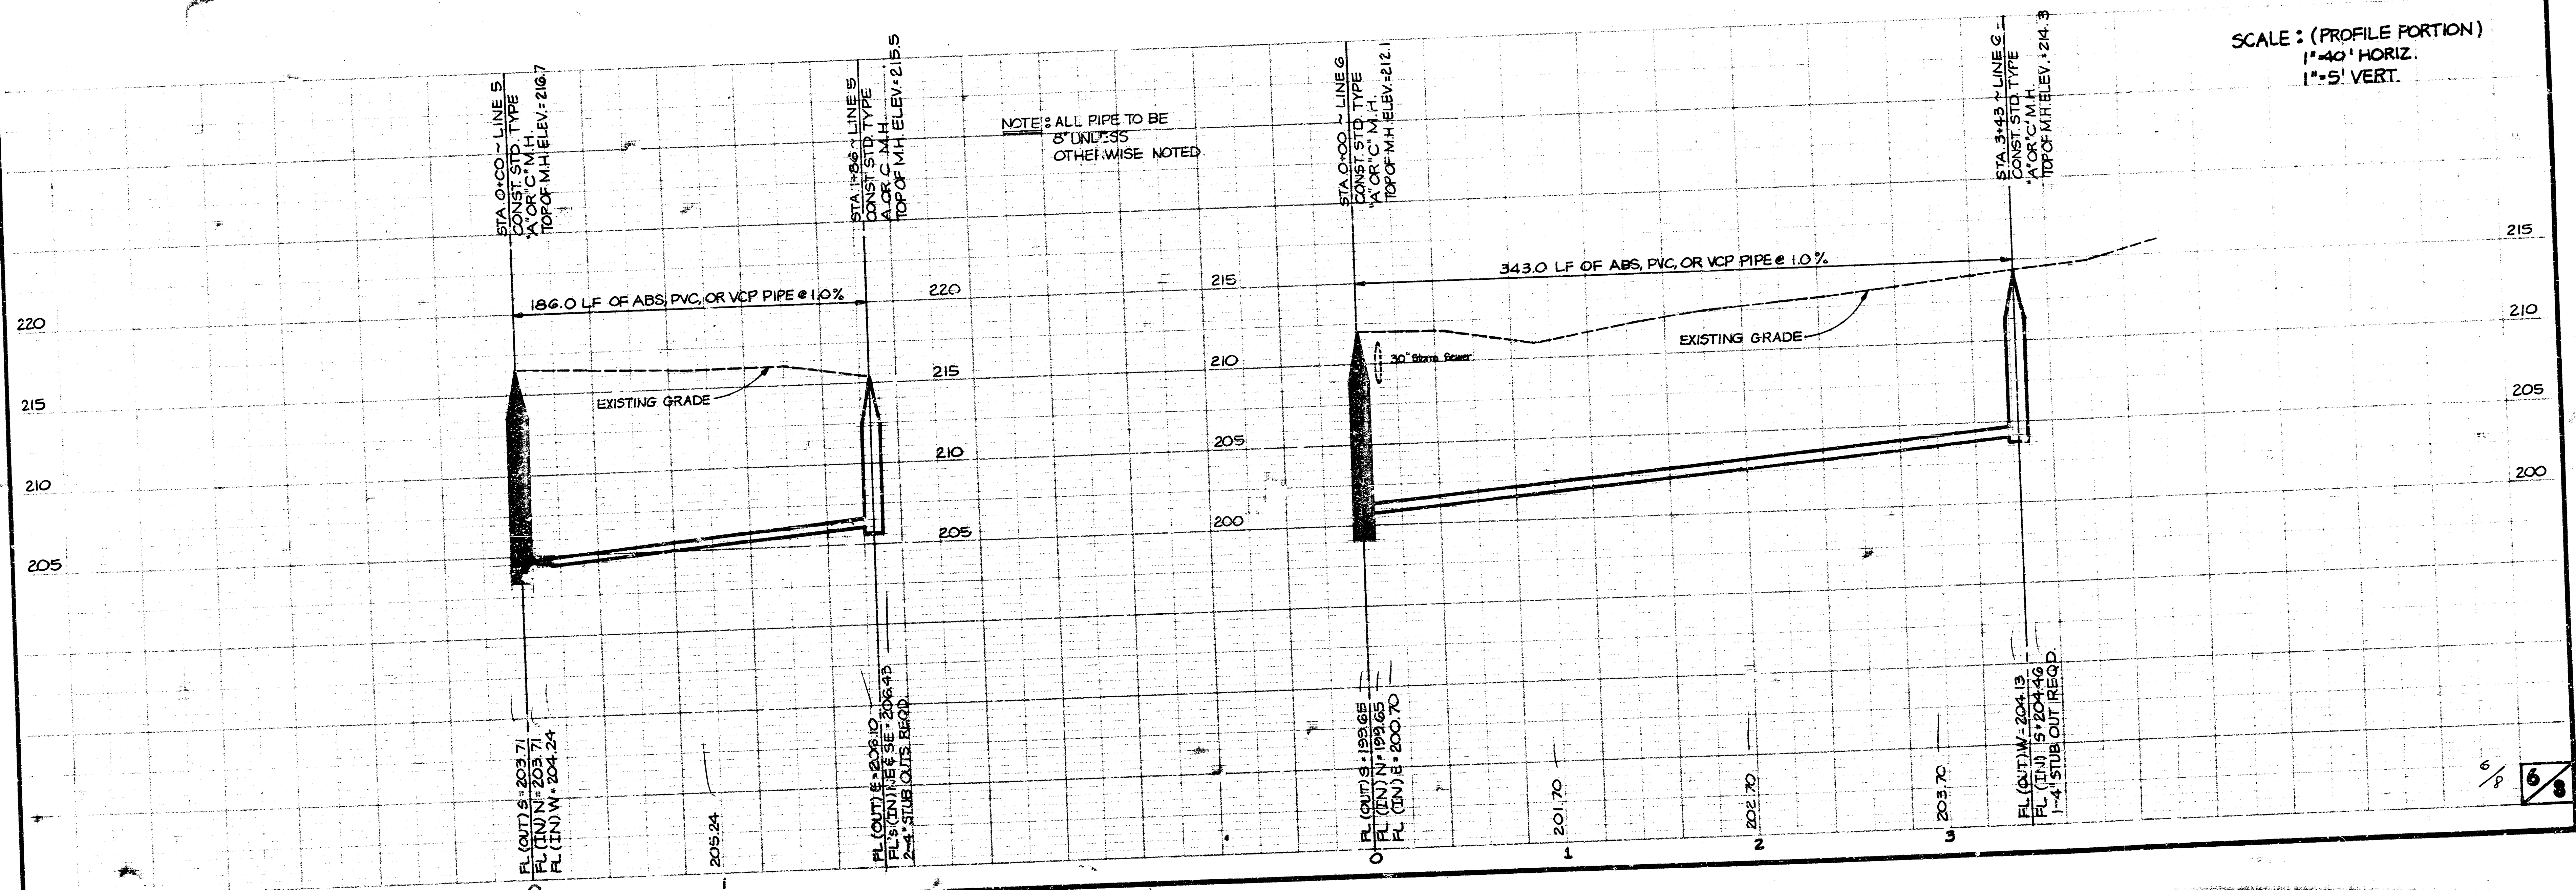

PLUMTHICKET
 LATERAL 11, MAIN 22
 468-76-245-80979-000-000-001

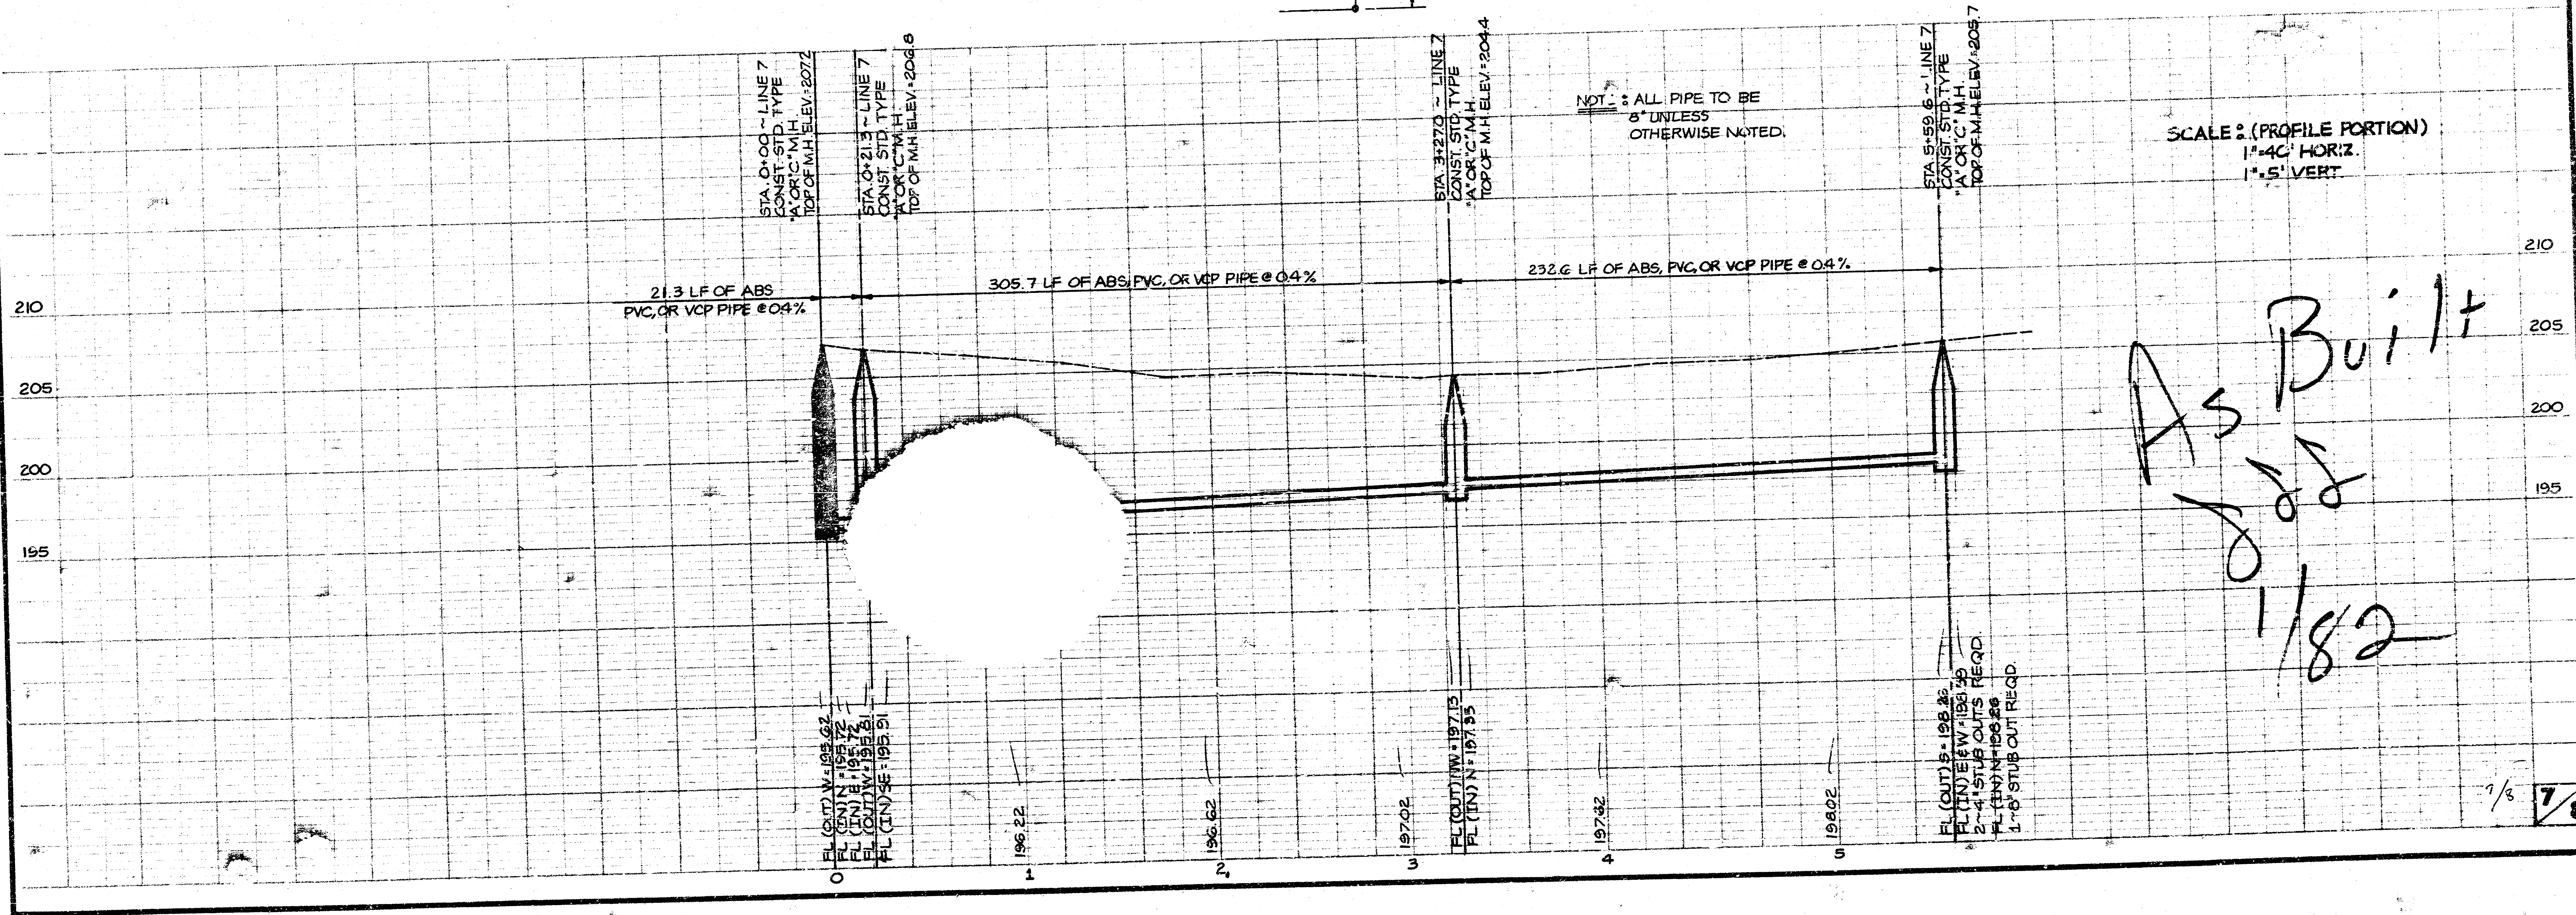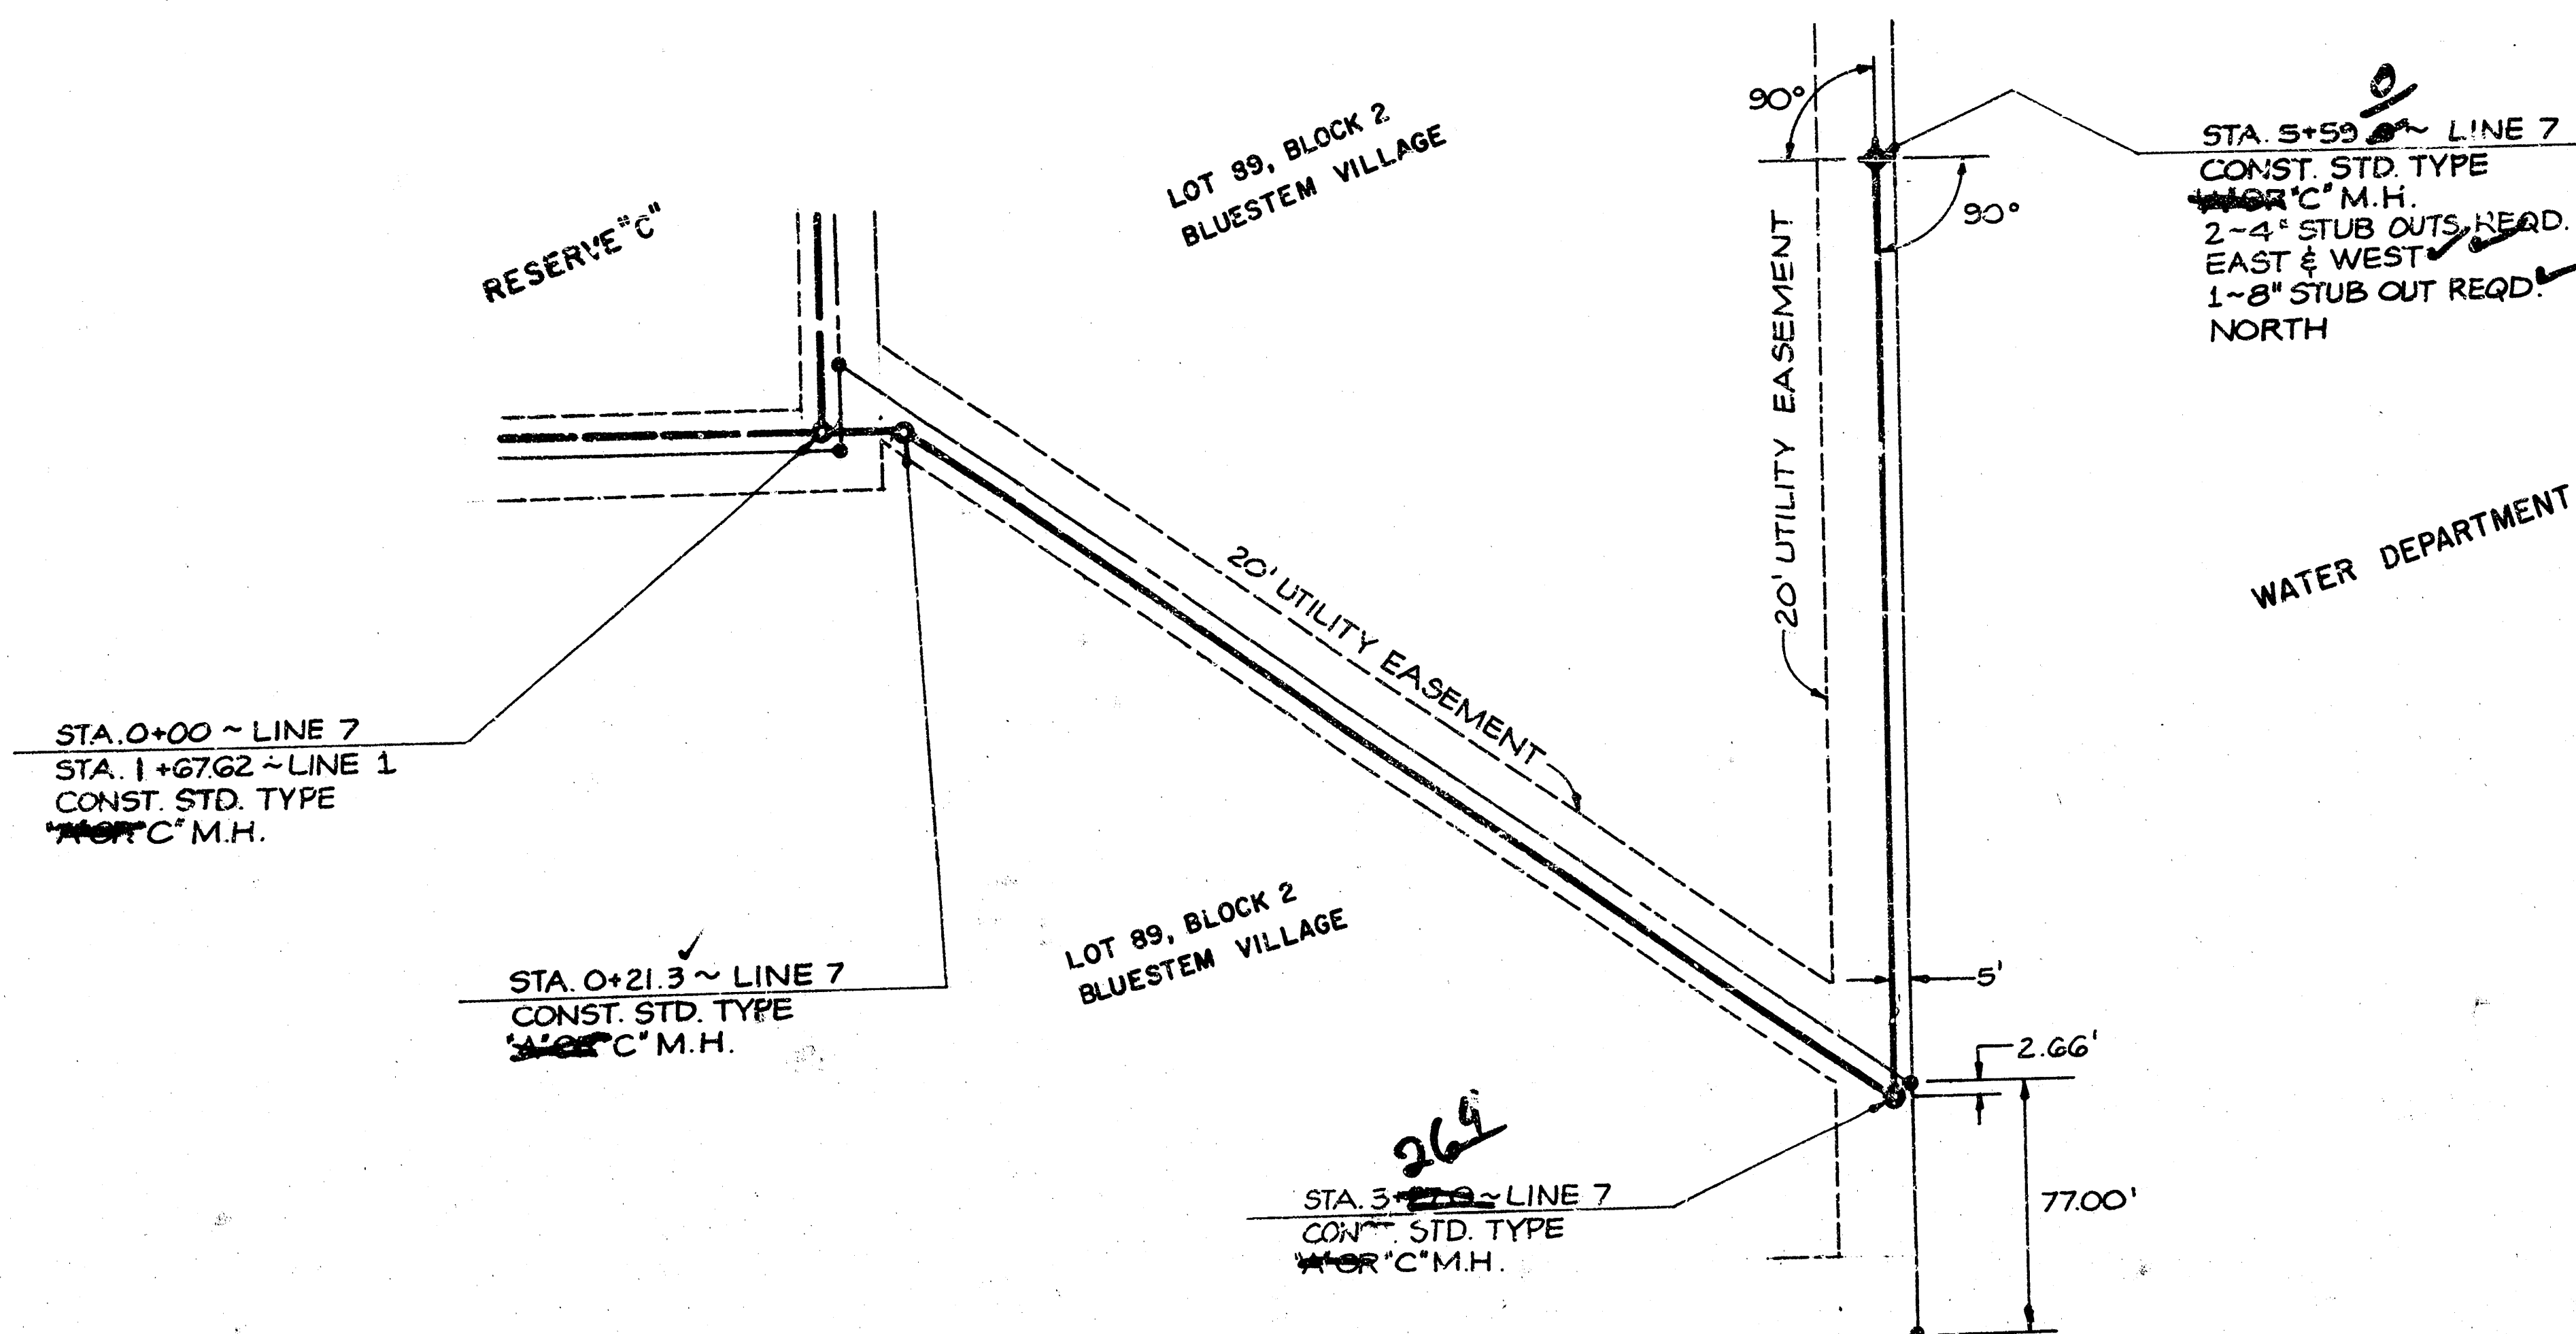

PLUMTHICKET
LATERAL 11, MAIN 22
468-76-245-80979-000-000-001

