
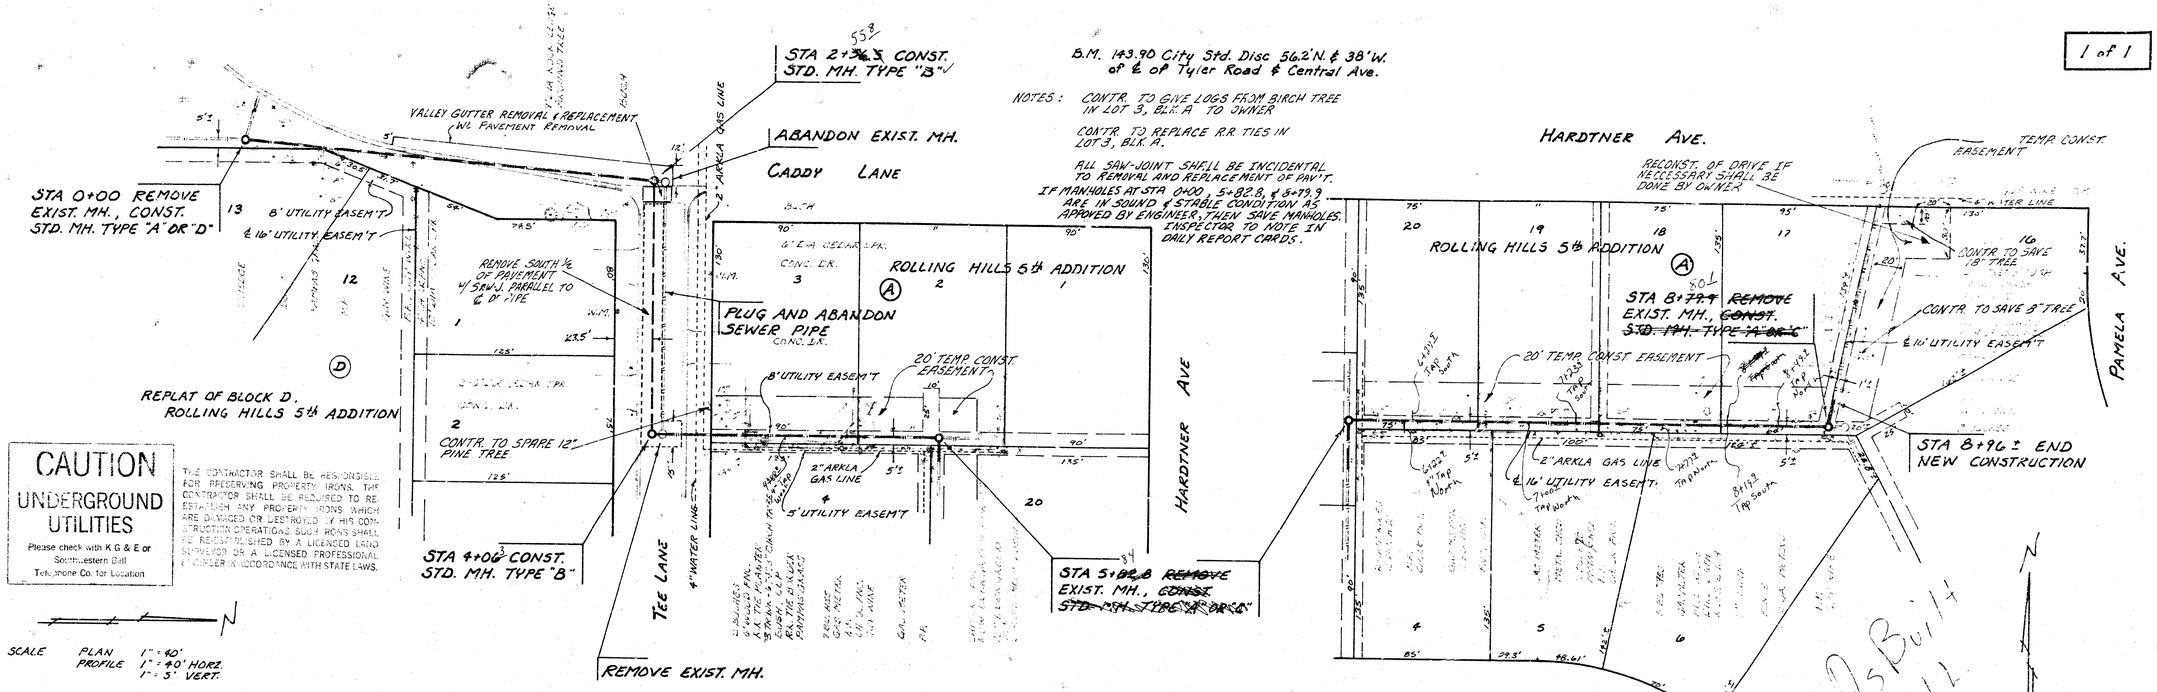


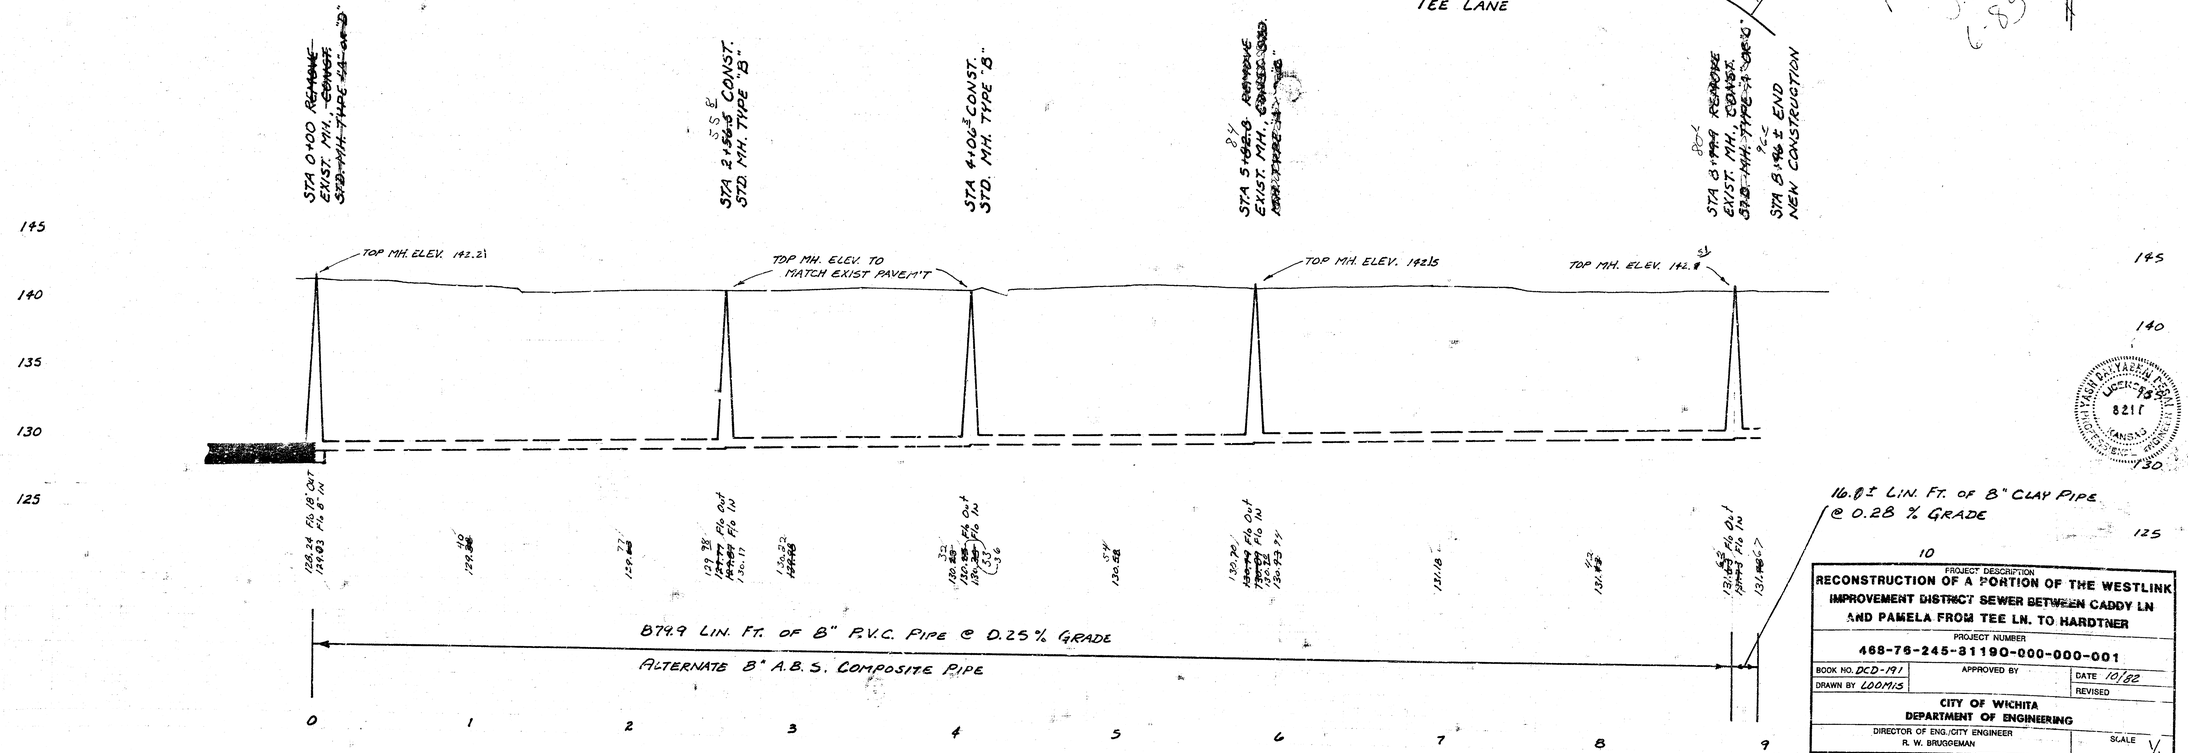

PROJECT DESCRIPTION
RECONSTRUCTION OF A PORTION OF THE WESTLINK IMPROVEMENT DISTRICT SEWER BETWEEN CADDY LN AND PAMELA FROM TEE LN. TO HARDTNER

PROJECT NUMBER
468-76-245-31190-000-000-001

BOOK NO. DCD-191 | APPROVED BY | DATE 10/82
DRAWN BY LOOMIS | REVISED

CITY OF WICHITA
DEPARTMENT OF ENGINEERING

DIRECTOR OF ENG./CITY ENGINEER
R. W. BRUGGEMAN

SCALE 1" = 40'

ASB Built 6-83

LICENSED PROFESSIONAL ENGINEER
8211
KANSAS