


B.M. 139.33 1" cut on E. End S. Hubbard R.C.B.C. 1/2 Mi. West of Tyler Rd. on 13TH

L. Krueger
D. Chalmers

CAUTION
UNDERGROUND
UTILITIES

CAUTION
UNDERGROUND
UTILITIES

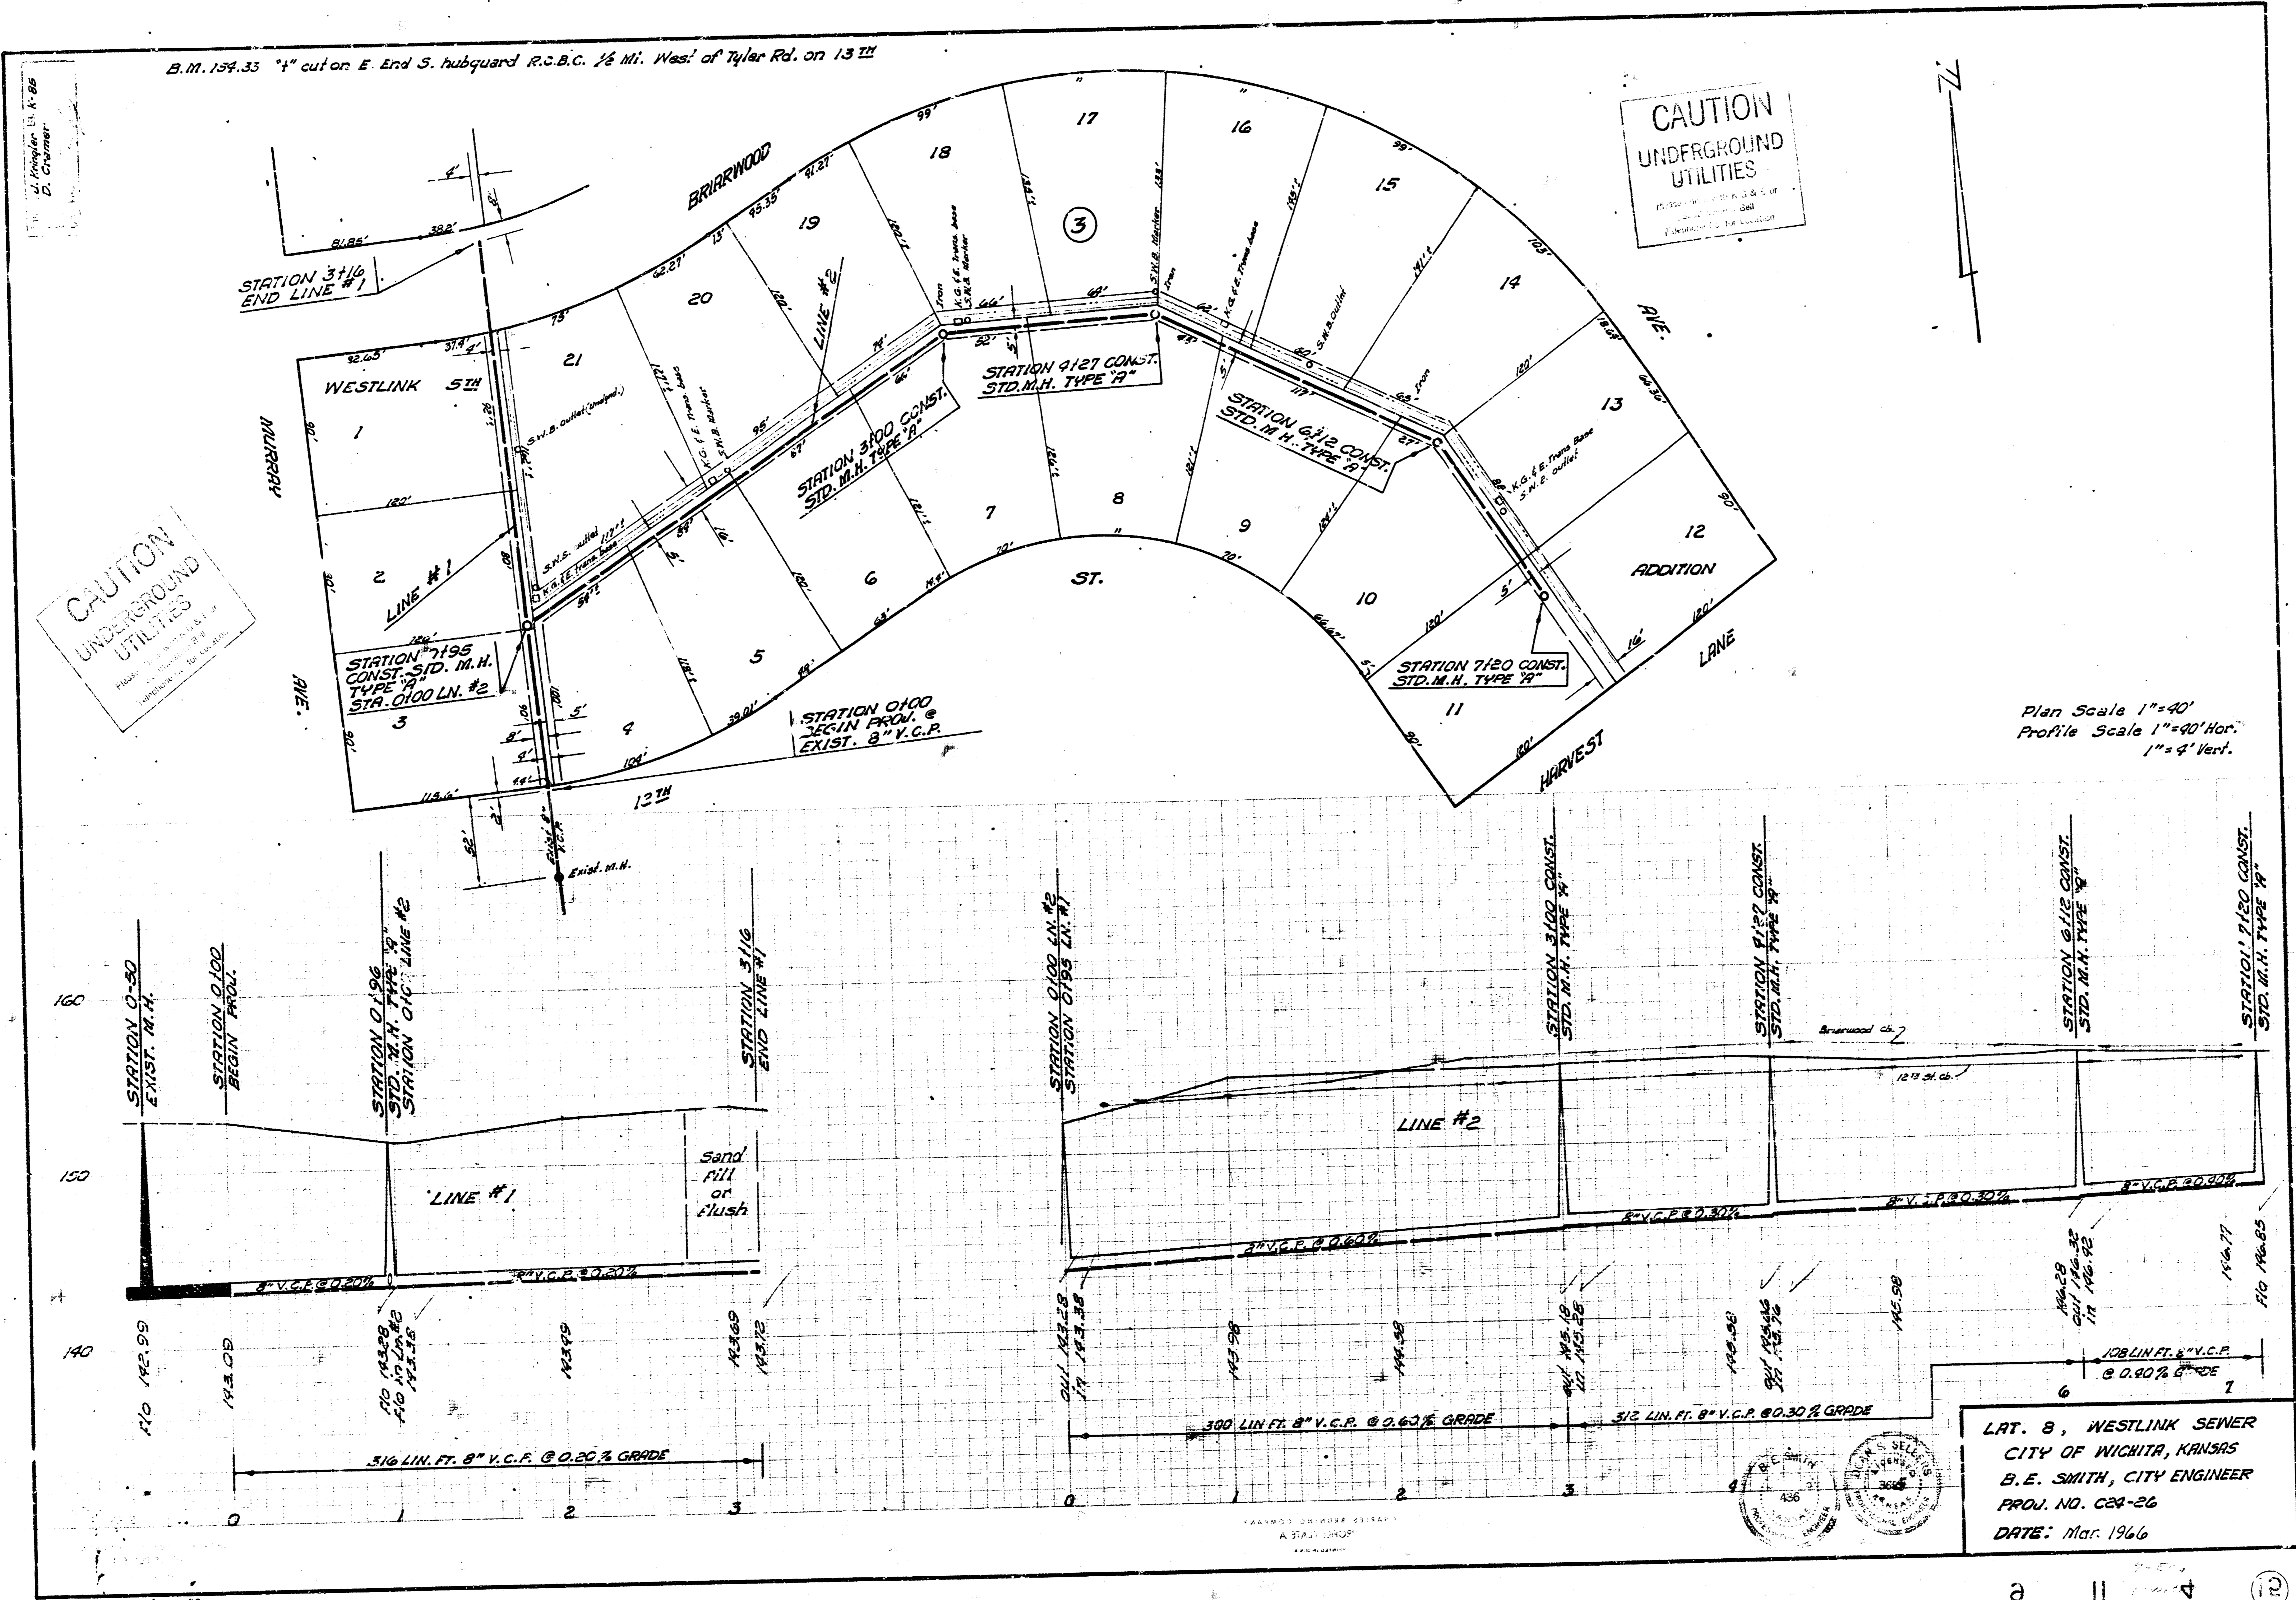

Plan Scale 1"=40'
Profile Scale 1"=40' Hor.
1"=4' Vert.

LAT. B, WESTLINK SEWER
CITY OF WICHITA, KANSAS
B.E. SMITH, CITY ENGINEER
PROJ. NO. C24-26
DATE: Mar. 1966