Plan Scale 1" = 40'
Profile Scale 1" = 40' Horz.
1" = 4' Vert.

B. M. 150.19 "a" cut top west curb Dunsworth at S. L. Emerson.

T. P. 151.97 W. Rim M.H. Sta. 0+00.0 Lat. 48, Westlink Sewer. C28-68

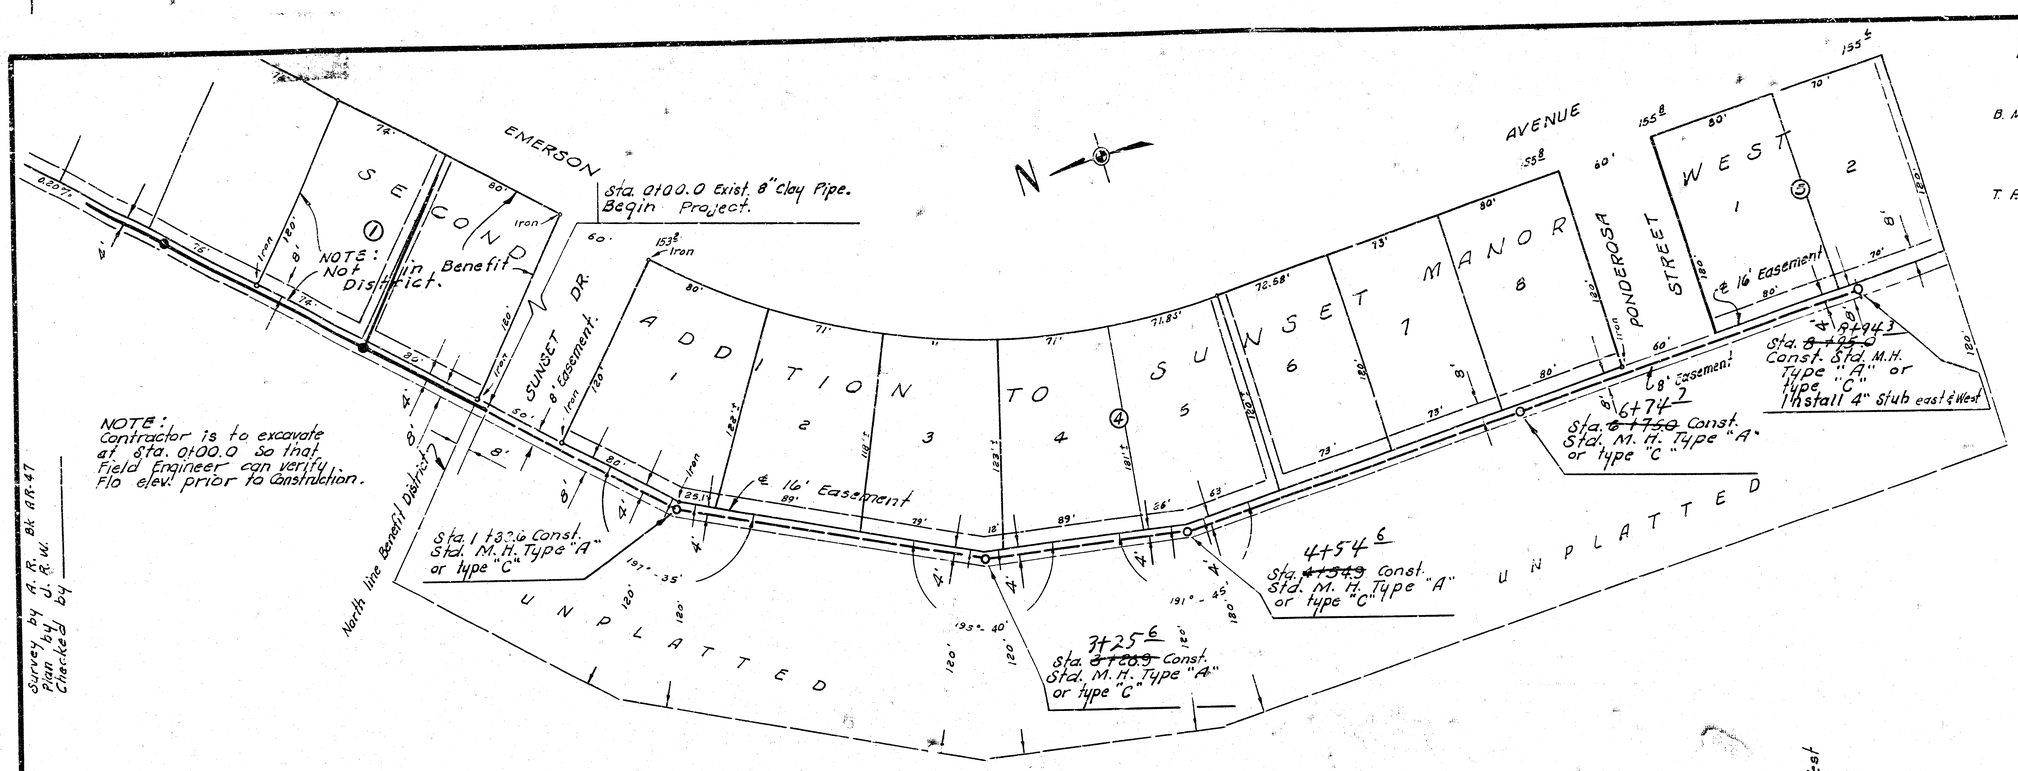

Survey by A. R. Bk AR-47
Plan by J. R. W.
Checked by

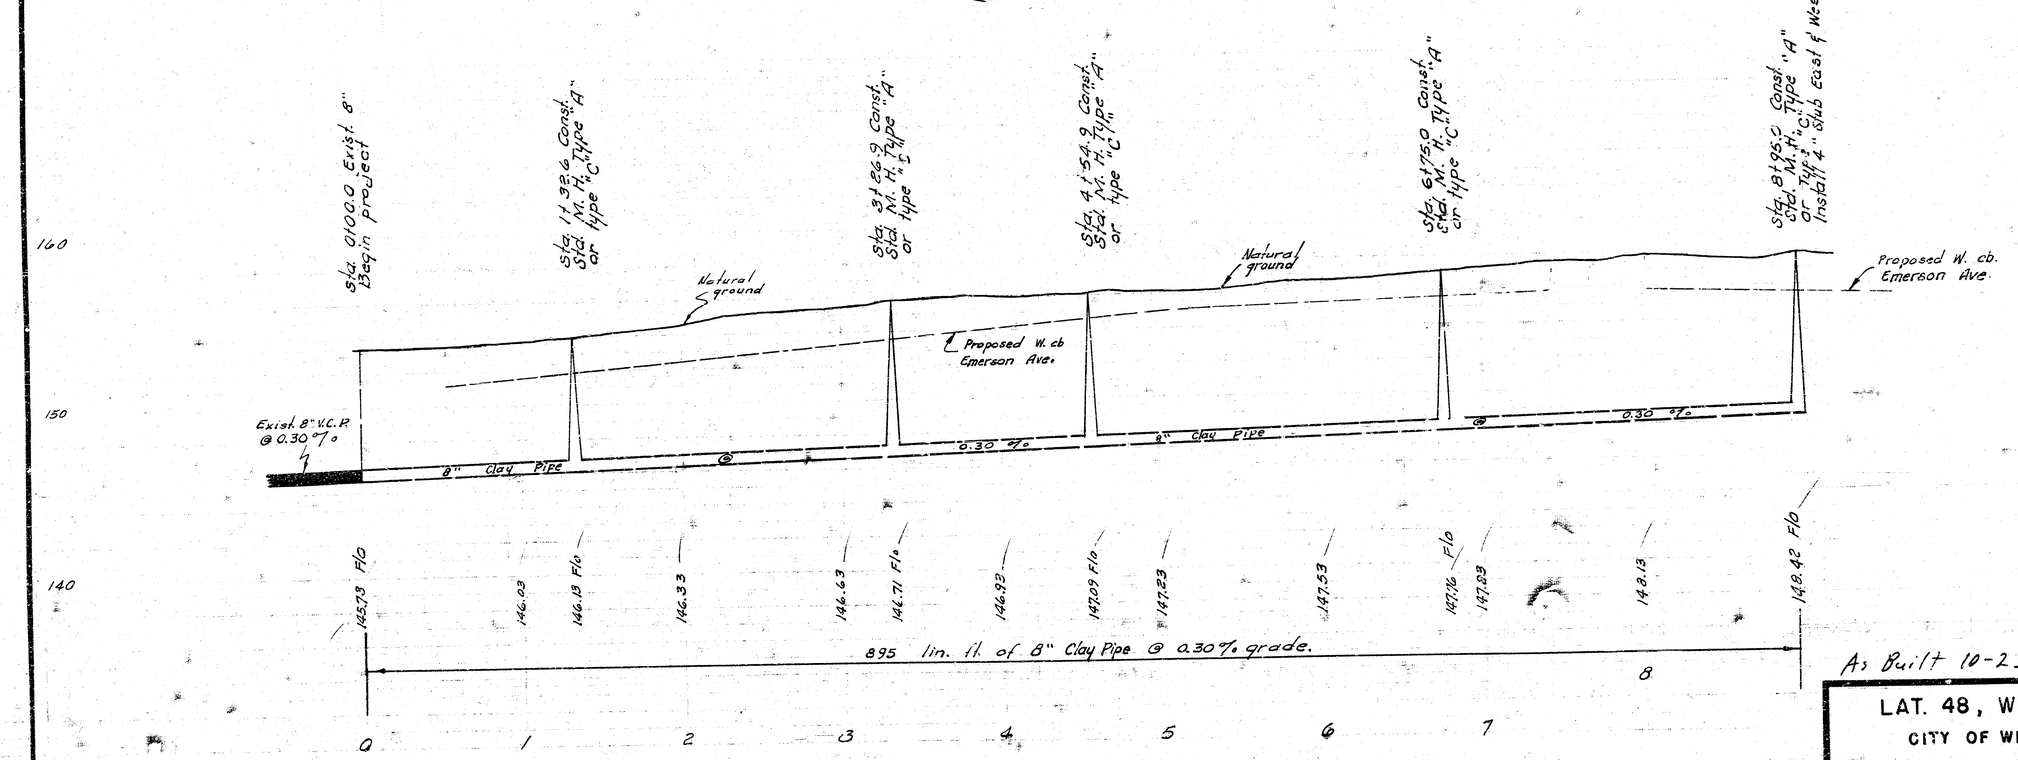

As Built 10-23-75

LAT. 48, WESTLINK SEWER
CITY OF WICHITA, KANSAS
R. W. LINN — CITY ENGINEER
DATE: Feb 75 PROJECT NO. DBKL5 68066