

B.M.: 1679' STANDARD N.E. TYLER ROAD & 13TH STREET.
B.M.: 1600' 'X' IN MID KANSAS. Cfr 9' Conc Walk North. N.E. Cor HARVEST LANE & HARVEST CT. opposite house #8991 HARVEST LN.

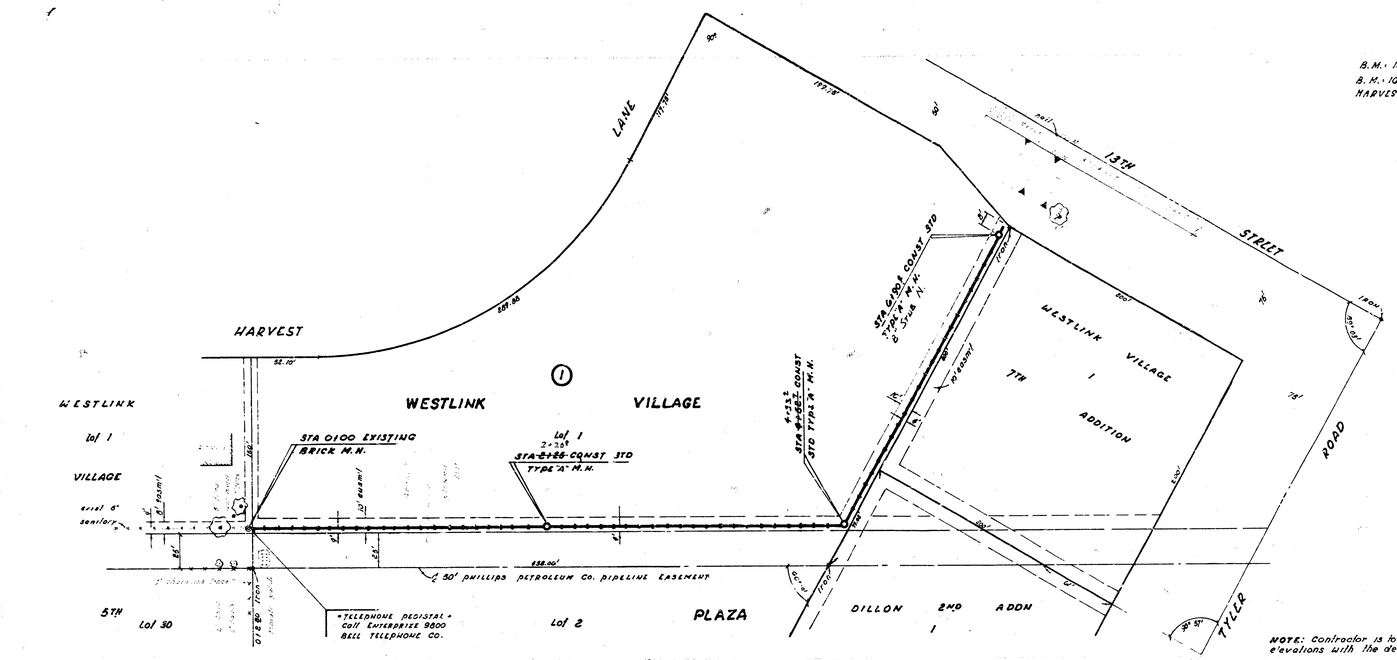

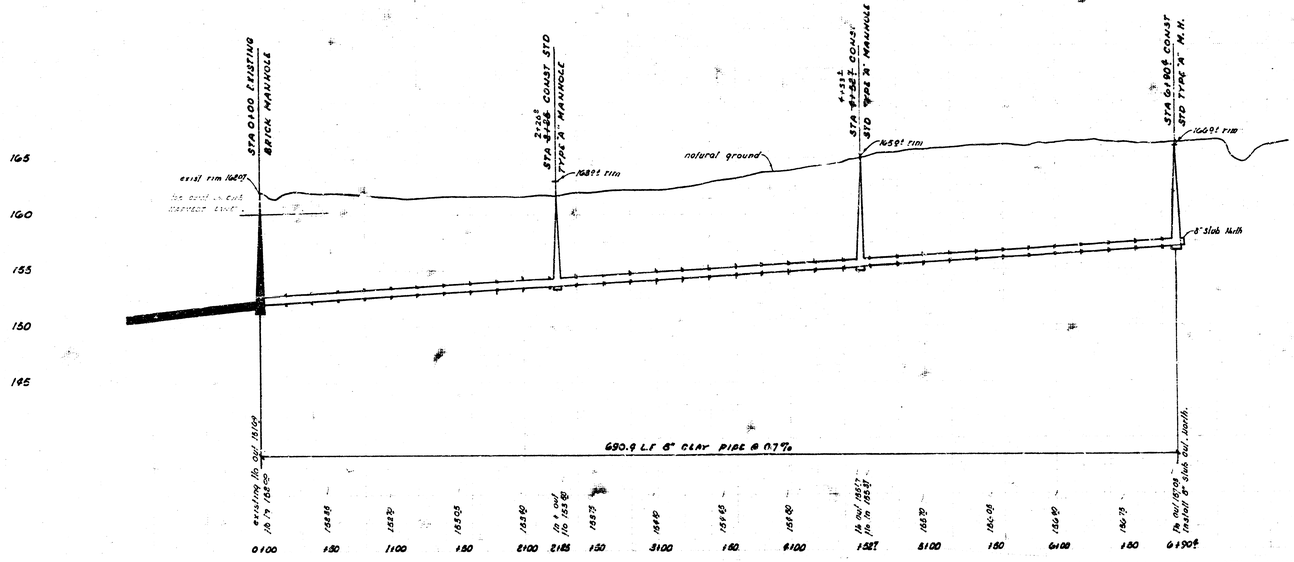

"As Built" Final Measurements 11-102

LATERAL S1, WESTLINK SEWER.
CITY OF WICHITA, KANSAS
R.W. LINN CITY ENGINEER
DATE: OCT. 1972 PROJ. No. DAKL 5GB087