B.M.: 1679' STANDARD N.E. TYLER ROAD & 13TH STREET.
B.M.: 1600$ "X" in MID KANSAS. c/r 4' conc walk North. N.E. cor HARVEST LANE & HARVEST CT. opposite House #8981 HARVEST LN.

N

HARVEST LANE

13TH STREET

TYLER ROAD

WESTLINK VILLAGE 7TH ADDITION

WESTLINK VILLAGE ①

Lot 1

Lot 2

Lot 30

5TH

PLAZA

DILLON 2ND ADDN

STA 0100 EXISTING BRICK M.H.

STA 2+28 CONST STD TYPE "A" M.H.

STA 4+33± CONST STD TYPE "A" M.H.


STA 6+90± CONST STD TYPE "A" M.H.

50' PHILLIPS PETROLEUM CO. PIPELINE EASEMENT

"TELEPHONE PEDISTAL - Call ENTERPRIZE 9800 BELL TELEPHONE CO.

PLAN SCALE 1" = 40'
PROFILE 1" = 5' VERT
1" = 40' HORZ.

NOTE: Contractor is to verify top of manhole elevations with the developer.

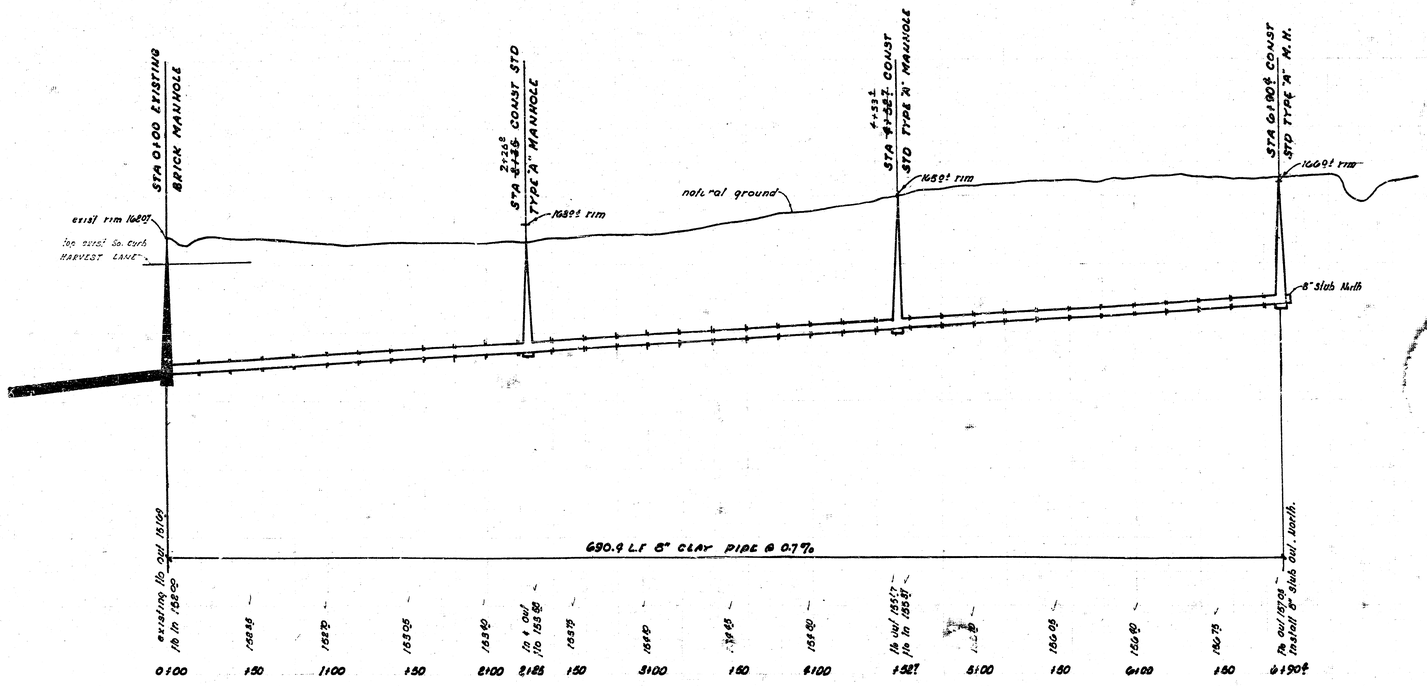

"As Built" Final Measurements K-102

LATERAL 51, WESTLINK SEWER.
CITY OF WICHITA, KANSAS
R.W. LINN CITY ENGINEER
DATE: OCT. 1972 PROJ. No. DSKL 5G8087

DONALD E. SCHNEIDER LICENSED 6311 KANSAS PROFESSIONAL ENGINEER

R.W. LINN LICENSED 3634 KANSAS REGISTERED PROFESSIONAL ENGINEER

JAMES S. SELLERS JR. LICENSED 5623 KANSAS REGISTERED PROFESSIONAL ENGINEER

FILMED FROM THE BEST