

B.M.: 1079.7 STANDARD N.E. CORNER 13TH STREET and TYLER ROAD.
B.M.: 1900.5 "K" in mid KANSAS c/f 4' conc walk N. North East Cor HARVEST COURT and HARVEST LANE opposite 16 # 8991 HARVEST LANE.

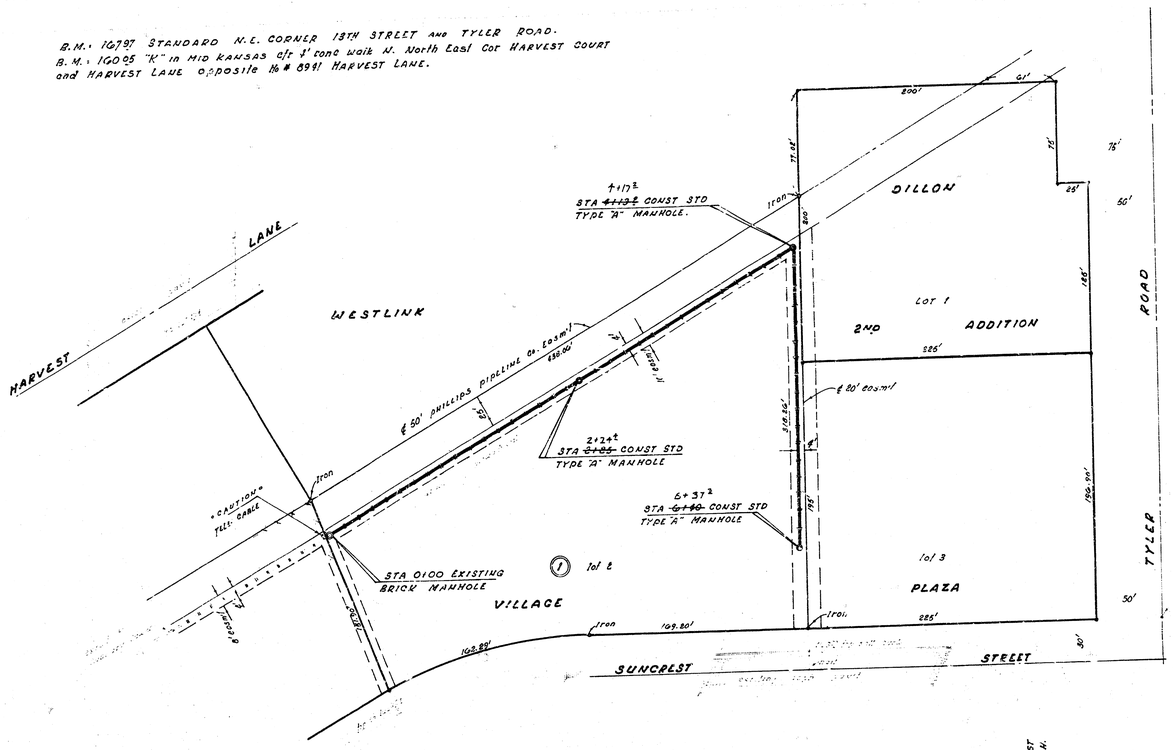

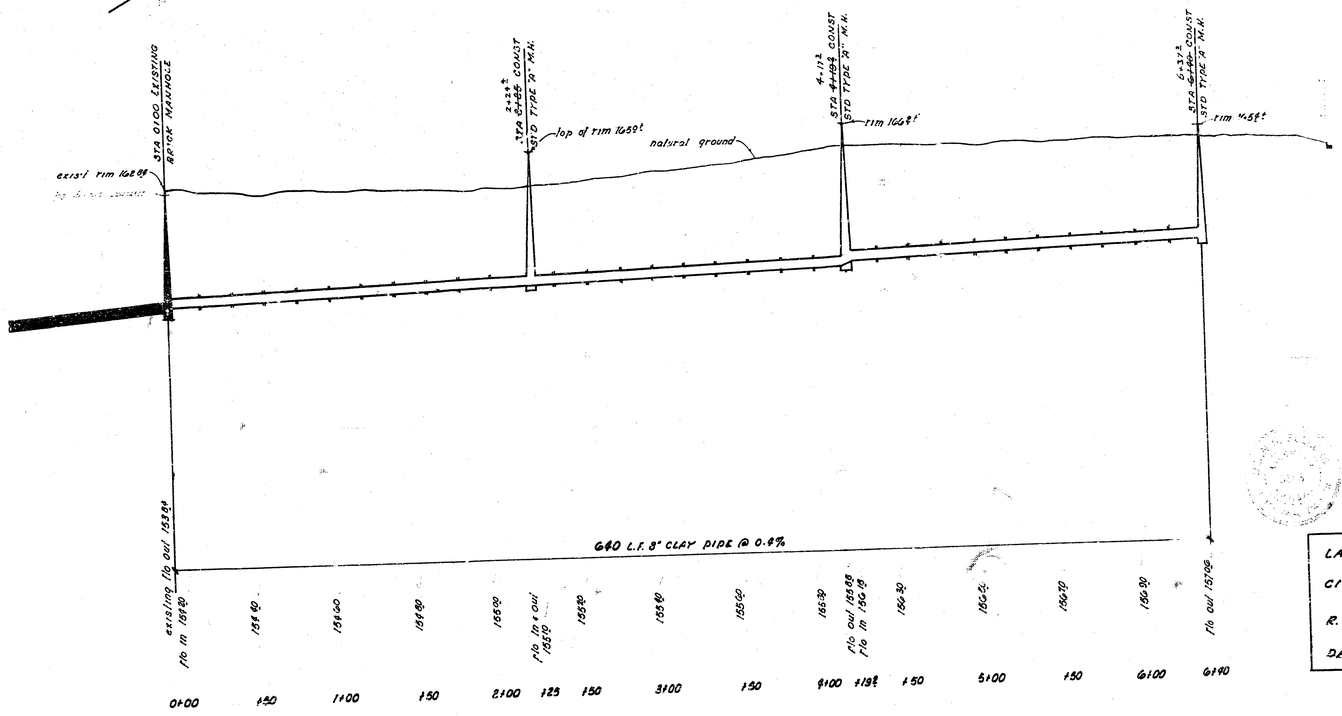

NOTE: Contractor is to verify Top of Manhole elevations with developer.

PLAN SCALE 1" = 50'
PROFILE 1" = 5' VERT
" = 10' HORZ

"As Built" Final Measurements K-102

LATERAL 52, WESTLINK SEWER
CITY OF WICHITA, KANSAS
R. W. LINN CITY ENGINEER
DATE OCT. 1972 PROJ No. DBKL 5690G9

FILMED FROM THE BEST AVAILABLE COPY