
B. M. 155.470 "+" top west curb Chipper Lane at S. L. Briarwood.

B. M. 157.080 Top bolt S.W. cor. M.L.P. base S-Side K.G.E. Westlink Sub station on 13th.

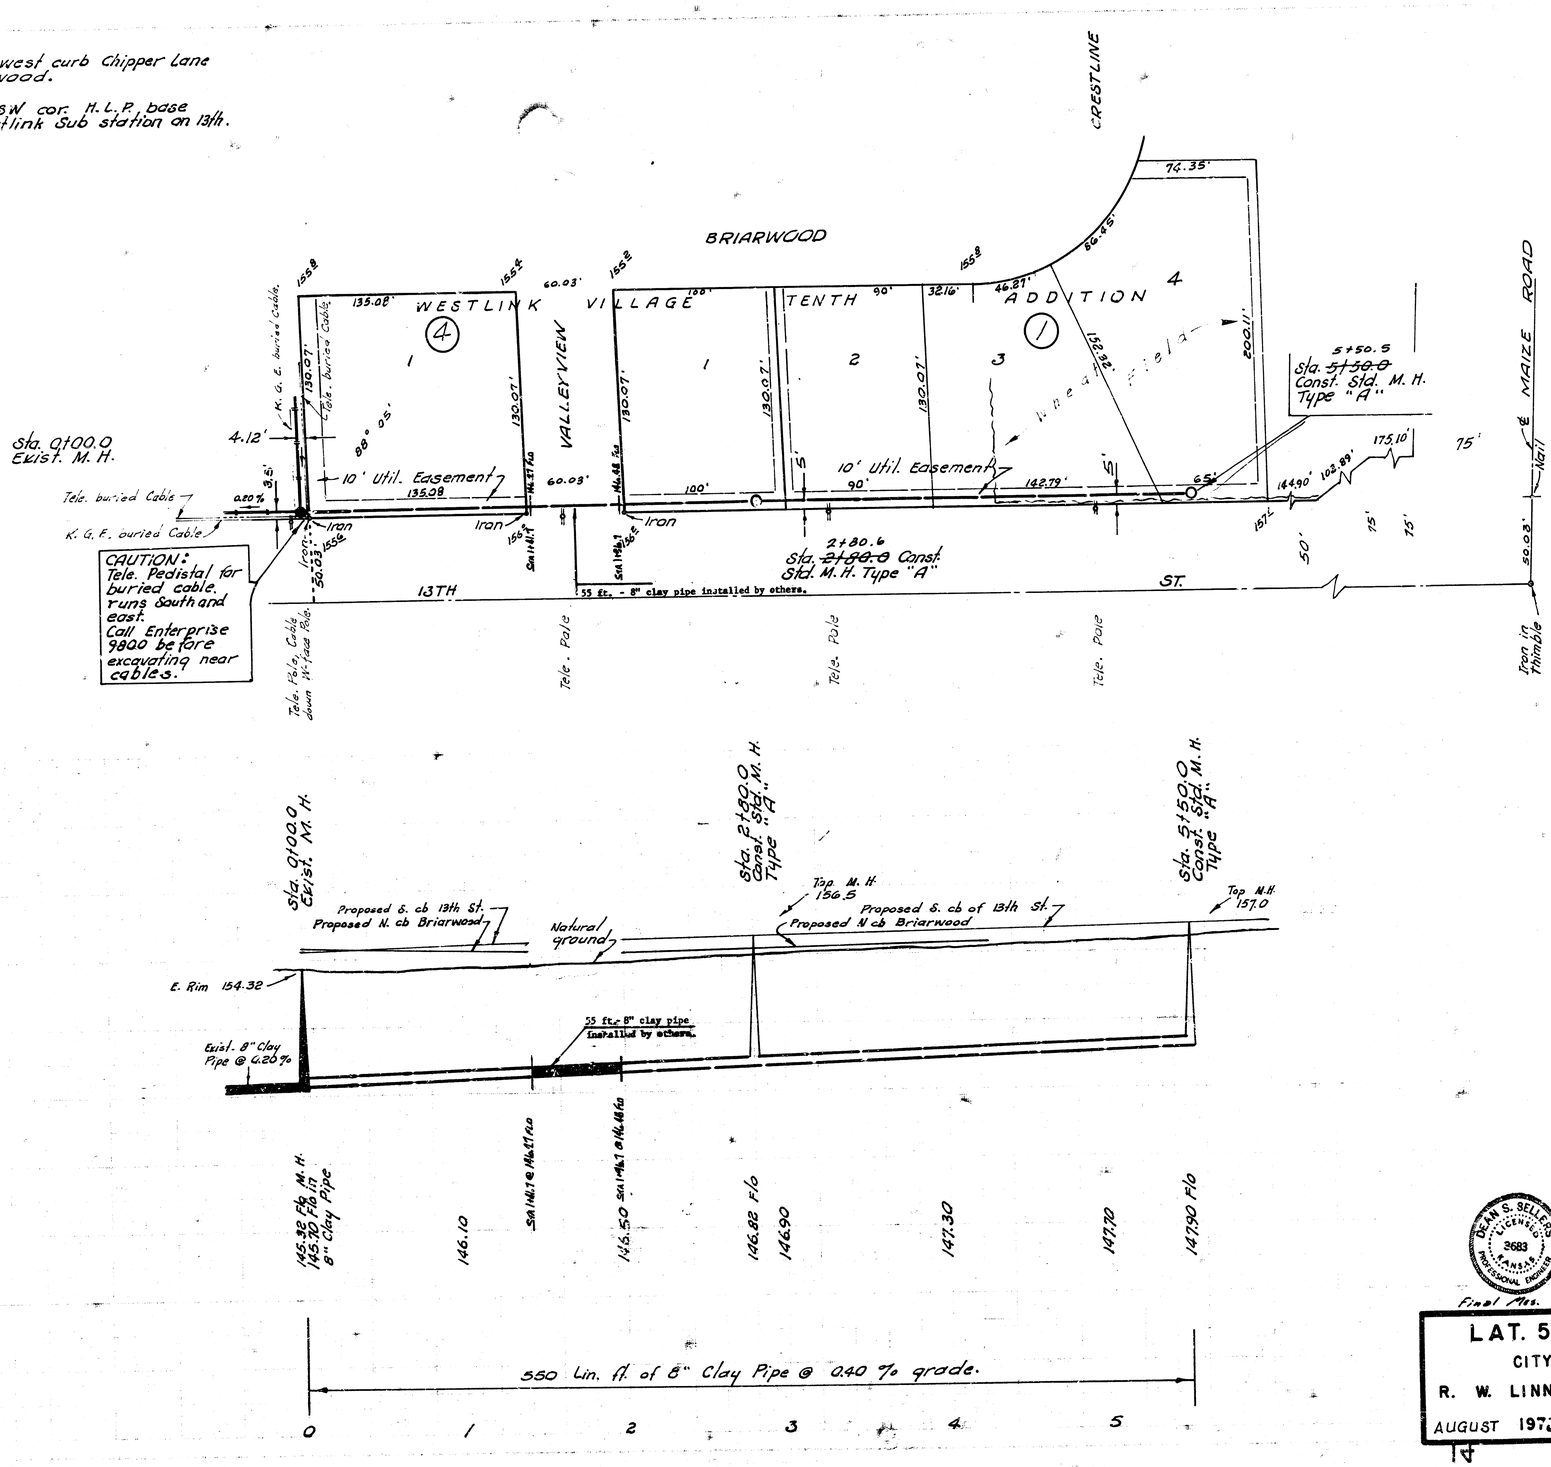

N

Plan Scale 1" = 40'
Profile Scale 1" = 40' Horz.
1" = 5' Vert.

DEAN S. SELLERS LICENSED 3683 KANSAS PROFESSIONAL ENGINEER

DONALD E. SCHNEIDER LICENSED 6311 KANSAS PROFESSIONAL ENGINEER

Final Mss. "A" Bw'll K-100

LAT. 55, WESTLINK SEWER
CITY OF WICHITA, KANSAS
R. W. LINN — CITY ENGINEER
AUGUST 1973, PROJECT NO. DBKL572048

1/1

FILMED FROM THE BEST AVAILABLE COPY....