

B.M. 142.26 ~ Std. 41.35 S. & 52.5 E. ℄ both Central & Maize

B.M. 143.57 ~ R.R. spk. S-face P.P. SW. cor. lot 1, blk. 1, Toh-N-Hah Village, being 3rd P.P. N. of Squaw Lane on E.S. Maize Road

Permits Sold
See Sheet #2

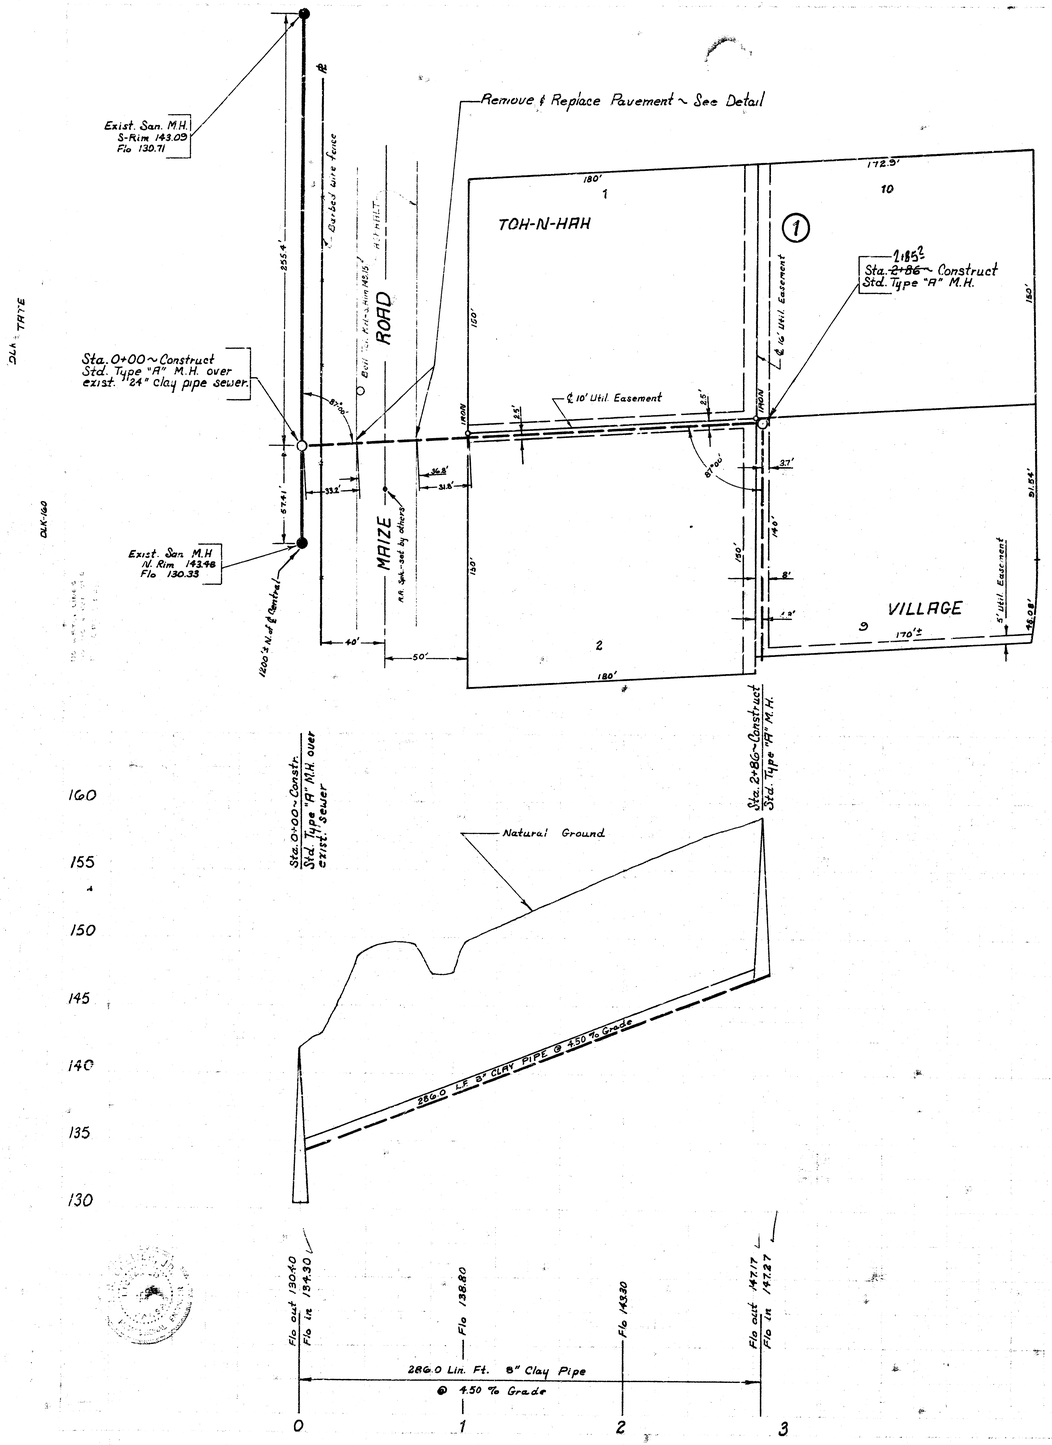

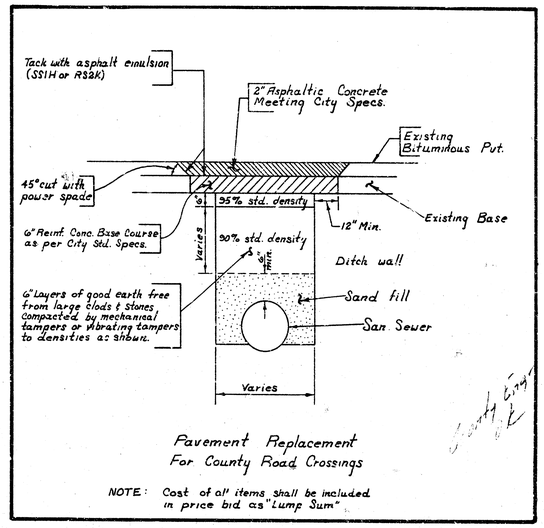

Pavement Replacement
For County Road Crossings

NOTE: Cost of all items shall be included in price bid as "Lump Sum"

N

Plan Scale ~ 1" = 40'
Profile Scale ~ Horiz. 1" = 40'
Vert 1" = 5'

"As Built" Plans 14 Sept. 73 from K-106


LATERAL 58
WESTLINK INTERCEPTOR
CITY OF WICHITA
R.W. LINN-CITY ENGINEER
DATE JULY 1973 PROJ. NO. DBKL 573028


DEAN S. SELLERS LICENSED 3683 KANSAS PROFESSIONAL ENGINEER

1/2

1/2

10 sets Engr
1 set water

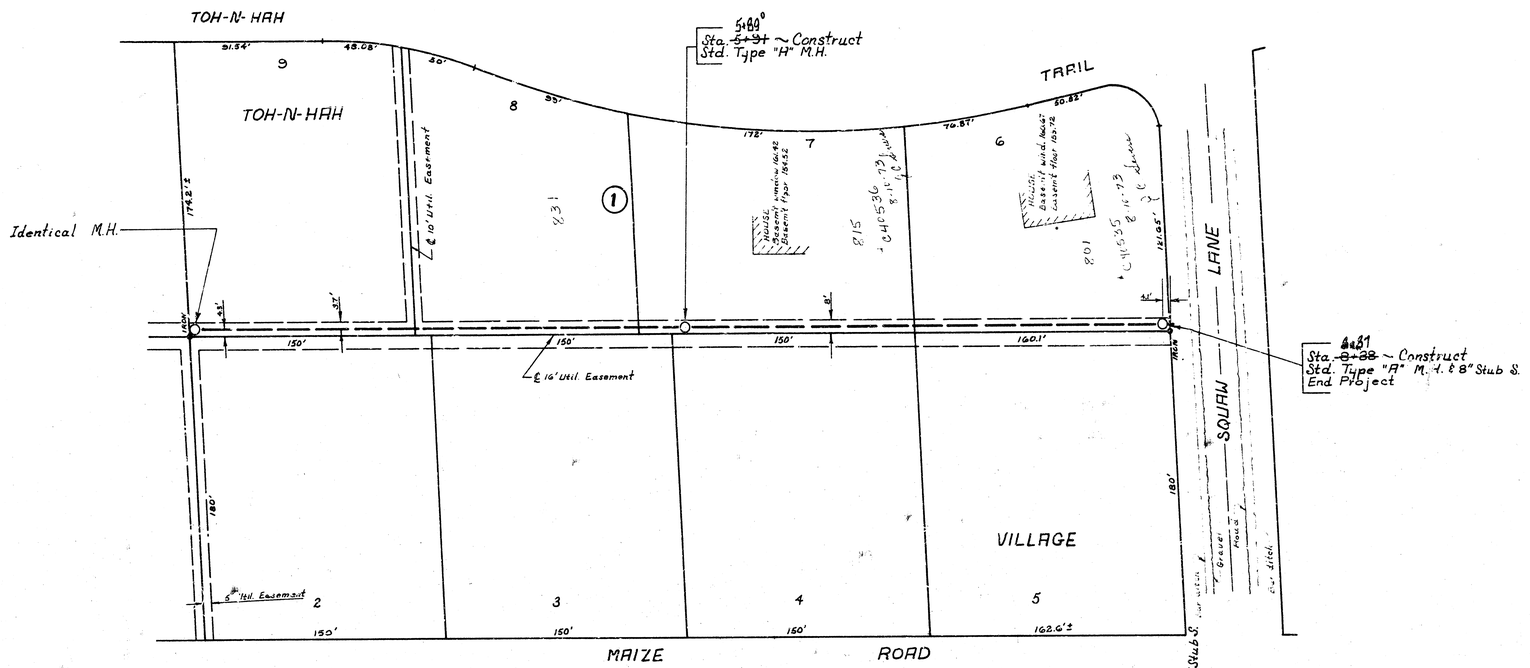

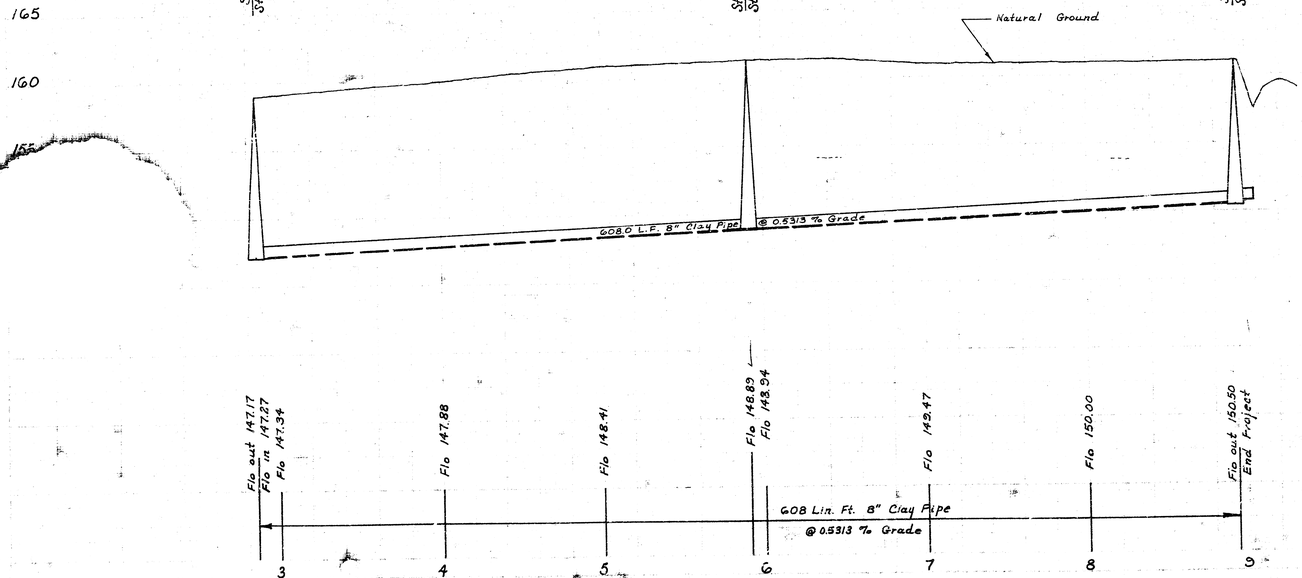

N

Plan Scale ~ 1" = 40'

Profile Scale ~ Vert. 1" = 5'
Horiz. 1" = 40'

(2/2) 14 R 5 (10) 22