B. M. 139.19 a top curb 12' west of w. end N.W Radius Mulberry and Sandplum.

B. M. 145.44 "M" in Mid Kansas 12' S. of S. end S.E. Radius Sandplum & Scoullar.

B. M. 143.20 S. S. drive @ garage wall House 1218 Sandplum.

Plan Scale 1" = 40'
Profile Scale 1" = 40' Horz.
1" = 5' Vert.

NOTE: Replace all Conc. drives.

MULBERRY PLACE

Sta. 0+00.0 Exist. M. H.

Curve data R = 805.1' P Δ = 21° 30' P Δ = 21° 28' M L = 302.05' P LC = 301.47' M

Exist. 10" W. of E. ft. Water line

Exist. 2" L.P. Gas line 6" W. of E. ft.

Sta. 2+11.0 Const. Std. M.H. Type "A"

Sta. 4+68.7 Const. Std. M.H. Type "A"

Curve data R = 710.1' P Δ = 16° 58' P L = 210.23' P Δ = 17° 02' M LC = 209.45' M

Sta. 6+03.7 Const. Std. M.H. Type "A"

LANE

Sta. 7+11.7 Const. Std. M.H. Type "A"

SANDPLUM

10' Sewer Easem't

COUNTRY ACRES 4TH "B" ADDITION

South line of Benefit District

Ronald F. Lane 2458 S. Minneapolis

Mayer Enterprises Inc. James D. Miner

Neal Storey 207 S. Brookside

James Minor 317 N. Westfield

Ronald F. Lane 2458 S. Minneapolis

Neal Storey 207 S. Brookside

James Minor 317 N. Westfield

SCOULLER

Sta. 3+37.2 Const. Std. M.H. Type "A"

CURVE DATA @ PC Calc. R = 190.76' Δ = 75° 46' M LC = 230.28' M R = 190' P Δ = 75° 45' P L = 251.18' P

Sta. 8+55.4 Const. Std. M.H. Type "A"


Sta. 7+83.9 Const. Std. M.H. Type "A"

13TH ST.

Neal Storey 207 S. Brookside

James Minor 317 N. Westfield

Ronald F. Lane 2458 S. Minneapolis

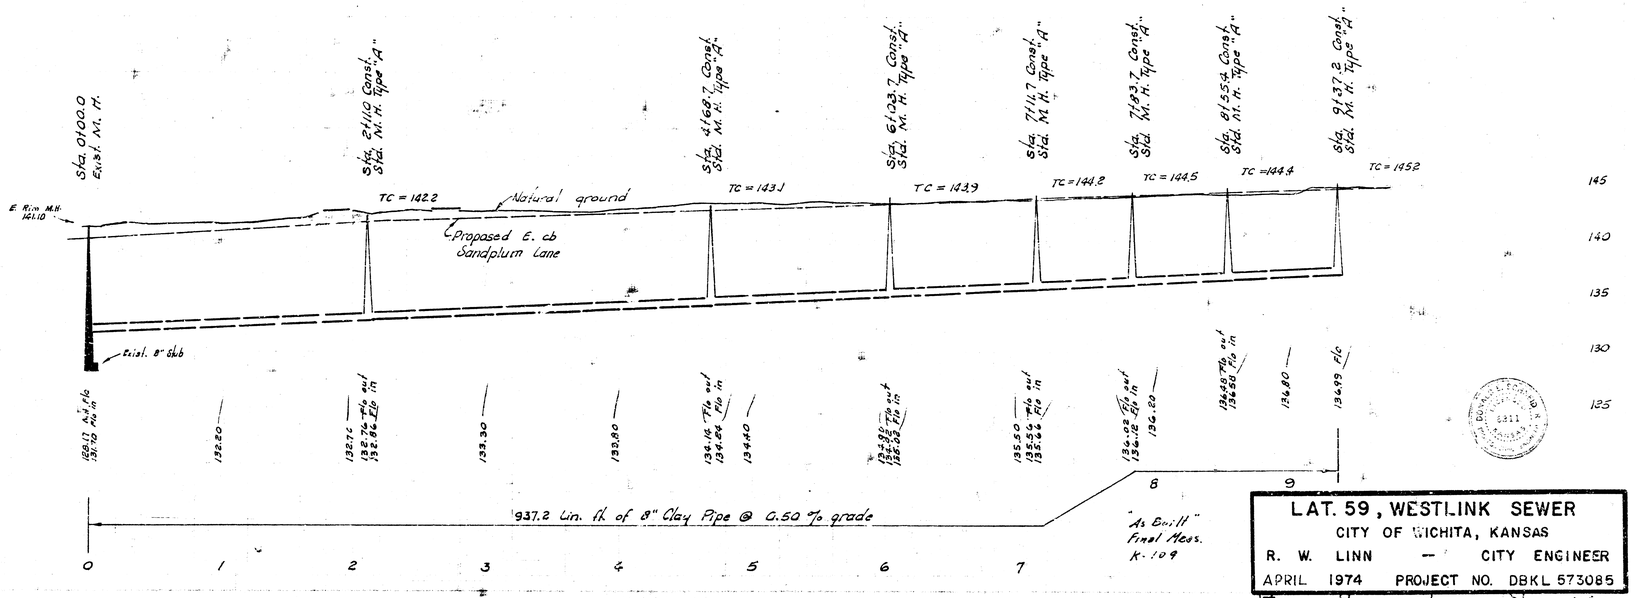

LAT. 59, WESTLINK SEWER
CITY OF WICHITA, KANSAS
R. W. LINN -- CITY ENGINEER
APRIL 1974 PROJECT NO. DBKL 573085