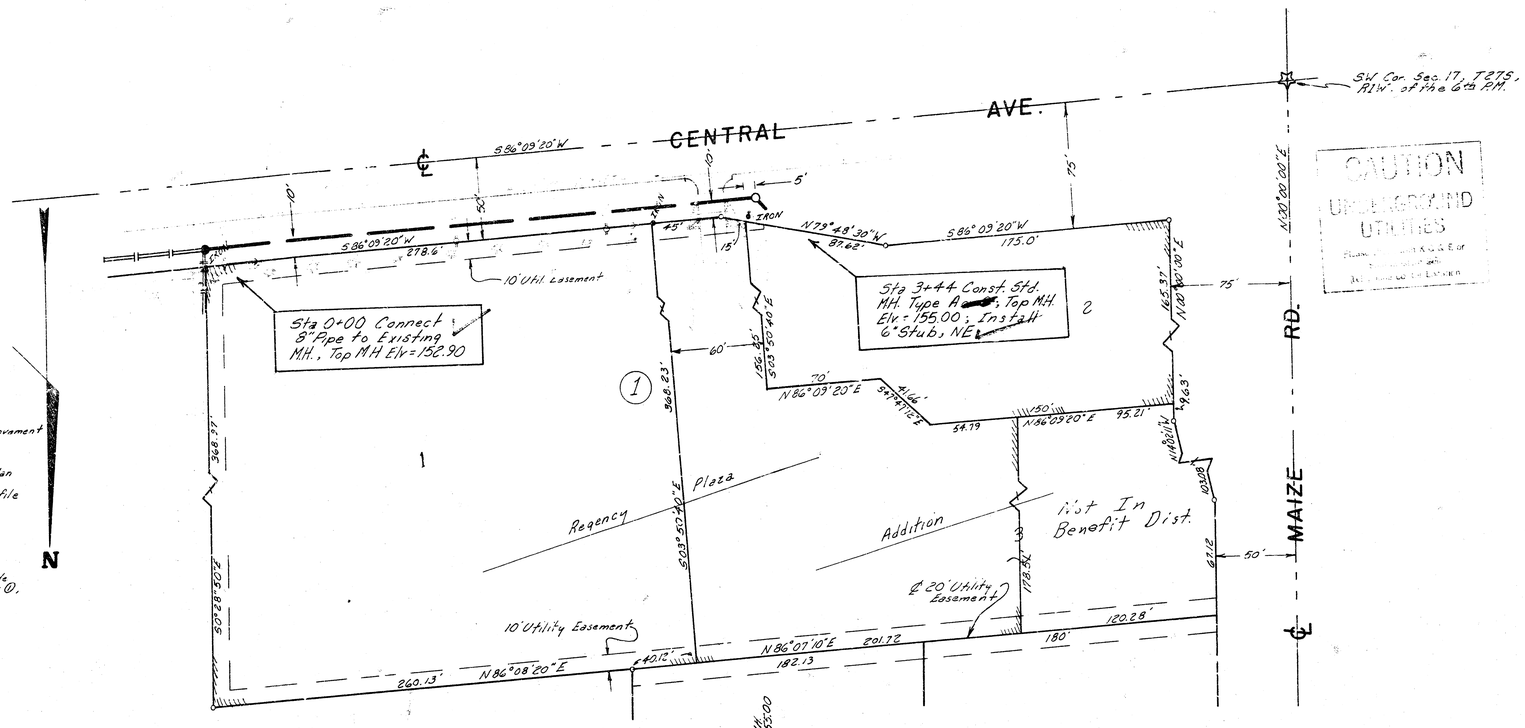

As Built 8/8 11/81

LAT. 67, WESTLINK SEWER
CITY OF WICHITA, KANSAS
R.W. BRUGGEMAN
DIRECTOR OF ENGINEERING / CITY ENGINEER
PROJ. NO. 468-76-245-81011-000-000-001

Sheet 1 of 1

FILMED FROM THE BEST AVAILABLE COPY