

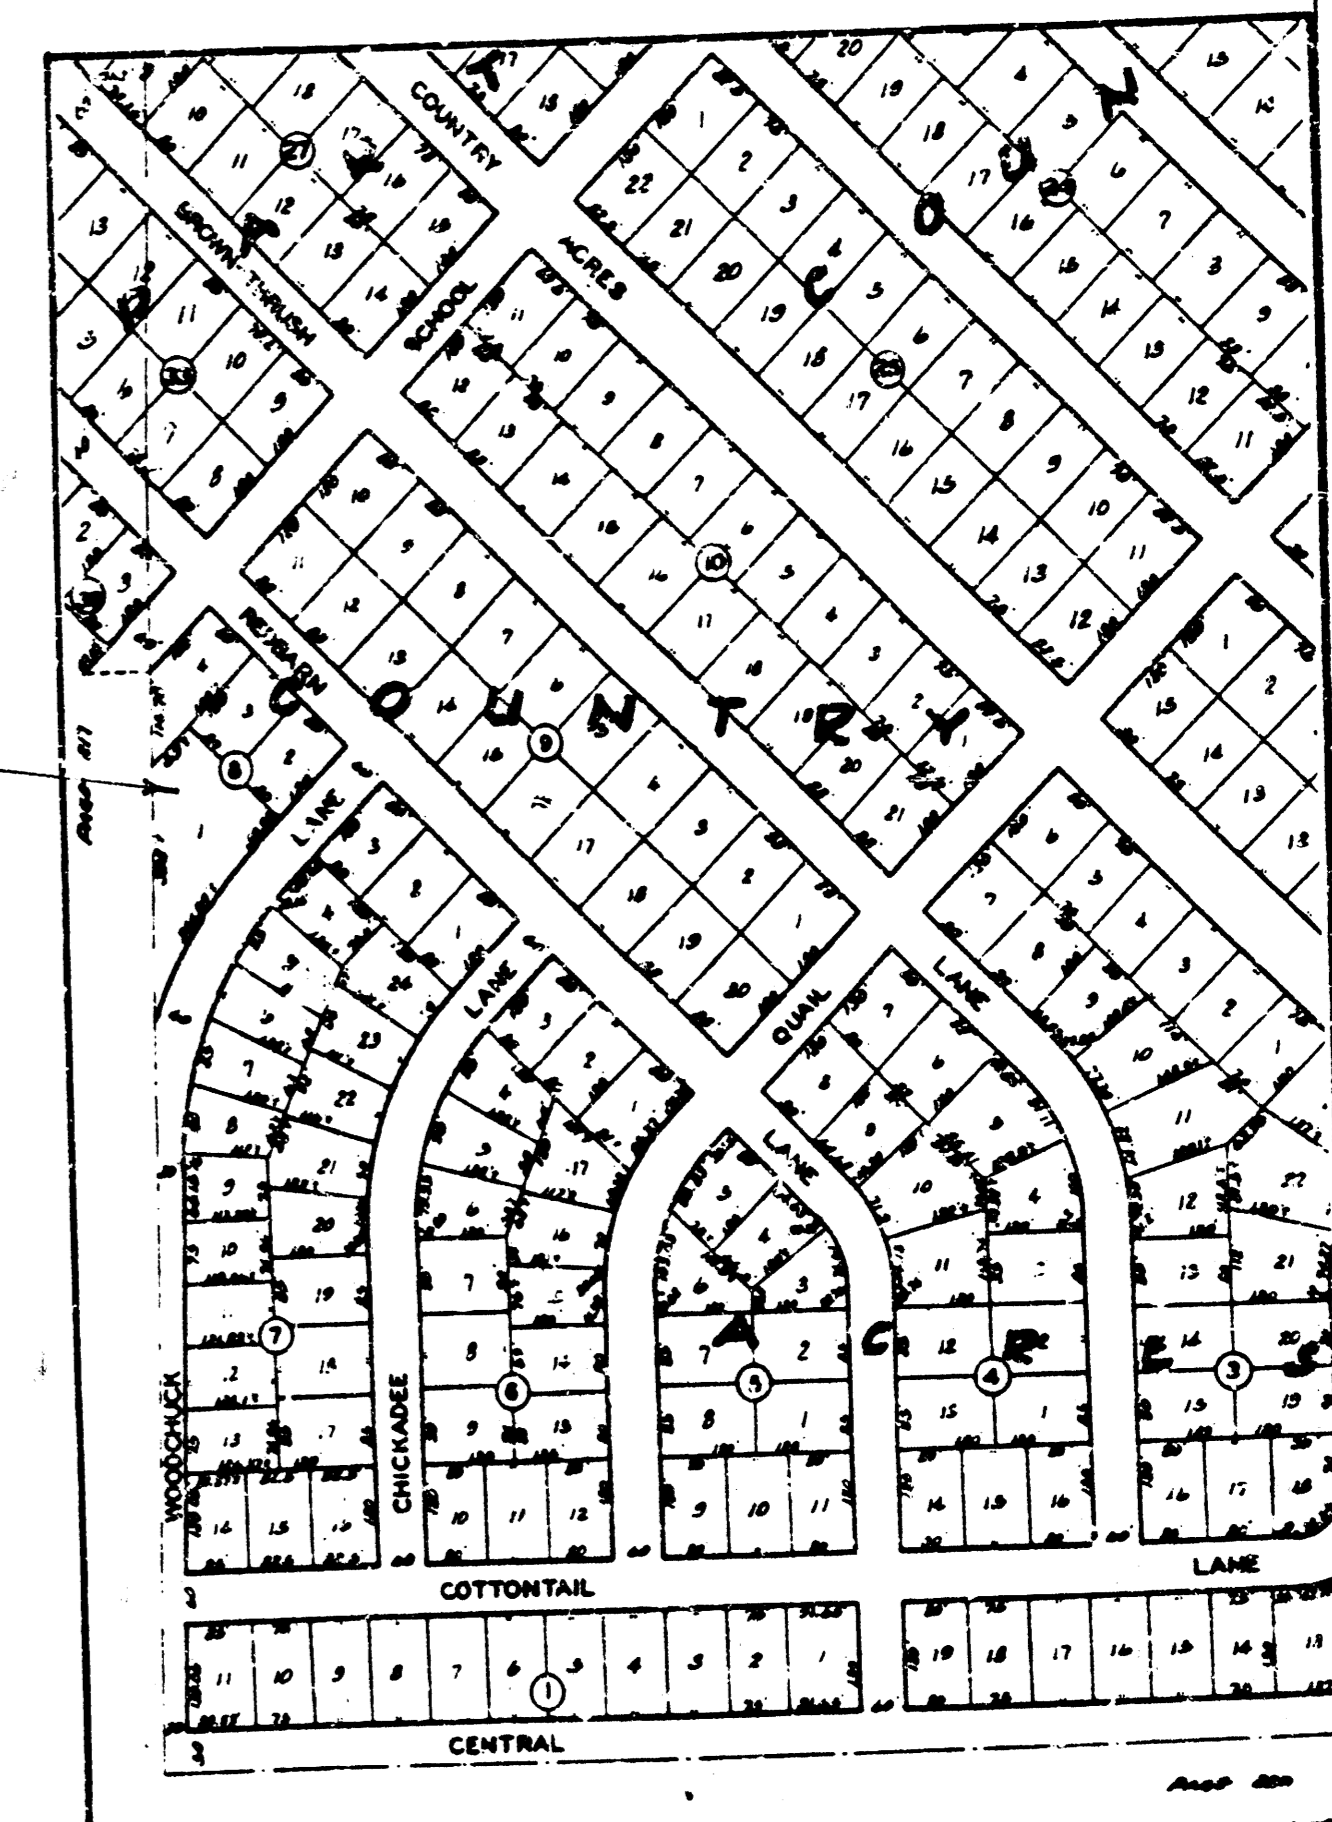
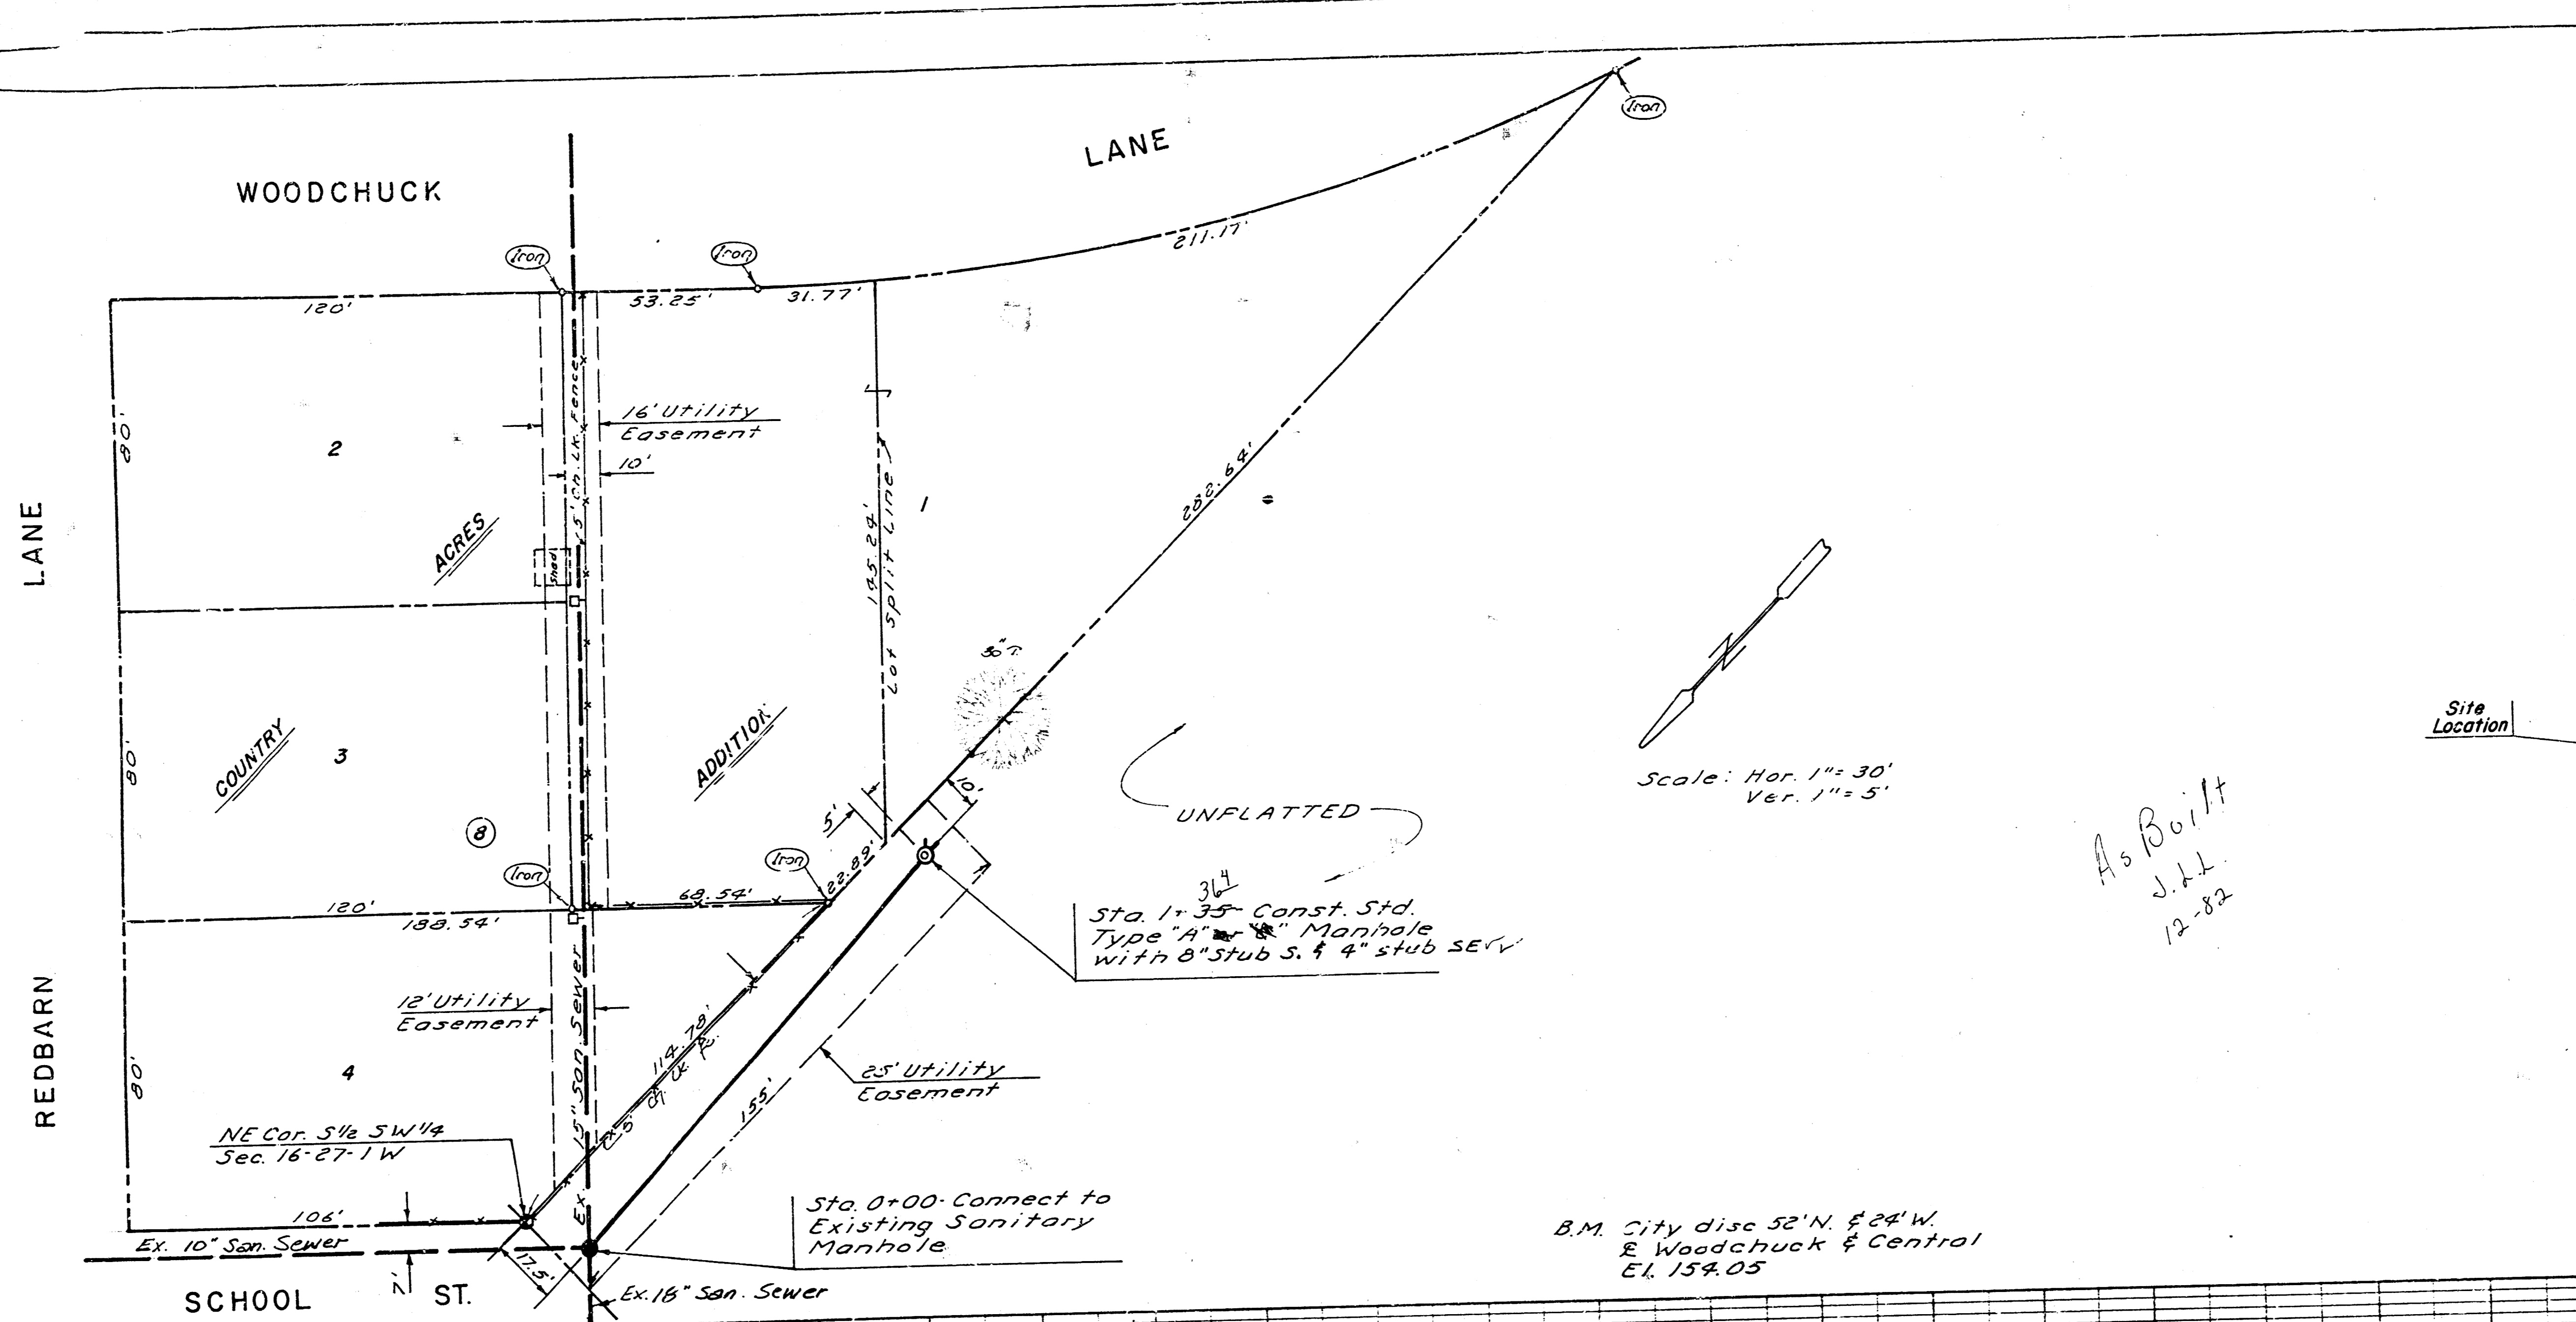


PLAN  
 CITY: WICHITA, KANSAS  
 SHEET NO. 1 OF 1

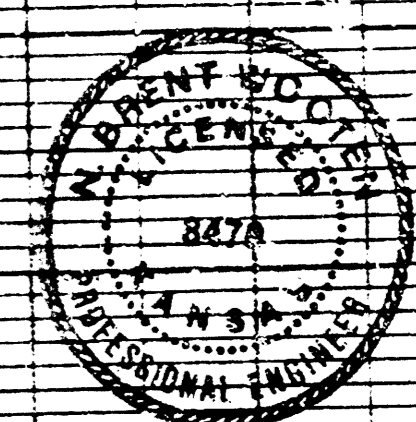

PROFILE  
 CITY: WICHITA, KANSAS  
 SHEET NO. 1 OF 1

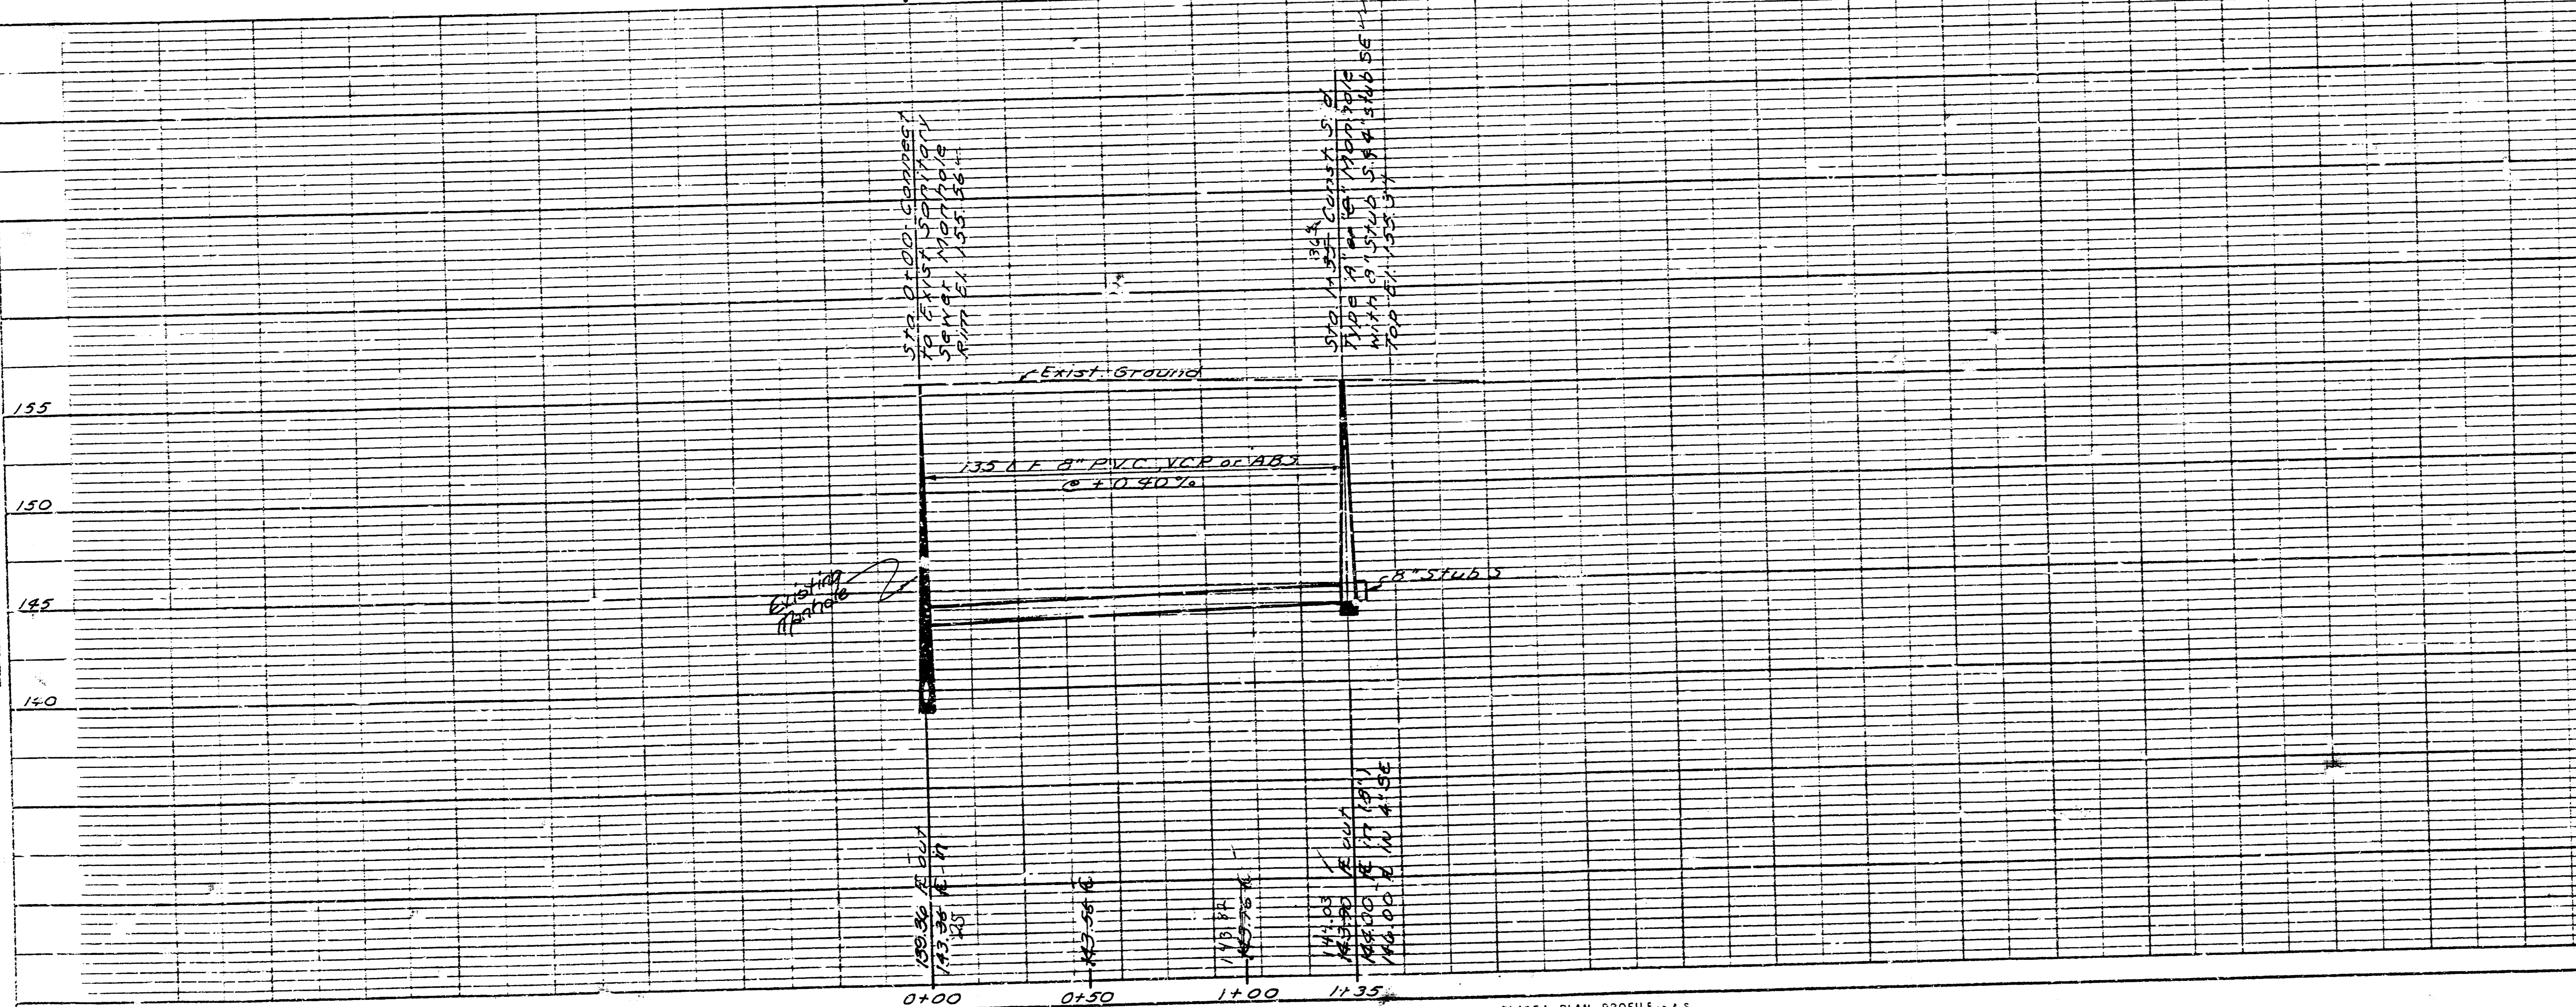

Revised 12-82

LATERAL 71, WESTLINK SANITARY SEWER  
 TO SERVE LOT 1, BLK. 8, COUNTRY ACRES ADDN.  
 PROJECT NO.  
 468-76-245-81231-000-000-001

CITY OF WICHITA, KS  
 R. W. BRUGGEMAN DIR. ENGINEERING