

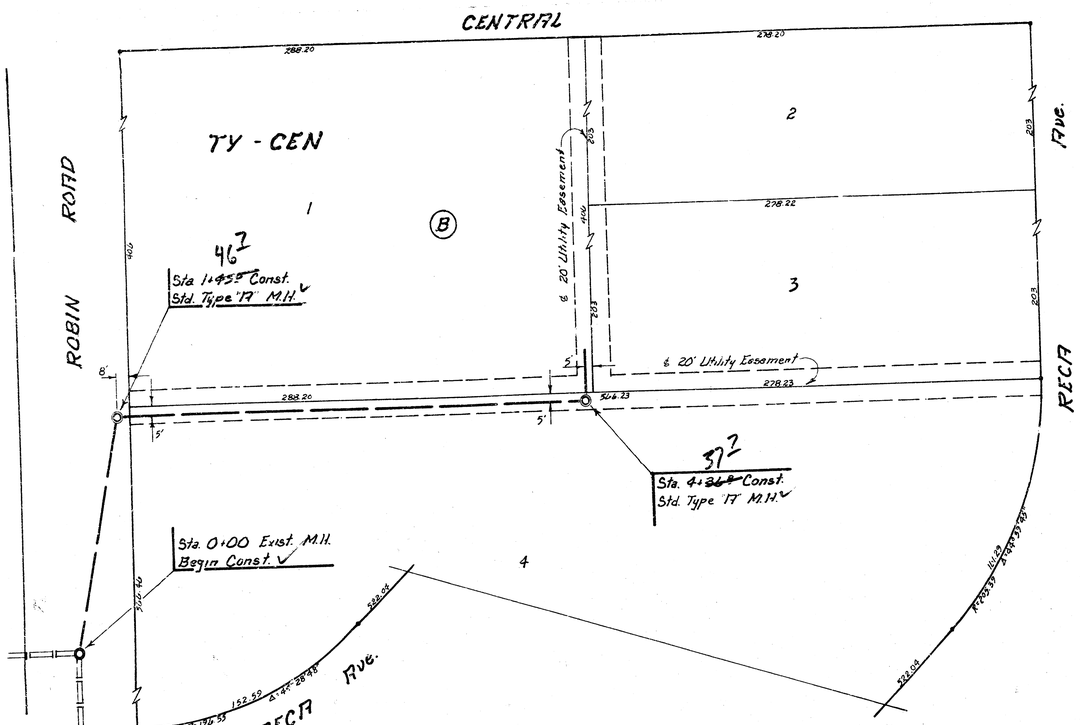


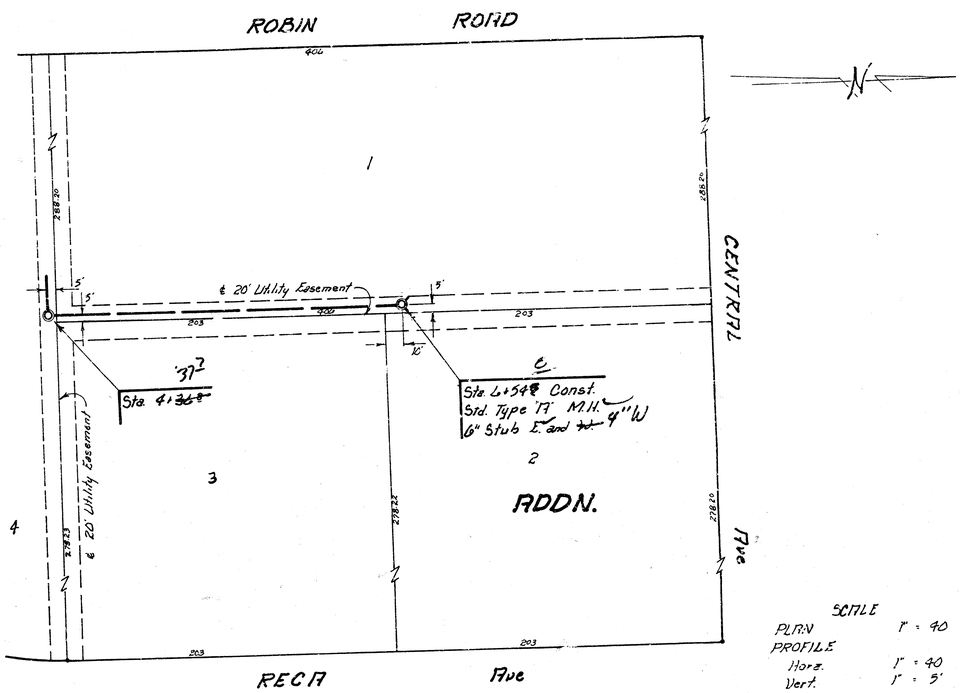

B.M. 143.903 City Std. , 30.2 No. and 38' W of ℄ TYLER ROAD and CENTRAL

SCALE
PLAN 1" = 40
PROFILE
Horz. 1" = 40
Vert. 1" = 5'

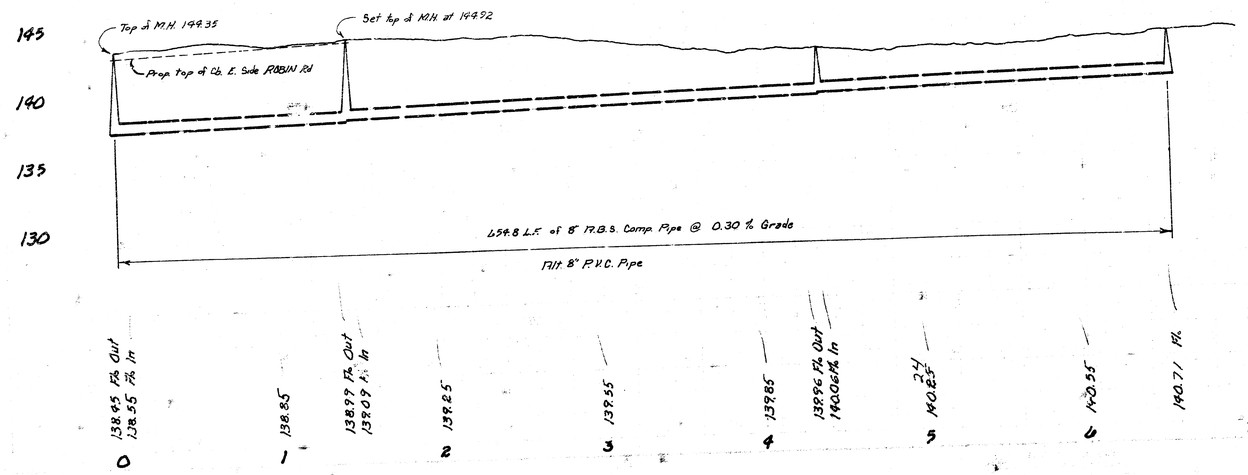

NOTE: EXCESS EXCAVATED MATERIAL SHALL BE USED TO MAINTAIN A MINIMUM COVER OF 30" OVER THE SEWER, WHERE NECESSARY ON THIS PROJECT.

As Built
88
11/81

Lat. 20, Main 1, WESTLINK SEWER
City of Wichita, Kansas
DEAN SELLERS CITY ENGINEER
Proj. No: 468-76-245-80761-000-000-601
Date _____

14 10 5 e

FILMED FROM THE BEST AVAILABLE COPY