Sanitary Sewer Extensions To Serve

BERLIN ADDITION

LATERAL 28 - MAIN 1 - WESTLINK SEWER

Project No.


468-76-245-82162-000-000-001

City of Wichita, Kansas - Michael E. Lindebak, City Engineer

740993

Index

1. Title Sheet
2. Line 1 and Line 2

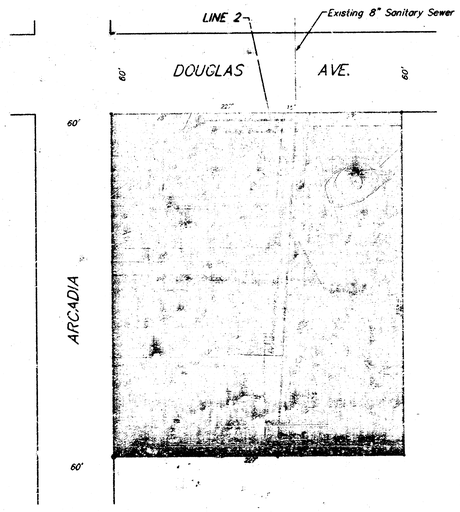

Scale: 1" = 50'

Benefit District

General Notes


1. Underground utility service lines and overhead utility pole lines are to be adjusted as necessary by others prior to construction unless the plans specifically call for their adjustment by the Contractor or unless the plans specifically identify a utility to be adjusted by its owner during construction. Existing utilities and their location, as shown on the plans, represent the best information obtainable for design. The Contractor will be required to work around existing utilities within the right-of-way which do not conflict with proposed construction.
2. The Contractor shall be responsible for preserving property irons. The Contractor will be required to re-establish any property irons which are damaged or destroyed by his construction operations. Such irons shall be re-established by a licensed land surveyor in accordance with state laws.

ROBERT WOOTEN LICENSED 0670 KANSAS LAND SURVEYOR

Built per plan RDC 5-92

February, 1992

BAUGHMAN COMPANY P. A.
ENGINEERING & SURVEYING
316/262-7271 • 315 ELLIS • WICHITA, KANSAS 67211

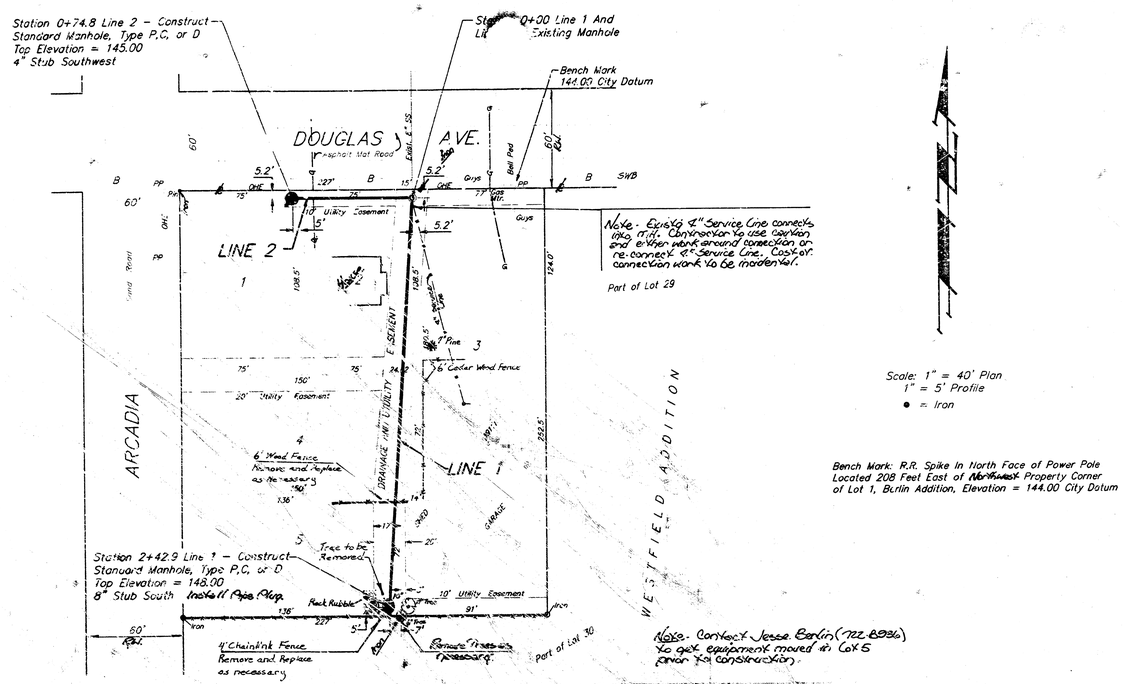

LATERAL 28 – MAIN 1 – WESTLINK SEWER
TO SERVE BERLIN ADDITION

BAUGHMAN COMPANY P. A.
ENGINEERING & SURVEYING
316/262-7271 • 315 ELLIS • WICHITA, KANSAS 67211

REV.

PROJECT NUMBER
468-76-245-82162-00C-000-001

SHEET 2
OF 2

DESIGN	DRAWN	APPROVED	DATE	SCALE
C. Bohm	C. Bohm	[illegible]	Feb. 20, 1992	Noted

P.I. 3-81