
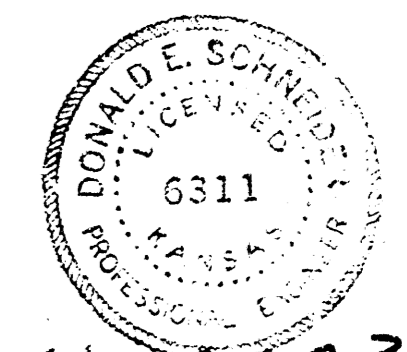
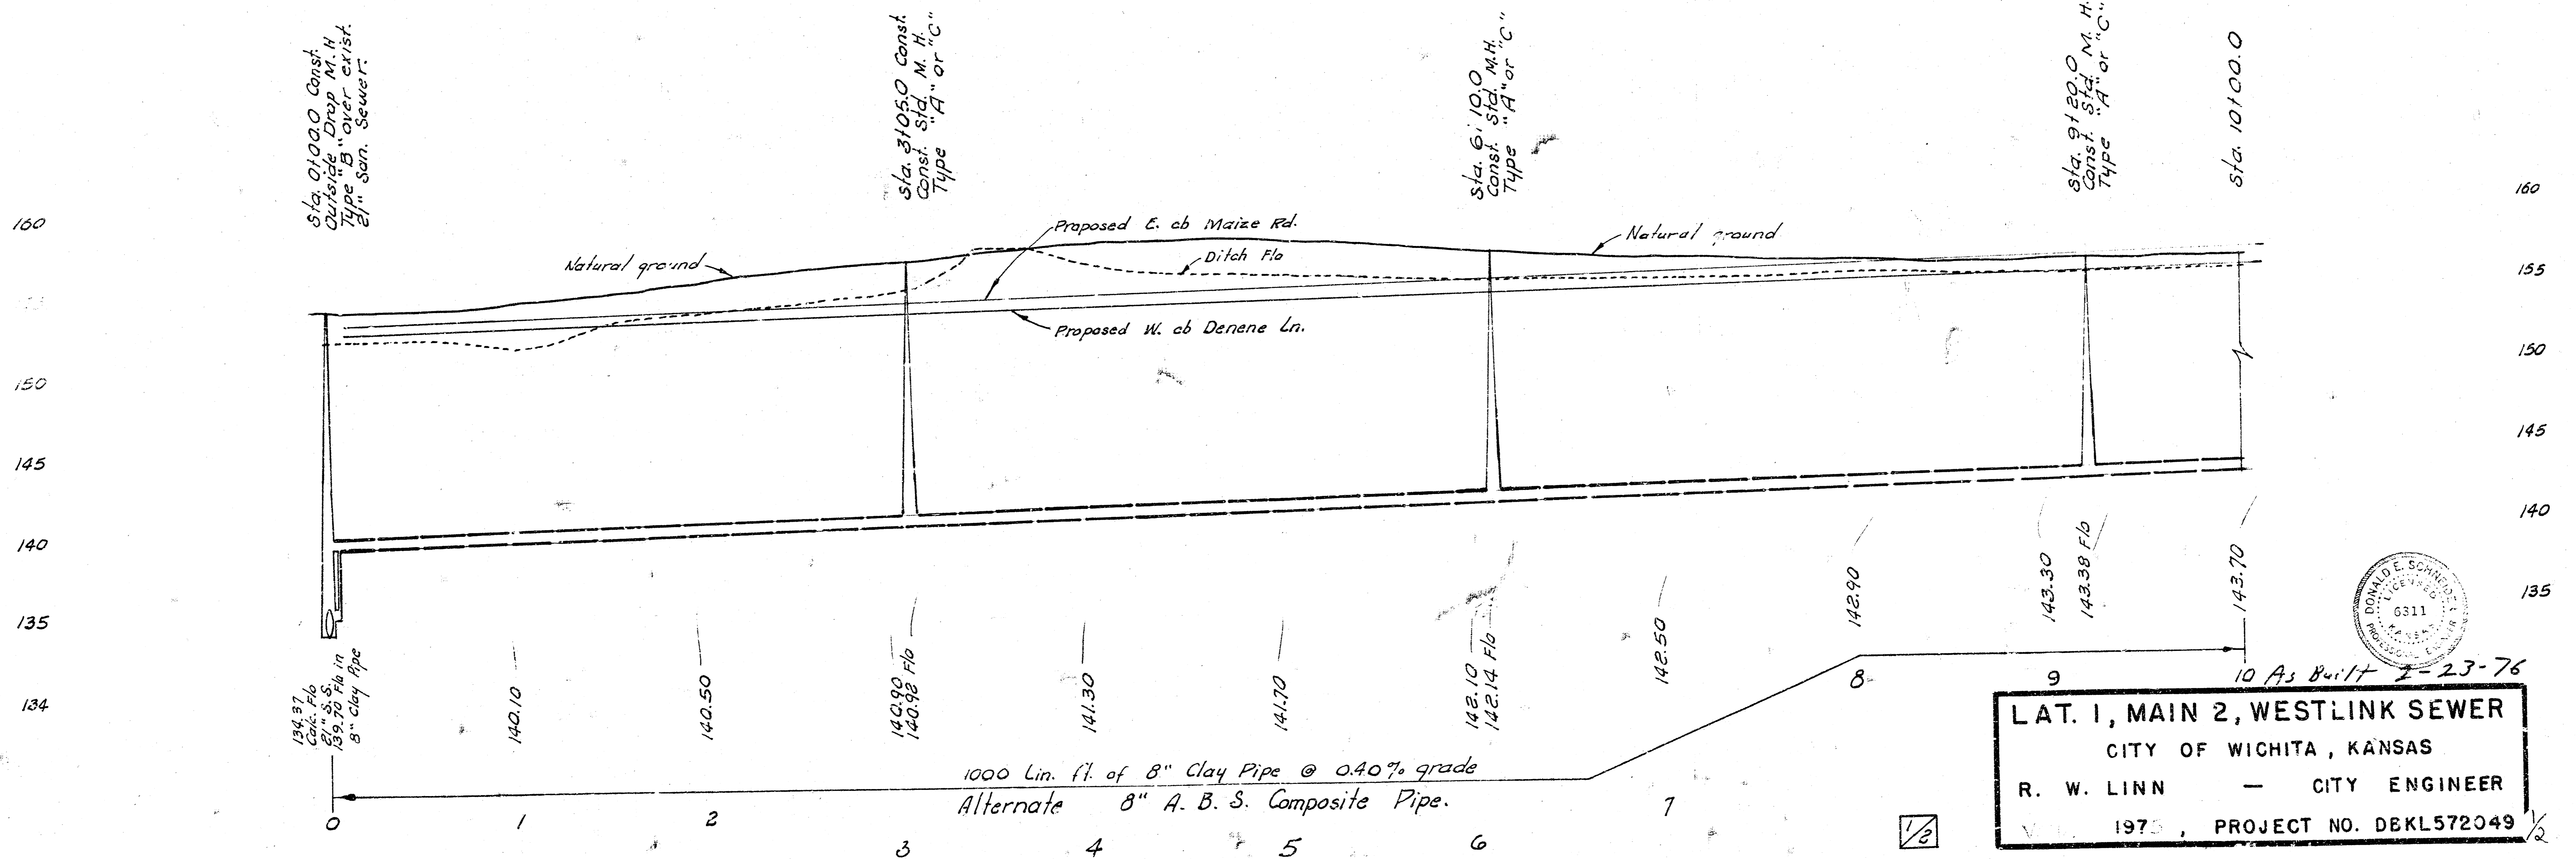
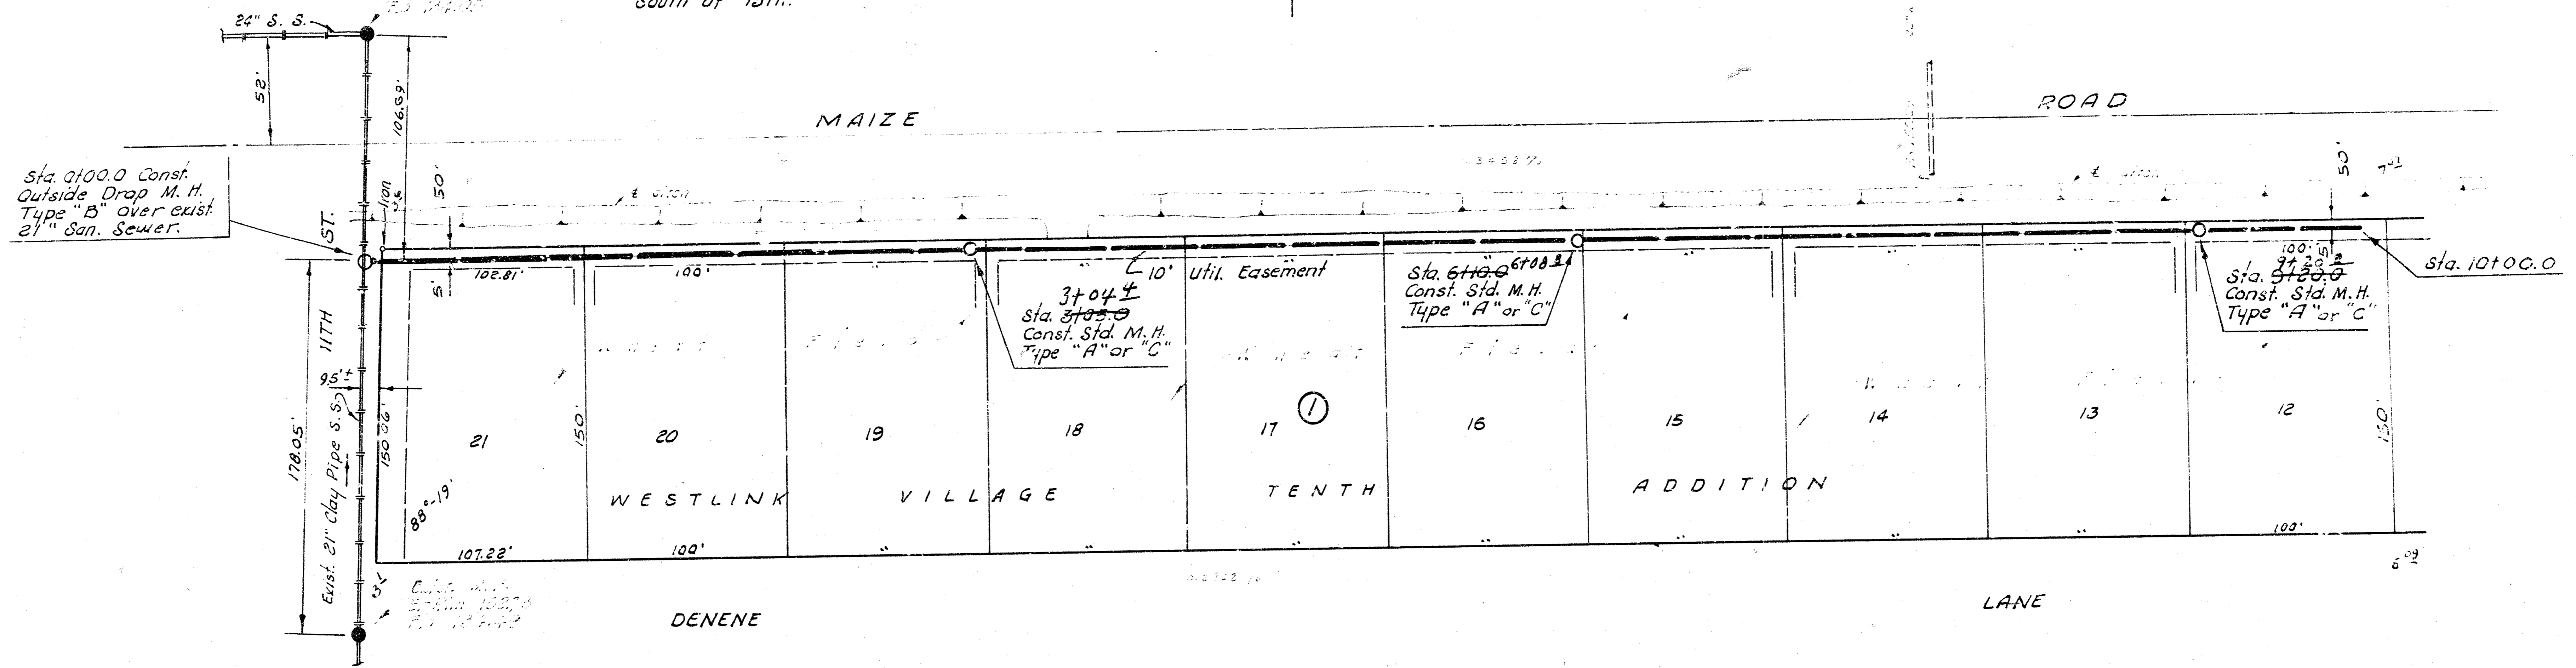


Plan Scale 1" = 40'
 Profile Scale 1" = 40' Horiz.
 1" = 5' Vert.

B. M. 156.59 R. R. Spk. E. face P. P.
 E. side Maize Rd. 6th pole
 South of 13th.

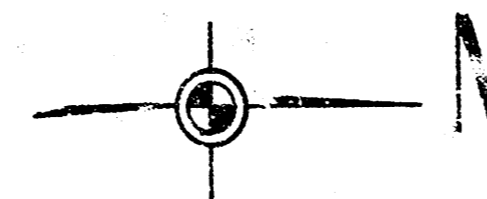


LAT. 1, MAIN 2, WESTLINK SEWER
 CITY OF WICHITA, KANSAS
 R. W. LINN — CITY ENGINEER
 1975, PROJECT NO. DBKL572049

B. M. 157.08 Top bolt SW cor. H.L.P. base
S. Side K. G. E. Westlink Substation
on 13th St.

B. M. 159.05 R. R. Spk. E. face P.P. E. - Side
Maize Rd. 5th Pole S. of 13th St.

B. M. 157.11 R. R. Spk. E. face P.P. E. - side
P. R. E. - side Maize Rd. 4th Pole South
of 13th St.

B. M. 156.85 R. R. Spk. E. face P.P. E. - side
Maize Rd. 3rd Pole S. of 13th St.

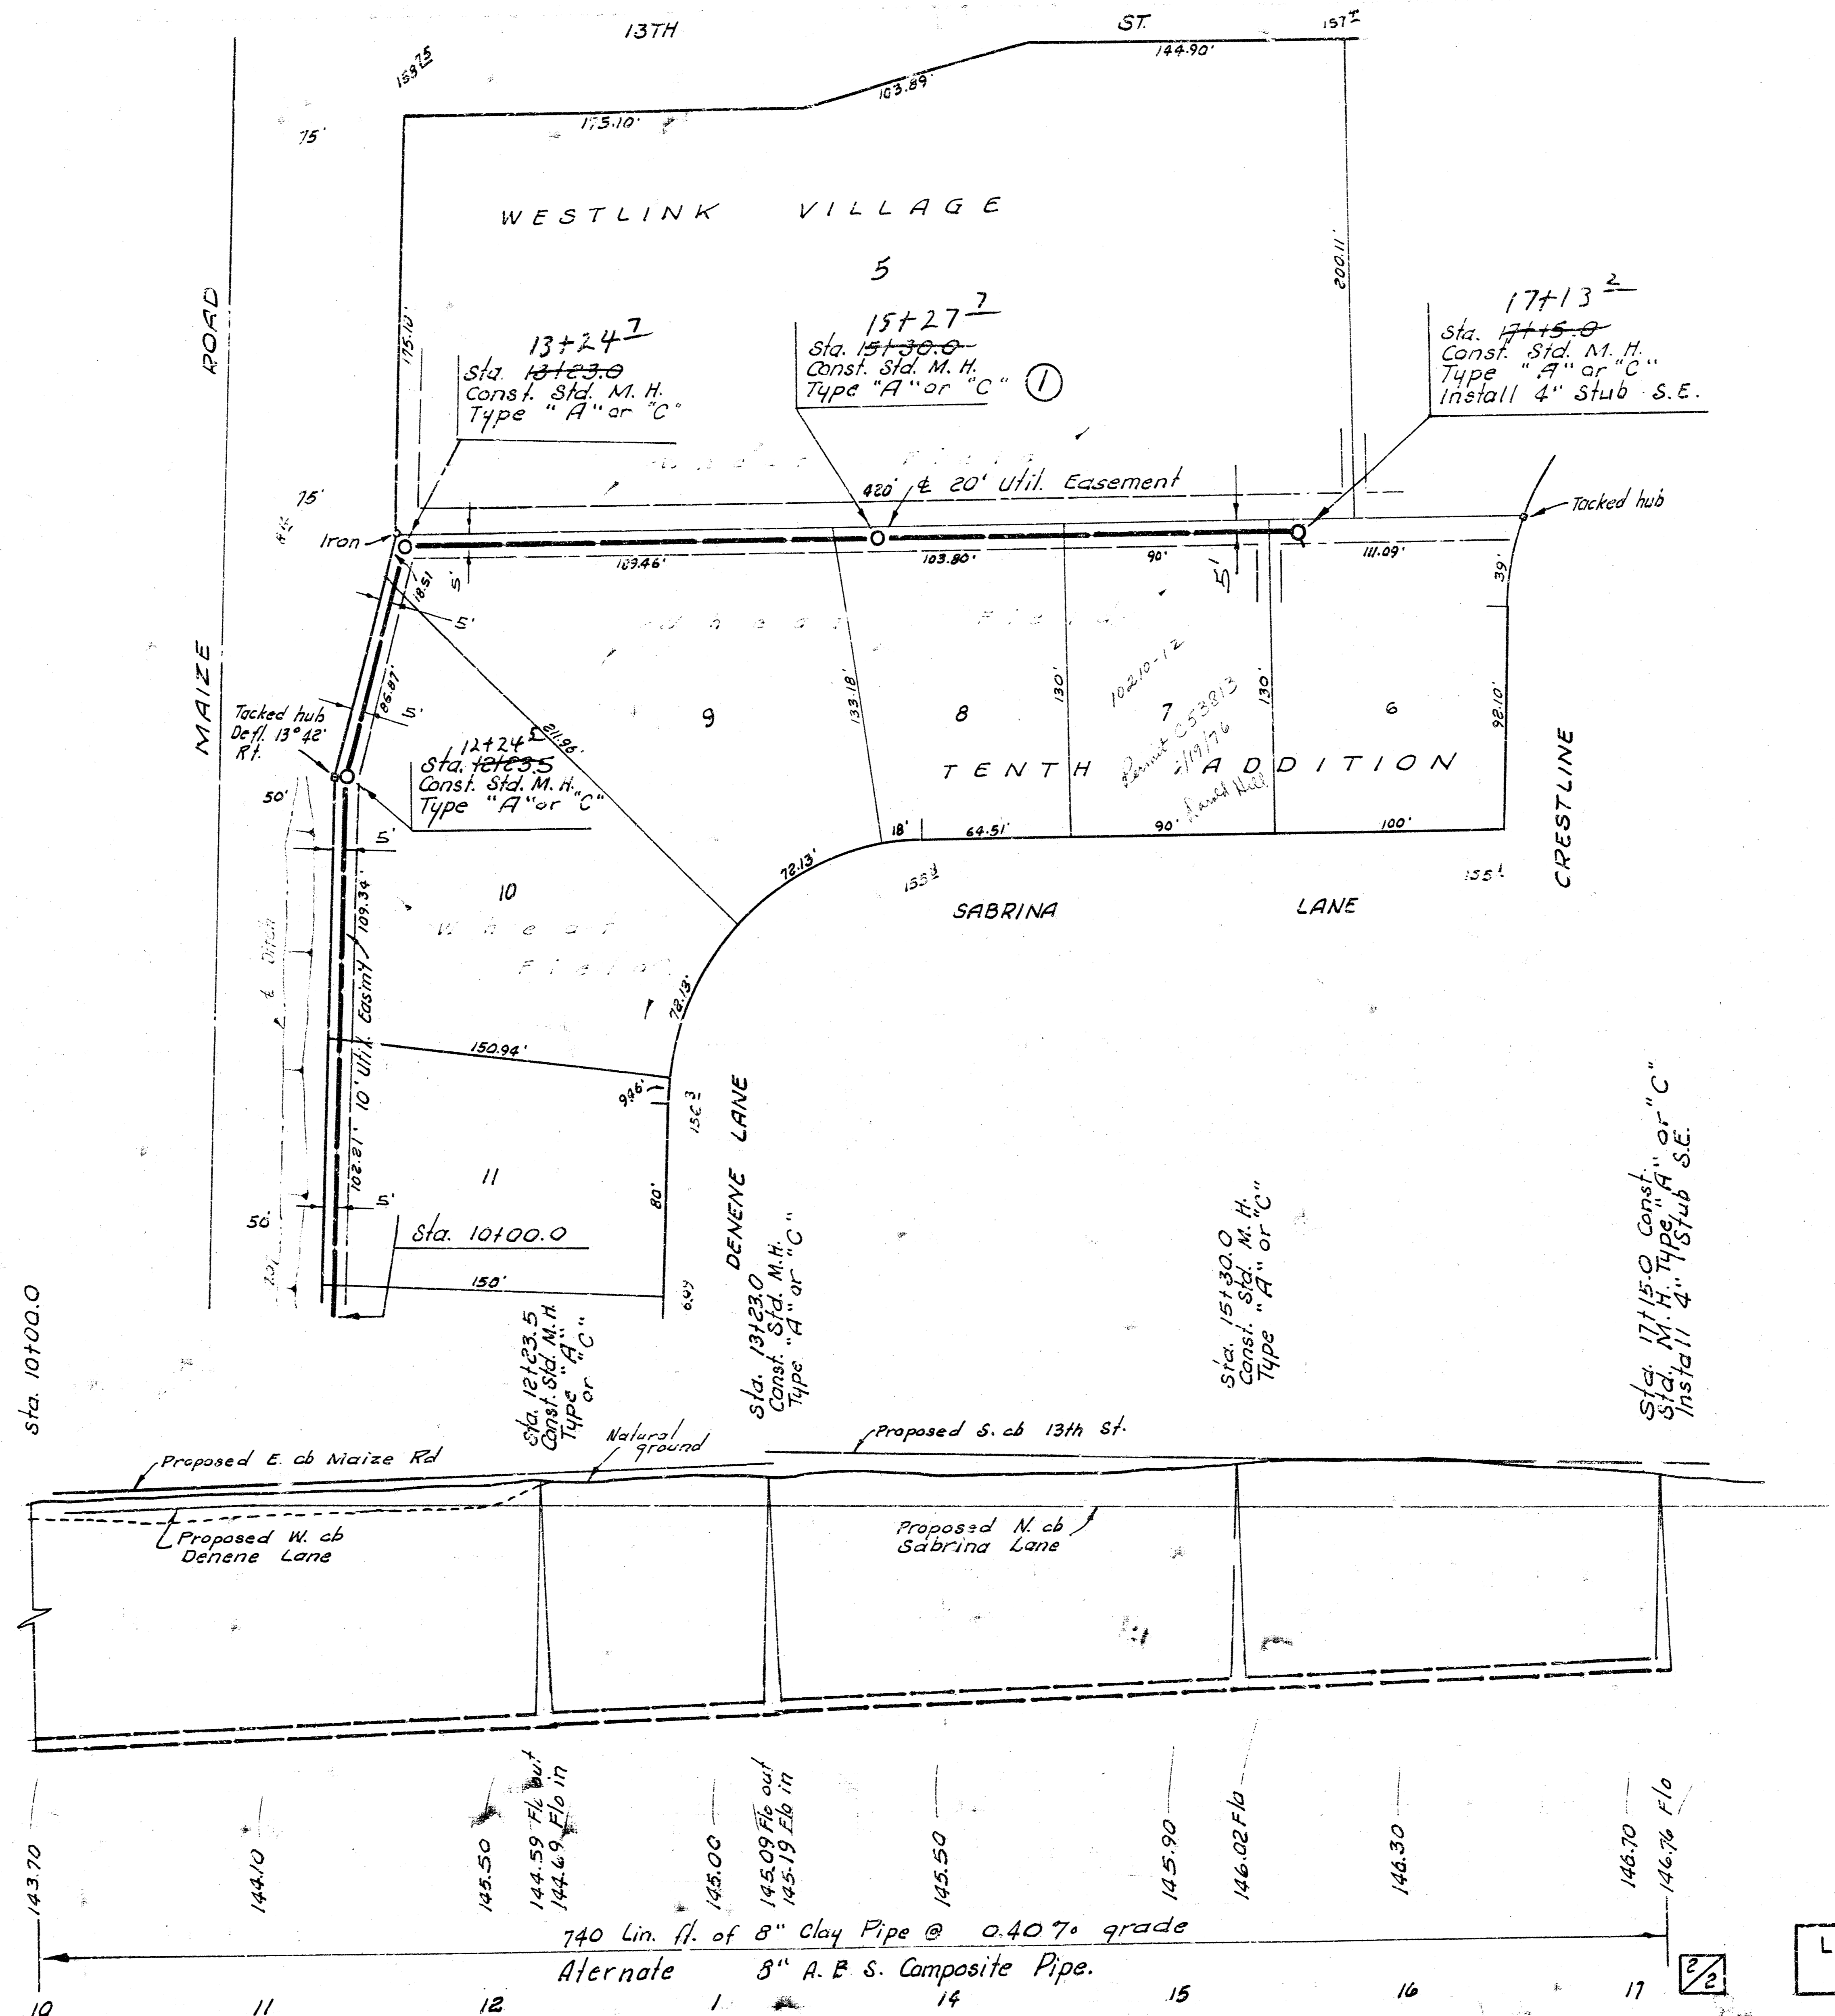

LAT. 1, MAIN 2, WESTLINK SEWER
PROJECT NO. DBKL572049