B. M. 159.655 "+" top w-cb Chipper Lane @ N. L. 11th St.

B. M. 151.858 R.R. Spk. NE Face P. P. 25 ft. S. and 7 ft. west of iron NW cor. lot 1, Block 8.

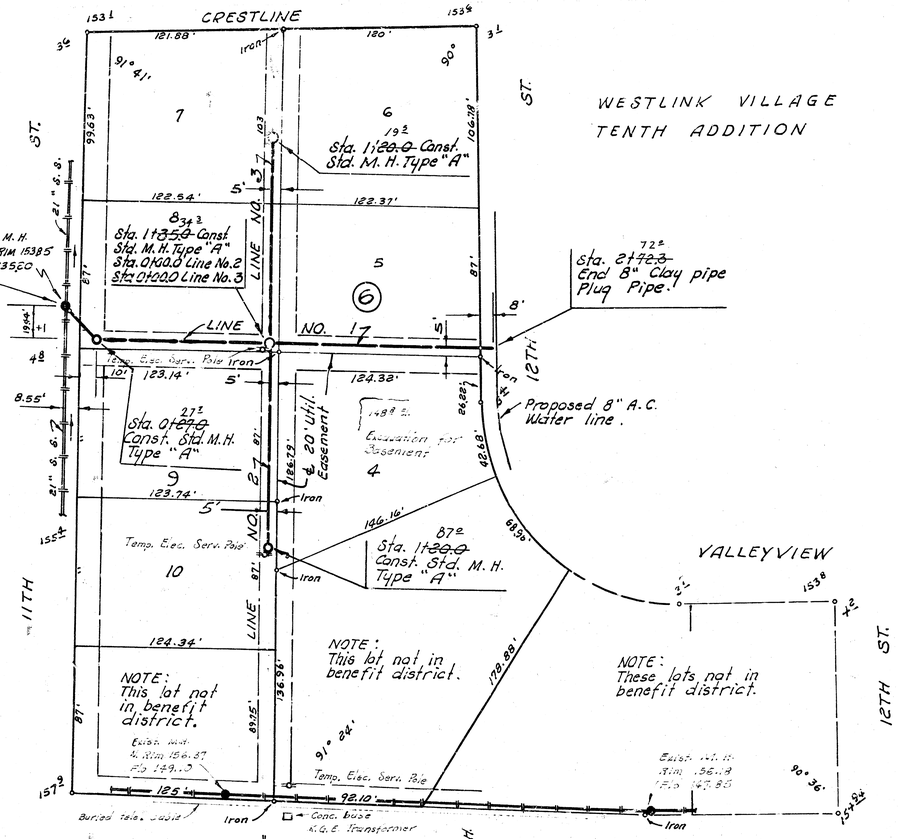

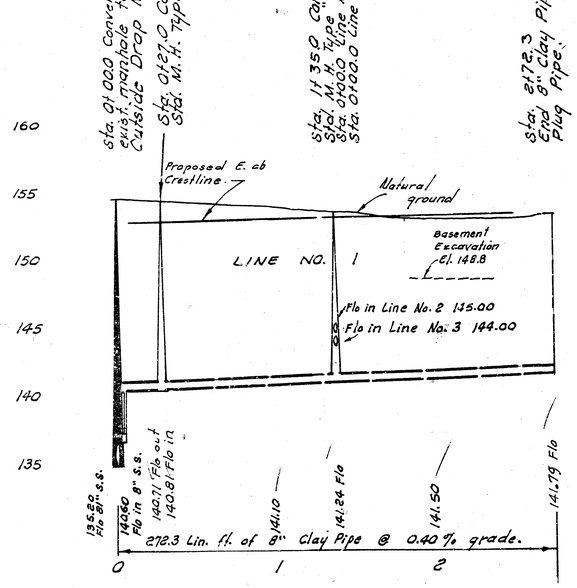

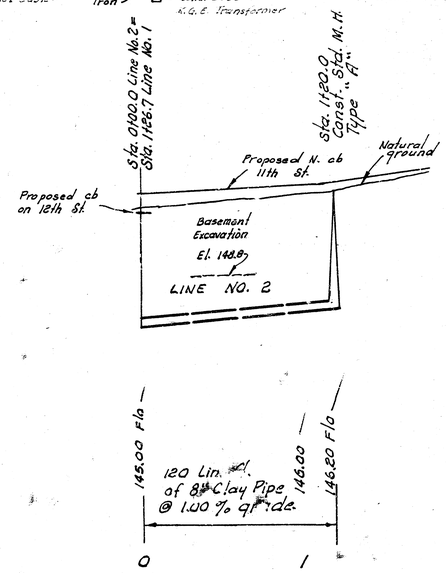

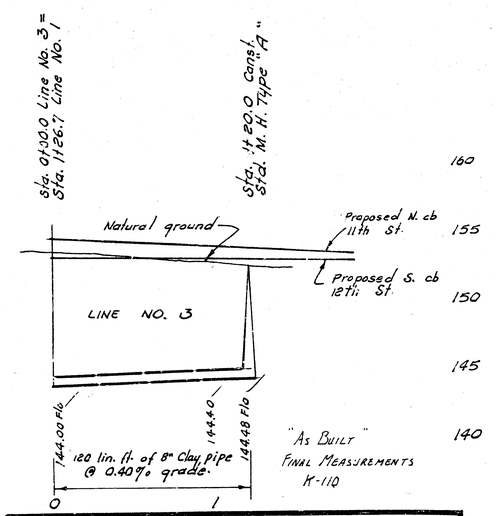

DONALD E. SCHNEIDER LICENSED 6311 KANSAS PROFESSIONAL ENGINEER

LAT. 4, MAIN 2, WESTLINK SEWER

CITY OF WICHITA, KANSAS

R. W. LINN — CITY ENGINEER

NOV. 1972 PROJECT NO. DBKL572052

FILMED FROM THE BEST