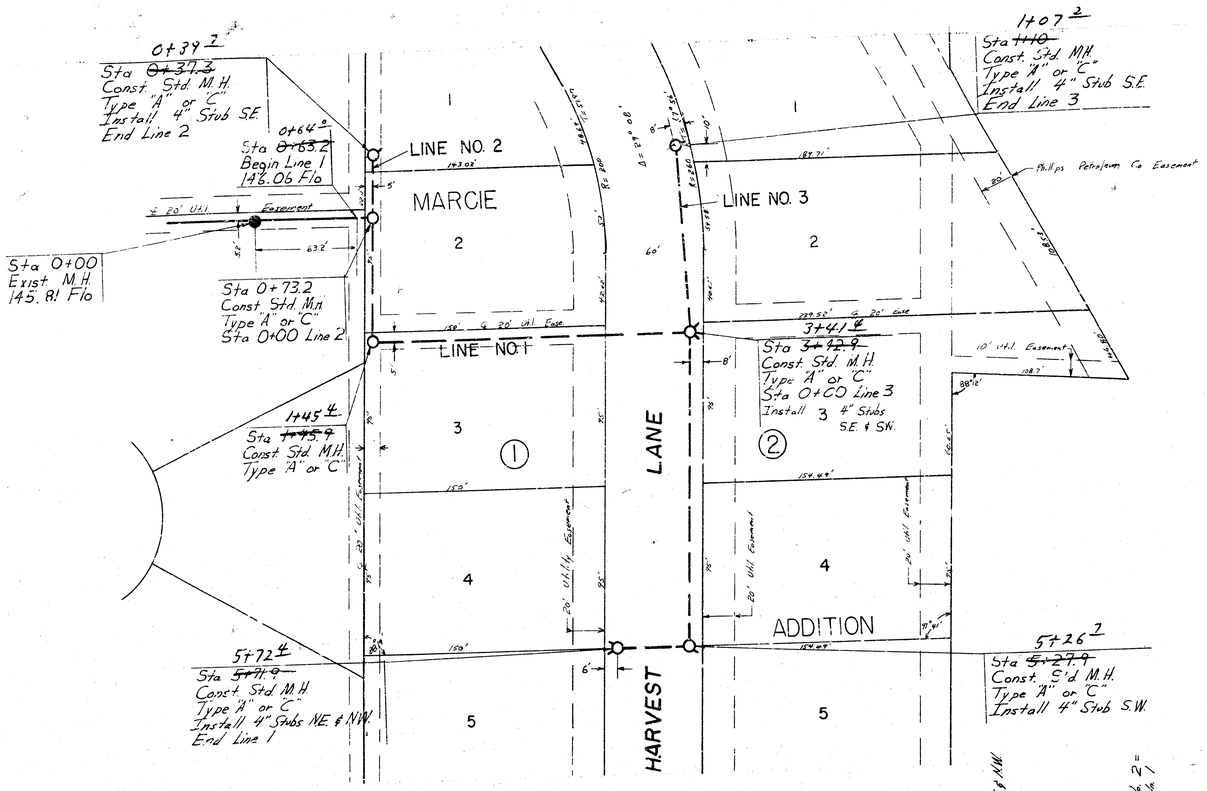



N


Plan Scale 1" = 40'

Profile Scale 1" = 40' Horz.
1" = 5' Vert.

B.M. 159.32 City Std. disc 39.3' S. and 56' E. of ℄ of 13th St. and Maize Rd.

B.M. 168.68 □ on Top Curb @ E.S. Chipper Lane @ N.L. Harvest

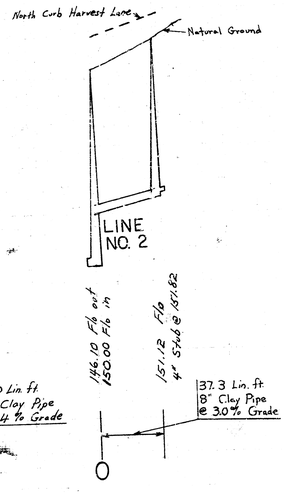

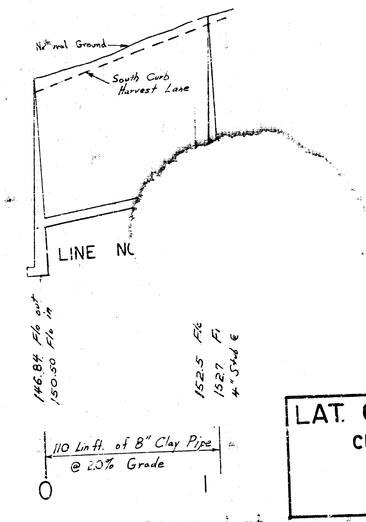

As Built 10-8-75

LAT. 6 MAIN 2 WESTLINK SEWER
CITY OF WICHITA, KANSAS
R. W. LINN — CITY ENGINEER
PROJECT NO. DBKL574093