
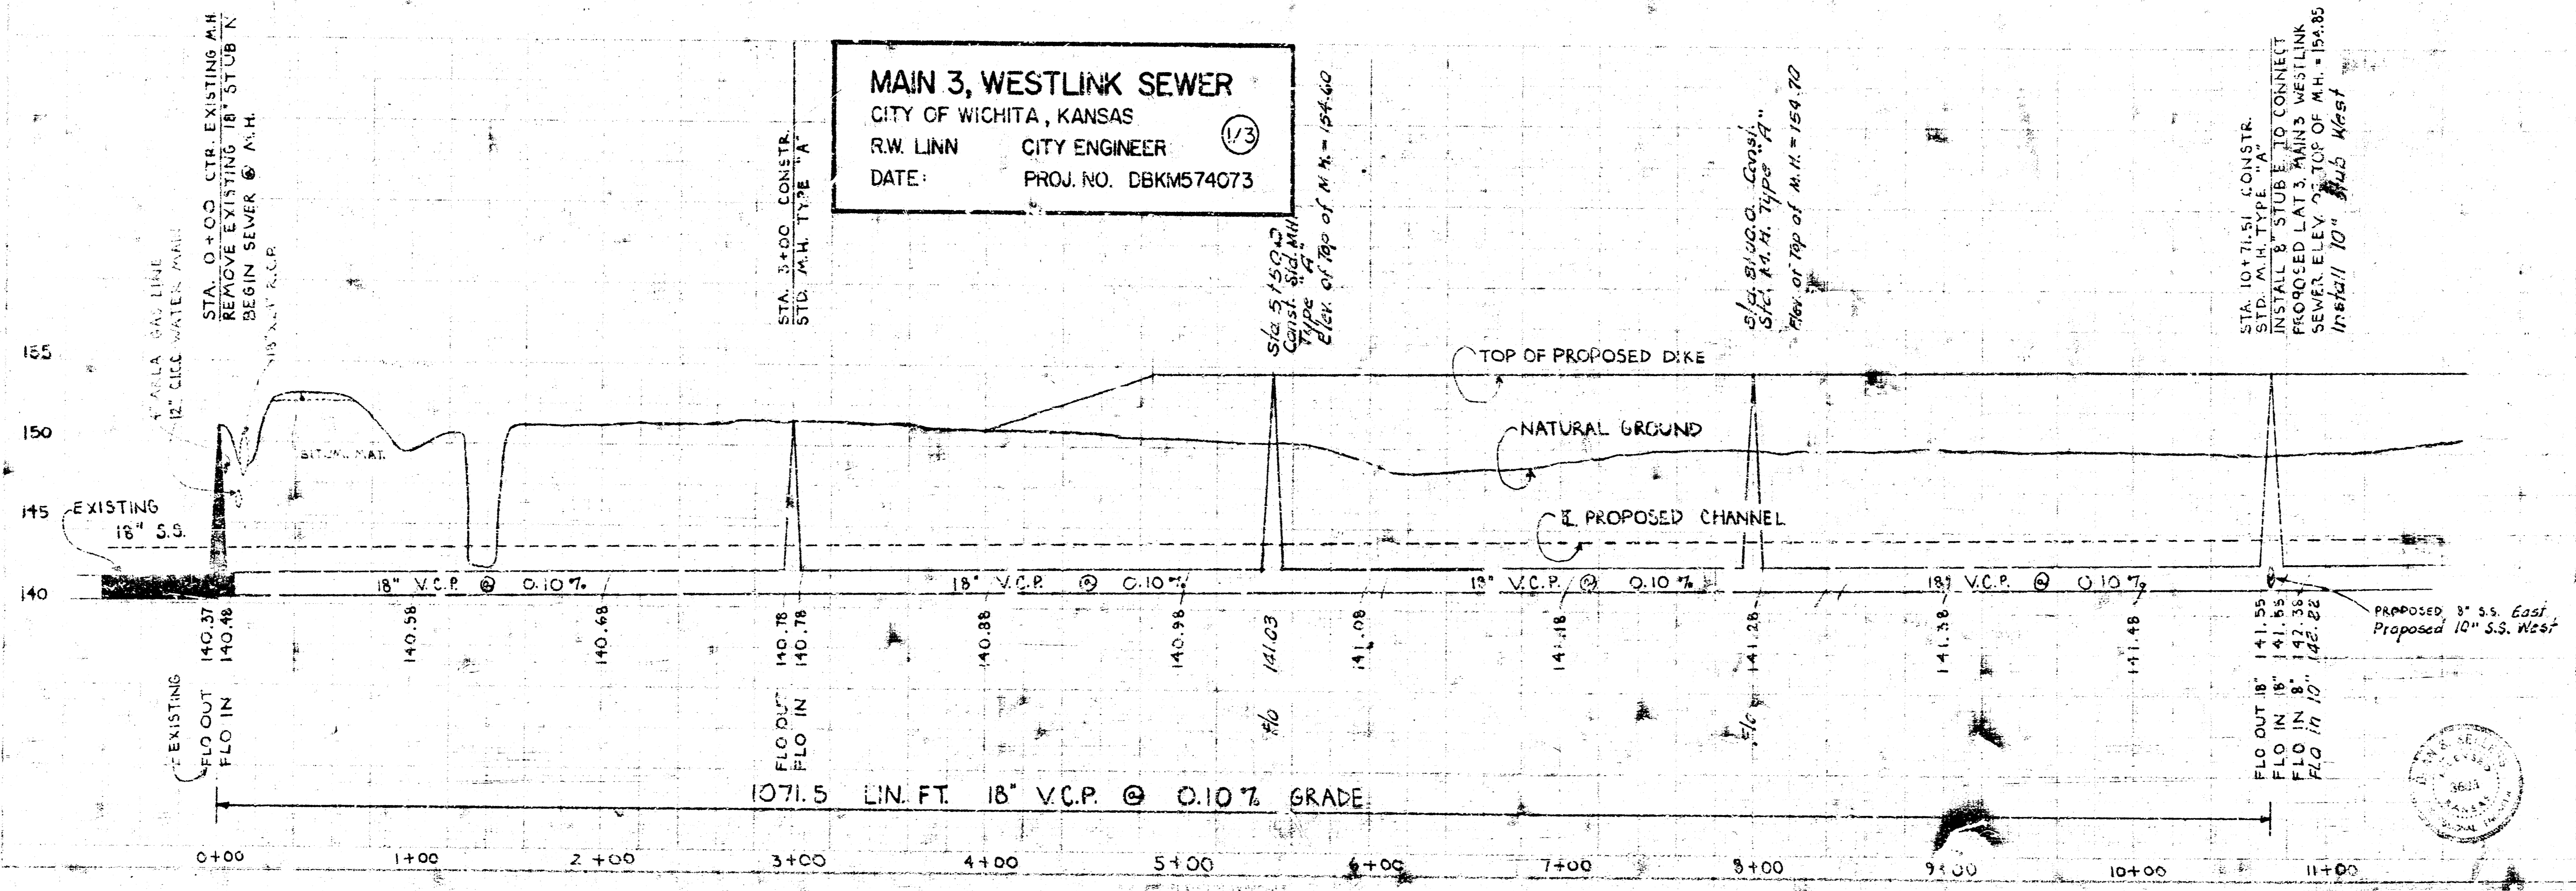


B.M. = 155.69 CITY STD. @ WESTLINK & 13TH ST. TOP W. END N. HANDRAIL TO R.C.B.

PLAN SCALE 1" = 40'  
PROFILE SCALE 1" = 40' HOR.  
1" = 5' VERT.

NOTE TO FIELD ENGINEER & CONTRACTOR  

STA. 10+71.51 CONSTR.  
STD. M.H. TYPE "A". INSTALL  
8" STUB E. TO CONNECT PROPOSED  
LAT. 3, MAIN 3 WESTLINK SEWER  
Install 10" Stub West

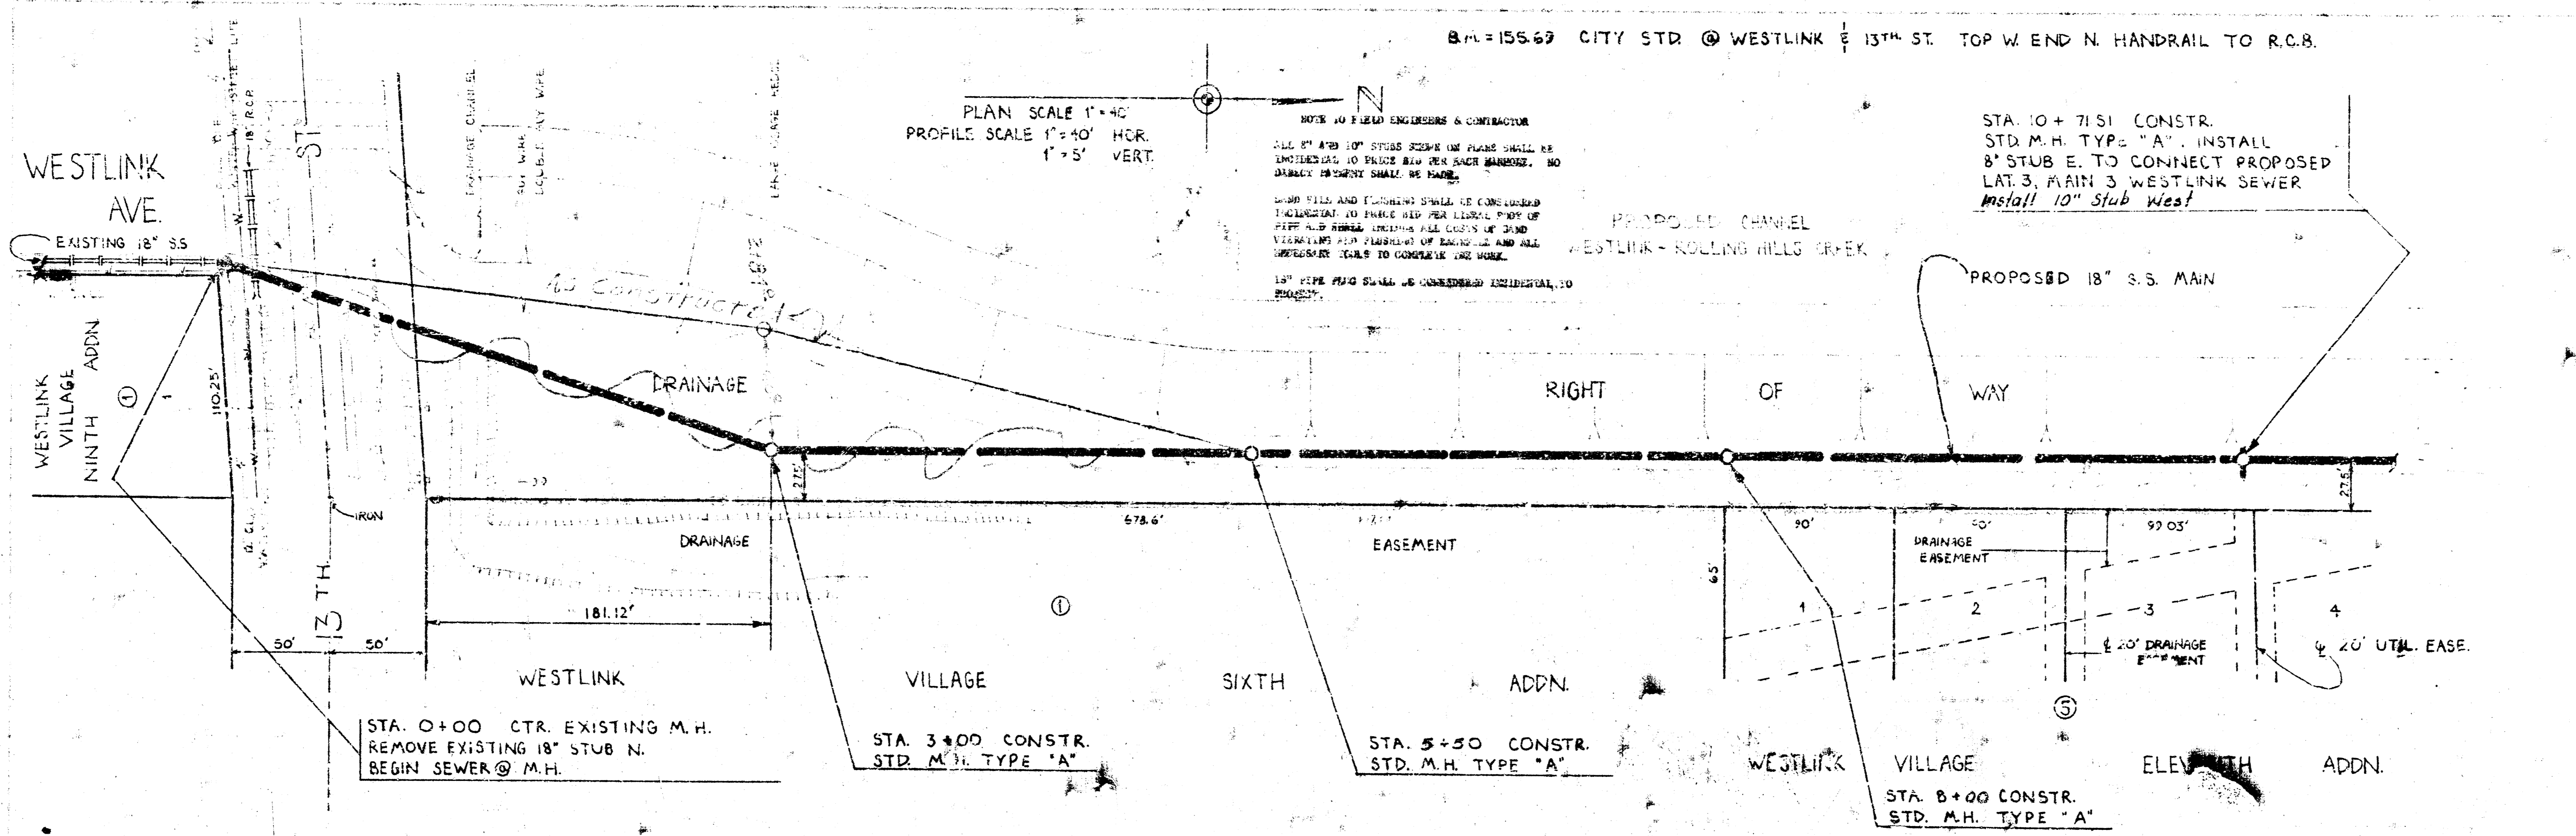


**MAIN 3, WESTLINK SEWER**  
CITY OF WICHITA, KANSAS  
R.W. LINN CITY ENGINEER  
DATE: PROJ. NO. DBKM574073

236

155


145

140

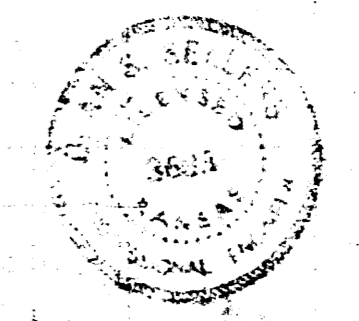




PLAN SCALE 1" = 40'  
 PROFILE SCALE 1" = 40' HOR.  
 1" = 5' VERT.

B.M. = 155.69 CITY STR @ WESTLINK 131' TOP W. END N. HANDRAIL TO R.C.B.

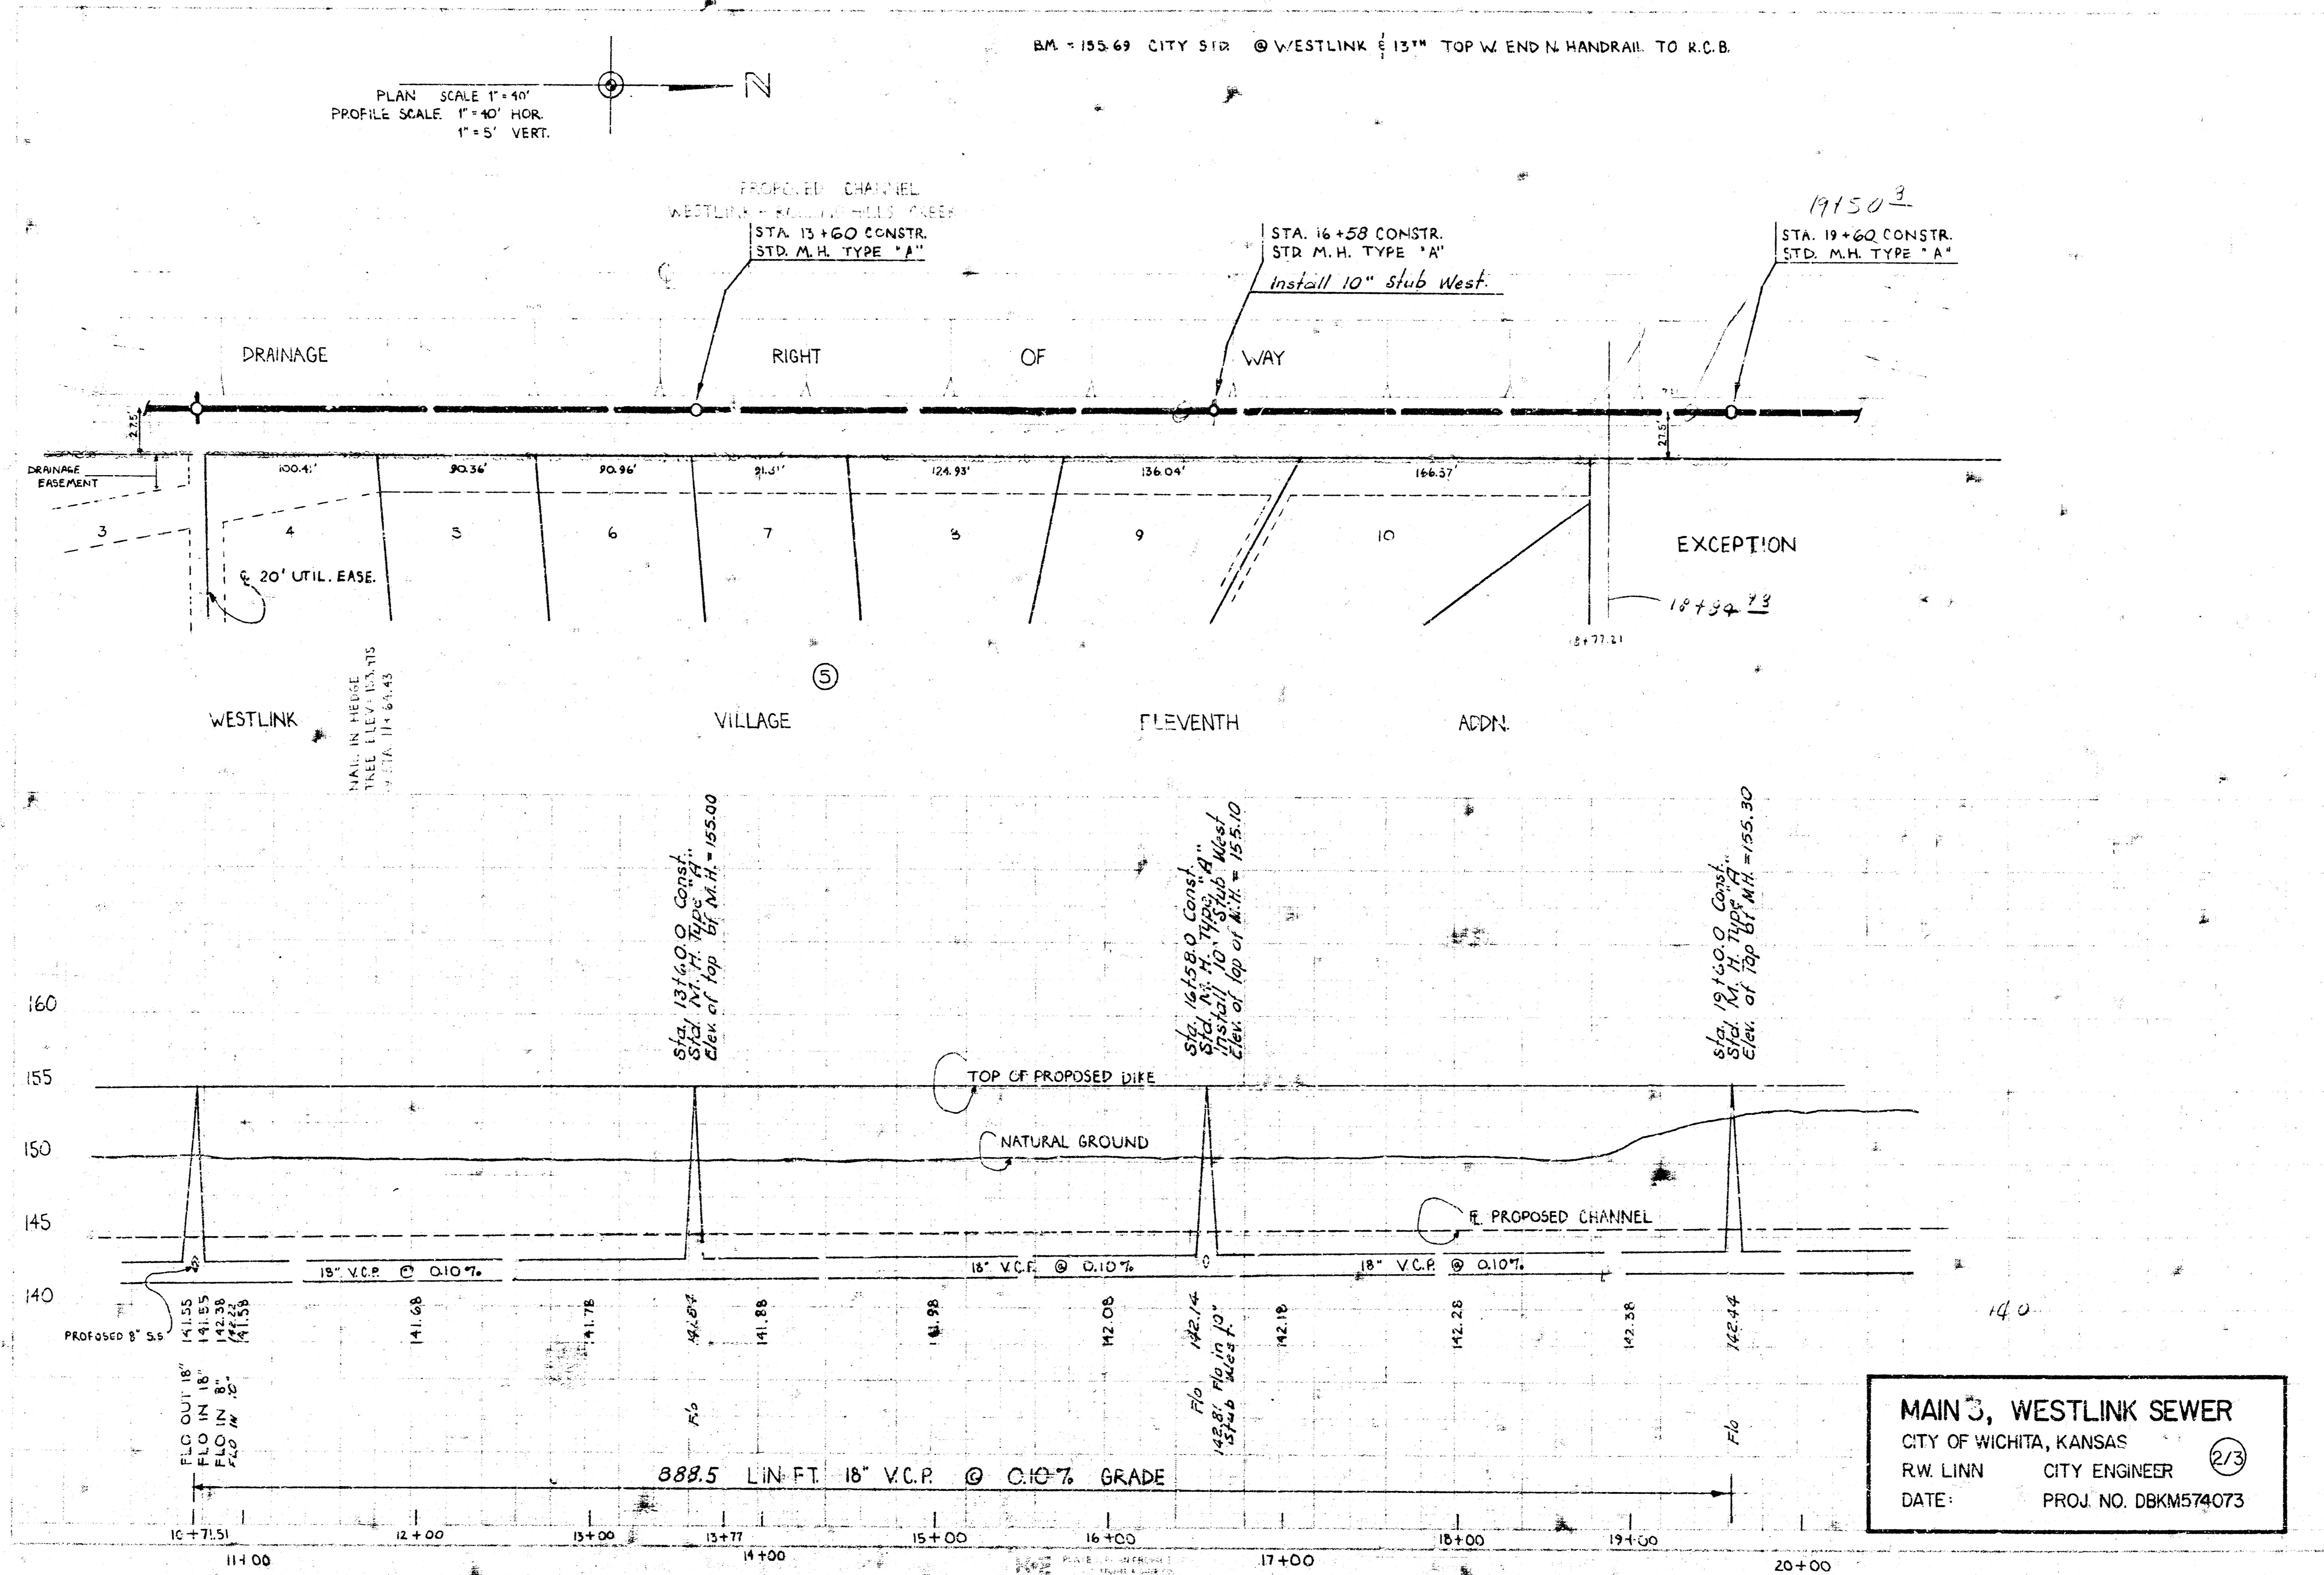

**MAIN 3, WESTLINK SEWER**  
 CITY OF WICHITA, KANSAS  
 R.W. LINN CITY ENGINEER  
 DATE: PROJ. NO. DBKM574073

B.M. 155.69 CITY STR @ WESTLINK @ 137<sup>th</sup> ST. TOP W. END N. HANDRAIL TO R.C.B.

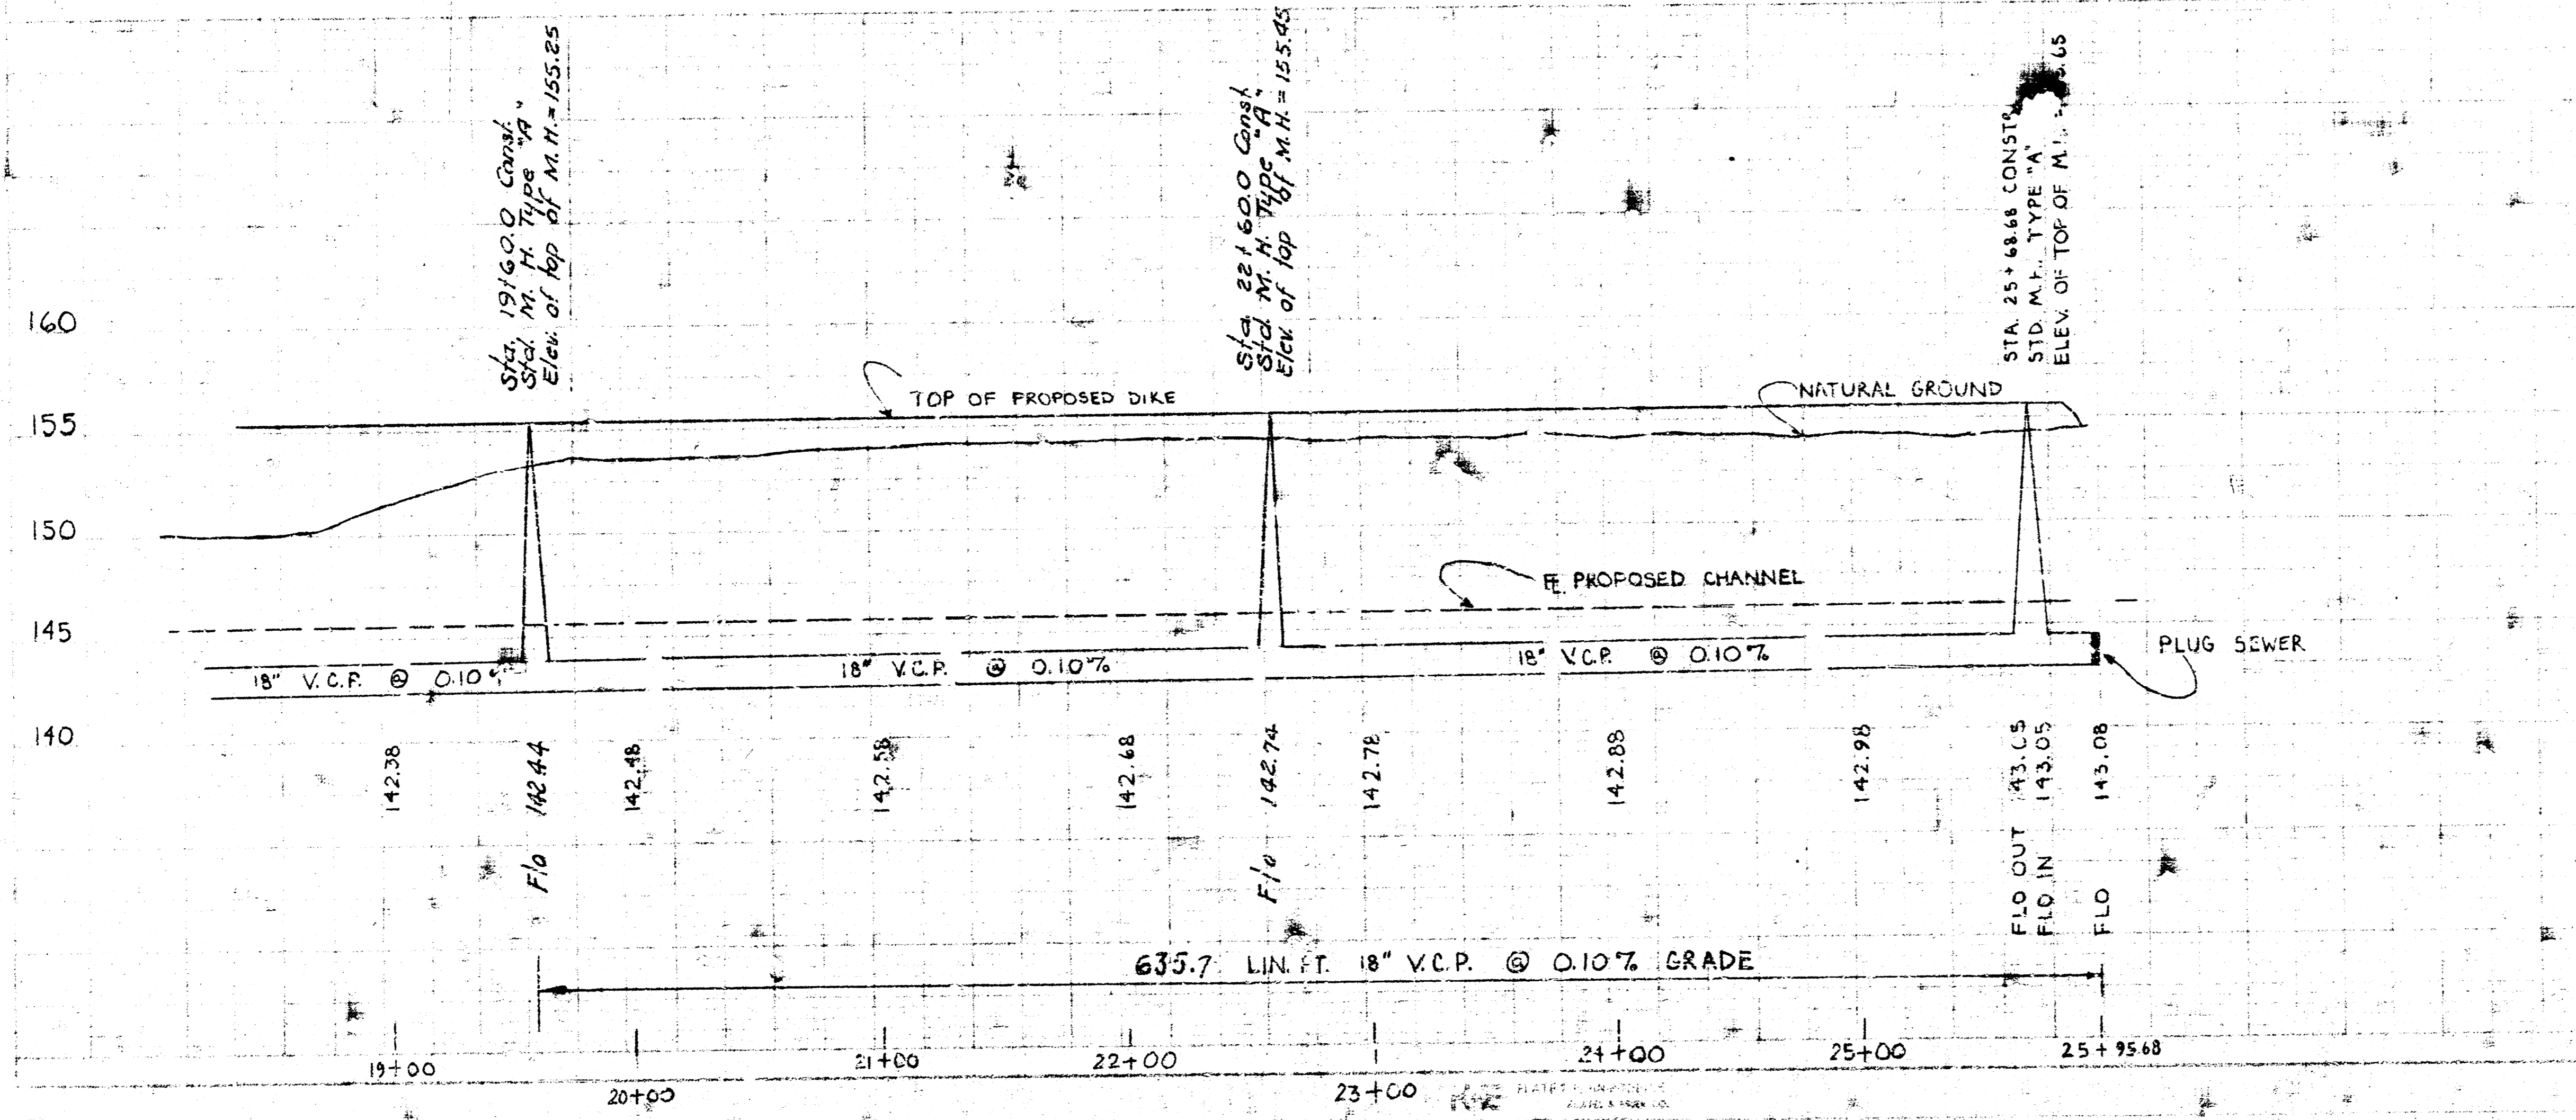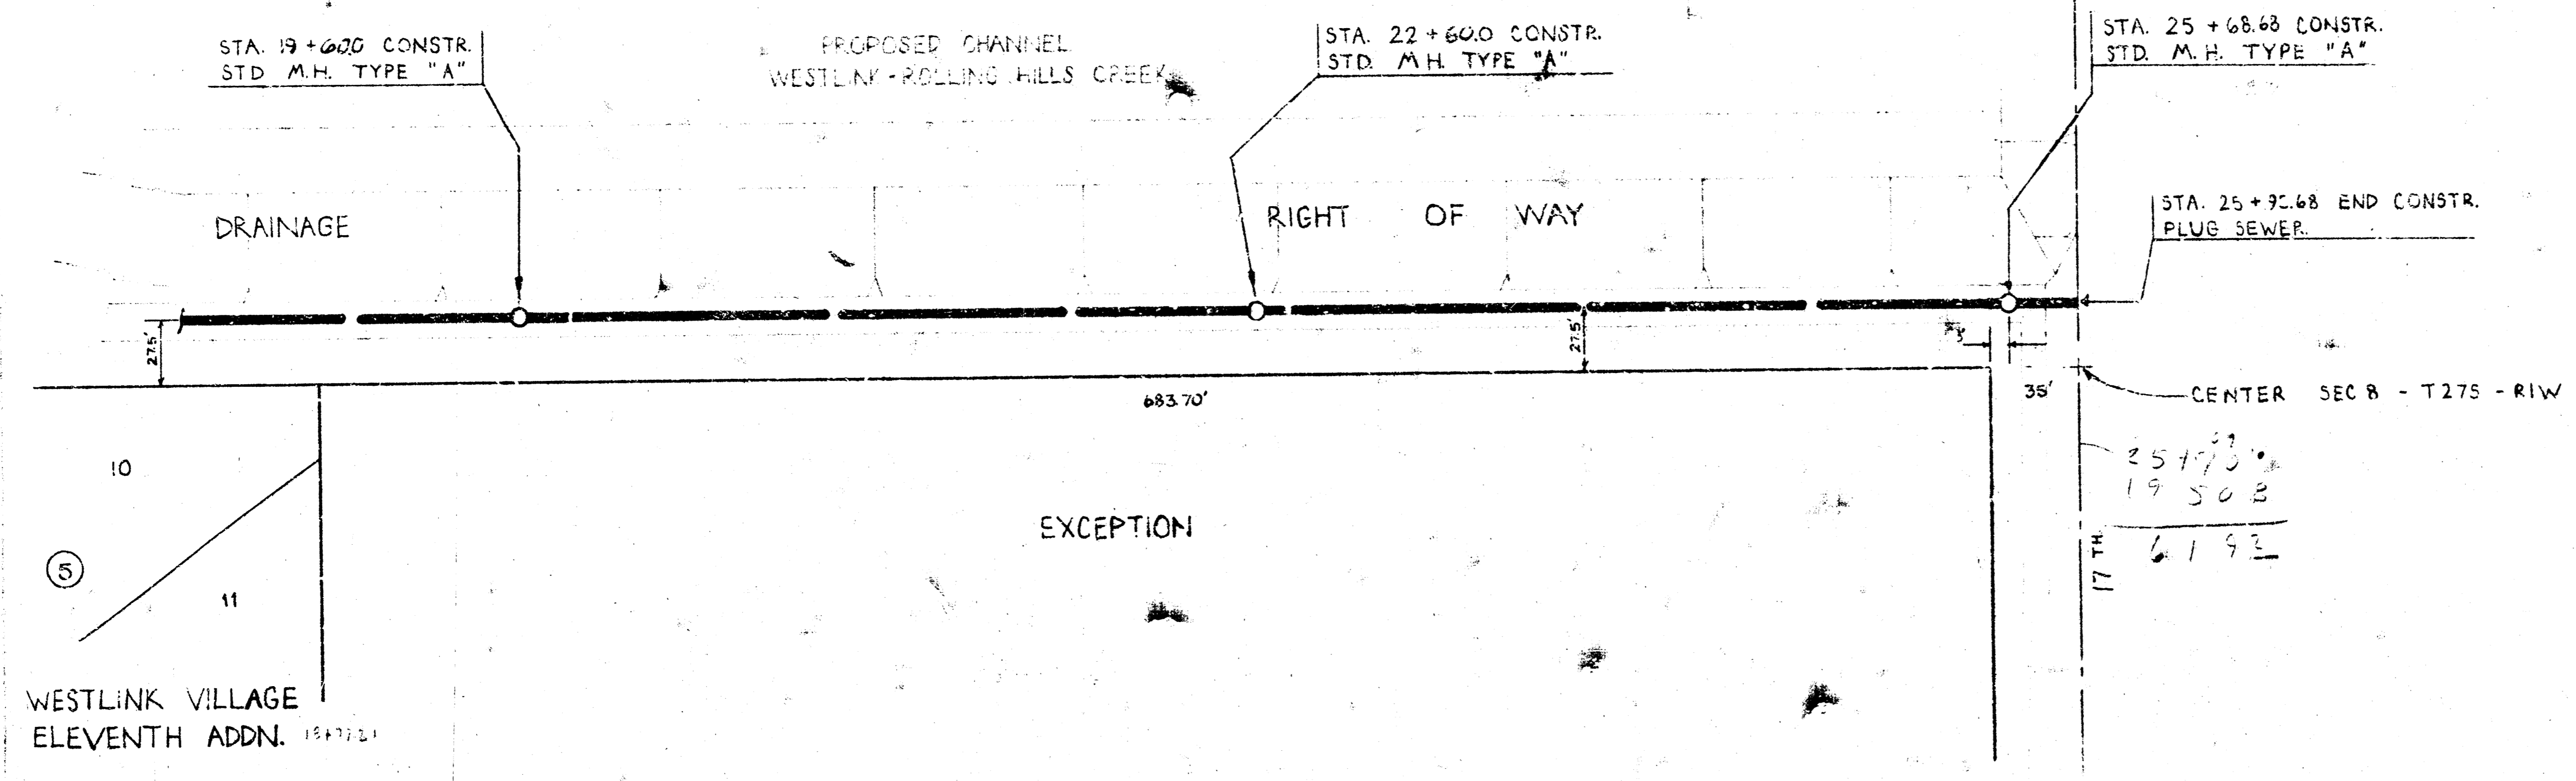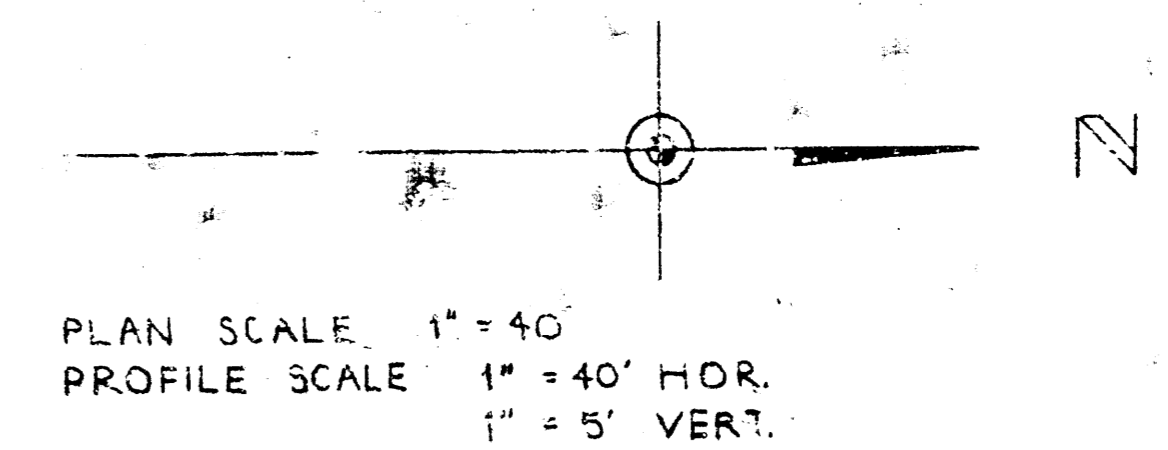

**MAIN 3, WESTLINK SEWER**  
 CITY OF WICHITA, KANSAS  
 R.W. LINN CITY ENGINEER  
 DATE: PROJ. NO. DBKM574073