

B.M. = 155.69 CITY STD @ WESTLINK @ 13TH ST. TOP W. END N. HANDRAIL TO R.C.B.

PLAN SCALE 1" = 40'
 PROFILE SCALE 1" = 40' HOR.
 1" = 5' VERT.


NOTE TO FIELD ENGINEERS & CONTRACTOR

ALL 8" AND 10" STUBS SHOWN ON PLANS SHALL BE INCIDENTAL TO PRICE BID PER EACH MANHOLE. NO DIRECT PAYMENT SHALL BE MADE.

SAND FILL AND FLUSHING SHALL BE CONSIDERED INCIDENTAL TO PRICE BID PER LINEAL FOOT OF PIPE AND SHALL INCLUDE ALL COSTS OF SAND VIBRATING AND FLUSHING OF BACKFILL AND ALL NECESSARY TOOLS TO COMPLETE THE WORK.

18" PIPE PLUG SHALL BE CONSIDERED INCIDENTAL TO PROJECT.

STA. 10 + 71.51 CONSTR. STD. M.H. TYPE "A". INSTALL 8" STUB E. TO CONNECT PROPOSED LAT. 3, MAIN 3 WESTLINK SEWER
 Install 10" Stub West

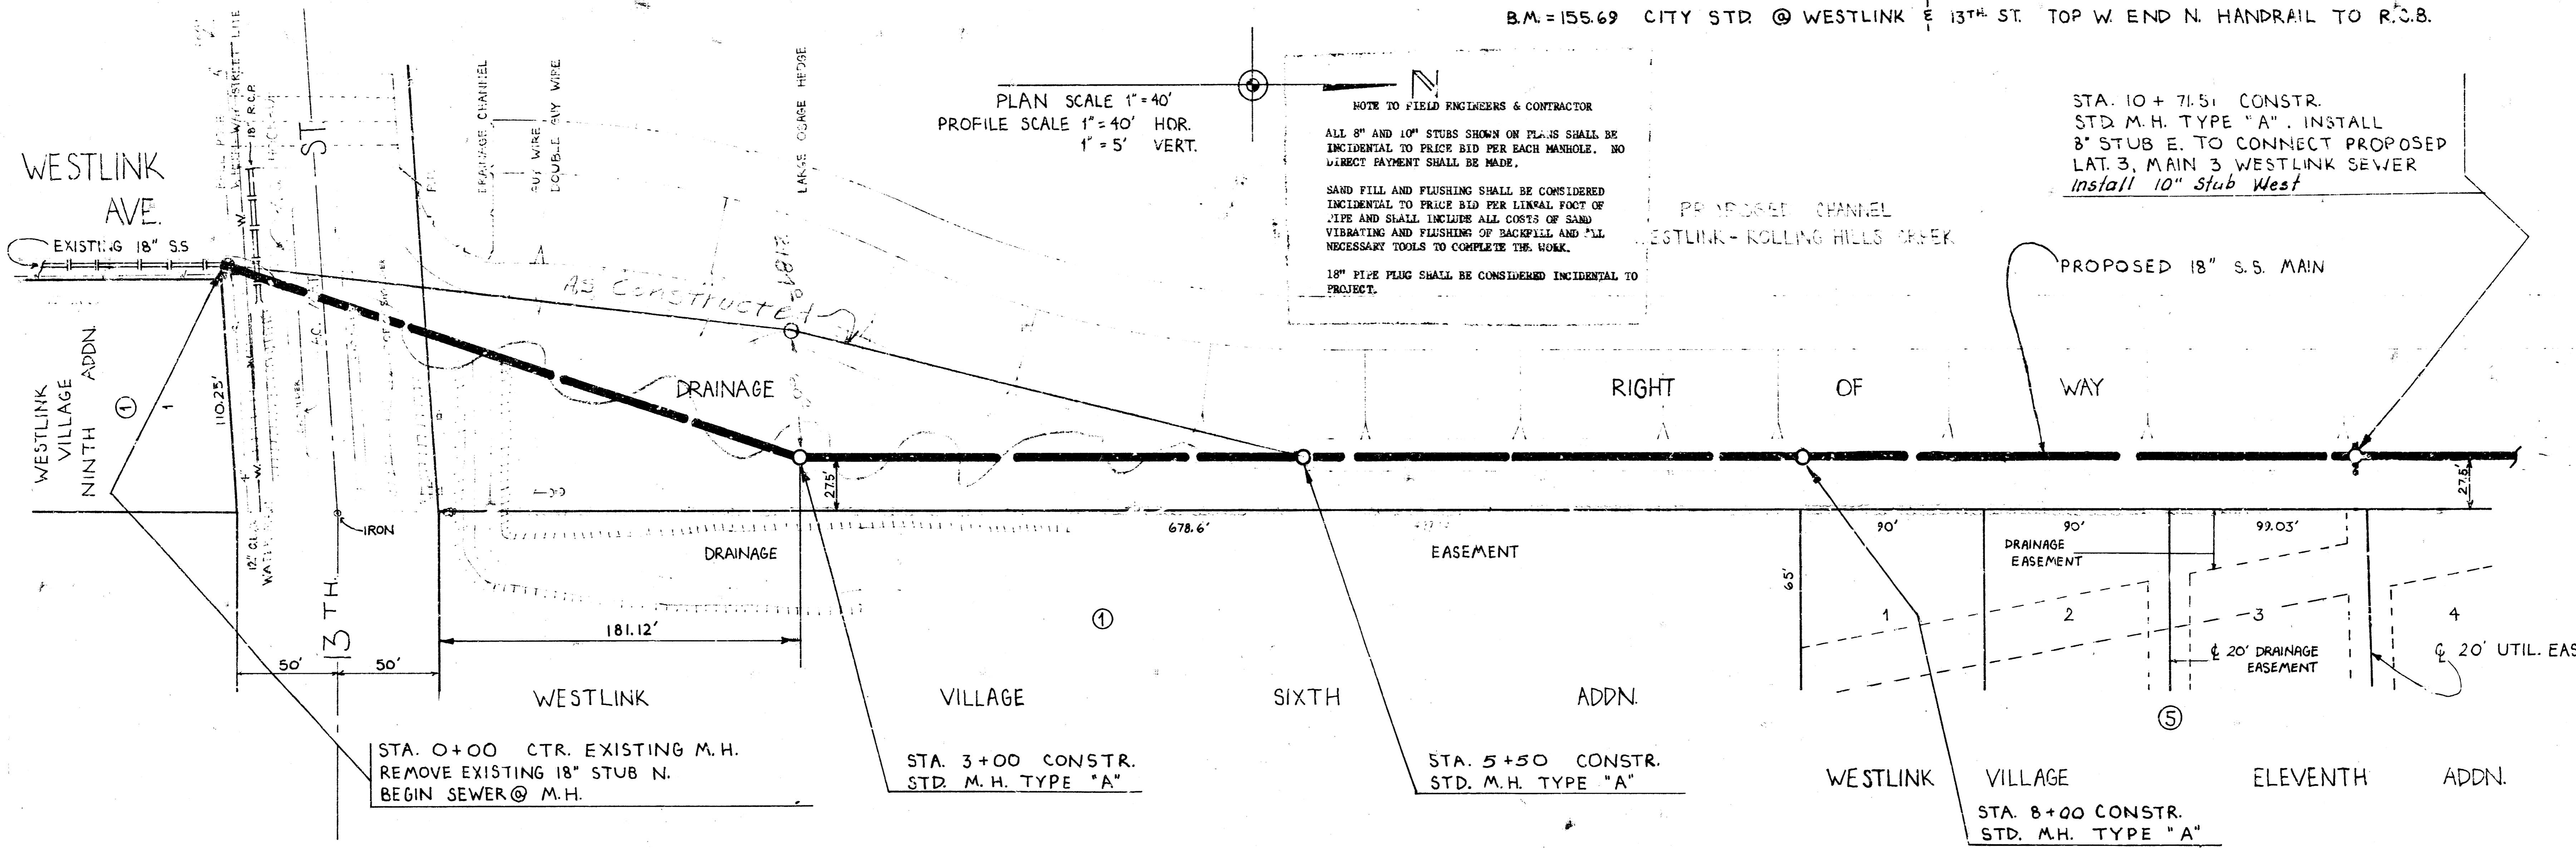


STA. 0+00 CTR. EXISTING M.H. REMOVE EXISTING 18" STUB N. BEGIN SEWER @ M.H.

STA. 3+00 CONSTR. STD. M.H. TYPE "A"

STA. 5+50 CONSTR. STD. M.H. TYPE "A"



STA. 8+00 CONSTR. STD. M.H. TYPE "A"

MAIN 3, WESTLINK SEWER
 CITY OF WICHITA, KANSAS
 R.W. LINN CITY ENGINEER
 DATE: PROJ. NO. DBKM574073

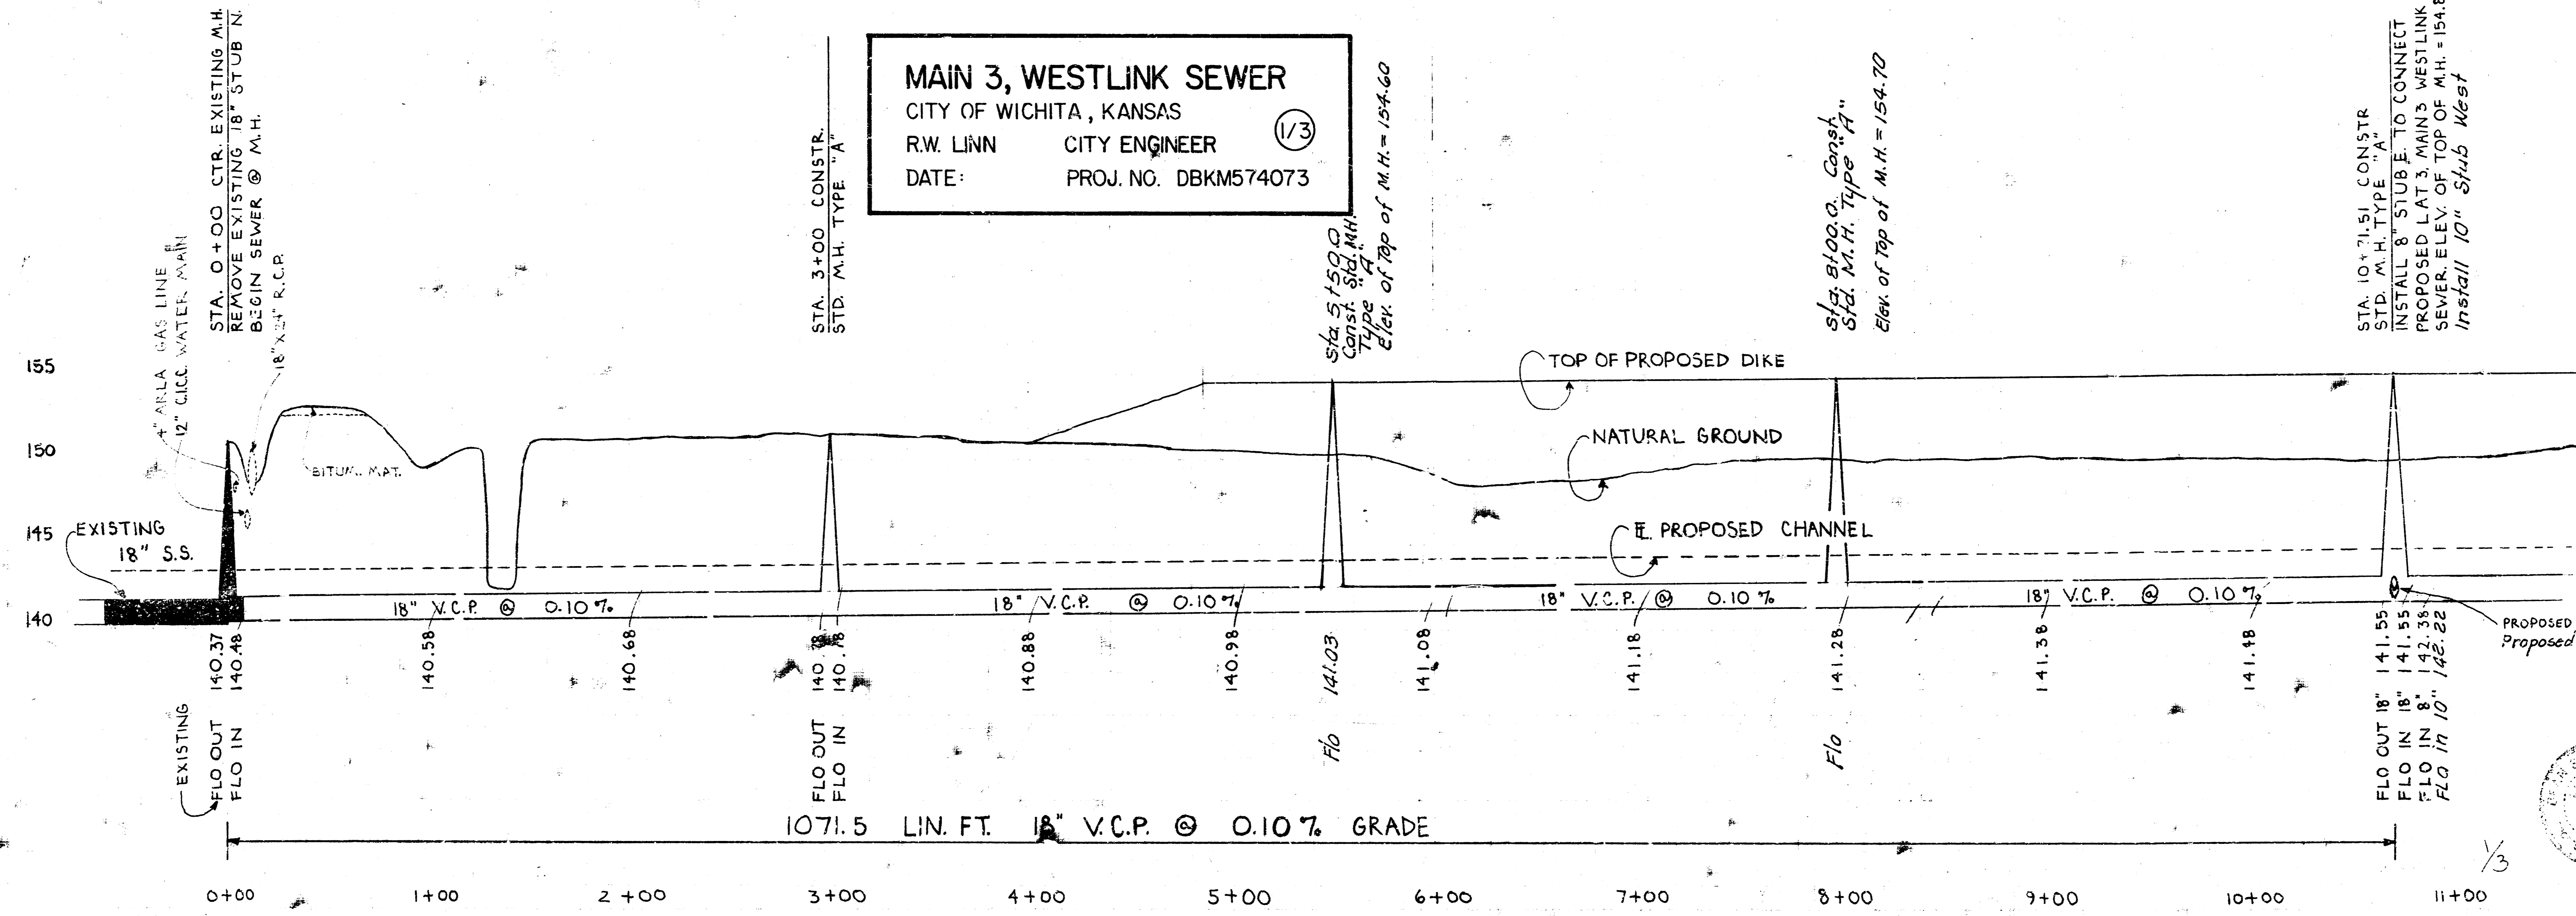

PLAN SCALE 1" = 40'
 PROFILE SCALE 1" = 40' HOR.
 1" = 5' VERT.




B.M. = 155.69 CITY STD @ WESTLINK @ 13" TOP W. END N. HANDRAIL TO R.C.B.

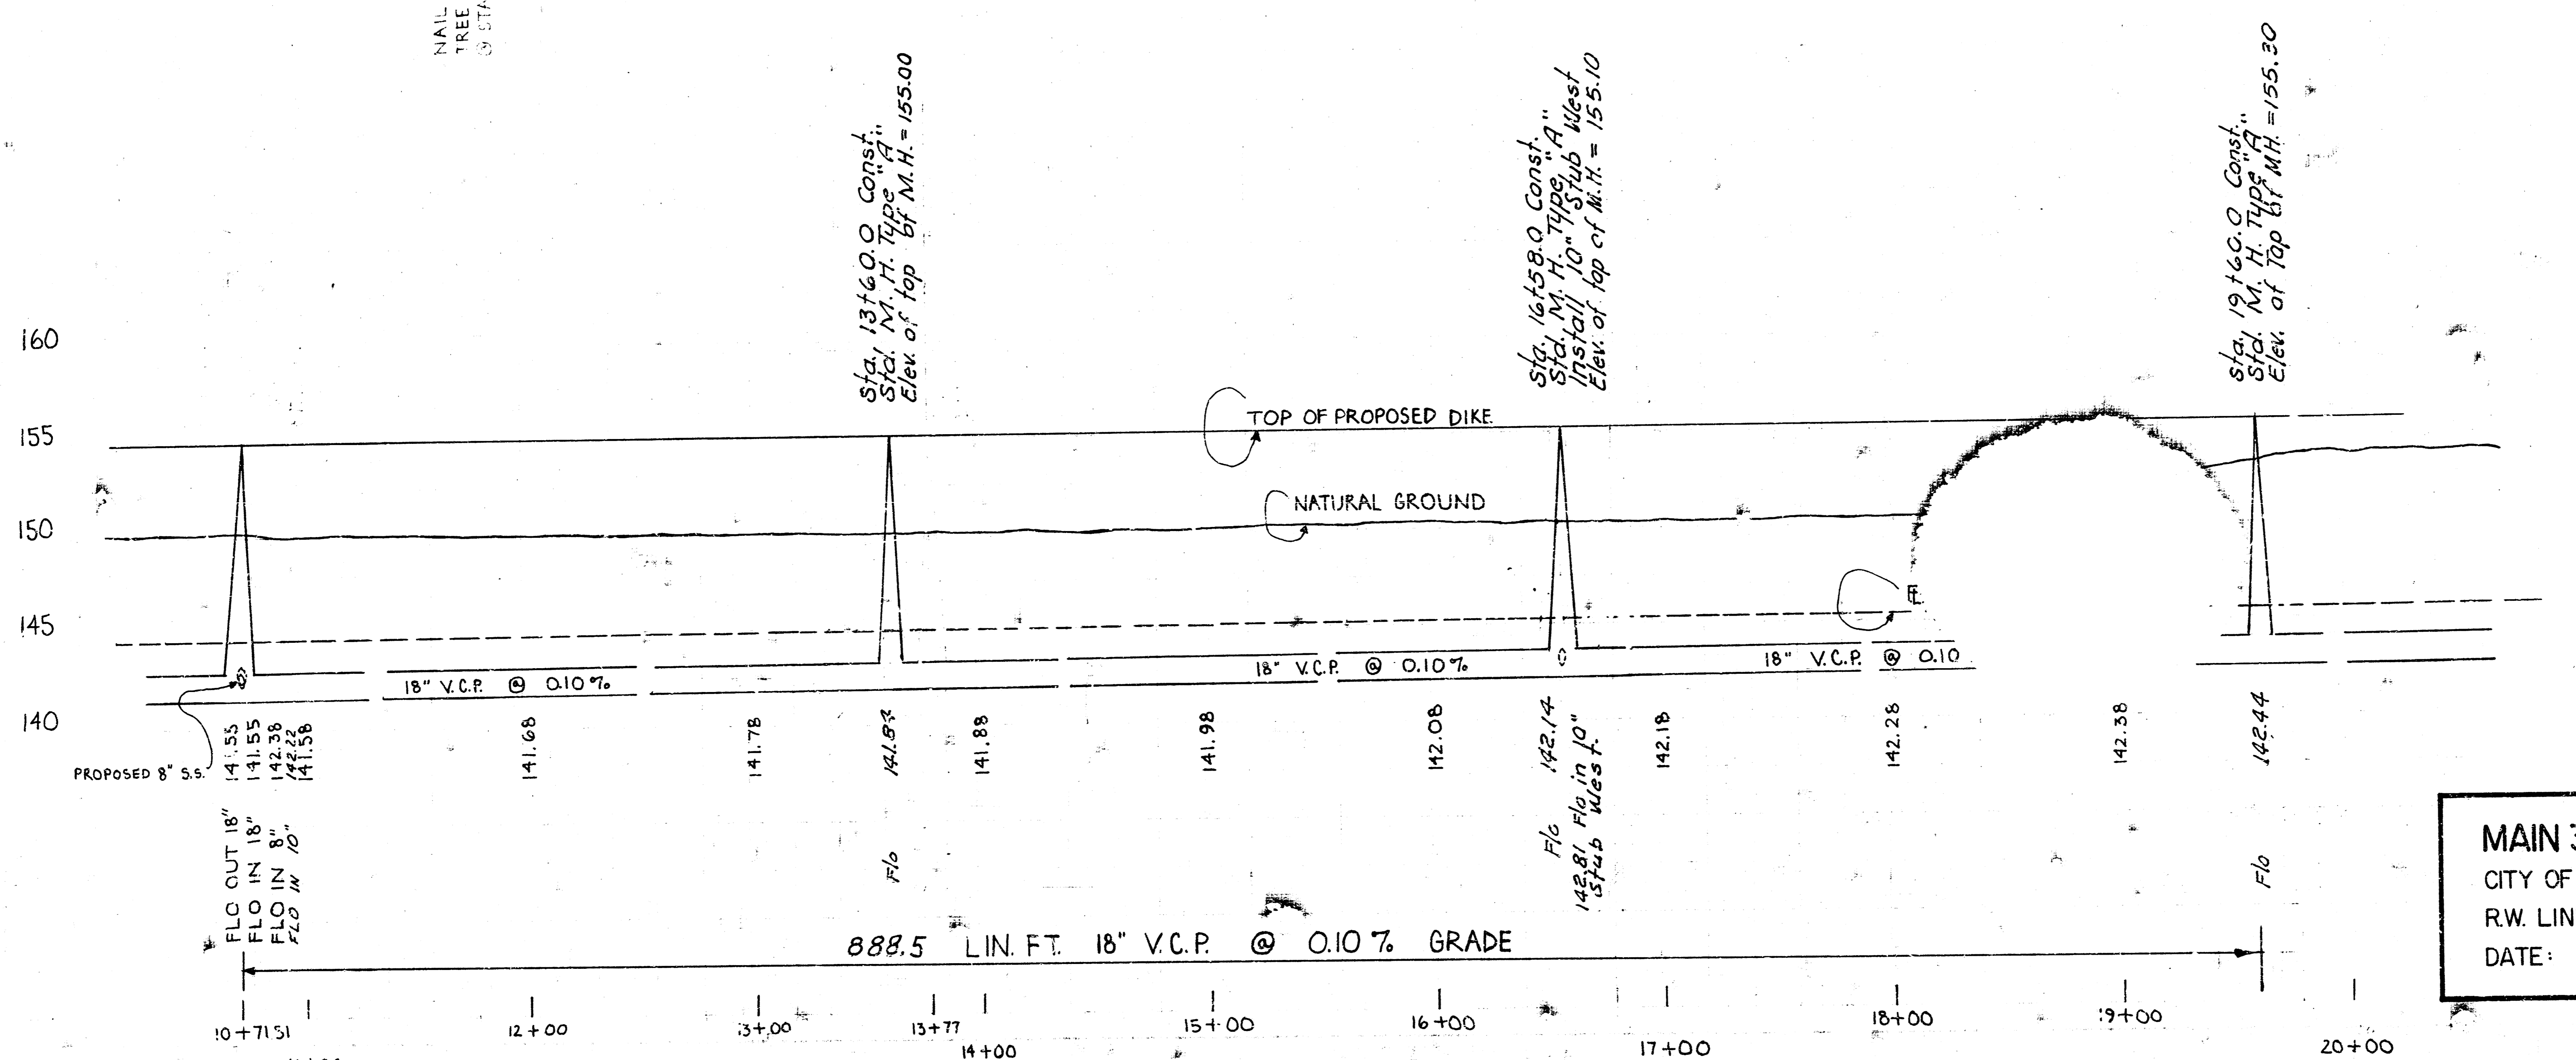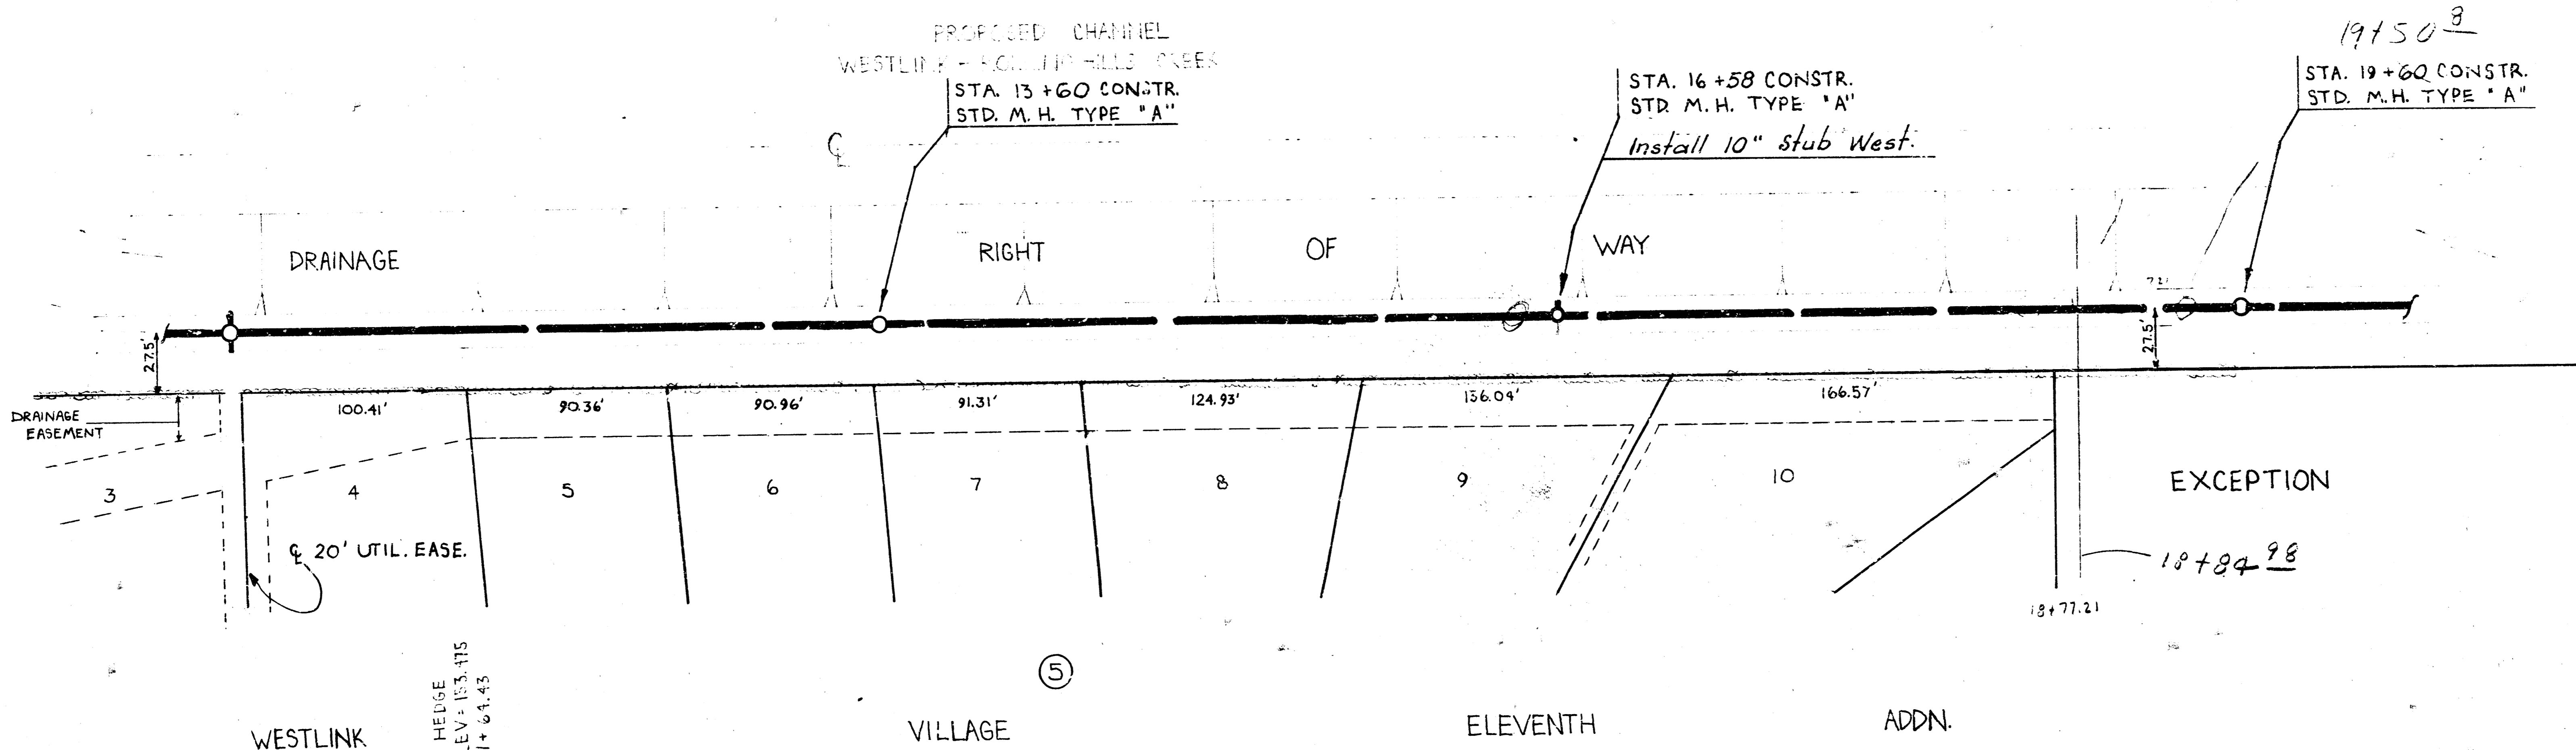

MAIN 3, WESTLINK SEWER
 CITY OF WICHITA, KANSAS
 R.W. LINN CITY ENGINEER 2/3(2/3)
 DATE: PROJ. NO. DBKM574073

140

B.M. = 155.69 CITY STR @ WESTLINK @ 13TH ST. TOP W. END N. HANDRAIL TO R.C.B.

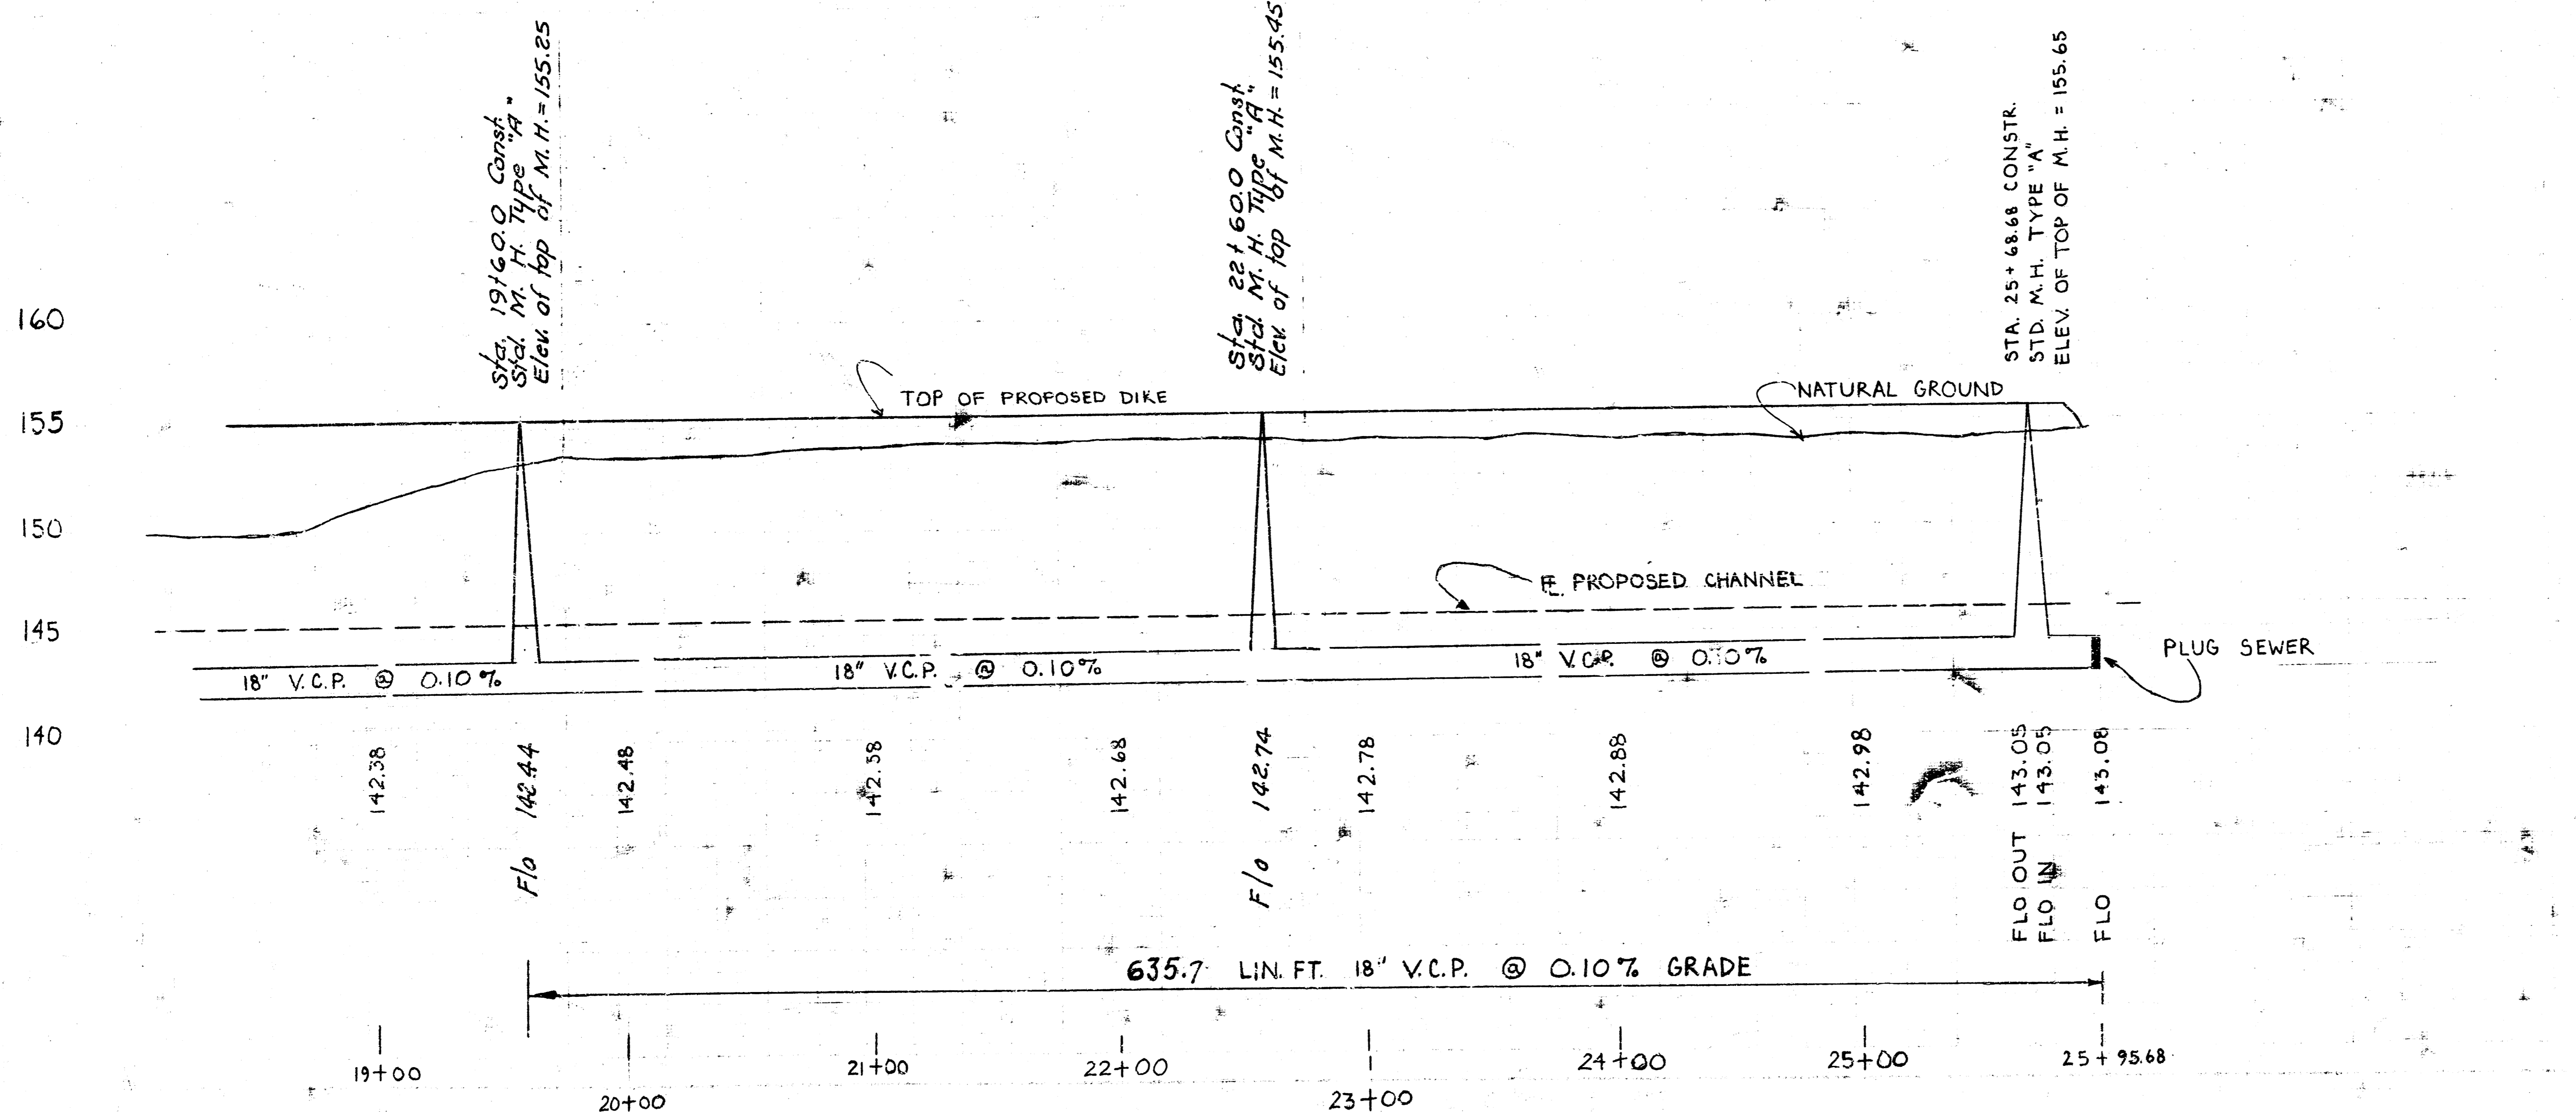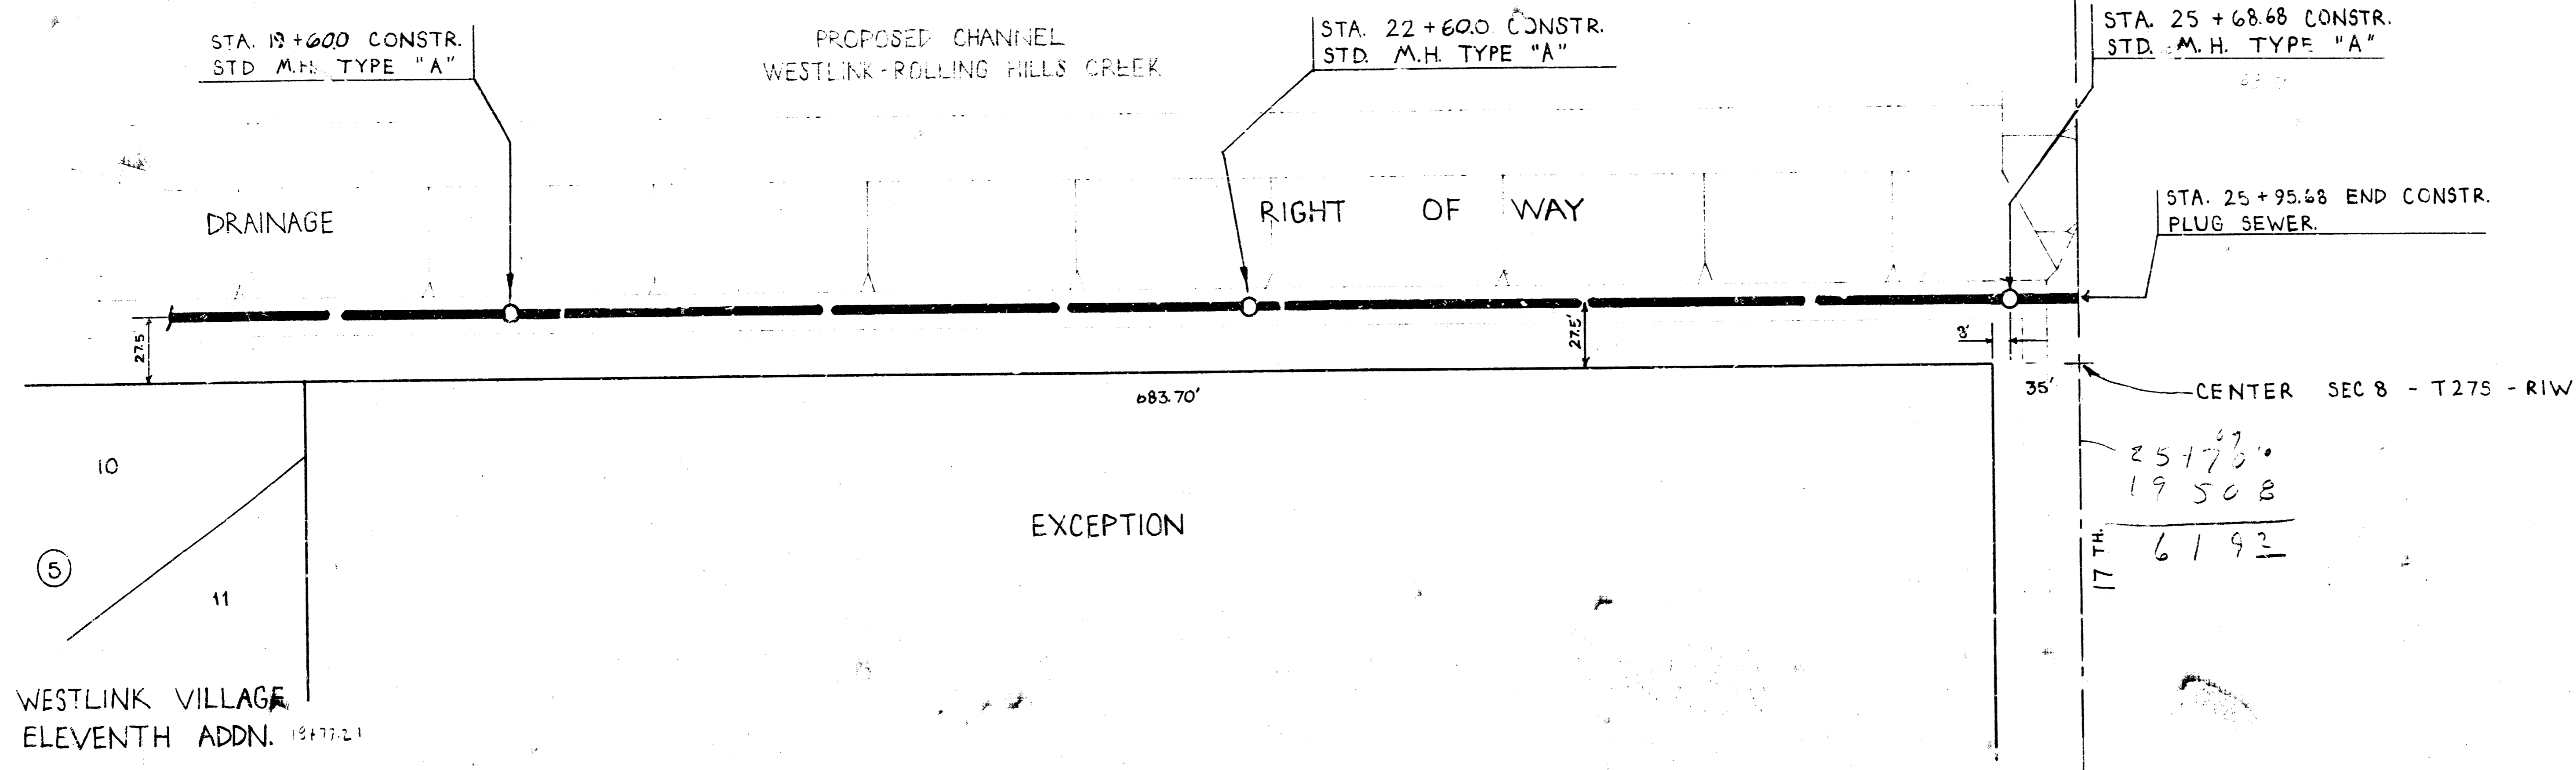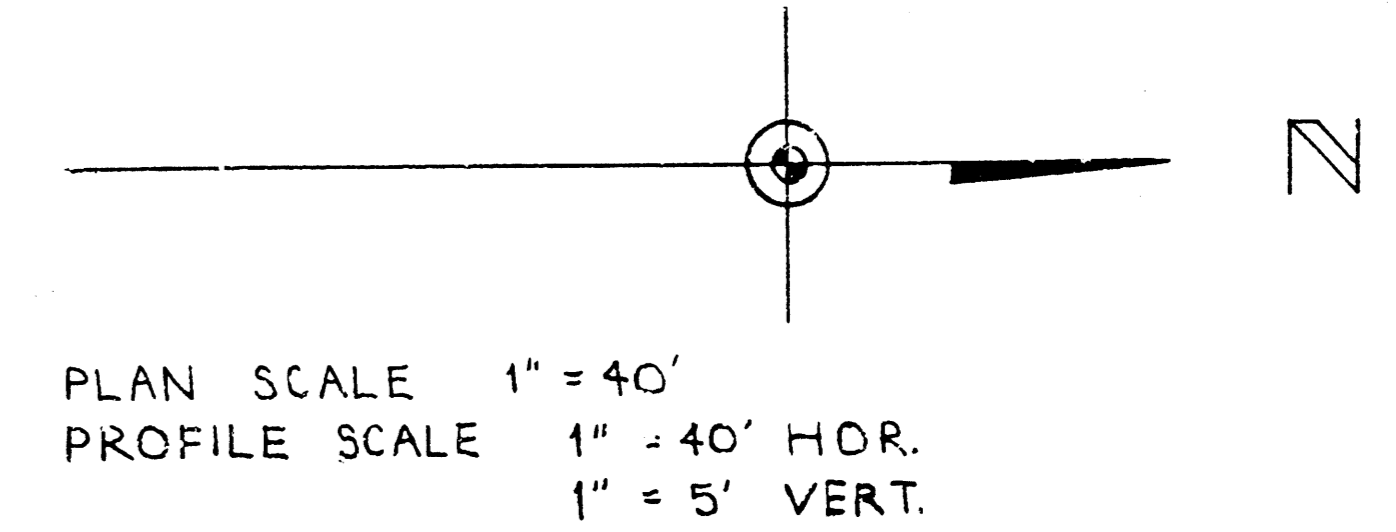

MAIN 3, WESTLINK SEWER
 CITY OF WICHITA, KANSAS 3/3
 R.W. LINN CITY ENGINEER (3/3)
 DATE: PROJ. NO. DBKM574073