
B. M. 158.58 N.W. cor. conc. porch, W. S. House 1502 MURRAY.

Plan. Scale 1" = 40'
Profile Scale 1" = 40' Hor.
1" = 5' Vert.

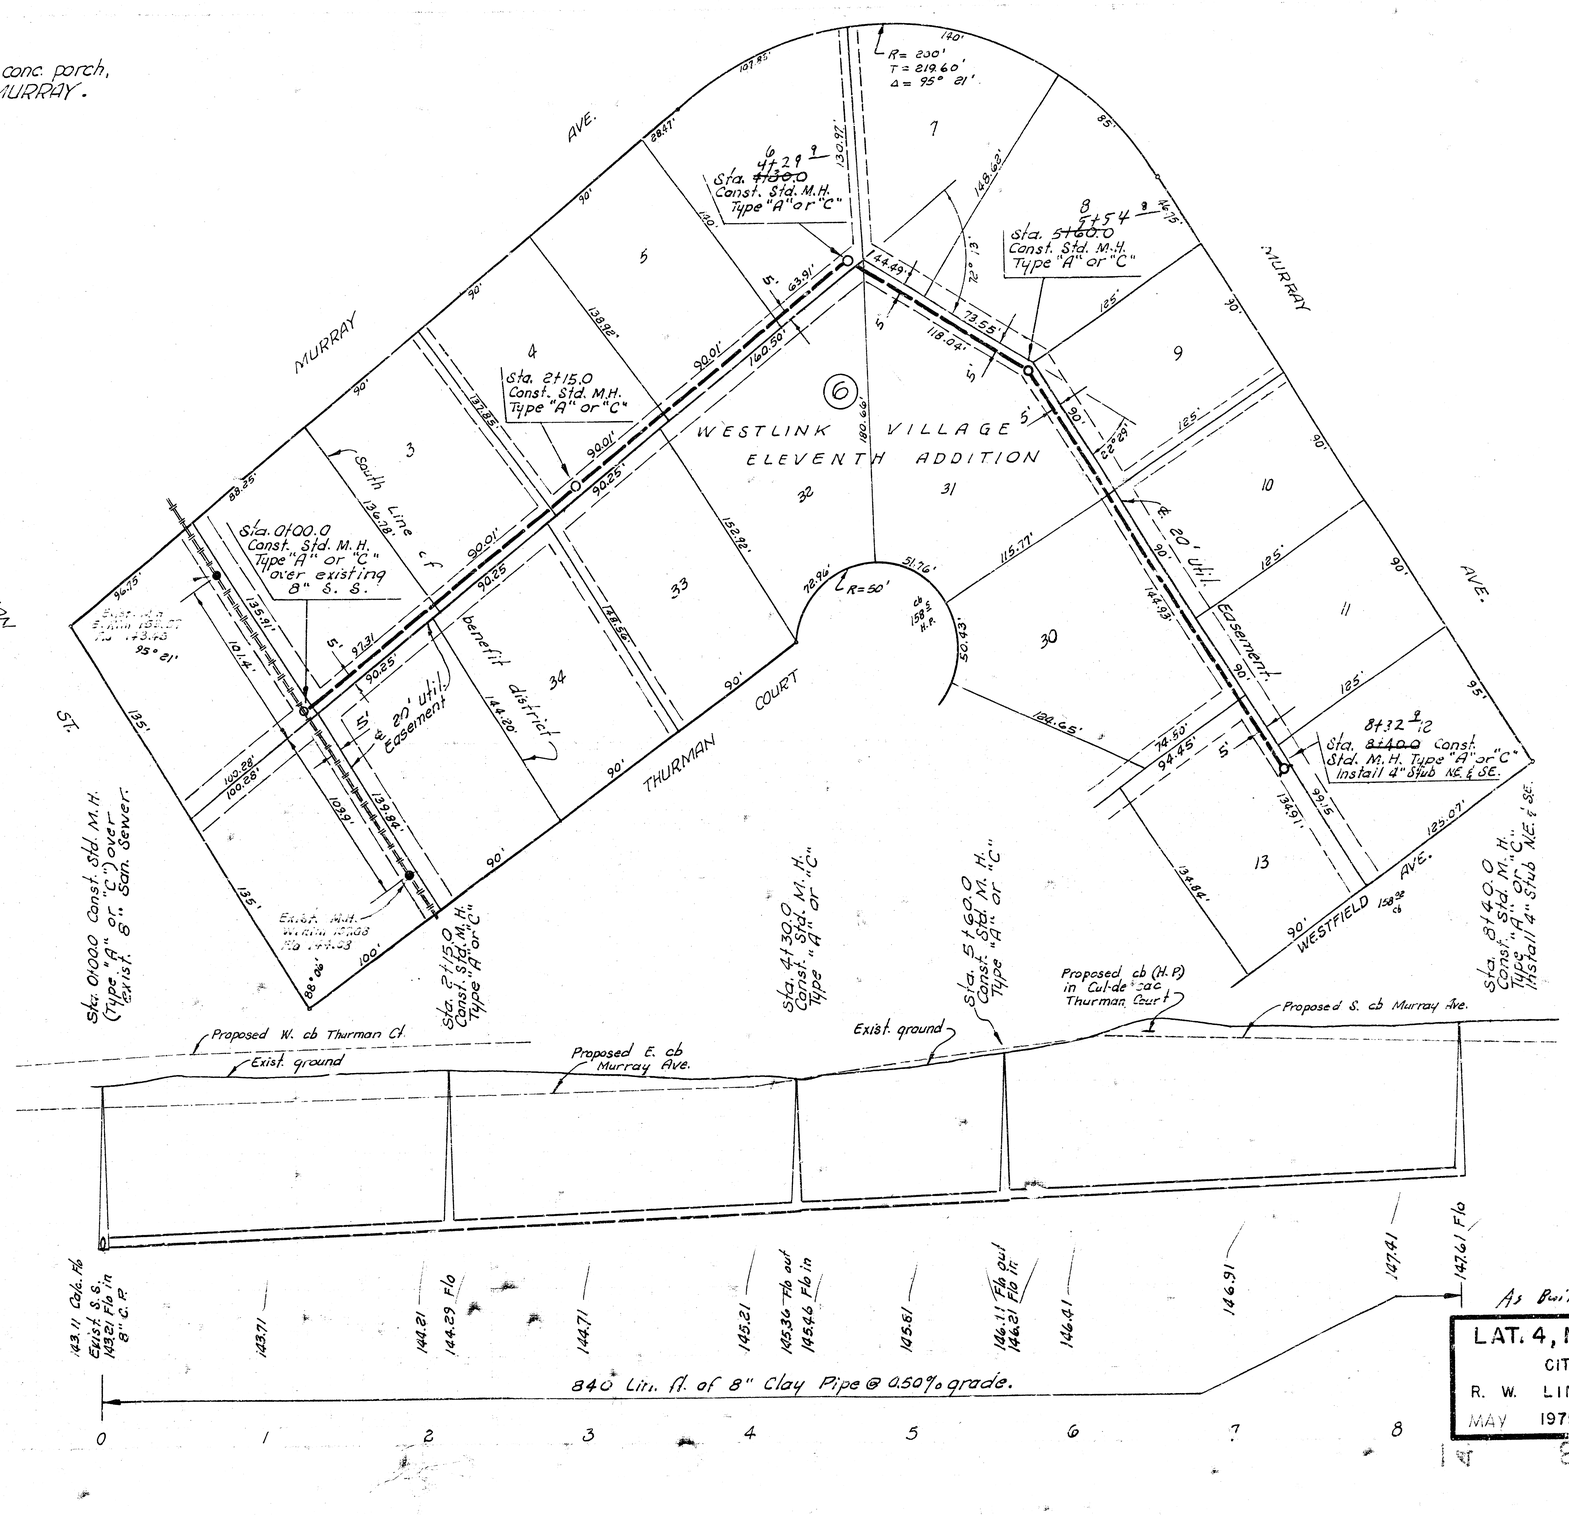

DONALD E. SCHNEIDER LICENSED 6311 KANSAS PROFESSIONAL ENGINEER

LAT. 4, MAIN 3, WESTLINK SEWER
CITY OF WICHITA, KANSAS
R. W. LINN — CITY ENGINEER
MAY 1975 PROJECT NO. DBKL57402B