PLAN SCALE 1" = 40'
PROFILE SCALE 1" = 40' HOR.
1" = 5' VERT.

STA. 0+00 CENTER PROPOSED M.H. ON PROPOSED LAT 3, MAIN 3. BEGIN S.S. @ PROPOSED 8" STUB E.

B.M. = 158.97 N.E. COR. CONC. PORCH, HO. # 9125 THURMAN

STA. 6+00 CONSTR. STD. M.H. TYPE "A" OR "C"

STA. 3+04.7 CONSTR. STD. M.H. TYPE "A" OR "C"

WESTLINK VILLAGE

ELEVENTH ADDN.

CHERYL PLACE

WOOD DR.

BYRON RD.

PROPOSED S.S. LAT. 3, MAIN 3 WESTLINK SEWER

℄ 20' UTIL. EASE.

PROP. 6" W.

PROP. 8" W.

Not in benefit district

THURMAN ST.

STA. 0+00 CENTER PROPOSED M.H. ON PROPOSED LAT. 3, MAIN 3. BEGIN S.S. @ PROPOSED 8" STUB E.

PROPOSED 8" A.C. WATER LINE

STA. 3+04.7 CONSTR. STD. M.H. TYPE "A" OR "C"

STA. 6+00 CONSTR. STD. M.H. TYPE "A" OR "C"

N. CURB THURMAN ST.

NATURAL GROUND

E. CURB WOOD DR.

W. CURB CHERYL PLACE

PROPOSED 8" STUB

8" V.C.P. @ 0.40%

PROPOSED 8" S.S.

146.54	146.64	146.64	147.04	147.44	147.86	147.96	148.34	148.74	149.14

FLO OUT LAT. 3
FLO IN LAT. 3
FLO IN LA. 6

FLO OUT
FLO IN

595 LIN. FT. 8" V.C.P. @ 0.40% GRADE

0 1 2 3 4 5 6

165 160 155 150 145 140

DONALD E. SCHNEIDER LICENSED 6311 KANSAS PROFESSIONAL ENGINEER


LAT. 6, MAIN 3, WESTLINK SEWER


CITY OF WICHITA, KANSAS

R.W. LINN CITY ENGINEER

DATE: PROJ. NO. DBKL574030

B.M. = 158.97 N.E. COR. CONC. PORCH, HO. # 9125 THURMAN

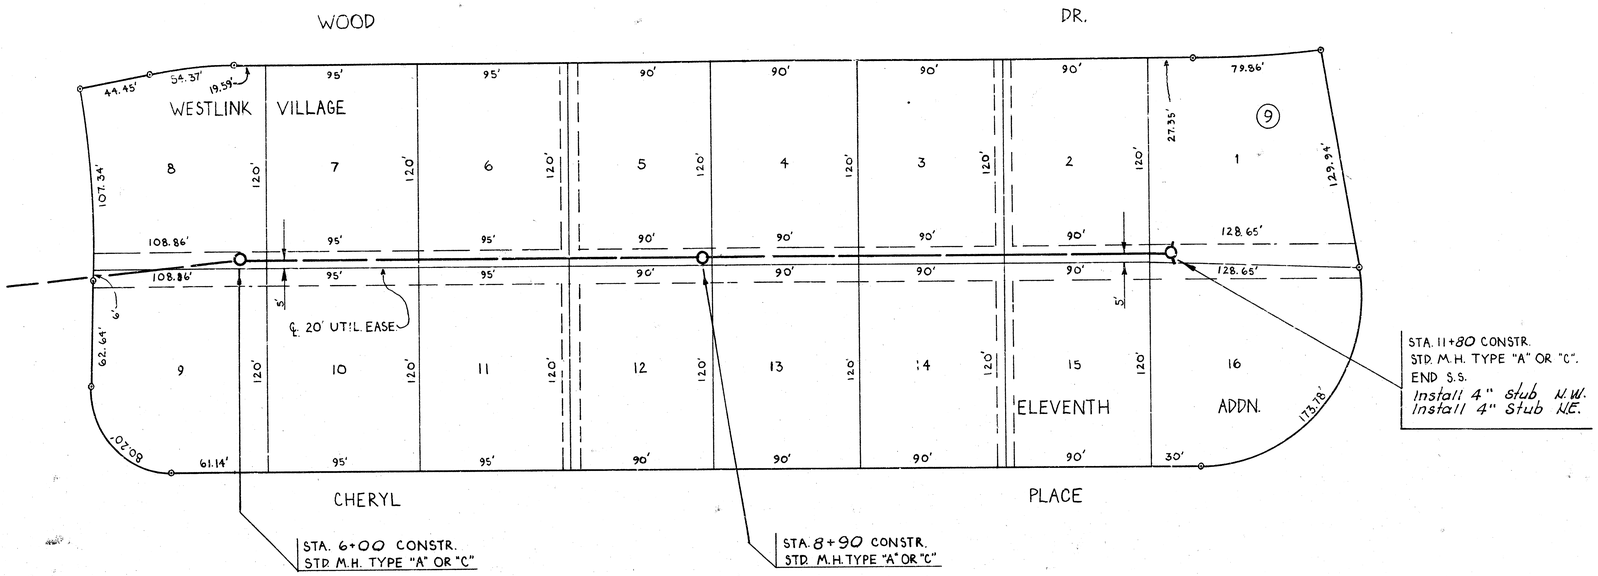

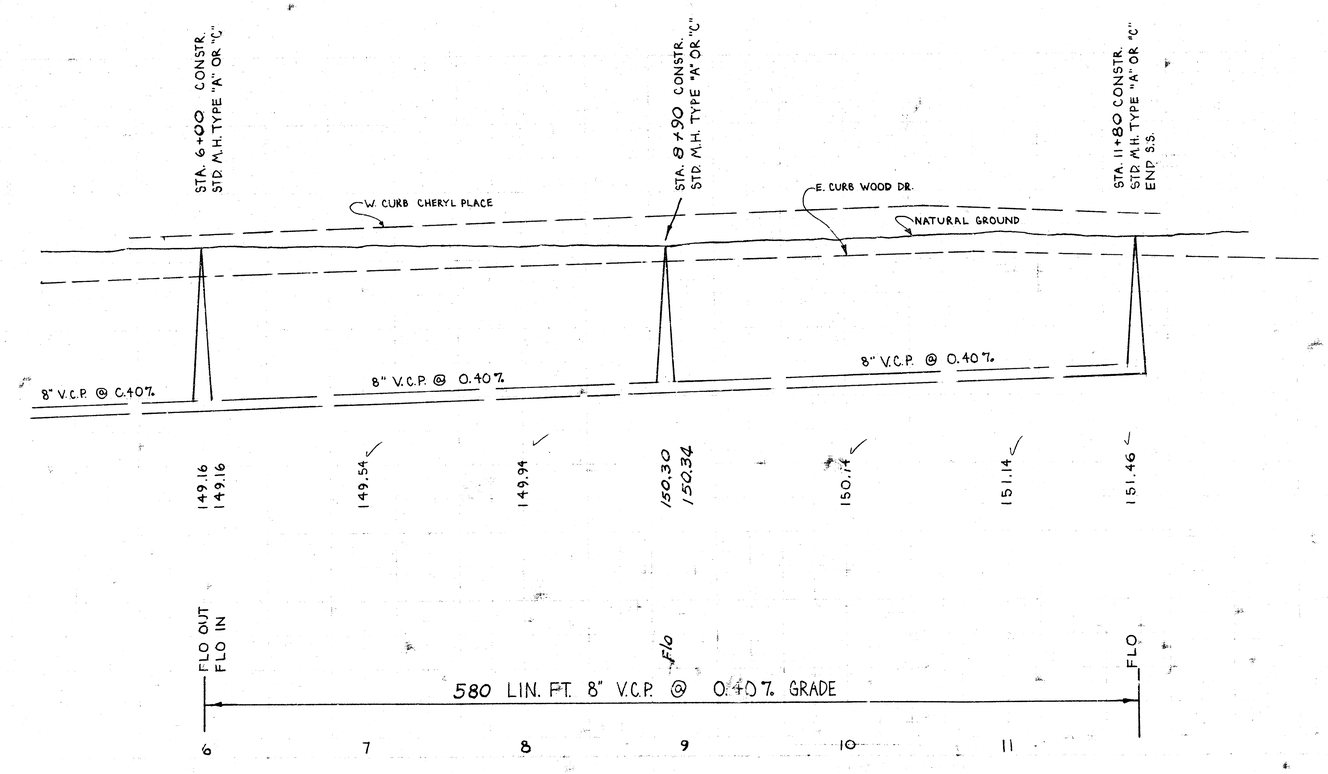

PLAN SCALE 1" = 40'
PROFILE SCALE 1" = 40' HOR.
1" = 5' VERT.

LAT. 6, MAIN 3, WESTLINK SEWER

CITY OF WICHITA, KANSAS
R.W. LINN CITY ENGINEER
DATE: PROJ. NO. DBKL574030