
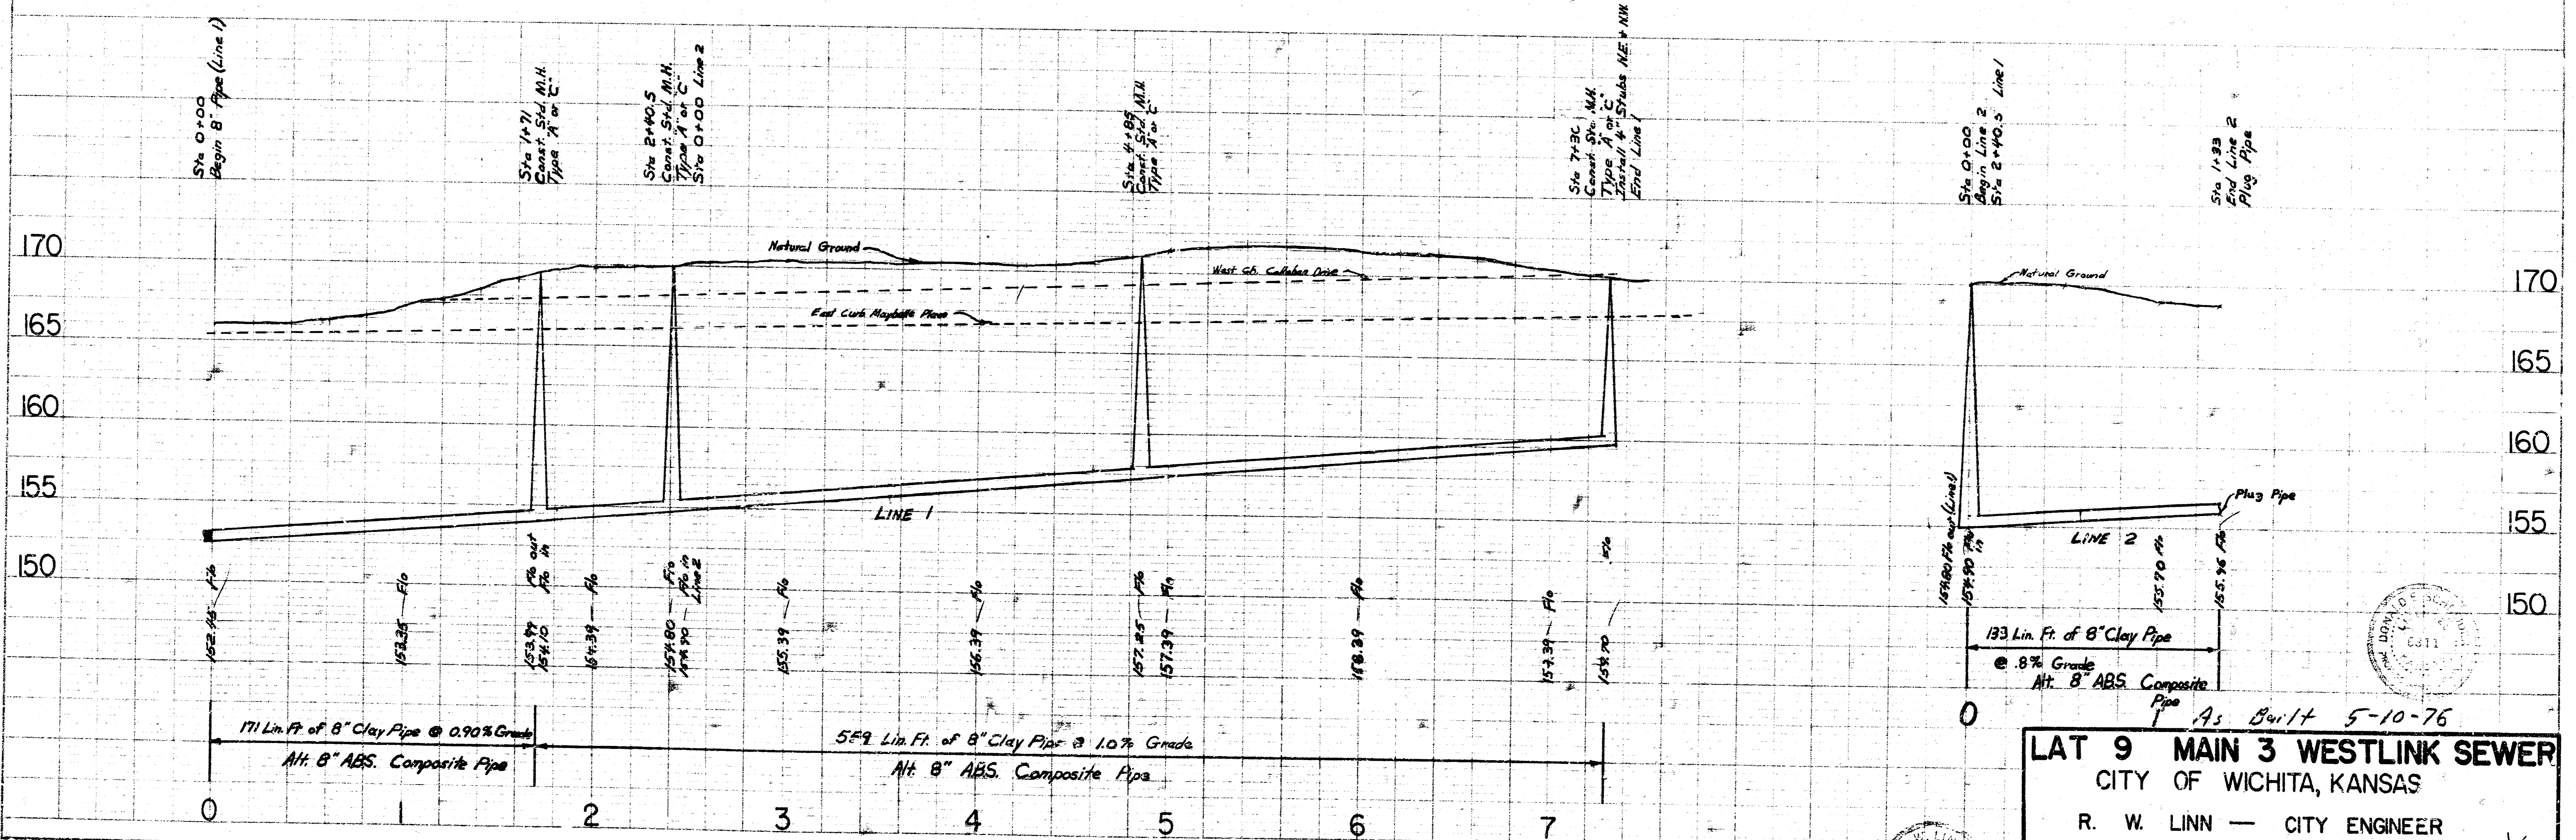


NOTE: PIPE BETWEEN STA. 0+00 AND STA. 1+71 ON LINE 1 SHALL BE THE SAME TYPE OF PIPE AS THAT WHICH IS TO BE INSTALLED BY CONTRACTOR FOR LATERAL 8, MAIN 3, WESTLINK SEWER.

BM. 172.48 City Std. SE. corner of 17<sup>th</sup> St North and Tyler Road  
 BM. 158.75 SE. corner concrete porch 916 Nantucket

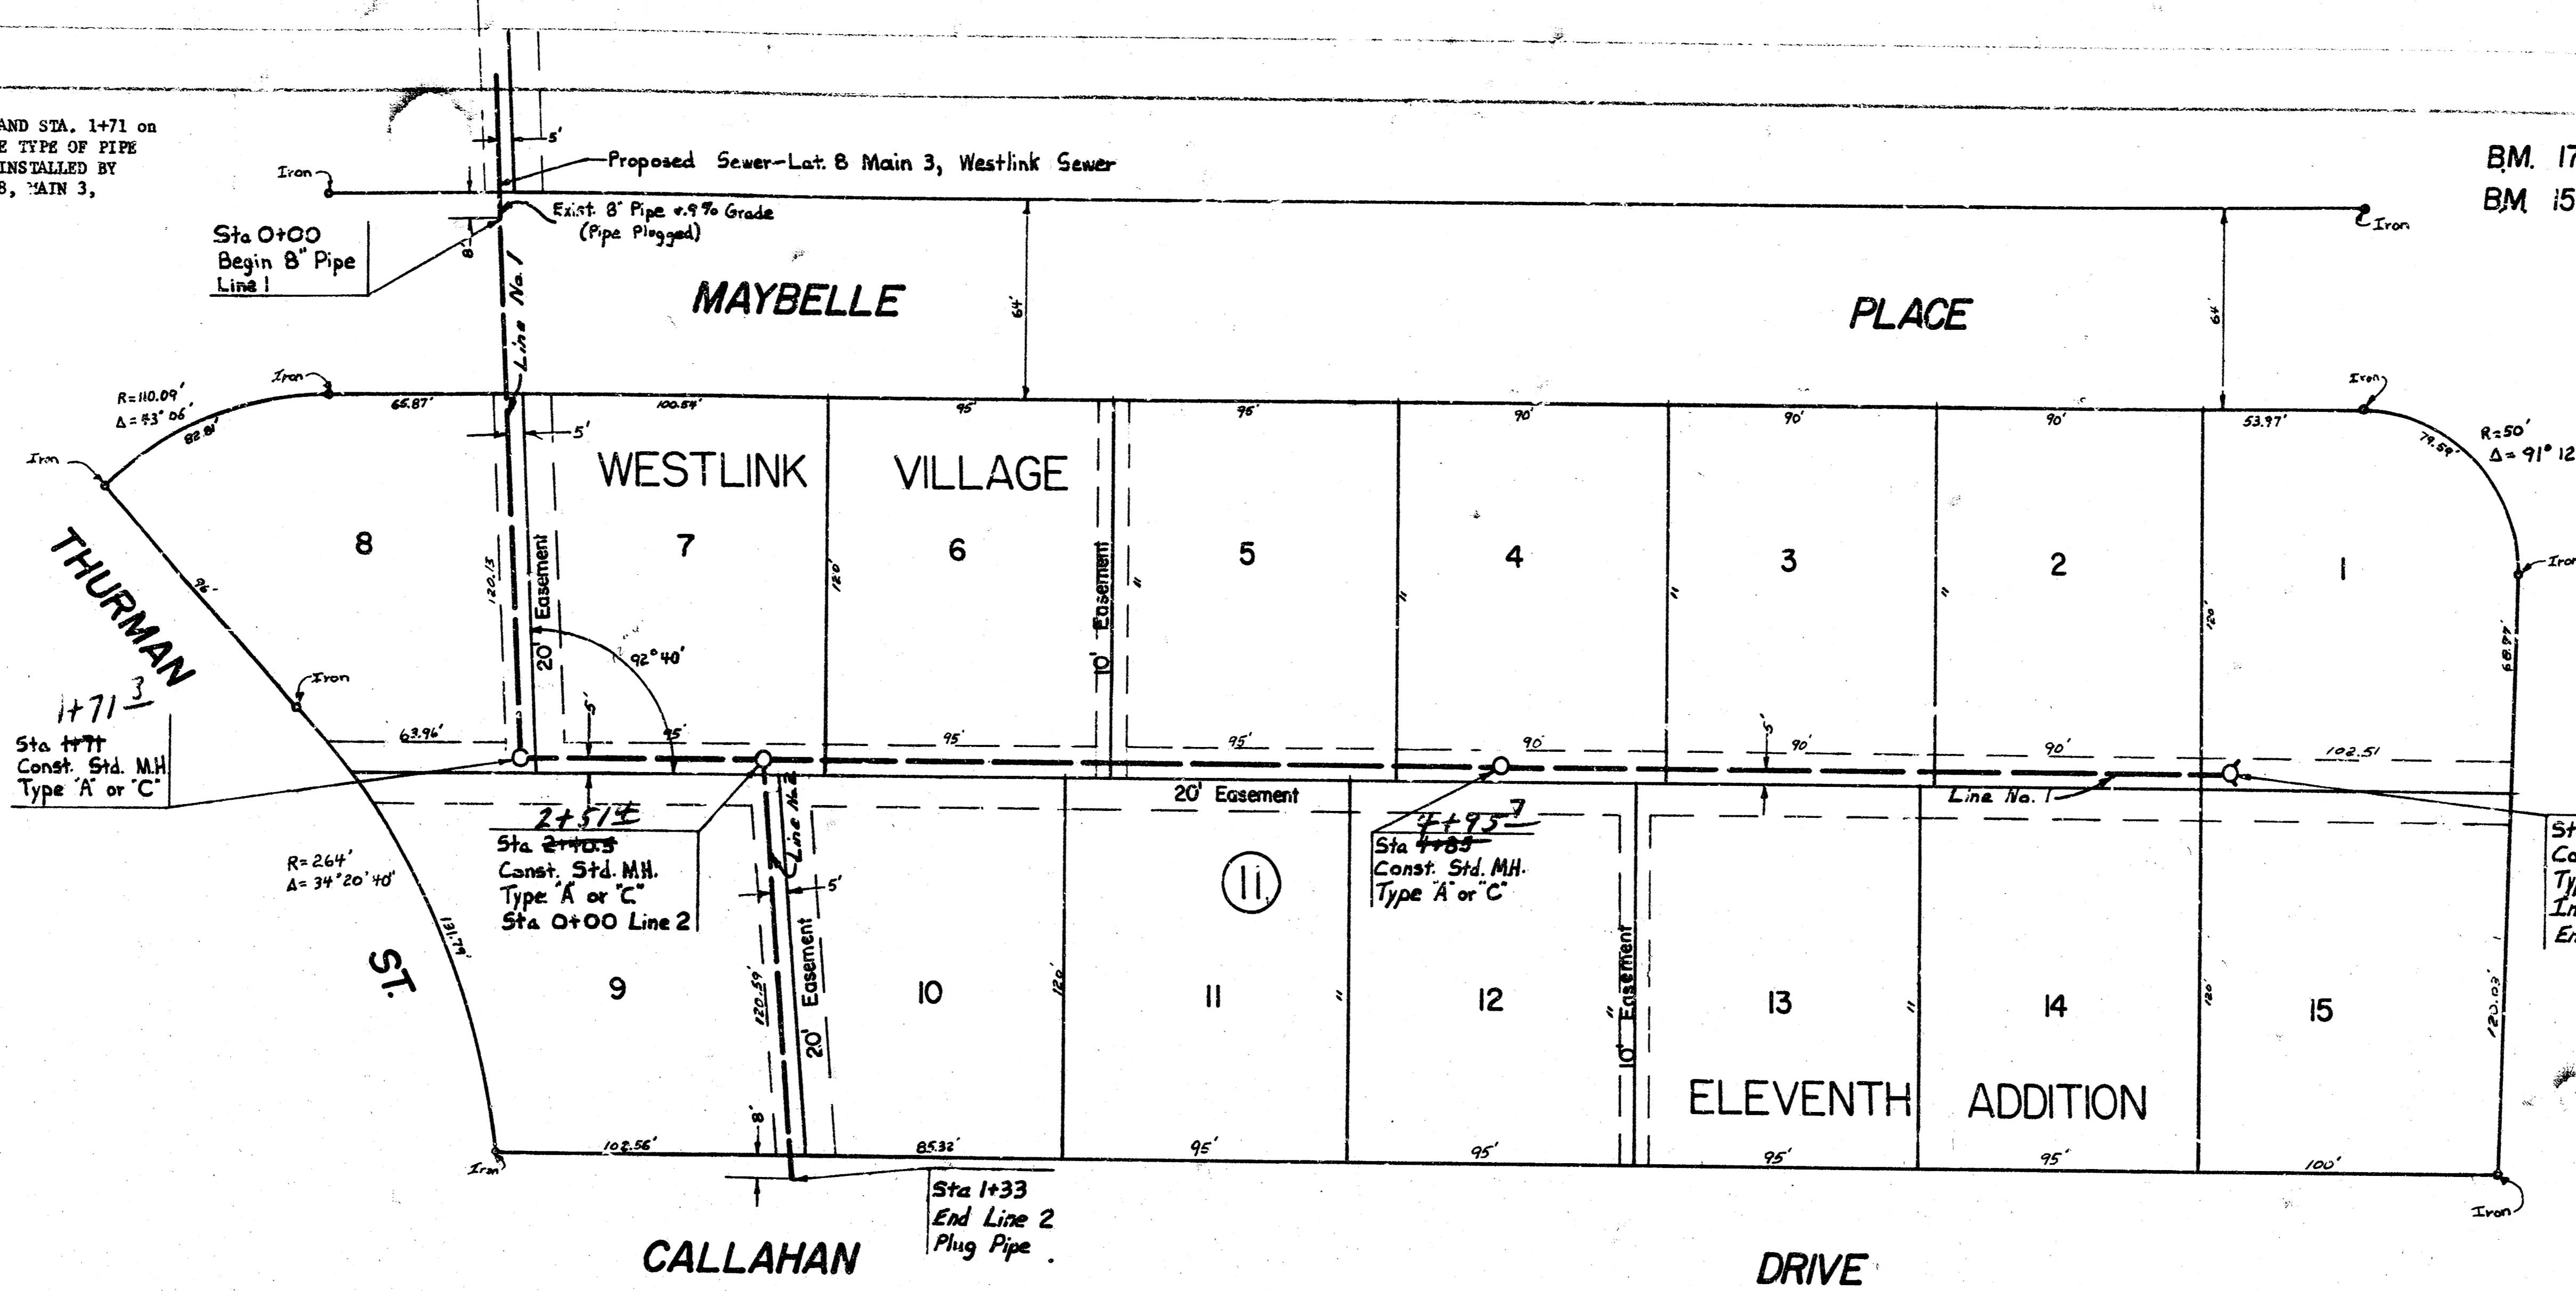

LAT 9 MAIN 3 WESTLINK SEWER  
 CITY OF WICHITA, KANSAS  
 R. W. LINN — CITY ENGINEER  
 Project No. DBKL 574033