

NOTE: PIPE BETWEEN STA. 0+00 AND STA. 1+71 on LINE 1 SHALL BE THE SAME TYPE OF PIPE AS THAT WHICH IS TO BE INSTALLED BY CONTRACTOR FOR LATERAL 8, MAIN 3, WESTLINK SEWER.

B.M. 172.48 City Std. SE. corner of 17th St. North and Tyler Road
B.M. 158.75 SE. corner concrete porch 9116 Nantucket

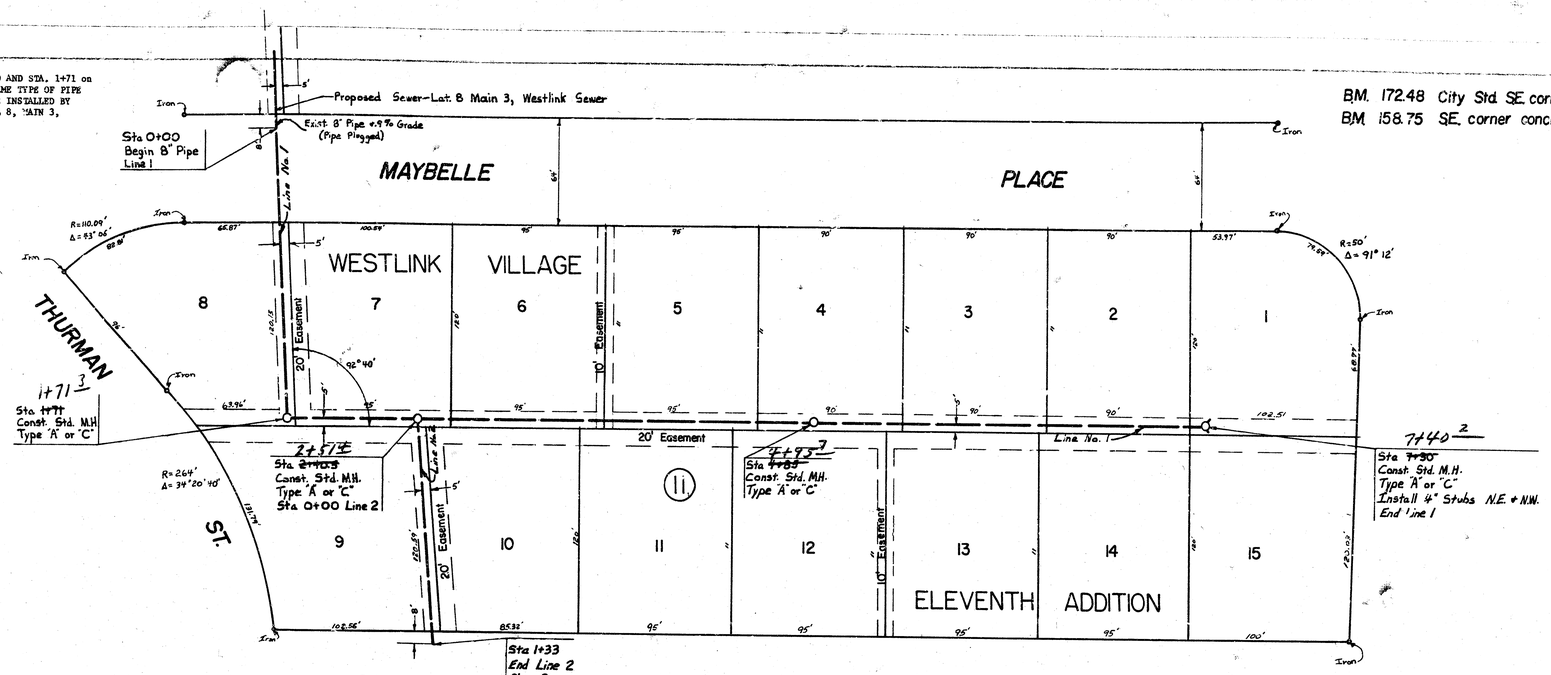

Plan Scale 1" = 40'
Profile Scale 1" = 40' Horz.
1" = 5' Vert.

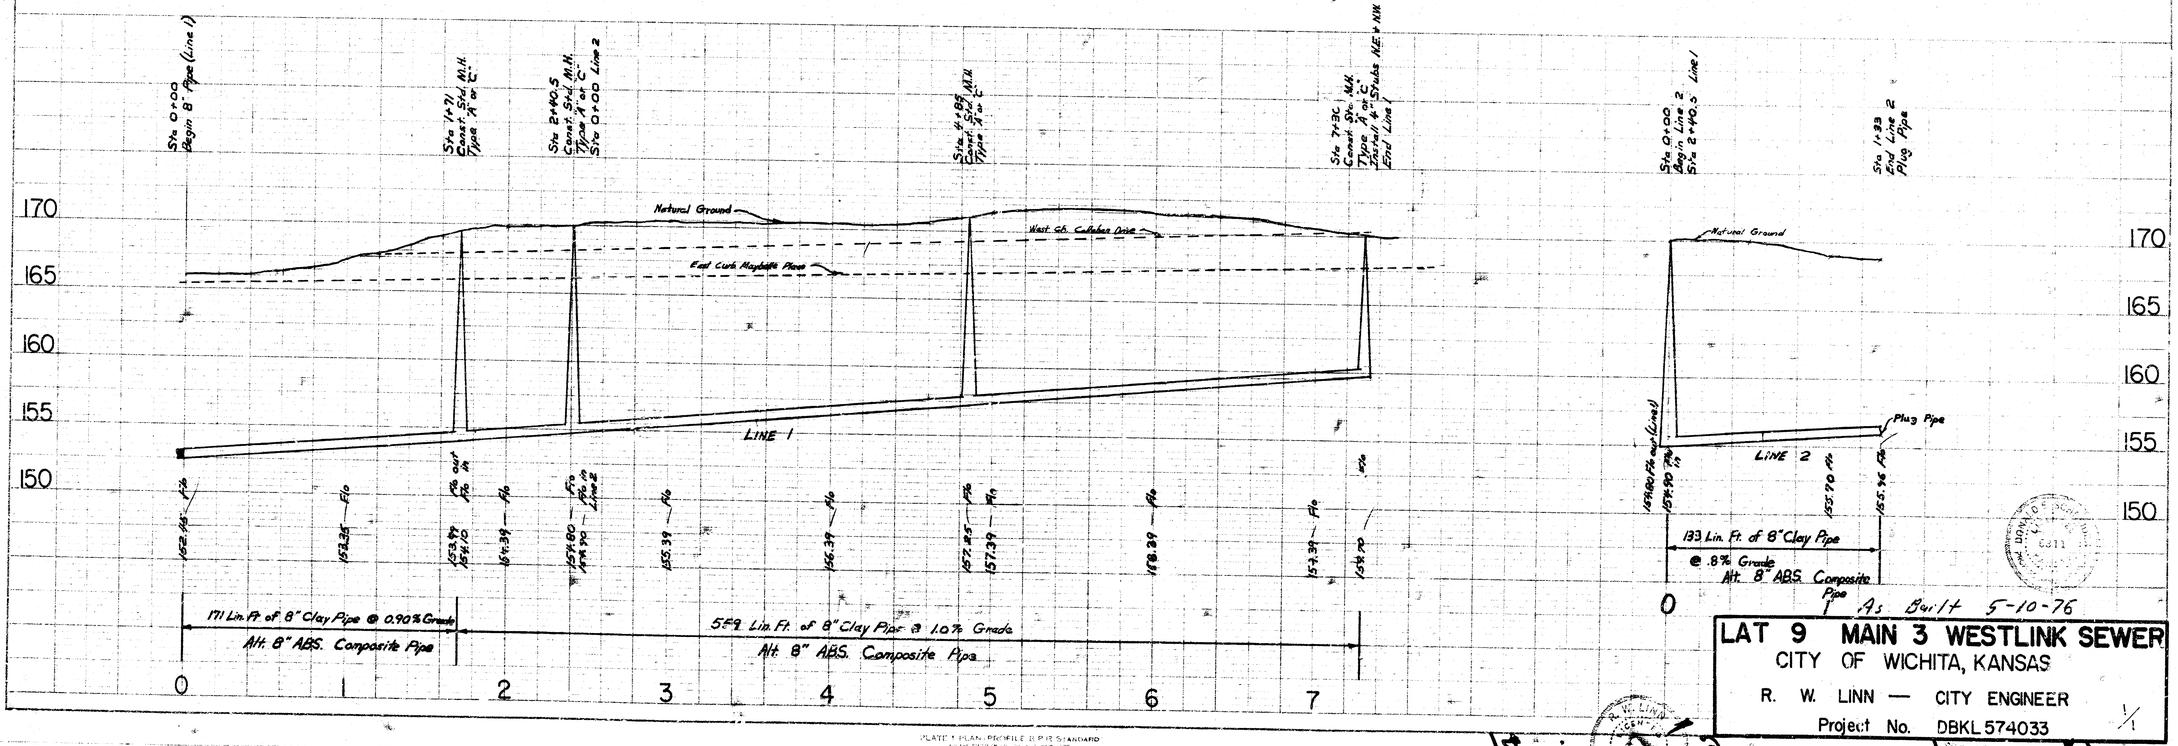

As Built 5-10-76

LAT 9 MAIN 3 WESTLINK SEWER

CITY OF WICHITA, KANSAS

R. W. LINN — CITY ENGINEER

Project No. DBKL 574033

1/1

PLATE 1 PLAN-PROFILE R.P.I.R. STANDARD