
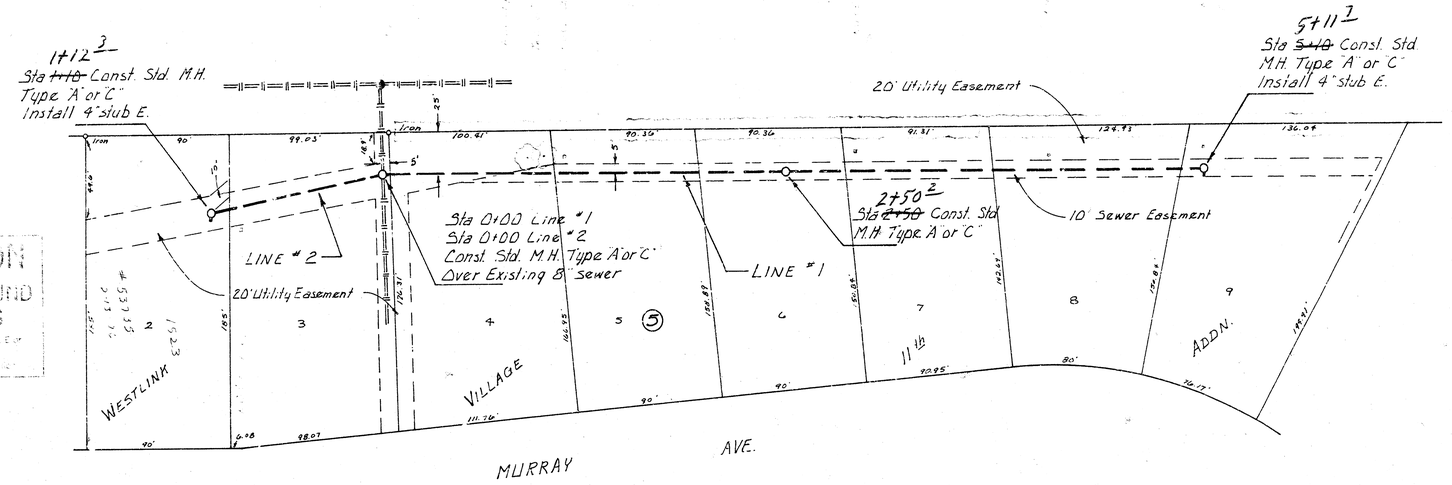


Scale Plan 1" = 40'
Profile 1" = 40' Horz.
1" = 5' Vert.

B.M. 158.58 N.W. Corner conc. porch west side of house at 1502 Murray Ave.

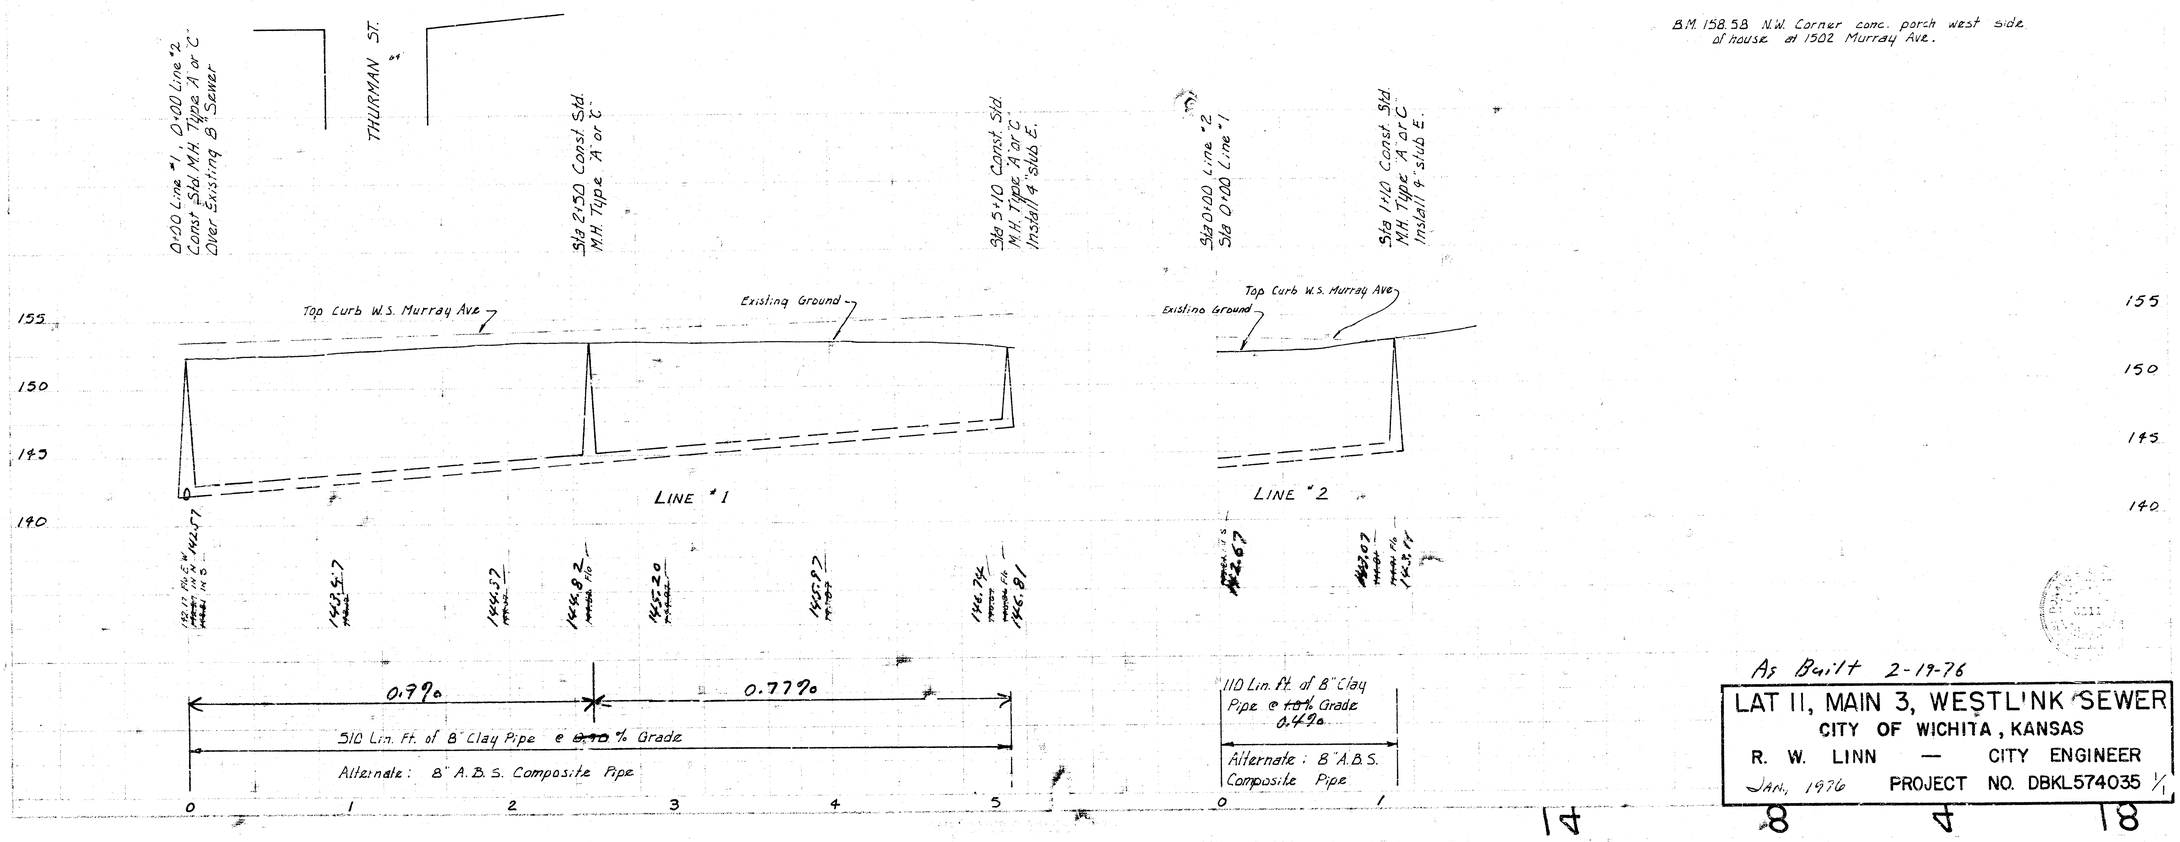

As Built 2-19-76

LAT II, MAIN 3, WESTLINK SEWER
CITY OF WICHITA, KANSAS
R. W. LINN — CITY ENGINEER
JAN., 1976 PROJECT NO. DBKL574035 1/1