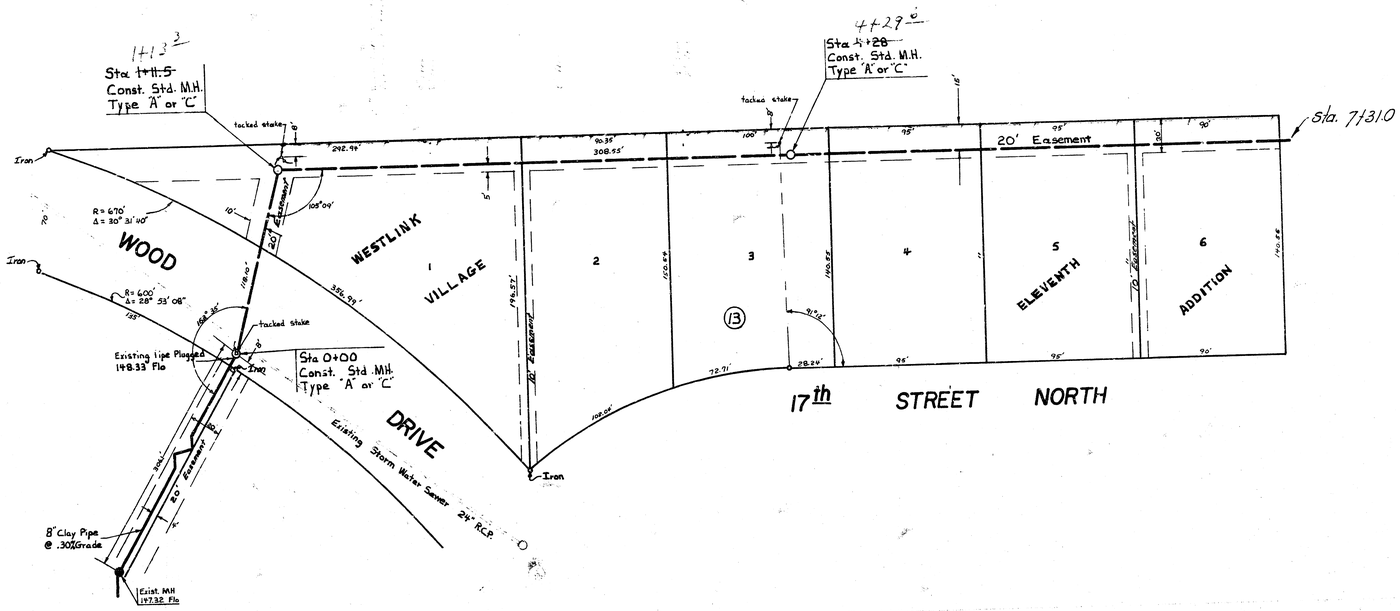
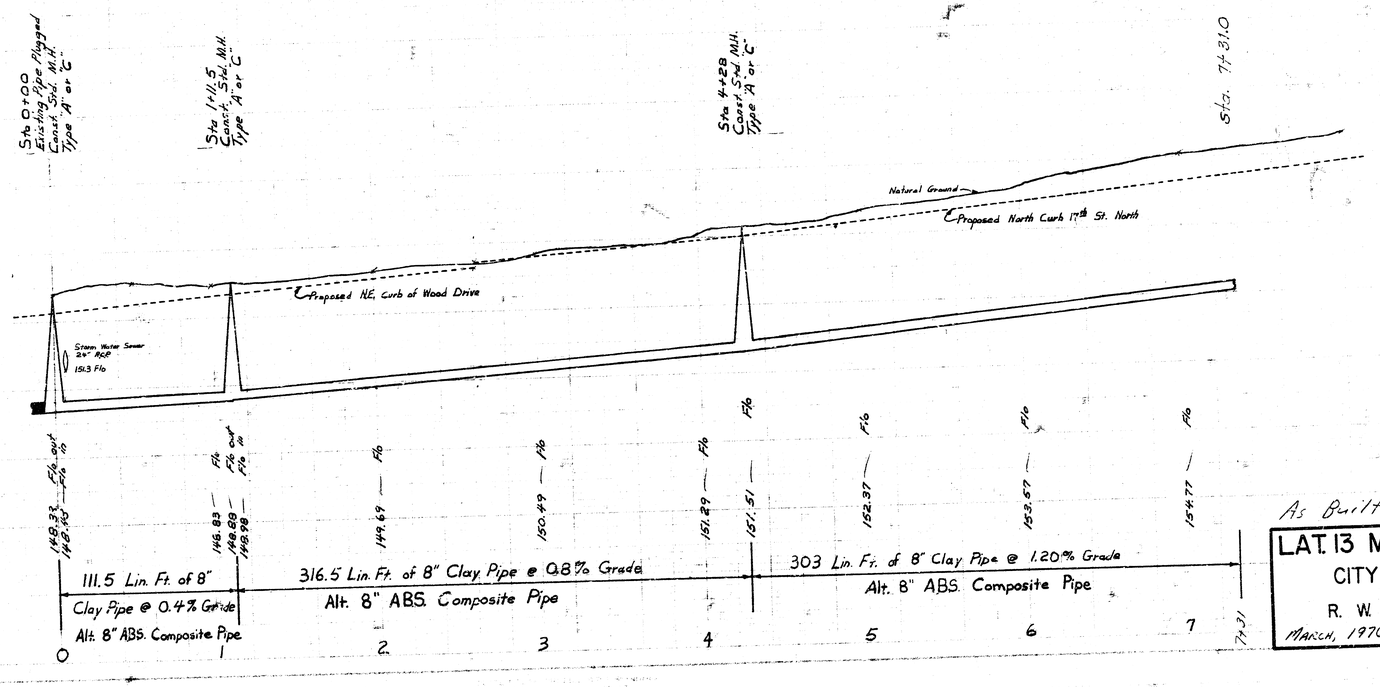
BM. 155.90 "a" cut top East curb of Westfield 10' South of S.L. Wood Drive
BM. 172.48 City Std. at Tyler & 17th St. North 36' East ℄ 31' South of NE. corner SE. 1/4 Sec. 8-27-1W.



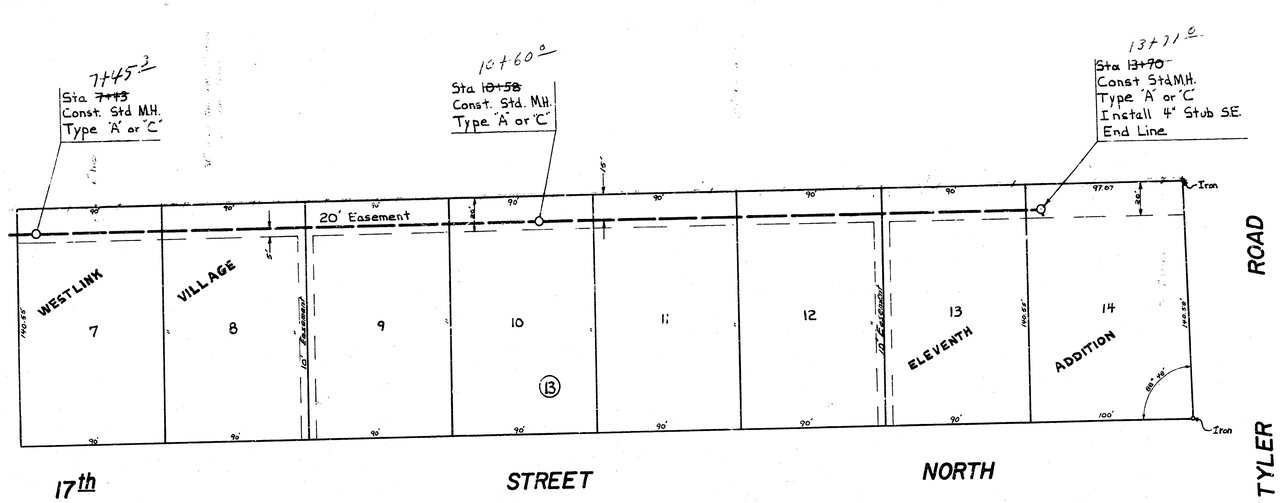

Plan Scale 1" = 40'
Profile Scale 1" = 40' Horz.
1" = 5' Vert.



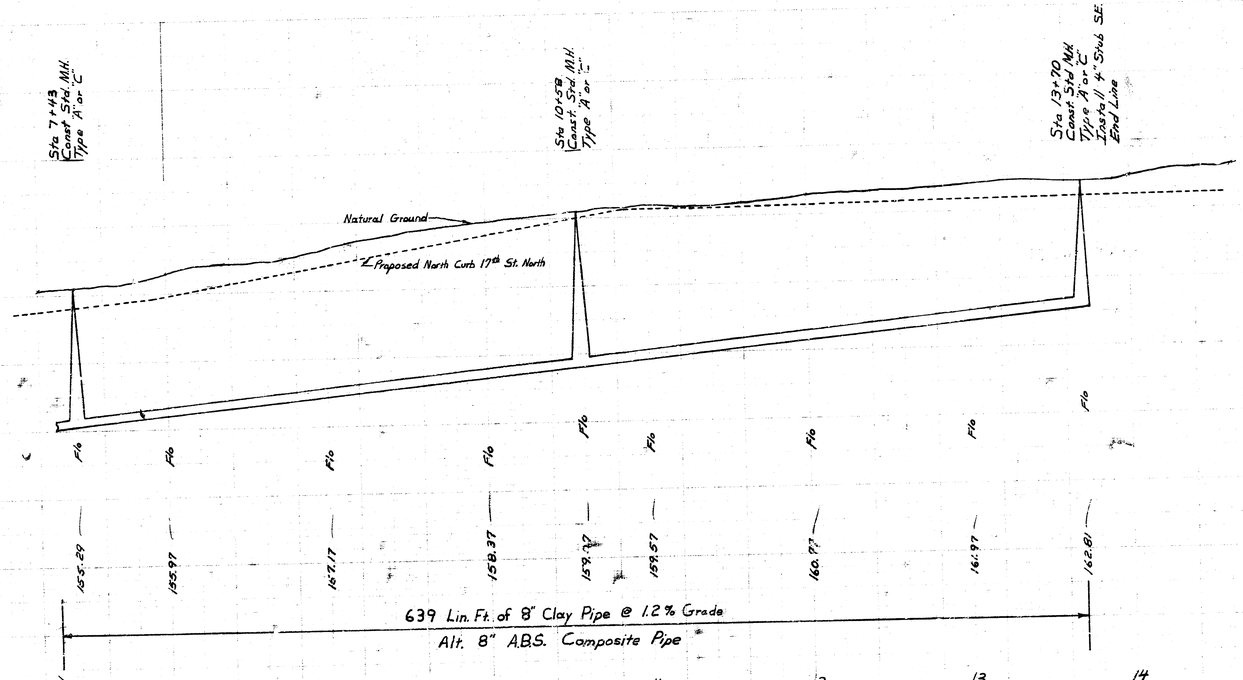

As Built 10-4-76

# LAT. 13 MAIN 3 WESTLINK SEWER
CITY OF WICHITA, KANSAS
R. W. LINN CITY ENGINEER
MARCH, 1976 Project No. DBKL574037

B.M. 155.90 "□" cut top East curb of Westfield 10' South of S.L. Wood Drive




Plan Scale 1" = 40'
Profile Scale 1" = 40' Horz.
1" = 5' Vert.




LAT. 13 MAIN 3 WESTLINK SEWER
Project No. DBKL574037

2/12