

JFG-184 (L-5-2)
WSK

N.W. Cor. SE¼ Sec. 8-27-1W | B.M. 158.58 NW Cor. Con. Porch W.S. house @ 1508 Murray | B.M. 156.01 West edge Manhole @ 150' S. of S.L. of 16th & 50' E. of E.L. of Murray

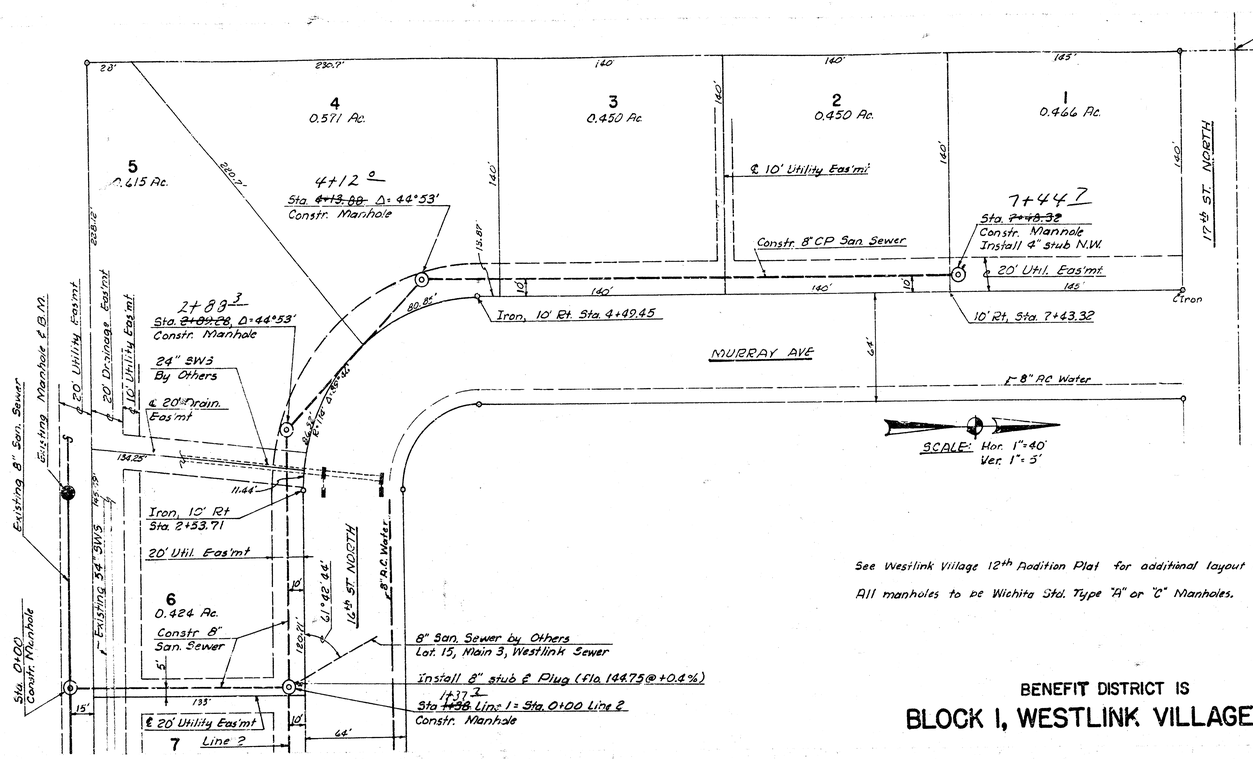

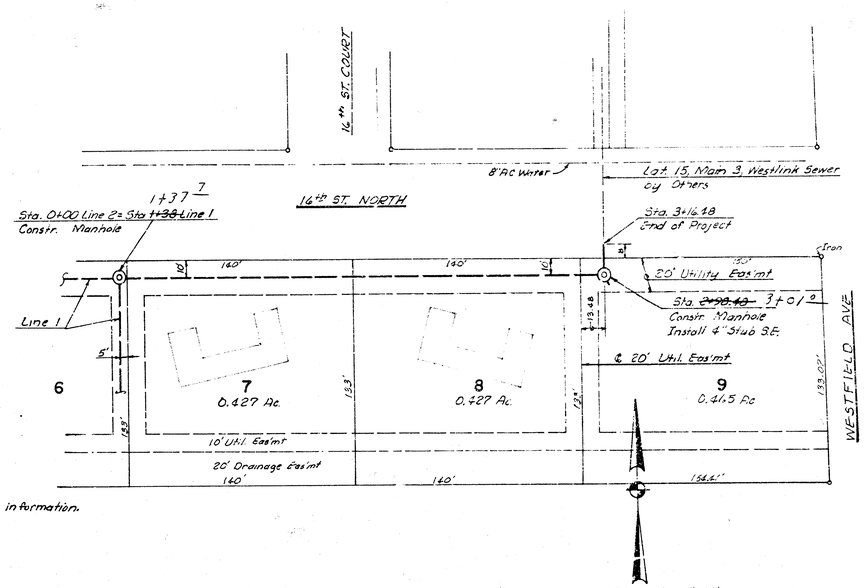



See Westlink Village 12th Addition Plat for additional layout information.

All manholes to be Wichita Std. Type "A" or "C" Manholes.

BENEFIT DISTRICT IS

BLOCK 1, WESTLINK VILLAGE TWELFTH ADDITION

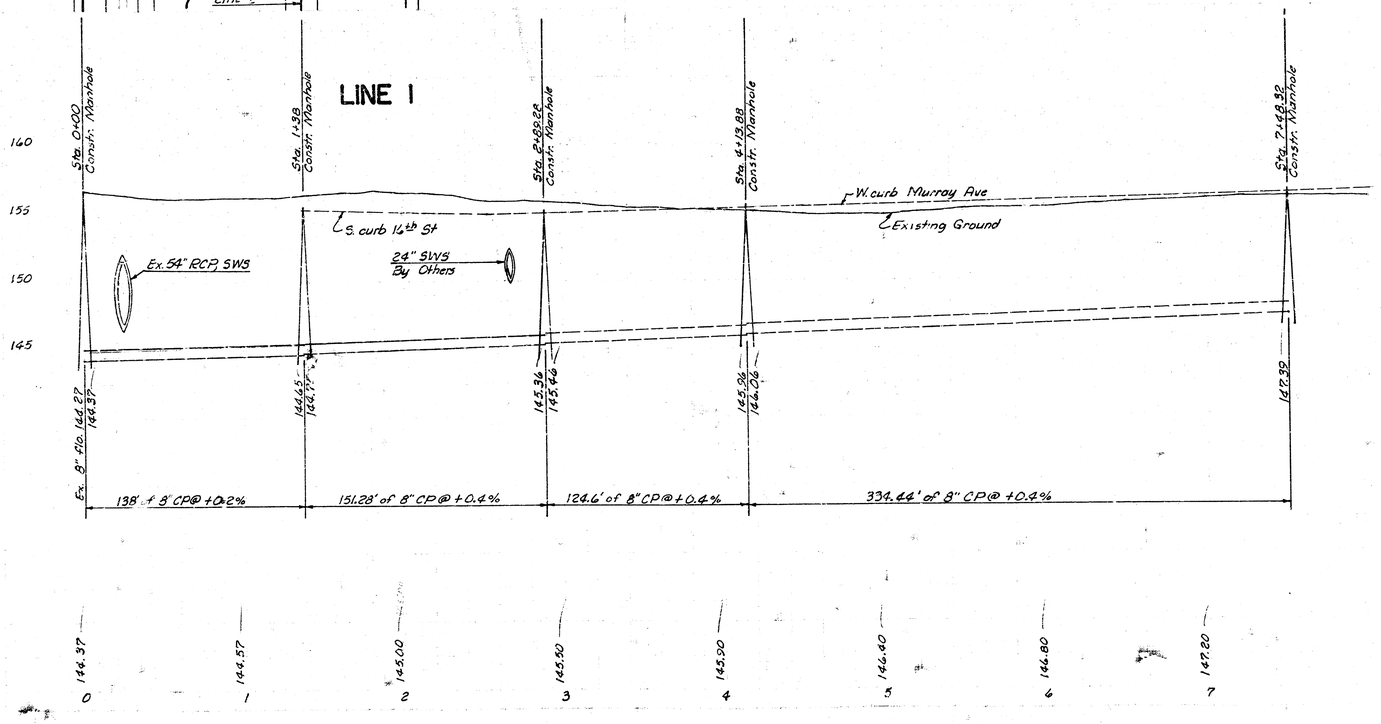

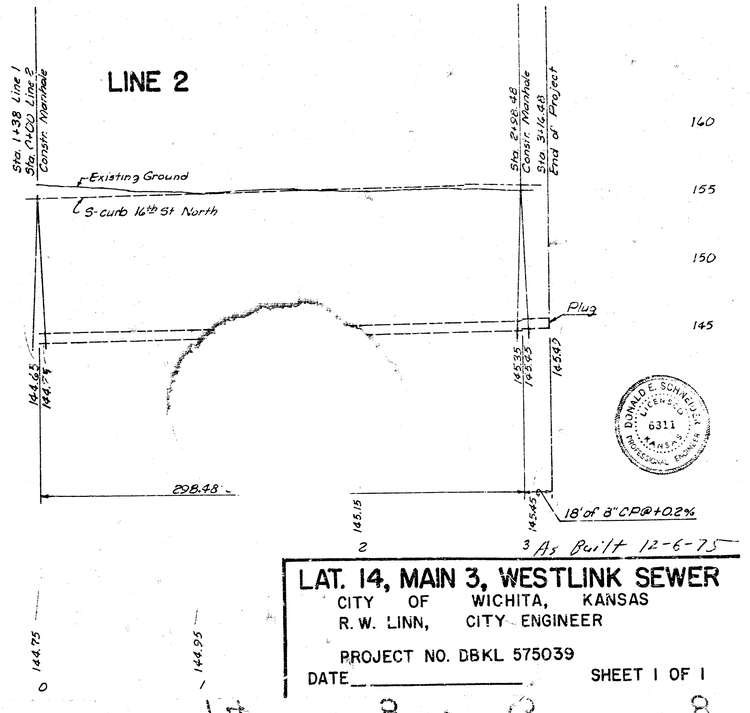

DONALD E. SCHNEIDER LICENSED PROFESSIONAL ENGINEER 6311 KANSAS

As Built 12-6-75

LAT. 14, MAIN 3, WESTLINK SEWER

CITY OF WICHITA, KANSAS
R. W. LINN, CITY ENGINEER

PROJECT NO. DBKL 575039
DATE _____ SHEET 1 OF 1

14 8 . 2 8